


T.7S. R.6W.W.M.

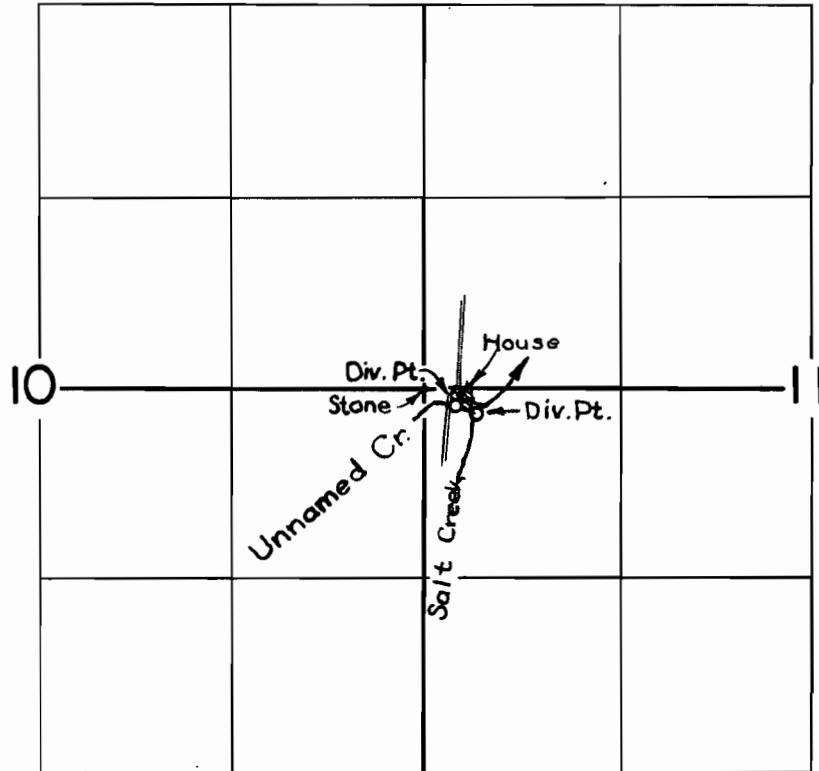

FINAL PROOF SURVEY
UNDER

Application No. 32010 Permit No. 25254
IN NAME OF

Fred & Mays McAllister

Surveyed April 1, 1958, by R.H. Whitby