


T.4N.R.28E.W.M.

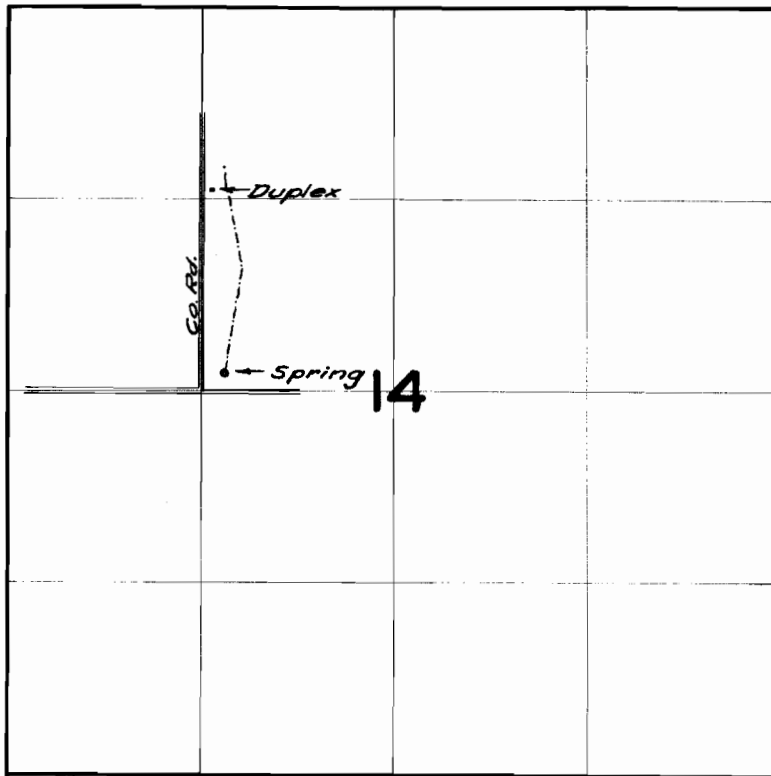

FINAL PROOF SURVEY
UNDER

Application No. 32109 Permit No. 25334
IN NAME OF

MR. & MRS. GLEA HISKEY

Surveyed 18 Nov. 1958, by T. B. Bish