


T.4.S.R.4 W.W.M.

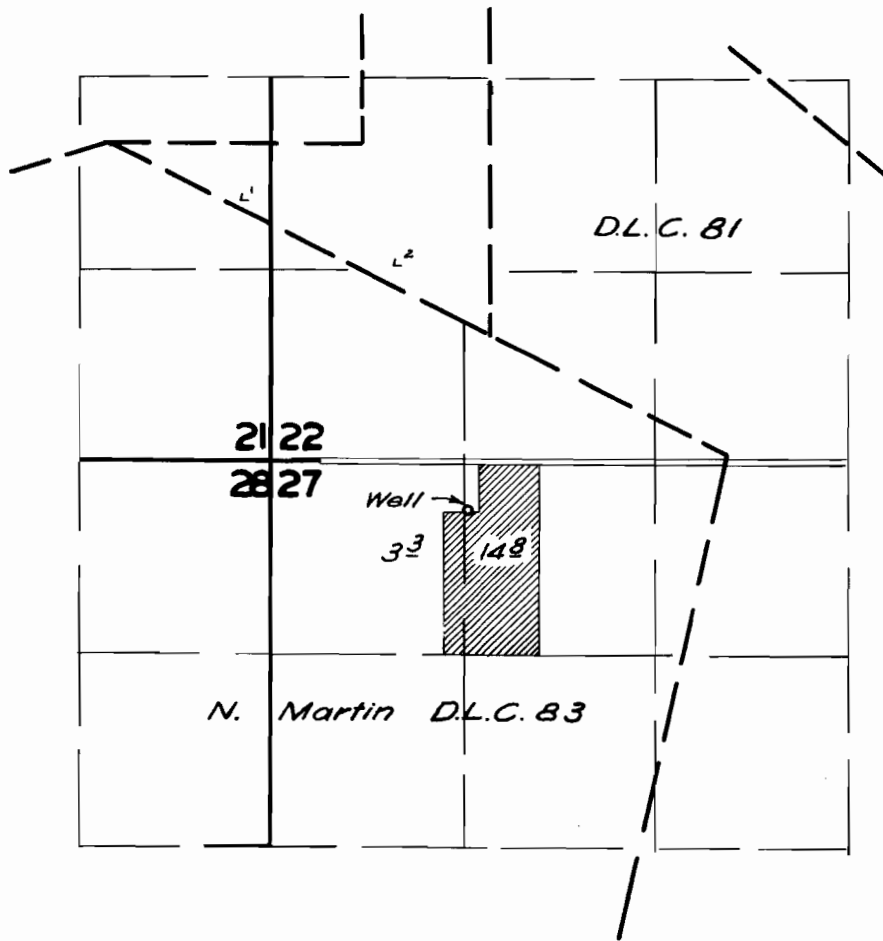

**FINAL PROOF SURVEY**  
UNDER

Application No. *G-384*... Permit No. *G-259*...  
IN NAME OF

*J. L. Wilcox*

Surveyed *29 April 1958*, by *M. A. Bish*