
TOWNSHIP 32 S. RANGE 13 E.

3669

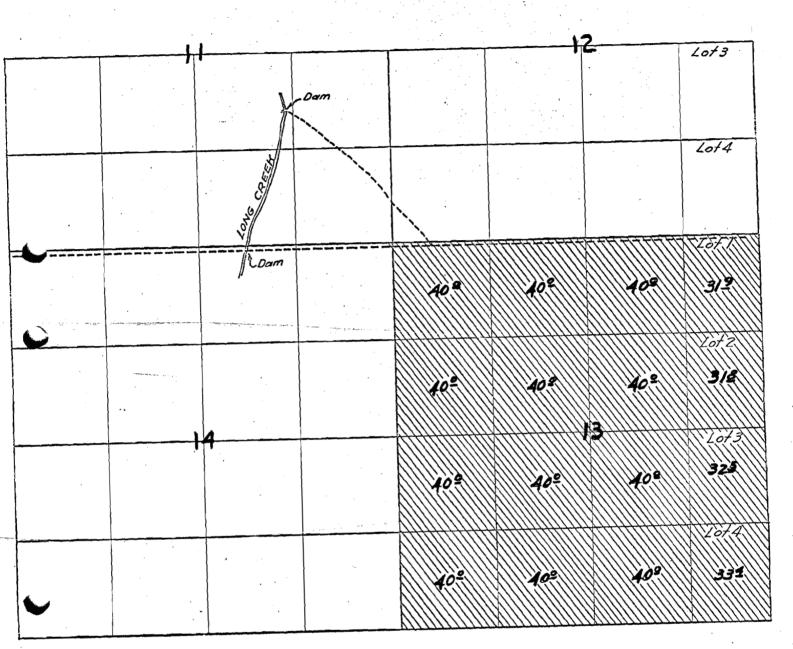

FINAL PROOF SURVEY UNDER Application No. <u>4649</u> Permit No. <u>3669</u> IN NAME OF <u>Chewaucan Land & Cattle Co.</u>

Sycan March ; Mice

Surveyed July 22, 1941, by Chester bumming