


T. 11 S. R. 2 W. WM

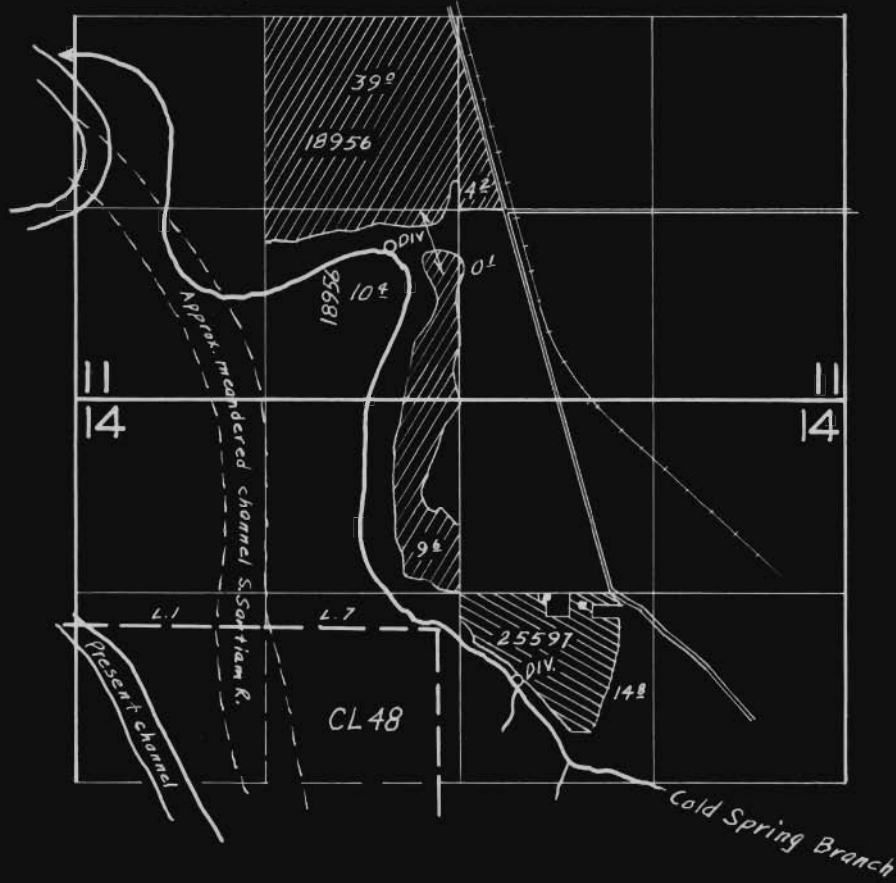

FINAL PROOF SURVEY

UNDER

18956

14558

Application No. 25597

Permit No. 20086

IN NAME OF

J. A. Brewster

Russell C. and Helen Louise Falk

Surveyed Aug. 4 19 54, by H. L. Coffman