

48-2-1

2

1

11

12

14


13

16

15

21


22

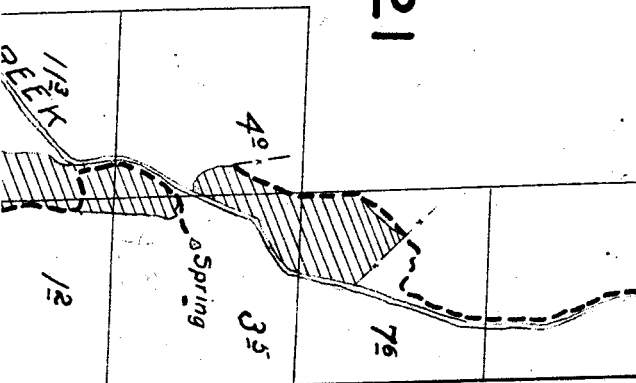

L.H. Donarson

ds, except
nd, is
ation.

TOWNSHIP 8 S., RANGE 25 E.

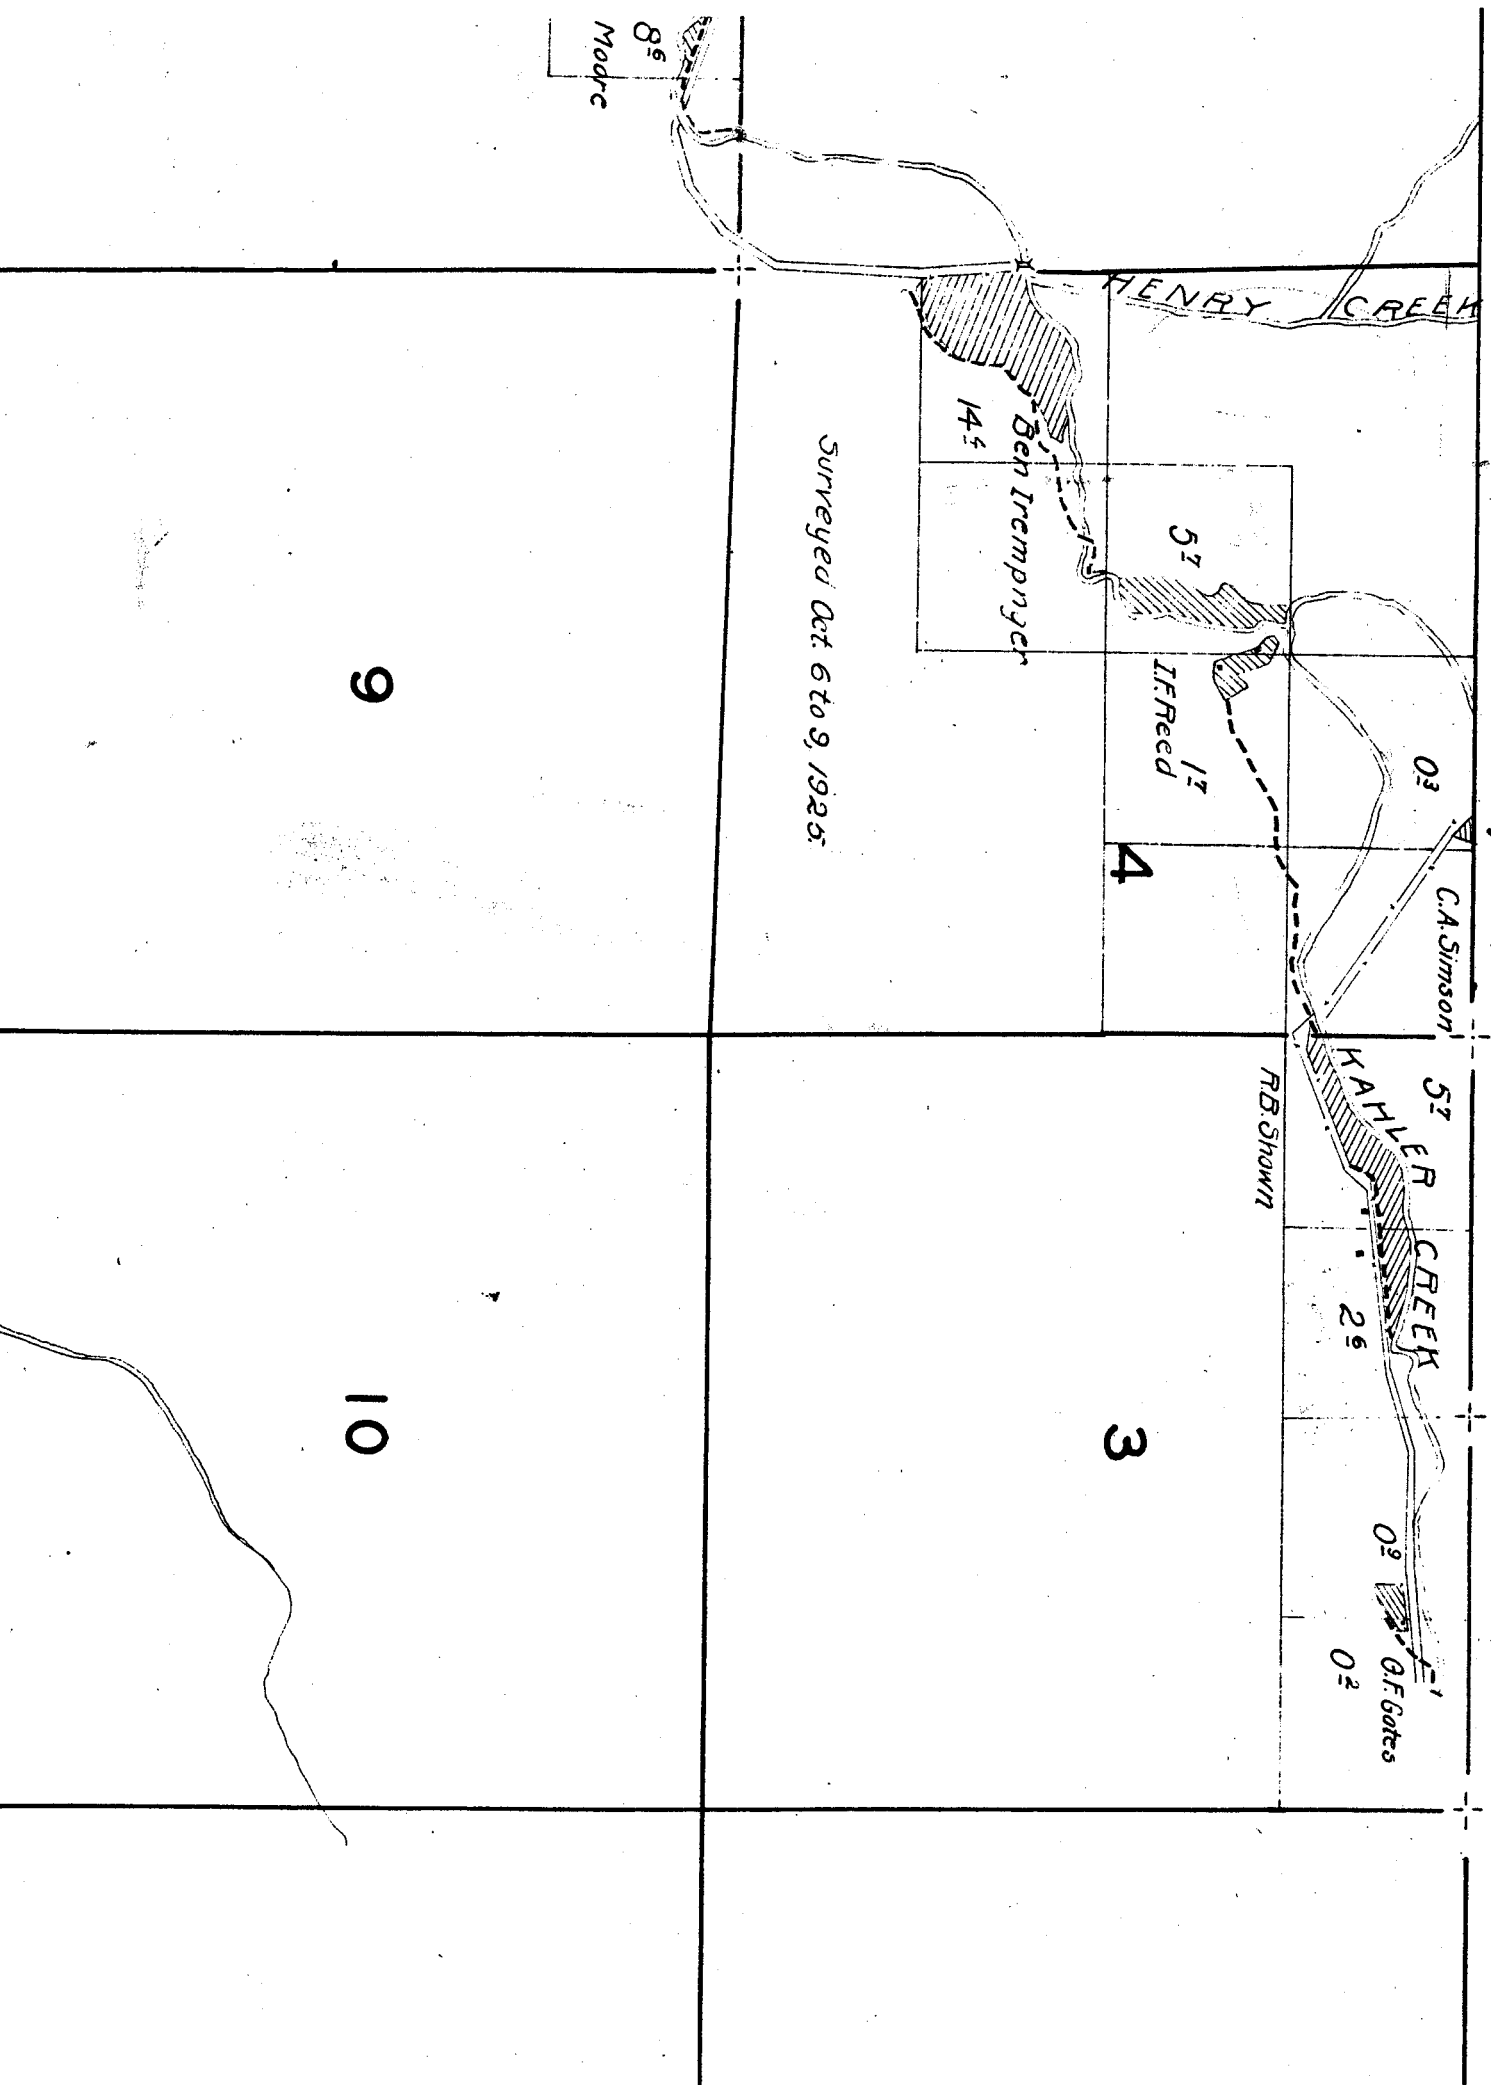

6

5

7

12

03

8

lage 8^e
E.R. Modre

07

4^o

A.S. Borges

18

17

30

29

31






03

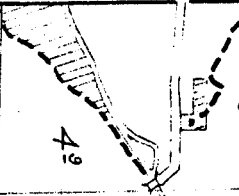

A.S. Borges

18

17

16

19

20

21

*Note: Location of streams and roads, except
in the vicinity of irrigated land, is
sketched in approximate location.*

41

11/3/11
CREEK

Surveyed Sept 29, 1925.

Helm Cr.

27

26

25

34

35

36

15

14

13

22

23

24

INVESTIGATE
CREEP

62



RJ. Carson

17

05



21

22

4°

7°

3°

Spring

L.H. Donovan

11/3
CREEK

1/2

17°

4°

HAYSTACK

Bob Wright

J.F. Asher

28

27

Spring

17°

Surveyed Sept. 19 to 23, 1926

Steiner

5°

C.W. Walls

1°

A.E. Cress

1/2

33

34

40°

Now C-35285

27°

07

12°

21°

Pump

3°

Pri. Jenkins

Vm