

21

22

2°
FWBall


Note: Location according
to Mr. Ball.
School

28

27

33

34

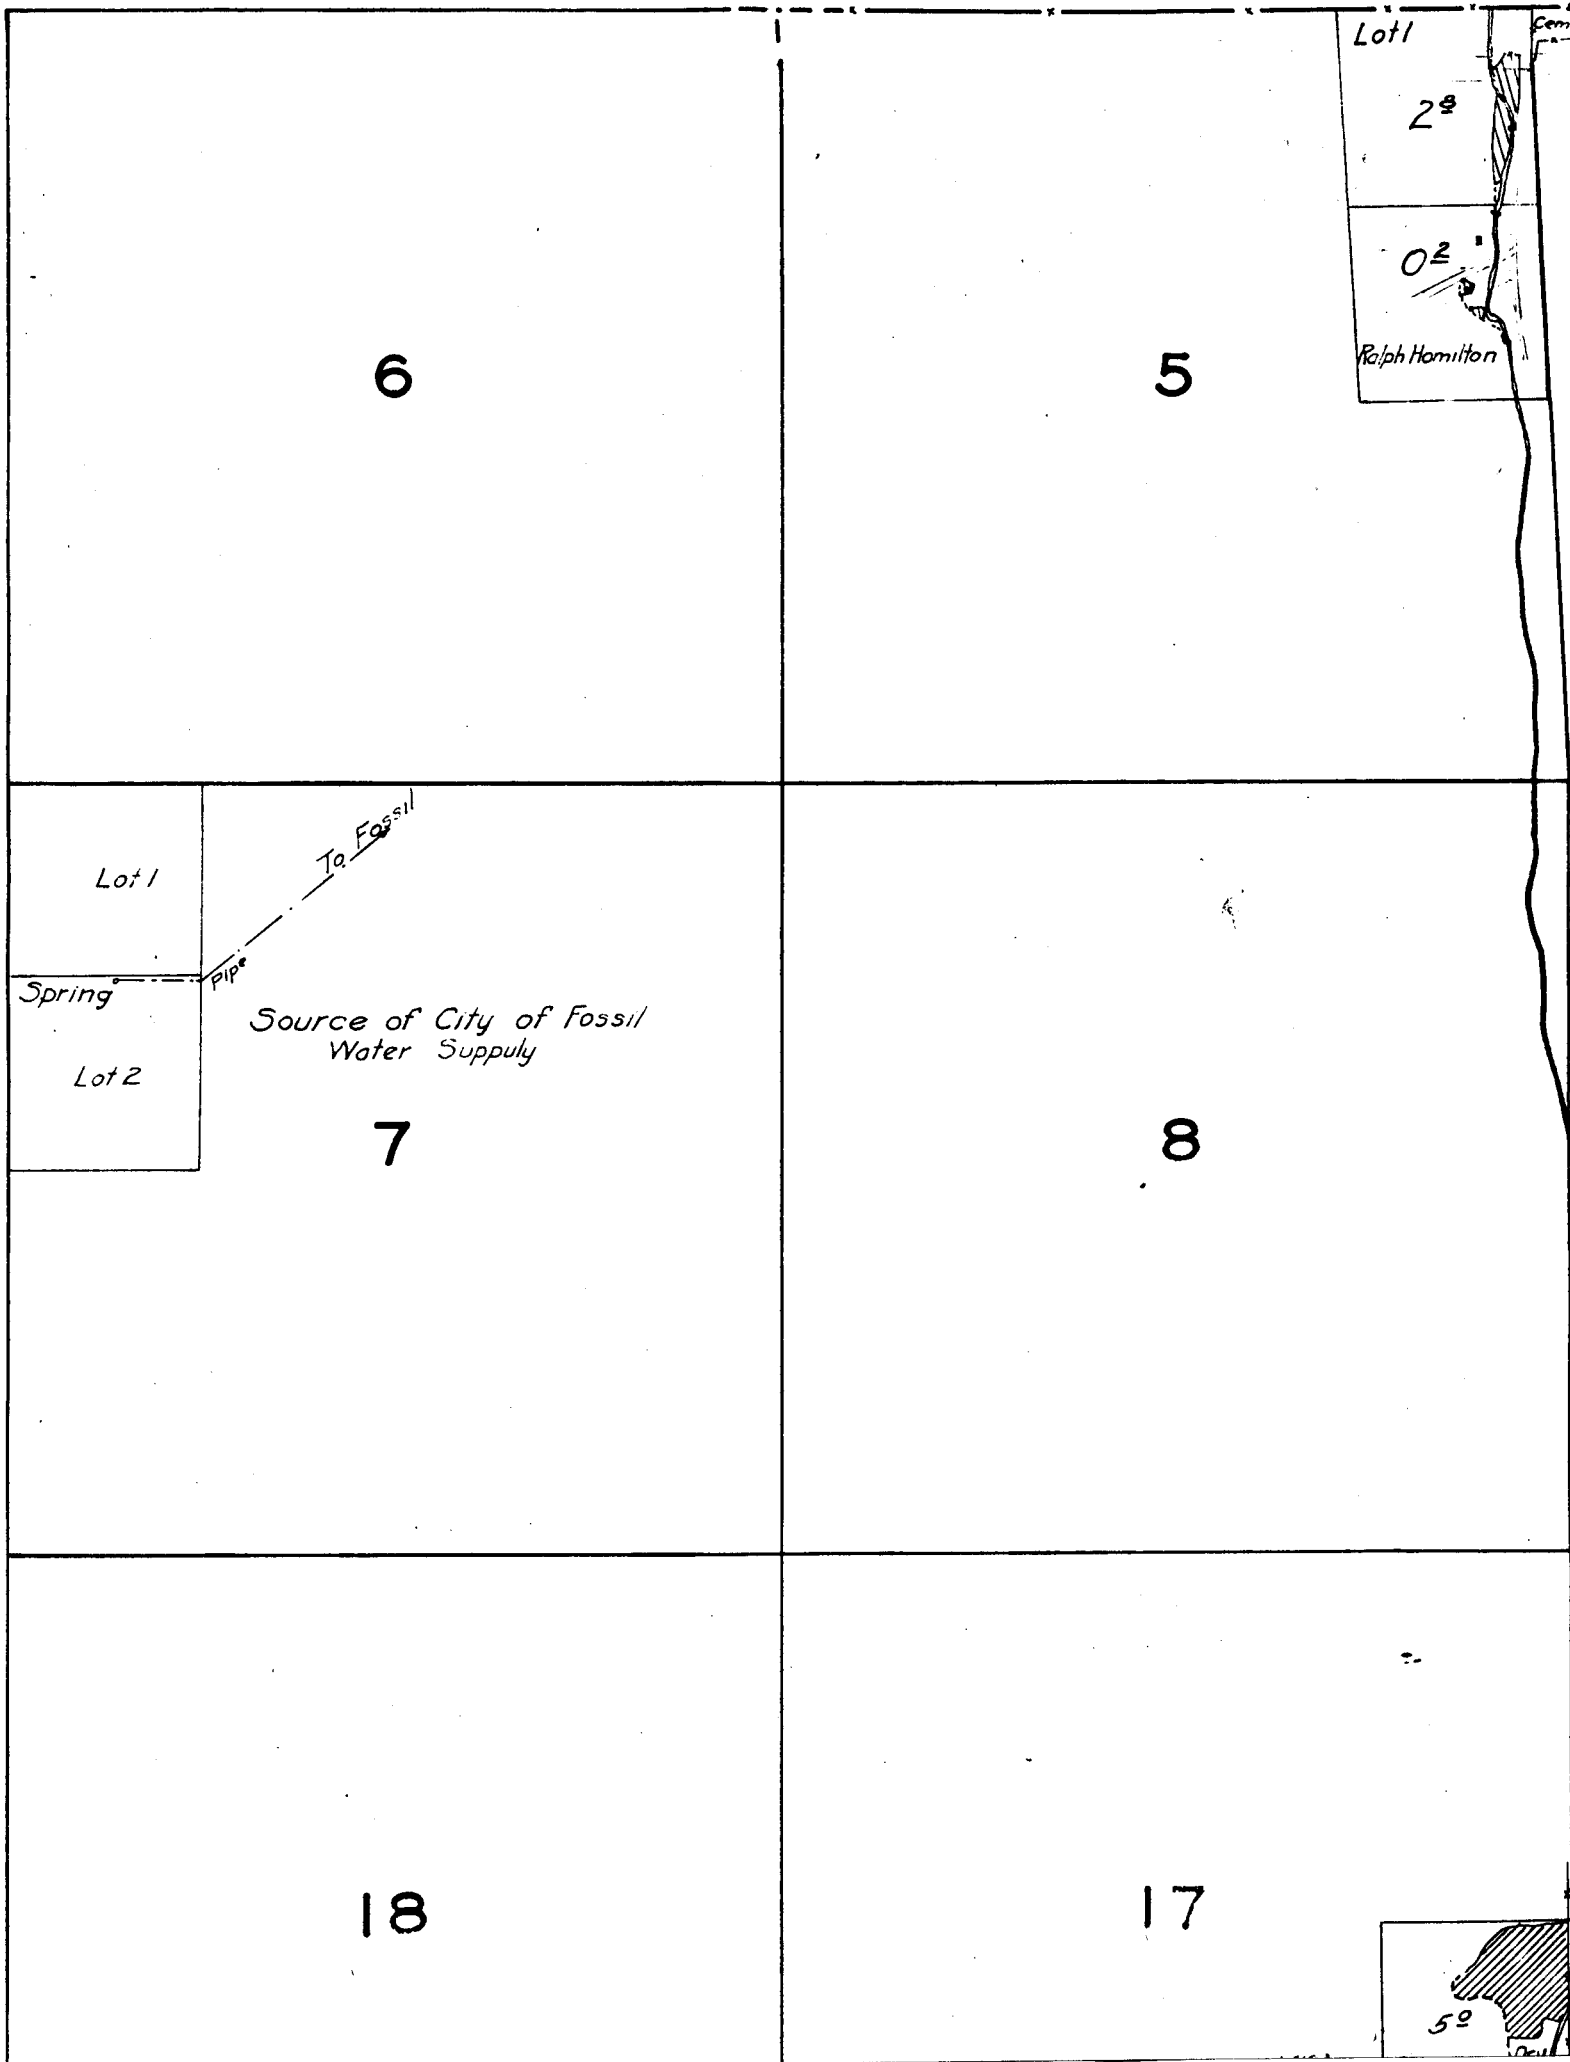

Note: Streams not in the vicinity of irrigated lands sketched in approximate location.

15

16

22

21

Note: Location according to Mr. Ball School

2°

FW Ball

COTTONWOOD

CREEK

50

C.L. Prindle 31

31

veyed June, 1927

7

0

Note: Streams not in th.
irrigated lands sketched.

18

17


16

19

20

21

COTTONWOOD

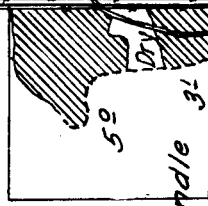

C.L. Prindle 31

31

Surveyed June, 1927

CREF

30


29

28

31

32

33

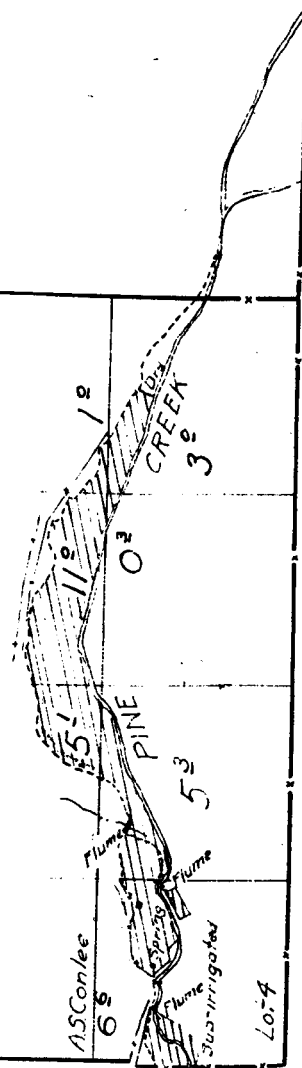

27


26

25

34

35

36

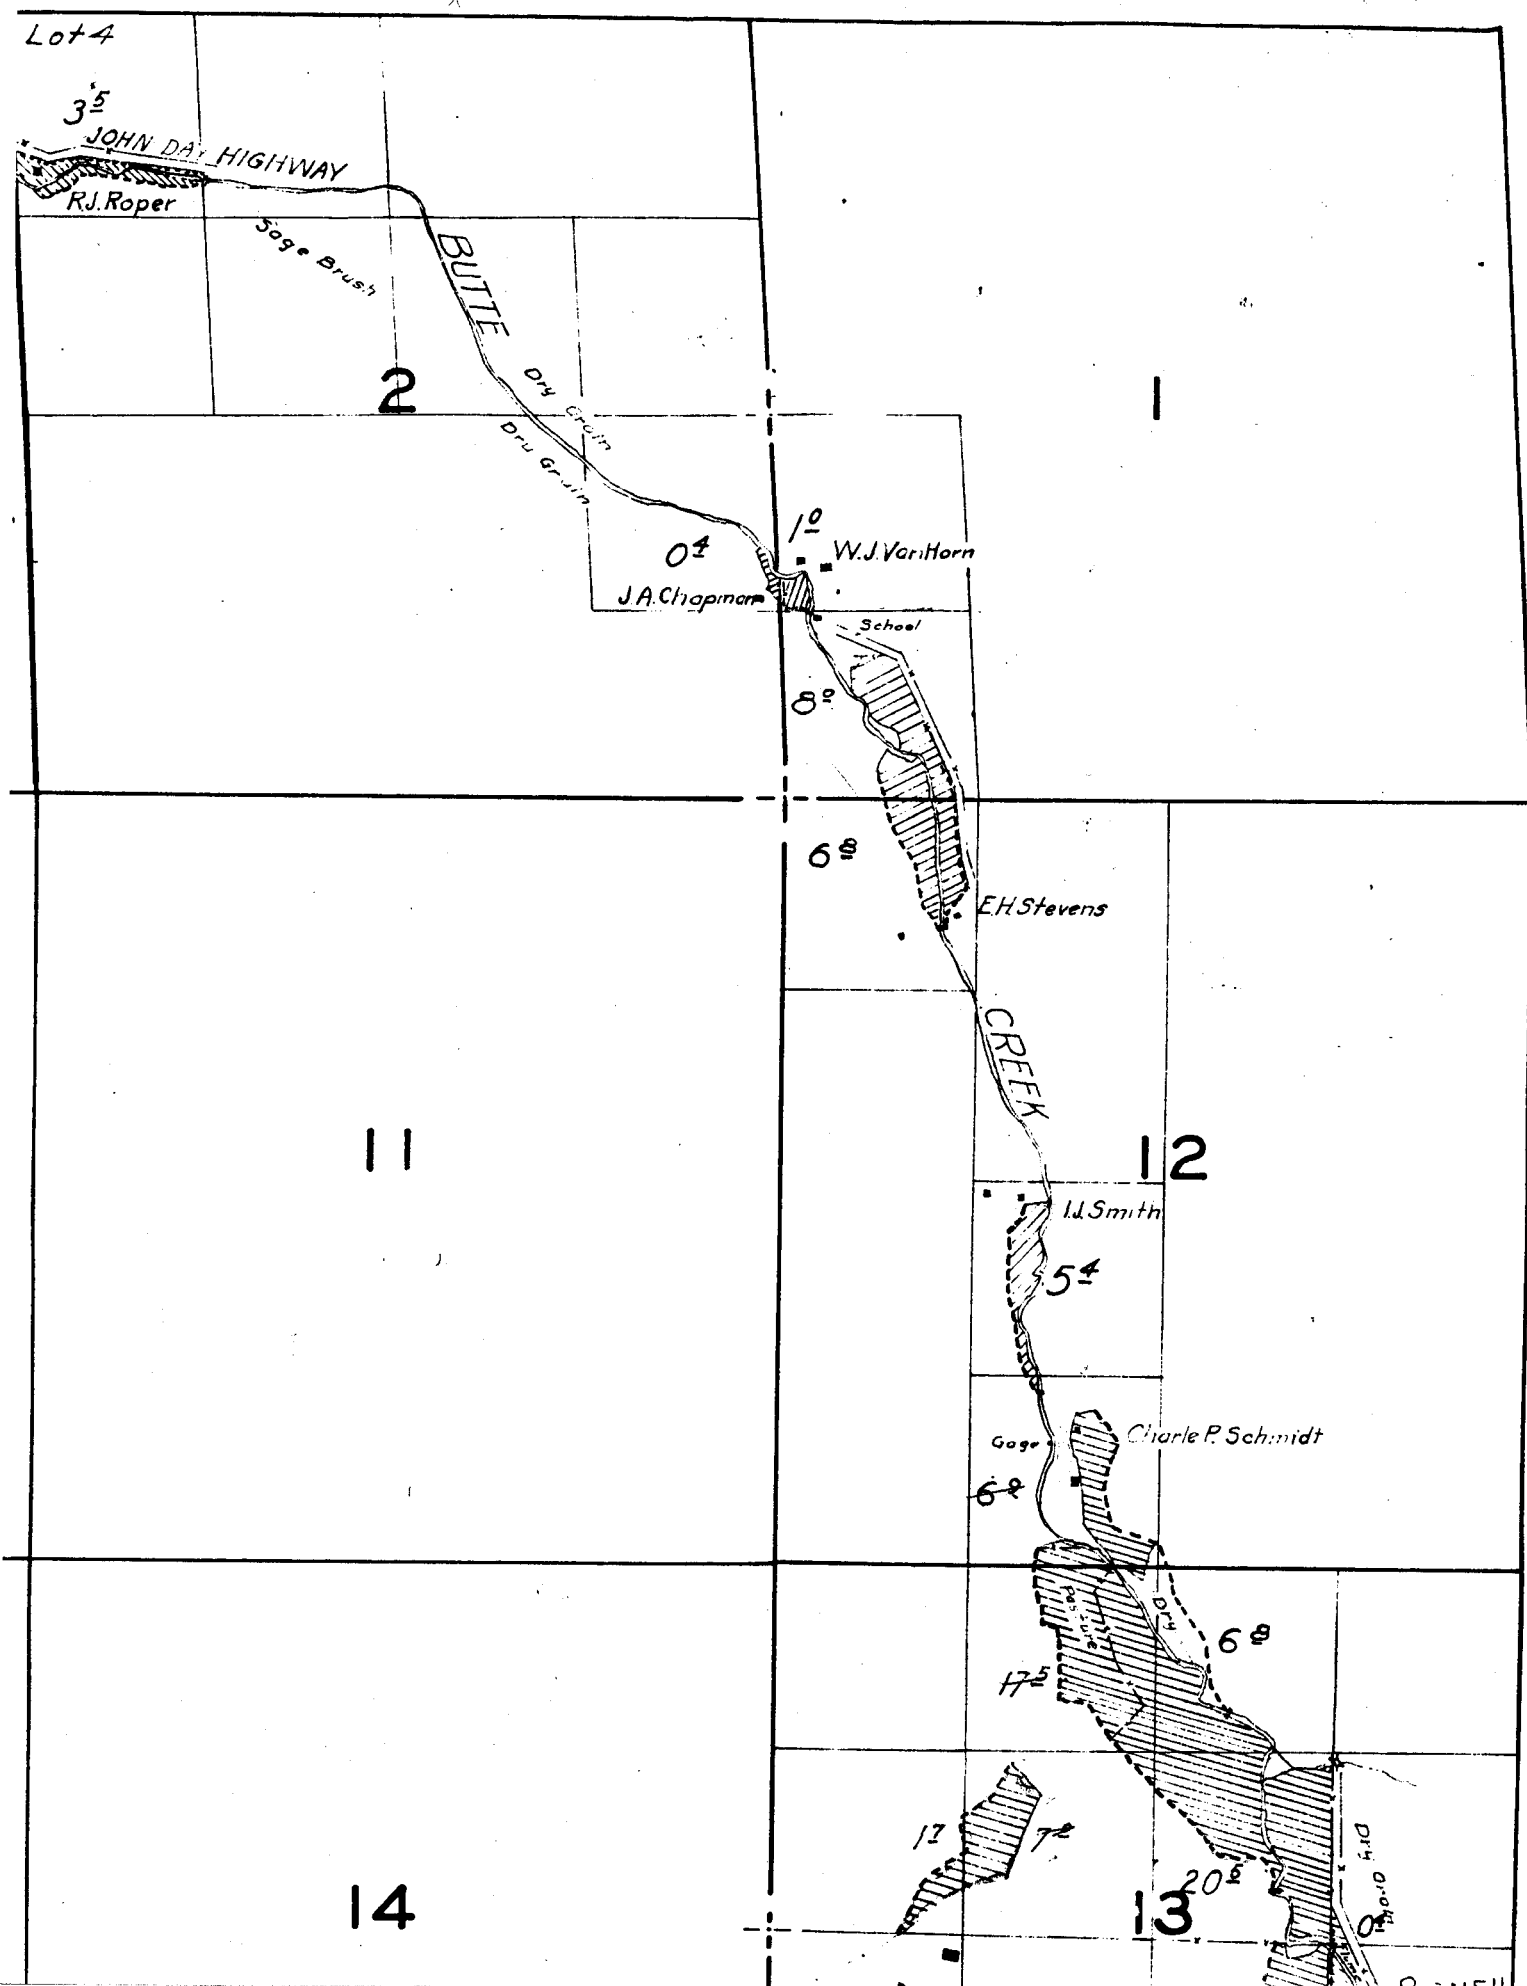

15

14

13

22

23

24

Location according
to Mr. Boll

