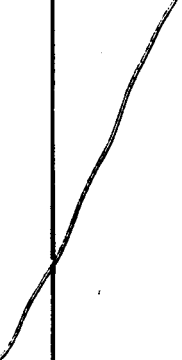
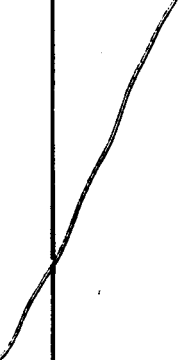
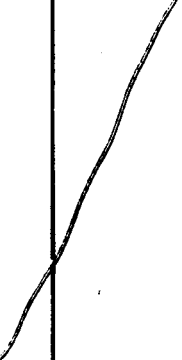
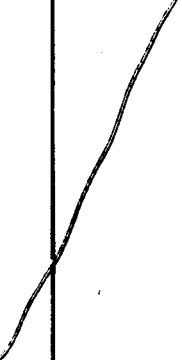



[illegible]

Location according to Mr. Boll	22	23	24
			

			

			

			

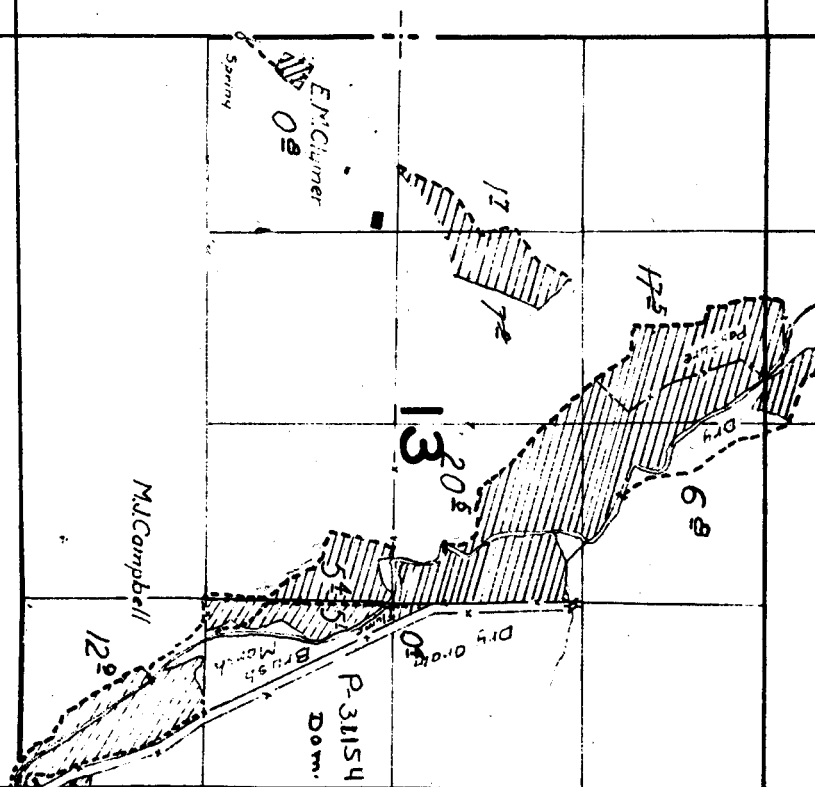

27


26

25


34

35


36

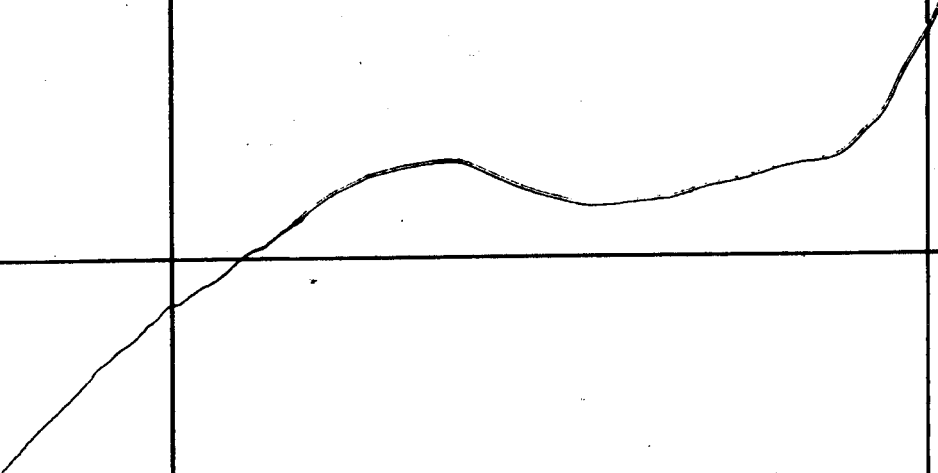

32-2-1

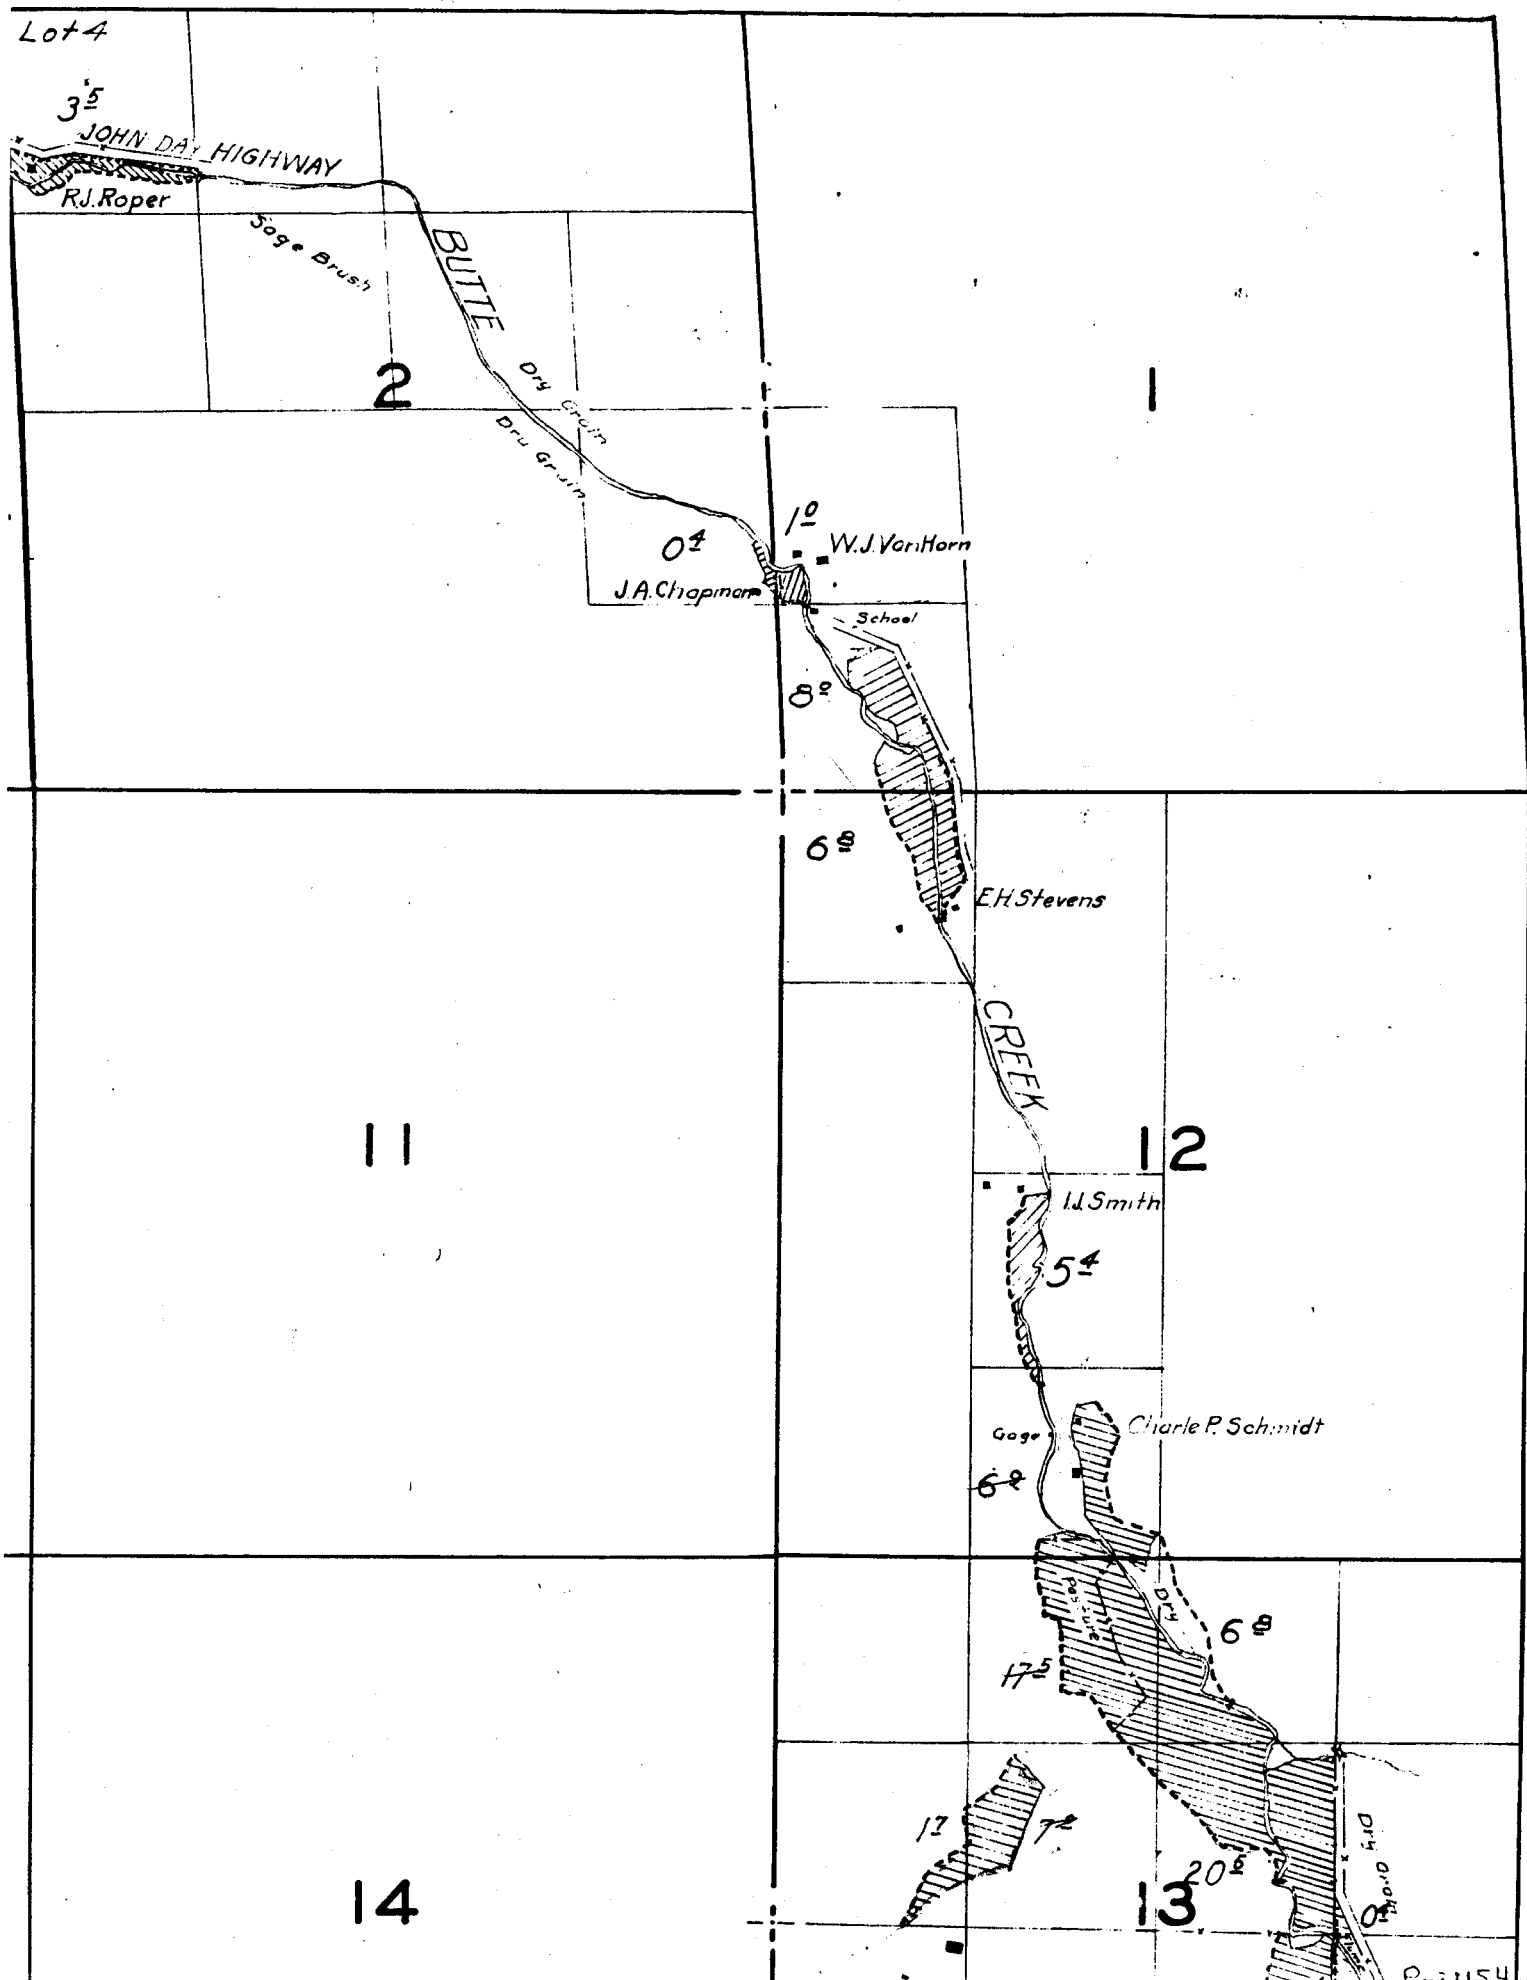

Note: Streams not in the
irrigated lands sketched

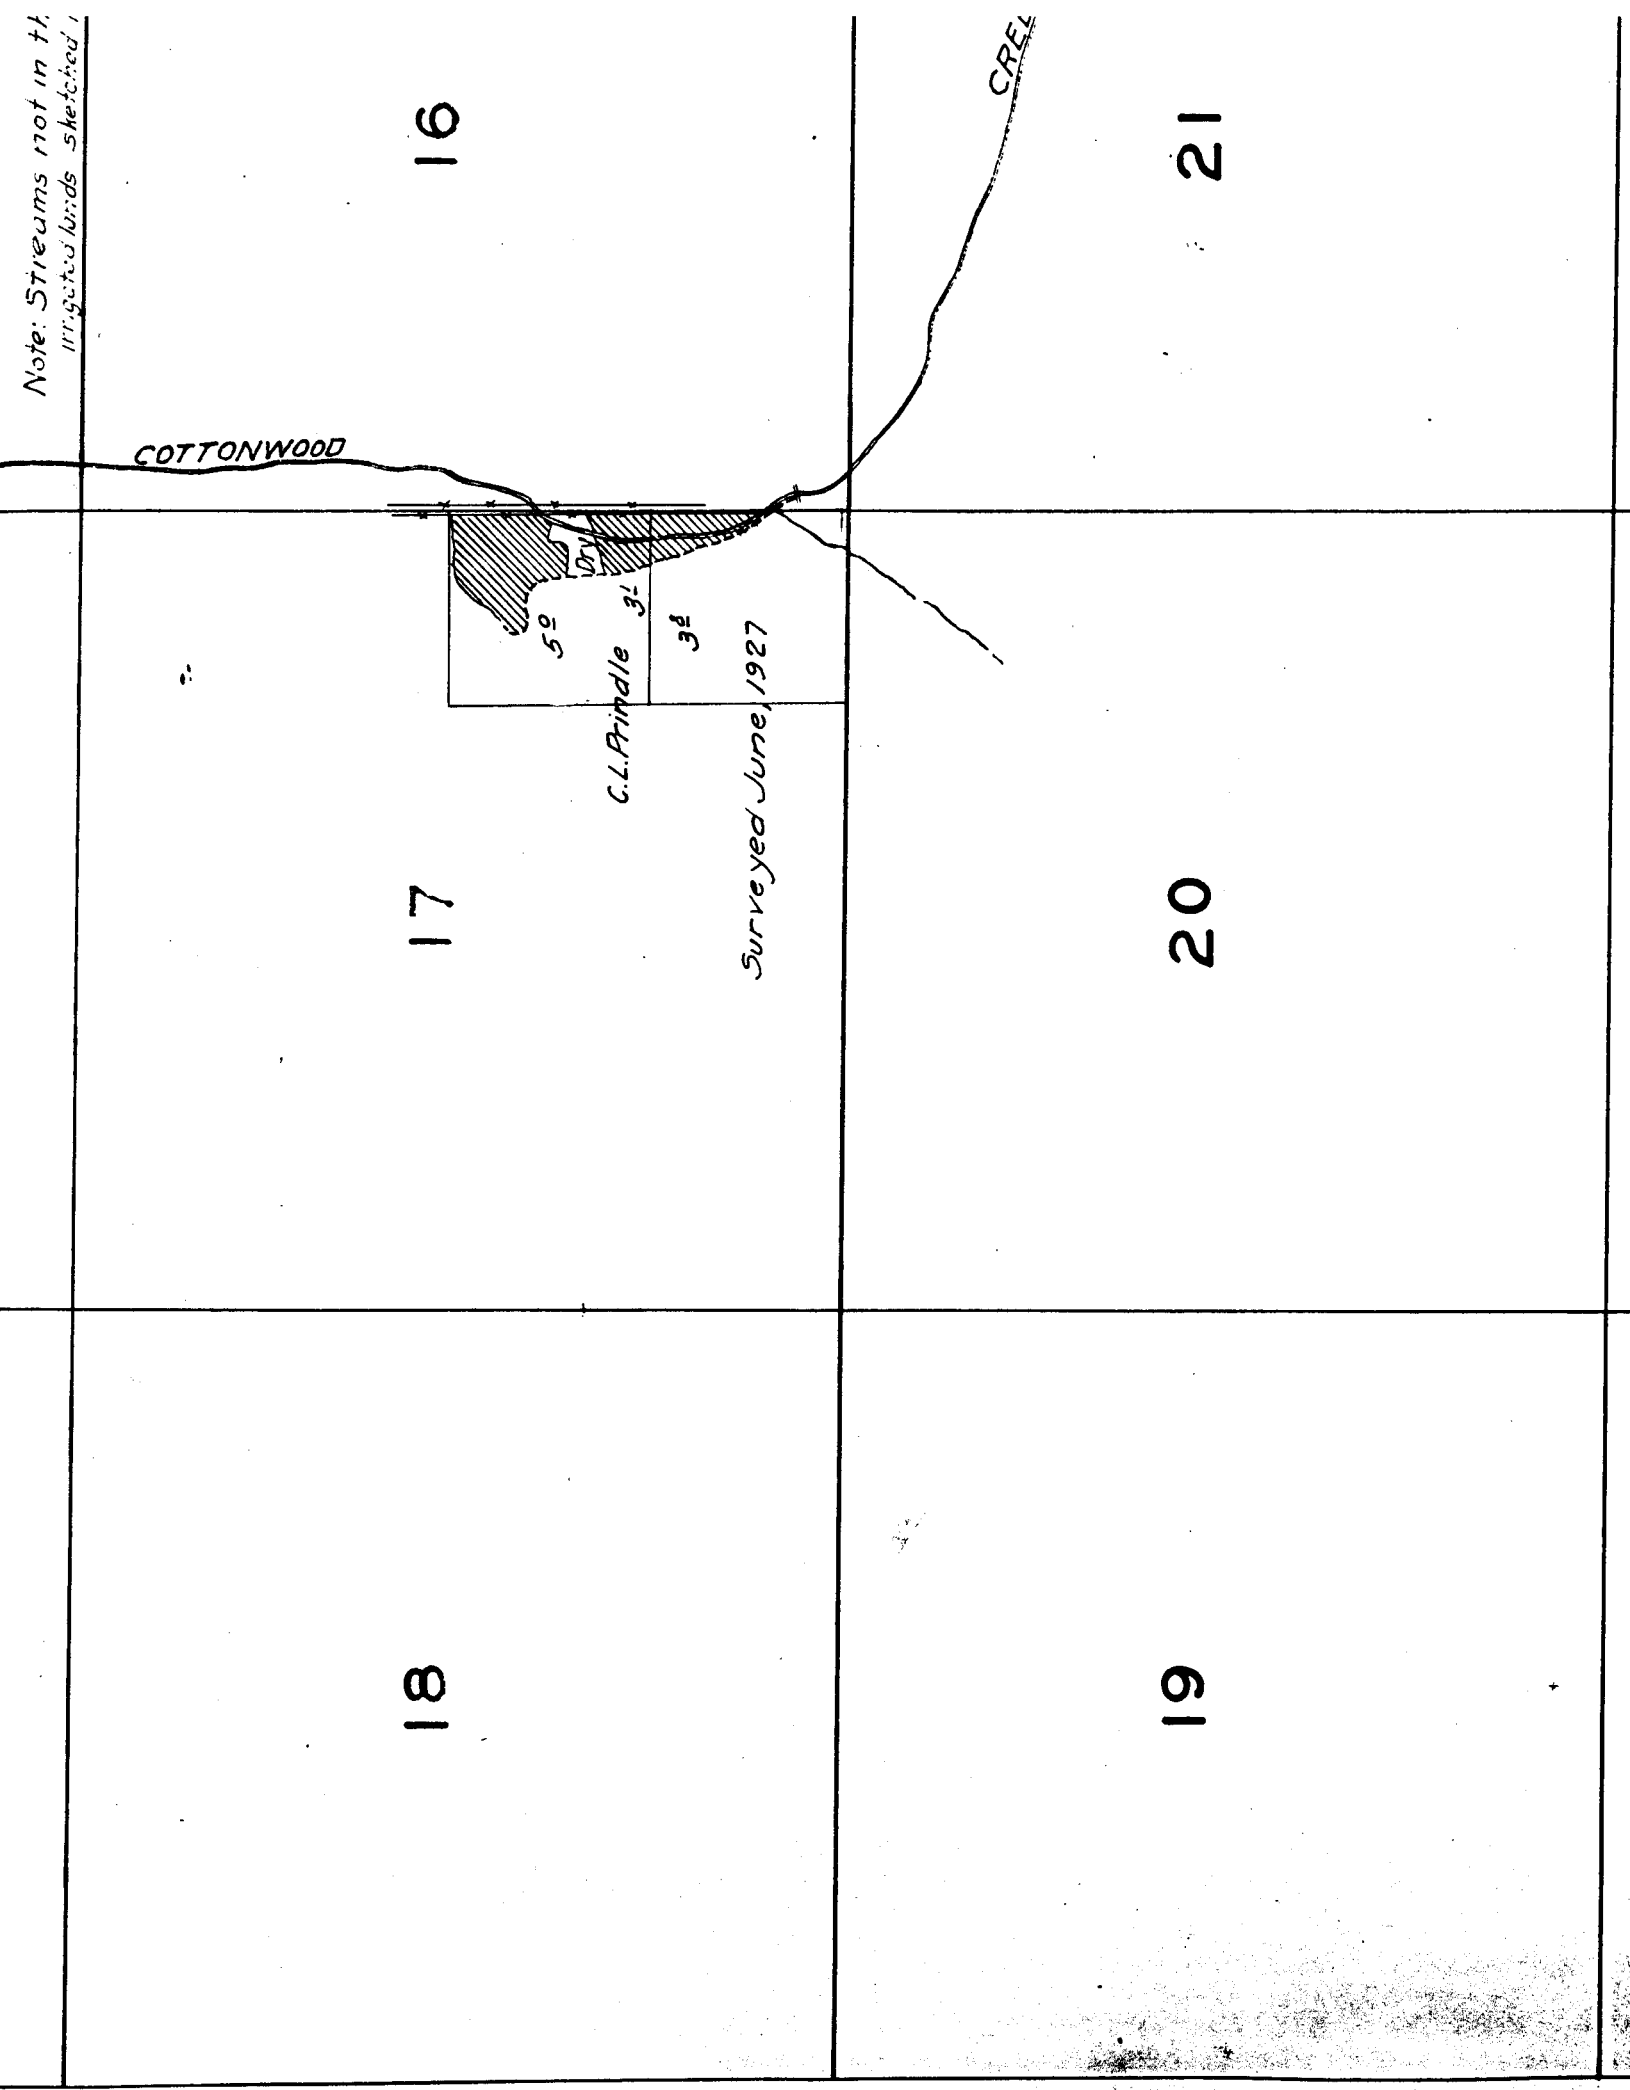

18

17

16

19

20

21

COTTONWOOD

50

C.L. Prindle

31

31

Surveyed June, 1927

CREK

28


33

29


32

30

31

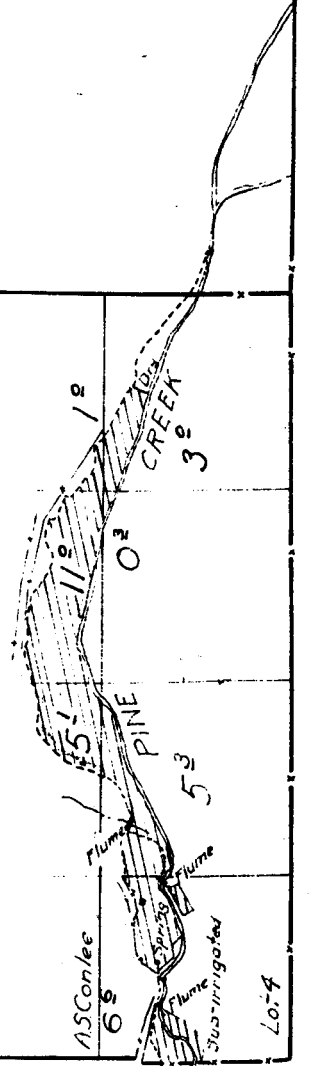

TOWNSHIP 7 S., RANGE 21 E.

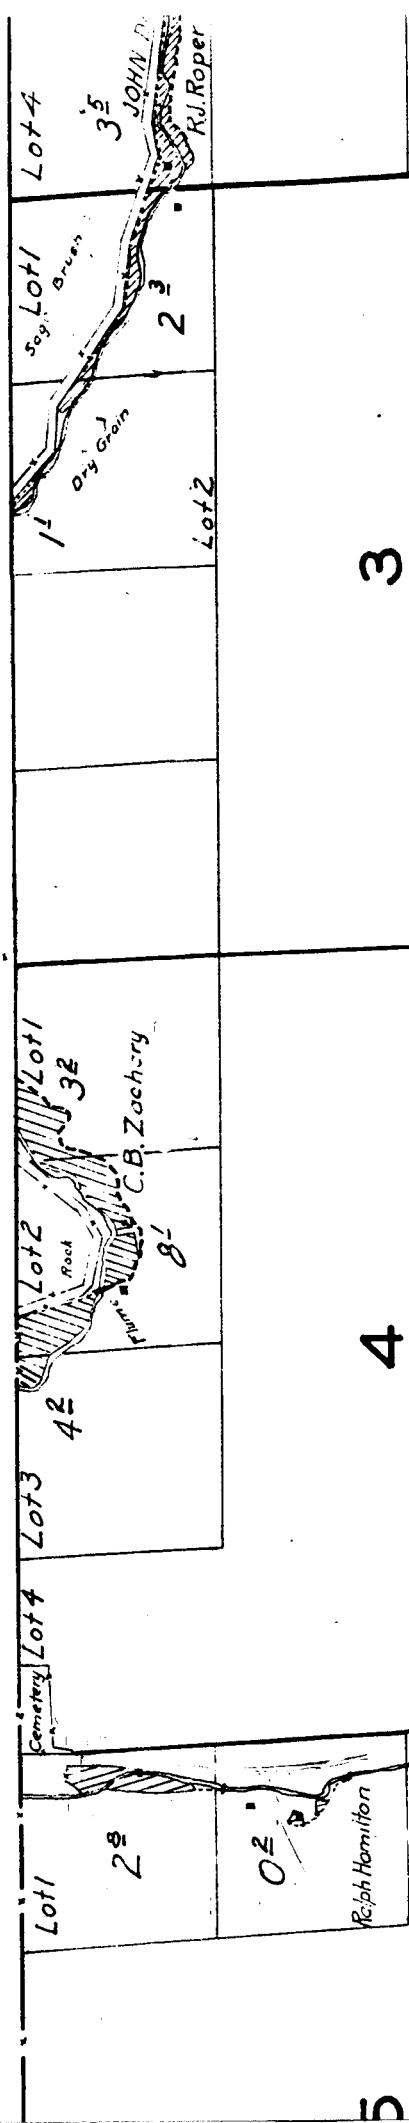

3

4

5

10

9

8

Note: Streams not in the vicinity of
irrigated lands sketched in approximate location.

COTTONWOOD

7

16

15

50

C.L. Prindle 31

31

veyed June, 1927


CREEK

0

21

22

Note: Location according
to Mr. Ball.
School
FWBall
2°

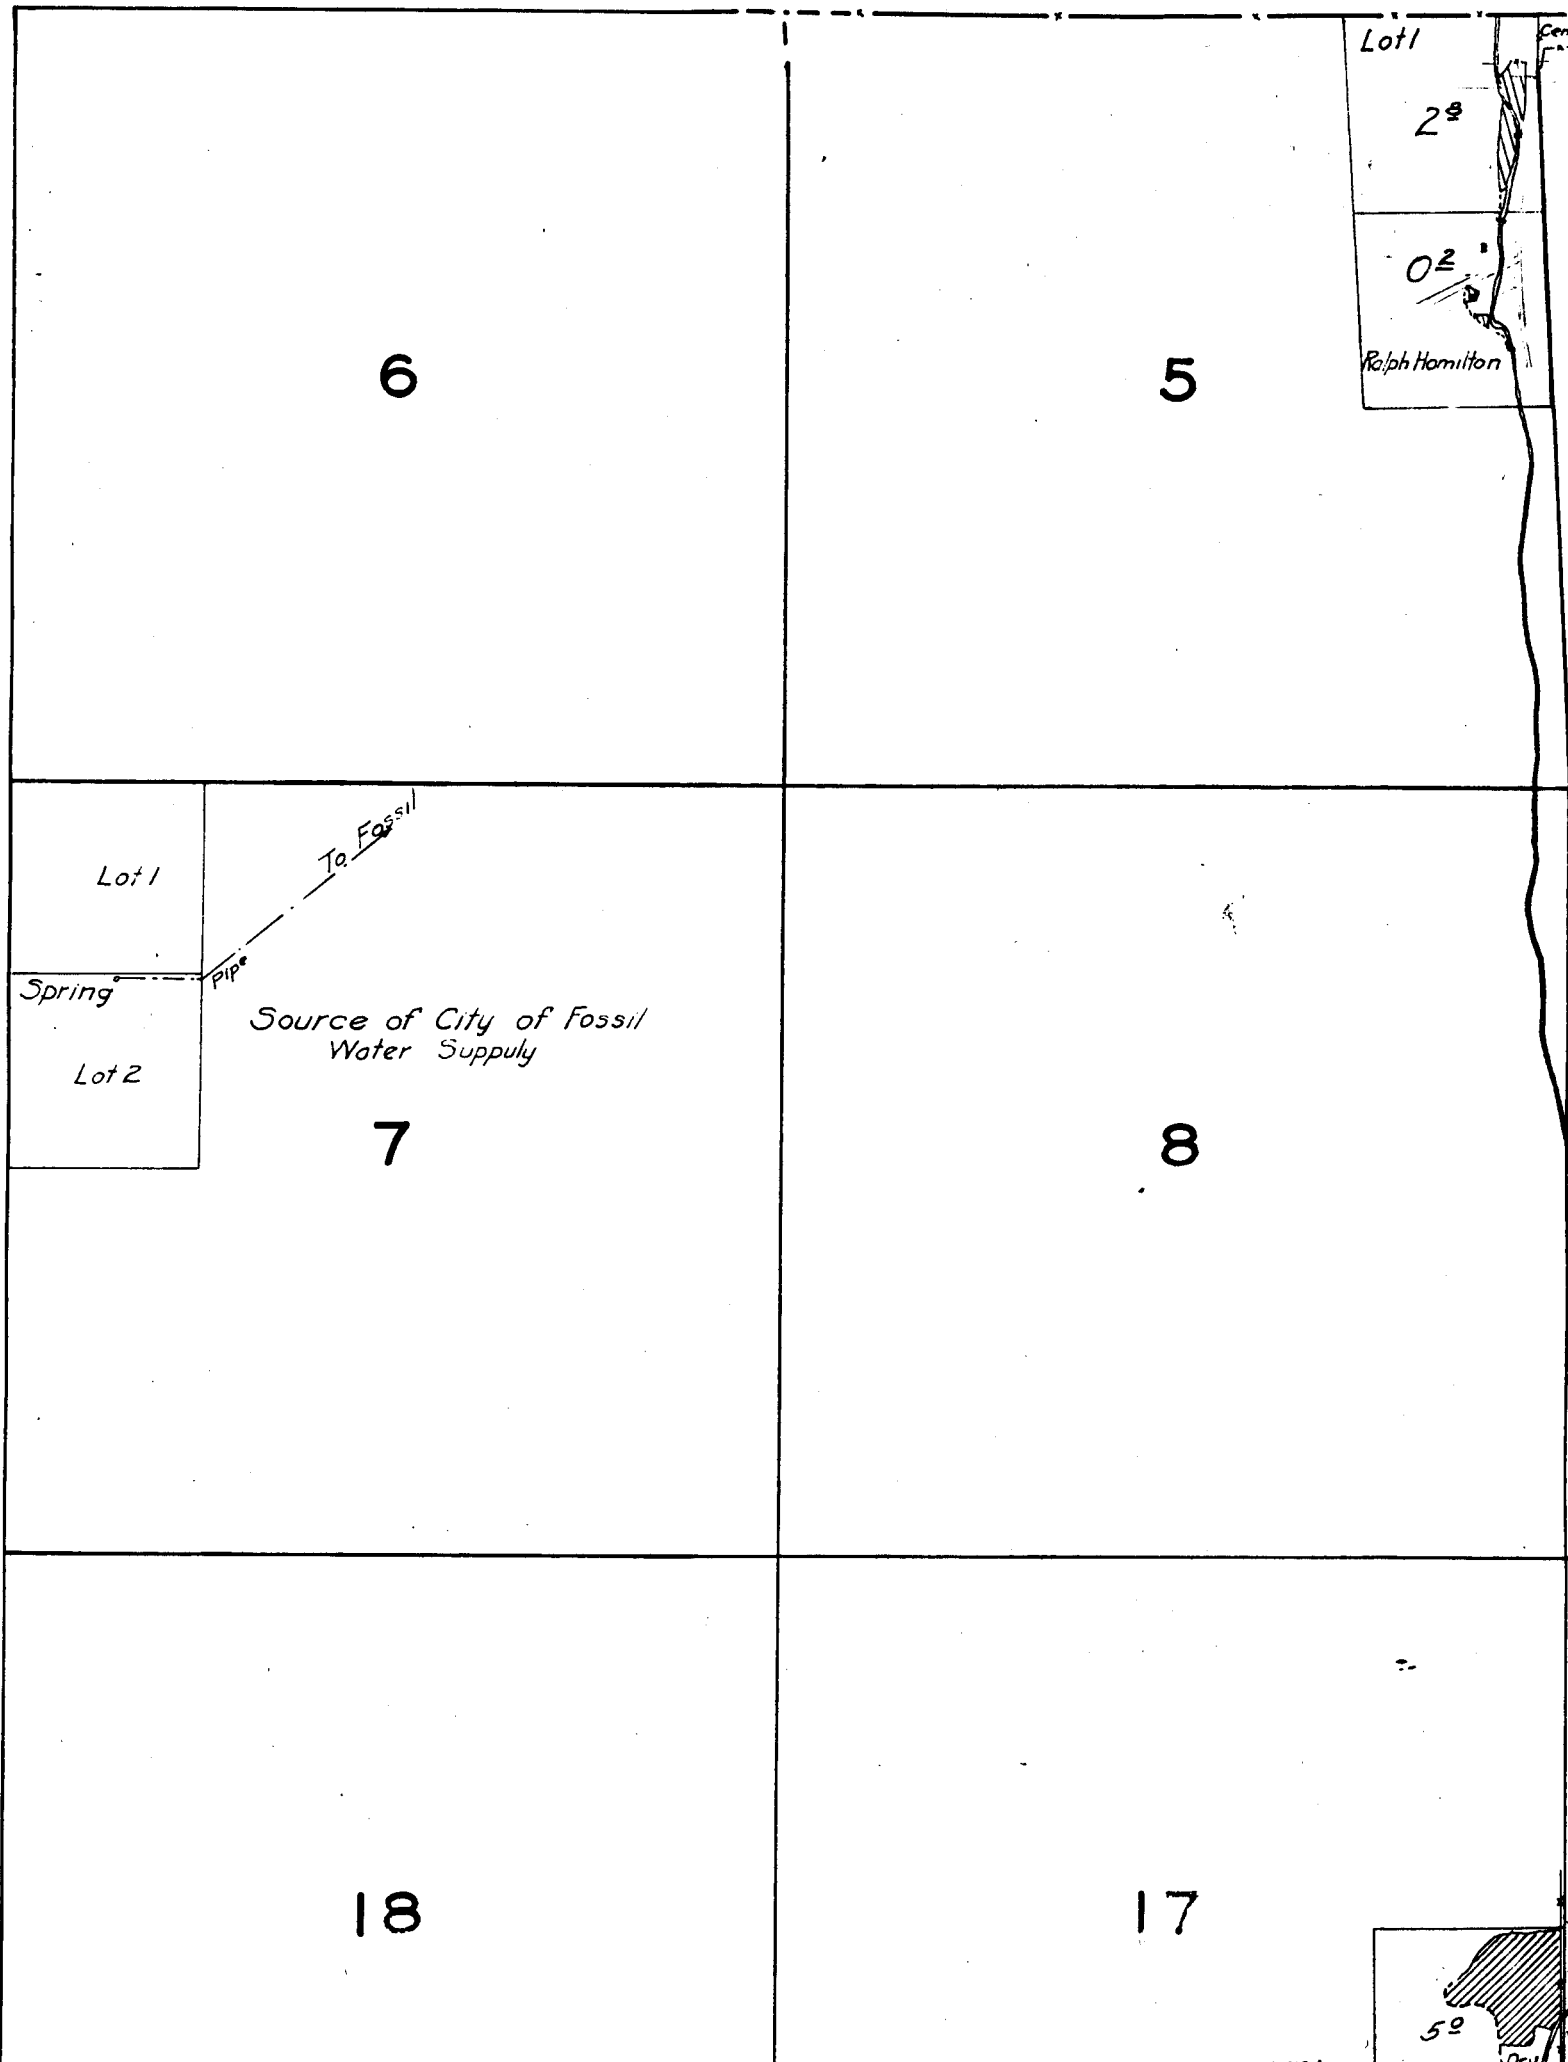

21

22

2^d
F.W. Ball

*Note: Location according
to Mr. Ball.*

School

28

27

33

34