

21

22

76

4°

35

Spring

L.H. Donarvon

113
CREEK

12

175

42

HAYSTACK

Bob Wright

J.F. Asher

28

27

Spring

175

Surveyed Sept. 19 to 23, 1926

Steiner

5°

C.W. Walls

16

A.E. Cress

12

33

34

40° Now C-35285

27°

02

12°


218

32

Pump

P.H. Jenkins

TOWNSHIP 8 S., RANGE 25 E.,

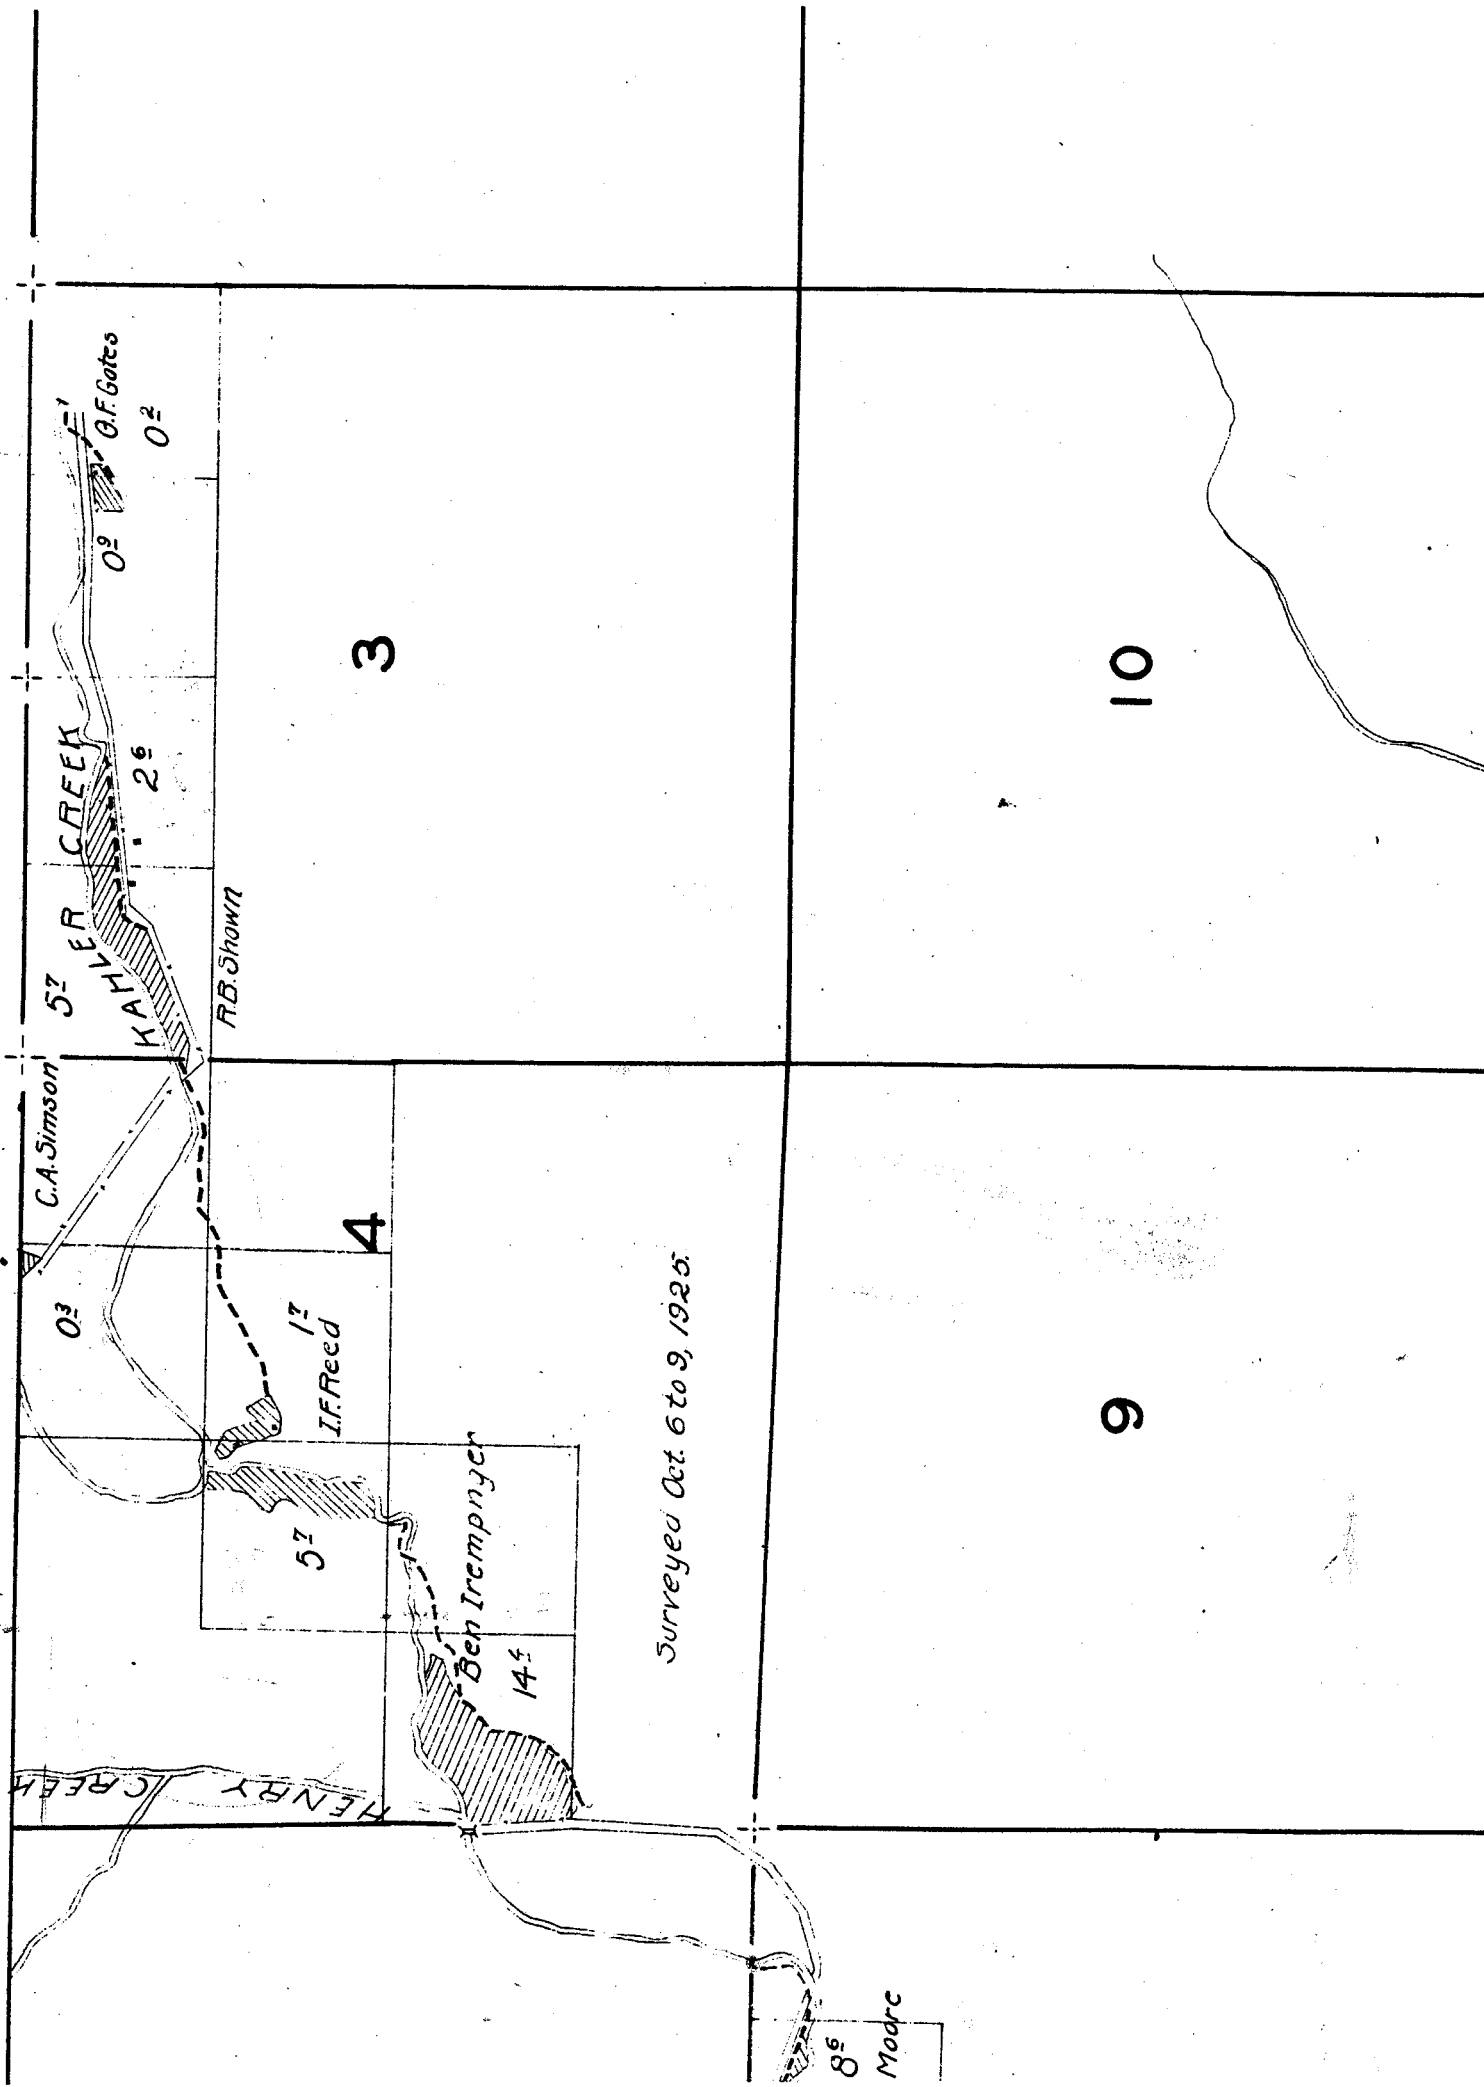

2

1

11

12

14

13

30

29

28

31


32


33

Surveyed Sept. 29, 1925

Surveyed Se

First National Bank
London
05

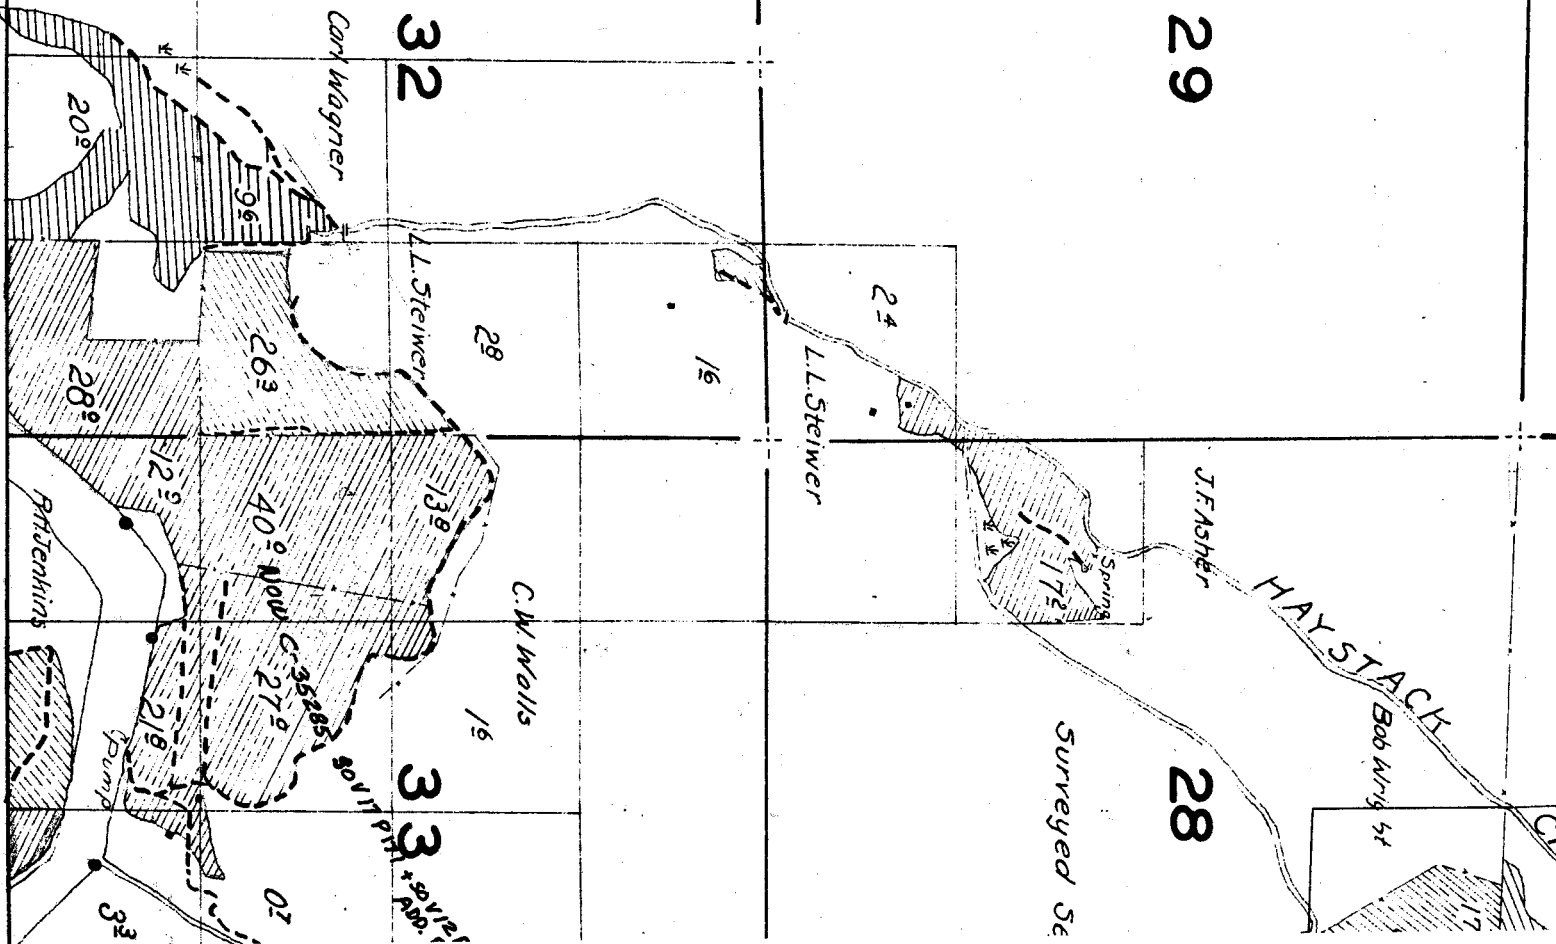

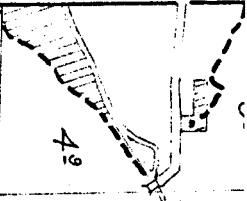

AS Borges

18

17


16

19

20

21

Note: Location of streams and roads, except in the vicinity of irrigated land, is sketched in approximate location.

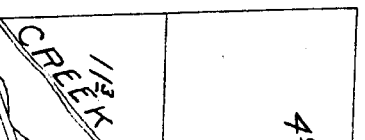

Surveyed Sept. 29, 1925.

Balm Cr.

27

26

25

34

35

36

15

14

13

22

23

24

IVE'S CREEK

02

62

RJ Corner

17

05



6

5

7

13

03

8

page 8^e
E.R. Modre

07

4⁹

A.S. Borges

18

17

Note: Streams and Rivers except in the vicinity of irrigated land, sketched in approximate location.

30

29

28

MATHIS
31

32

33

Surveyed Oct 29, 1925

0-1
N.Y.O.N.
Mrs Mary Adams

Spring

Baugh

18

17

16

19

20

21

21

22

28

27

Surveyed Sept. 24 and 30, 1925.

33

34

Baughn

0³

6²

ump

Snable

JOHN DAY RIVER

TOWNSHIP 8 S., RANGE 24 E.

	4	3	<i>Surveyed.</i>
1925.	9	10	


50.

15

22

16

21

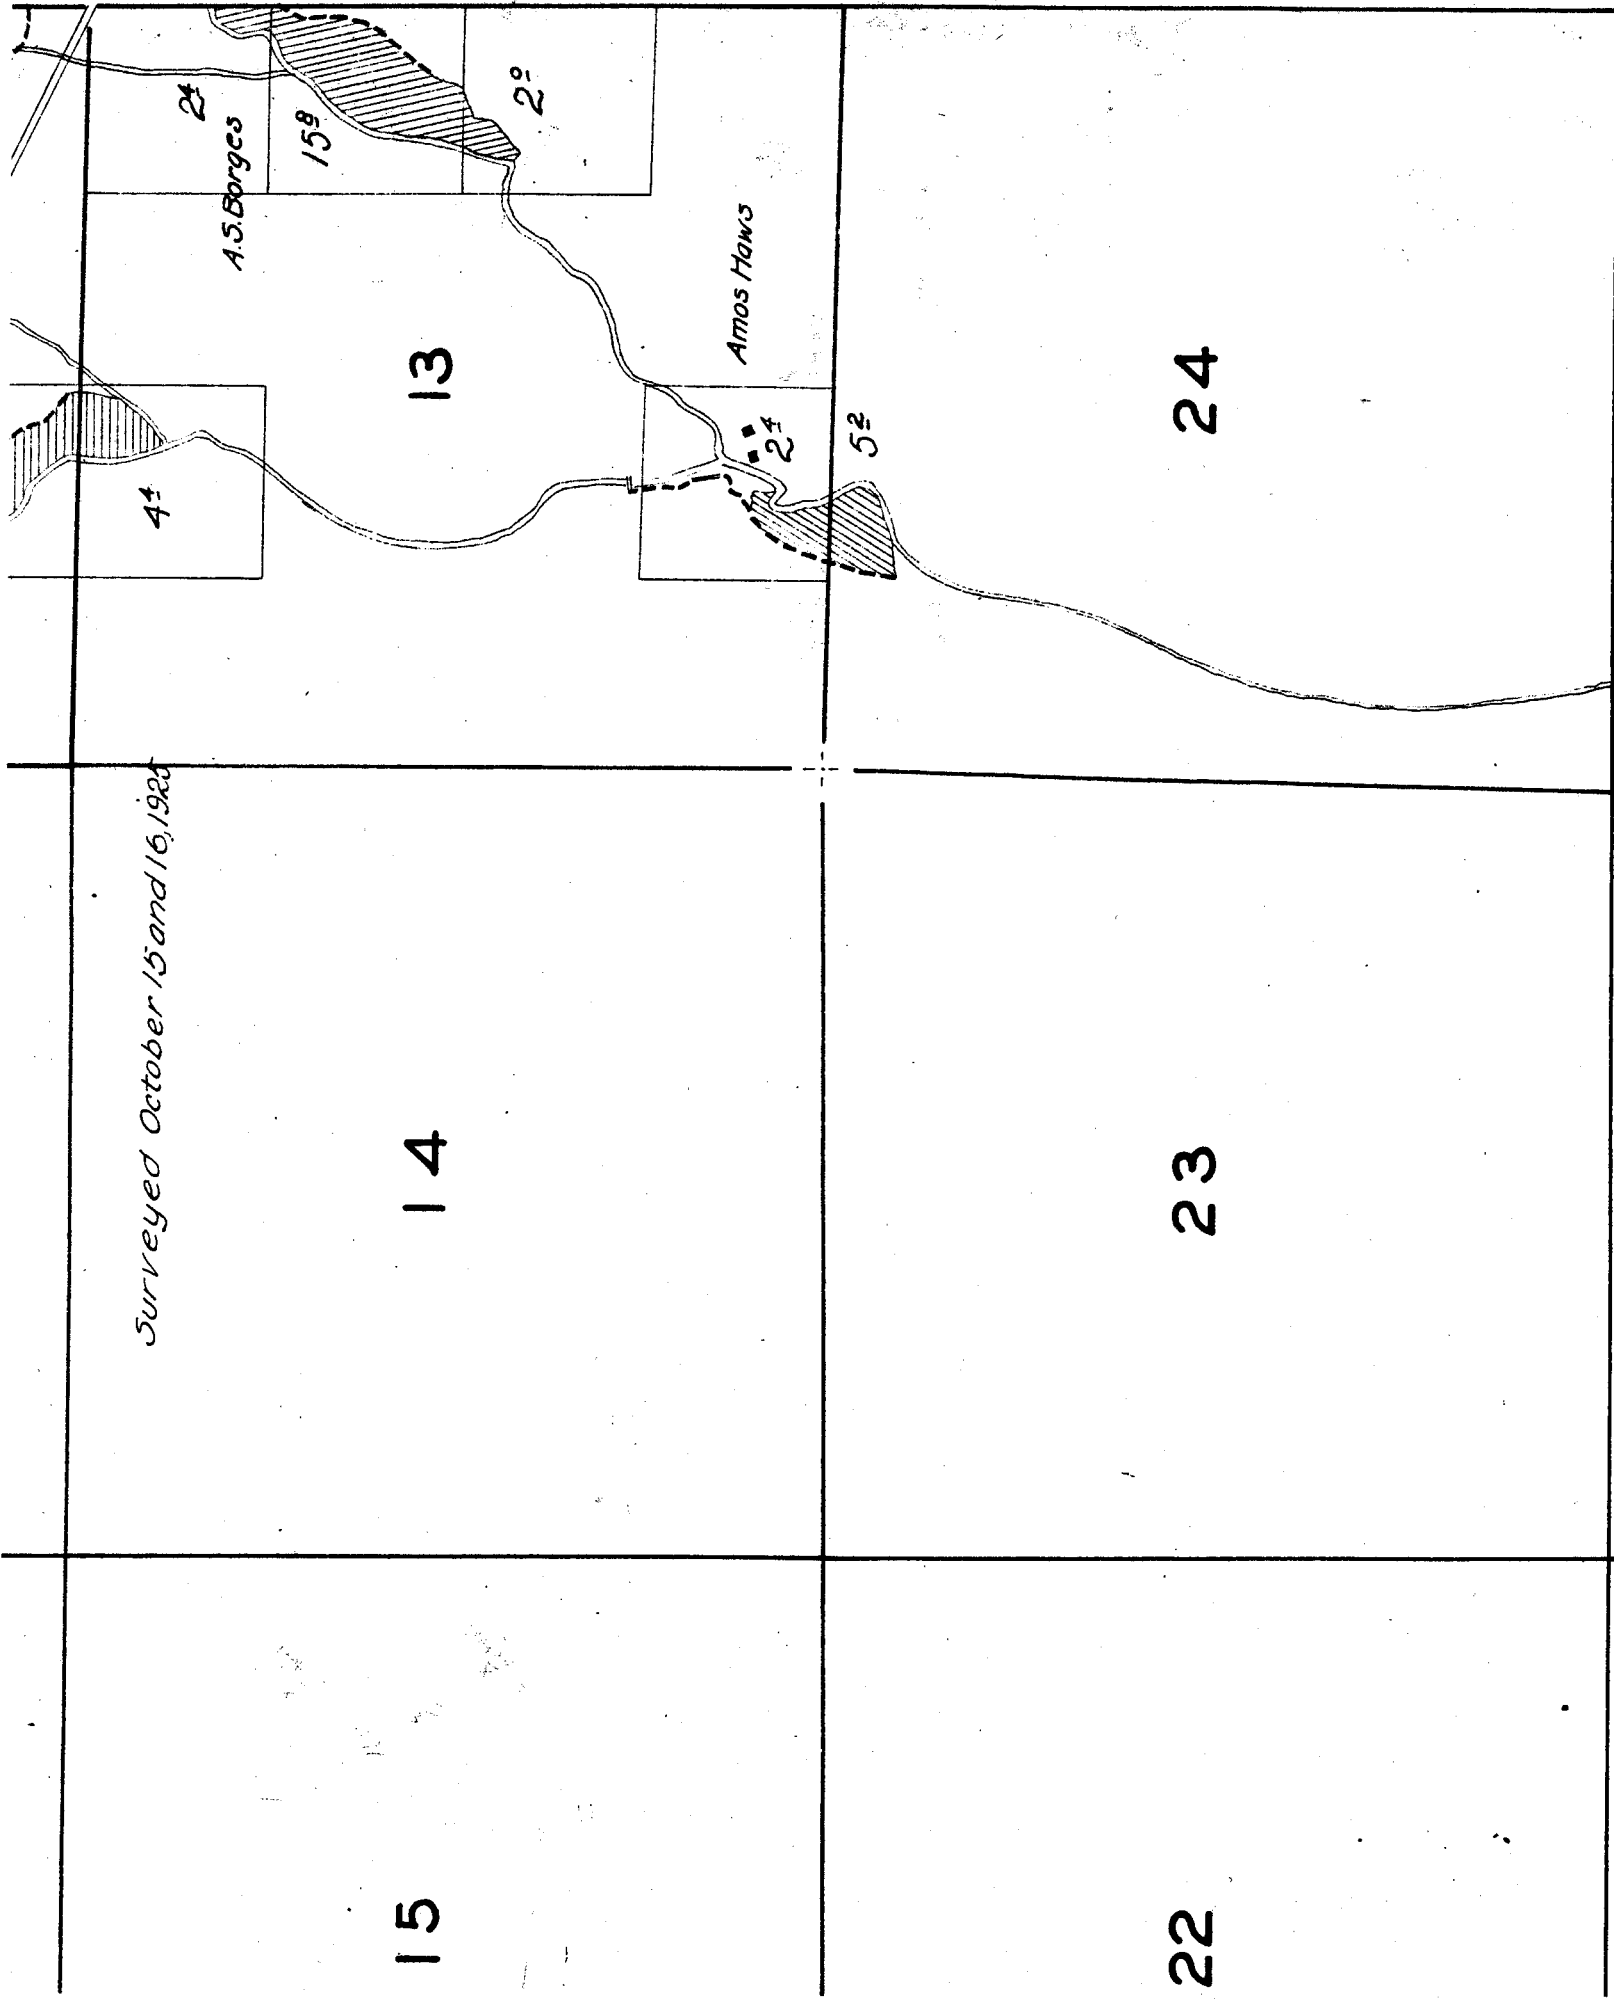

27

26


25

1 Sept. 24 and 30, 1925

34

35

36

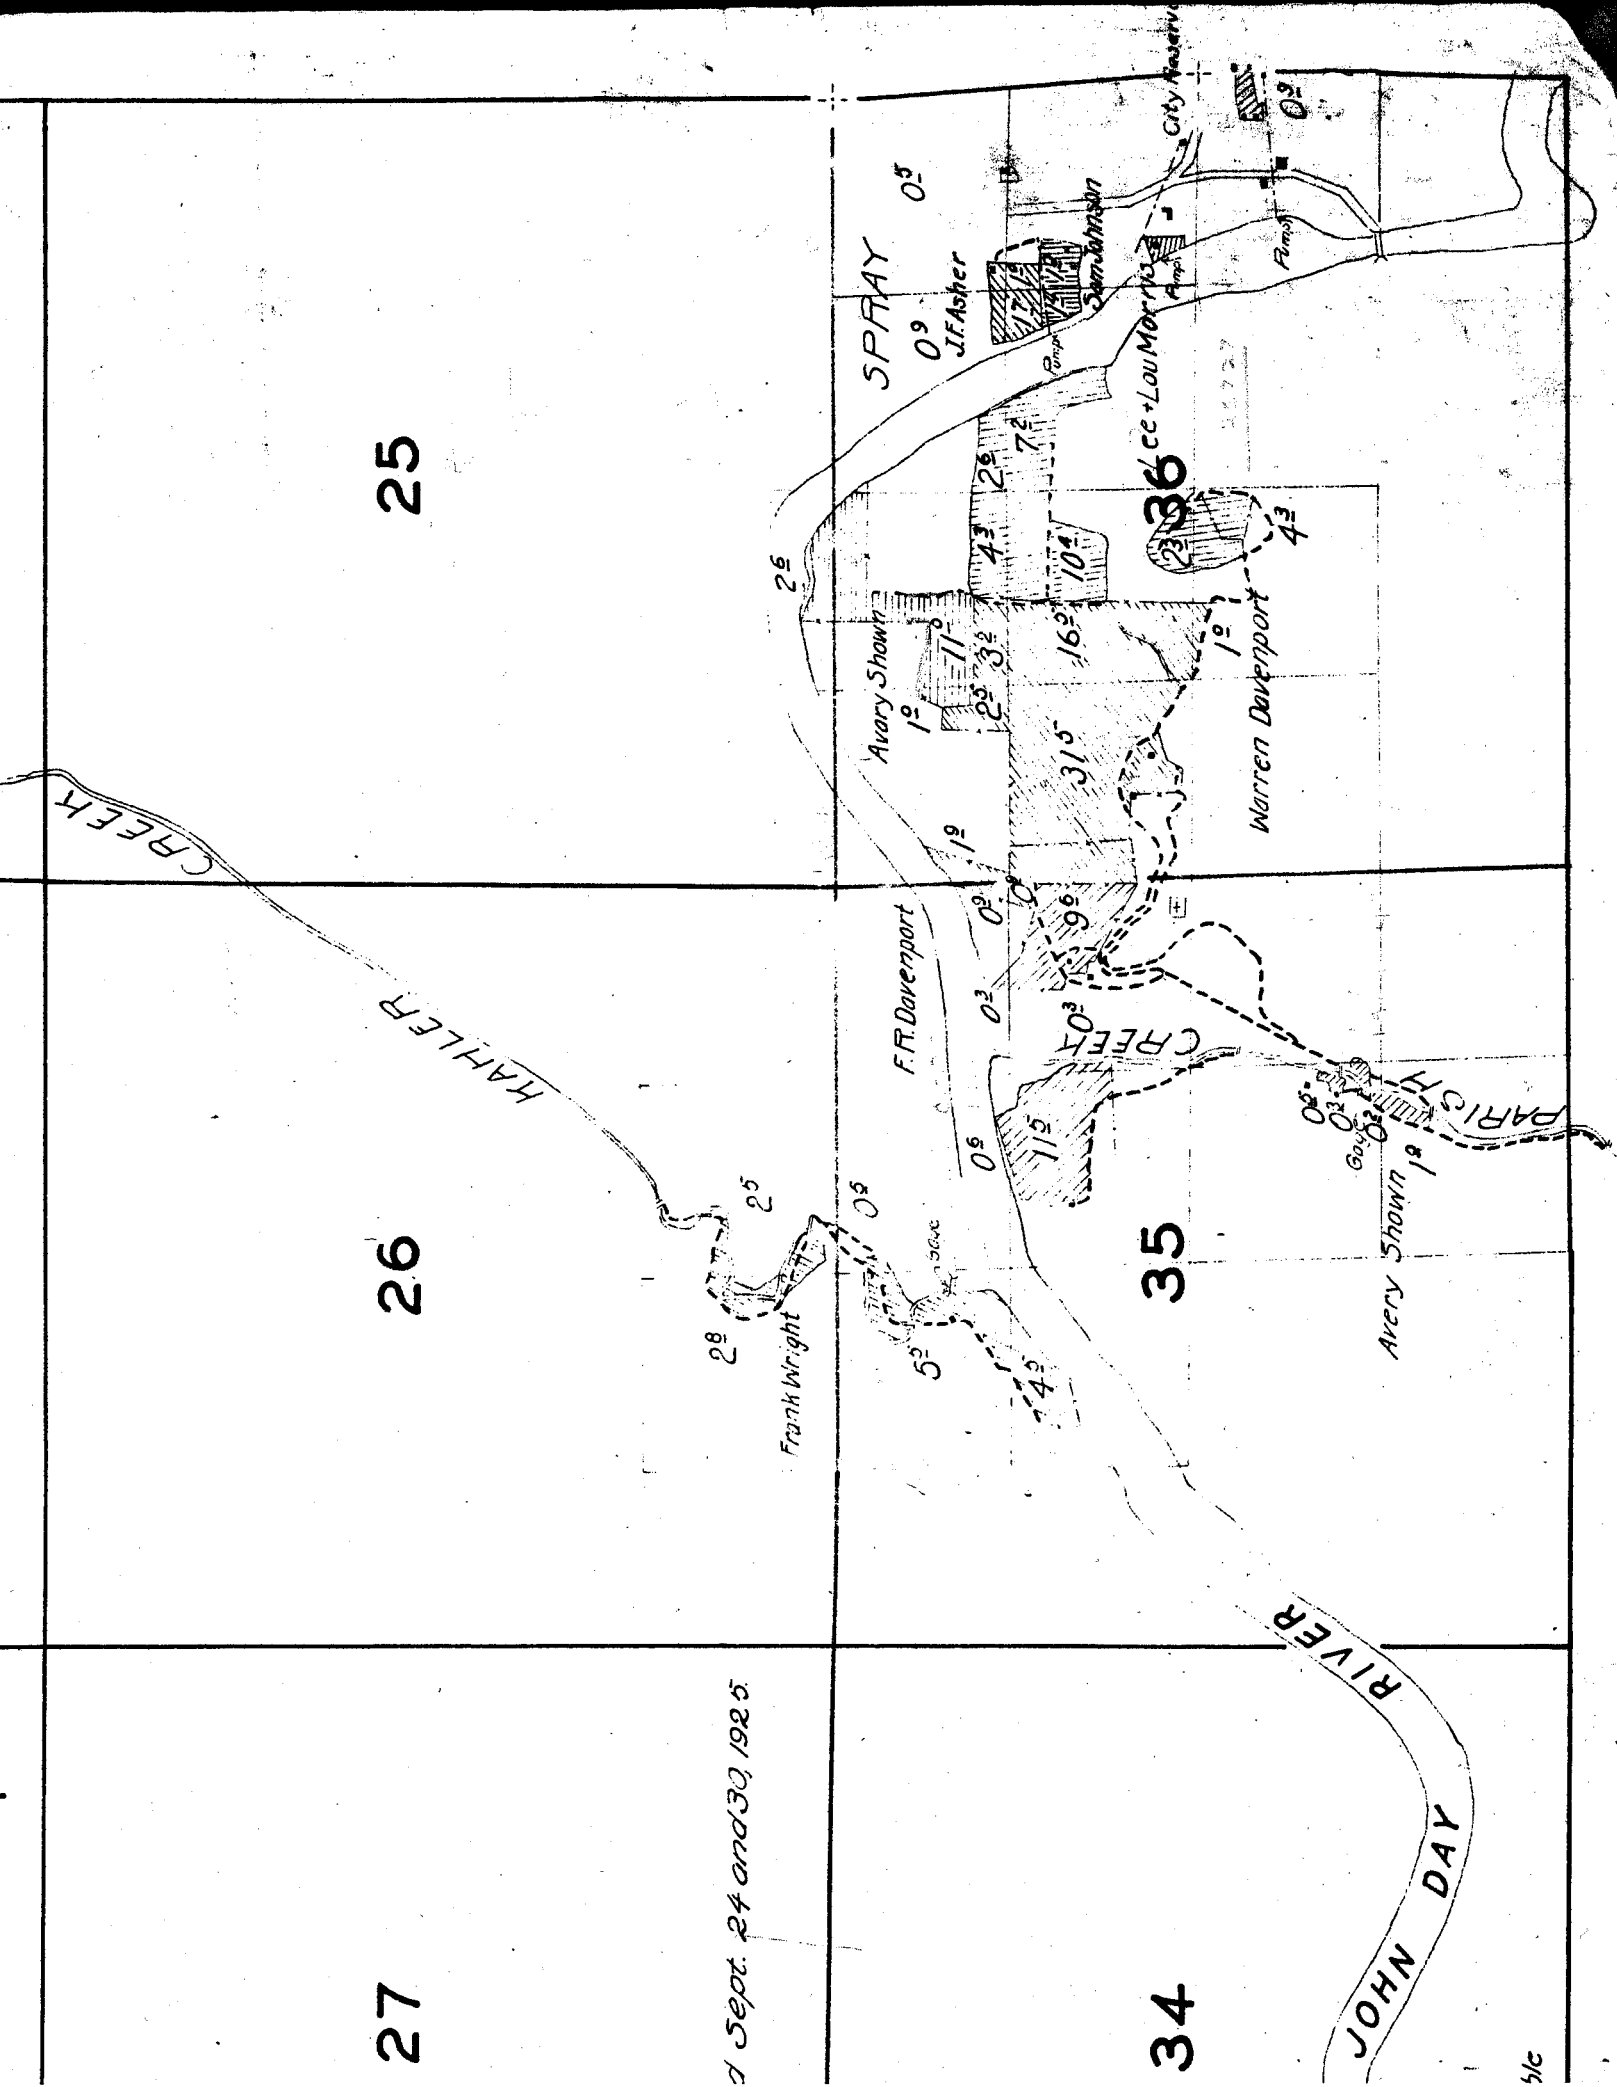

18

17

8

7

Surveyed October 16, 1925

5

6

Elmer McQuinn

Mrs Elmer McQuinn

CREEK

ALDER

Lot 4

138

Lot 3

09

Lot 2

04

Lot 1

Spring 24

24

20

10


10

08

37

20

Lot 4

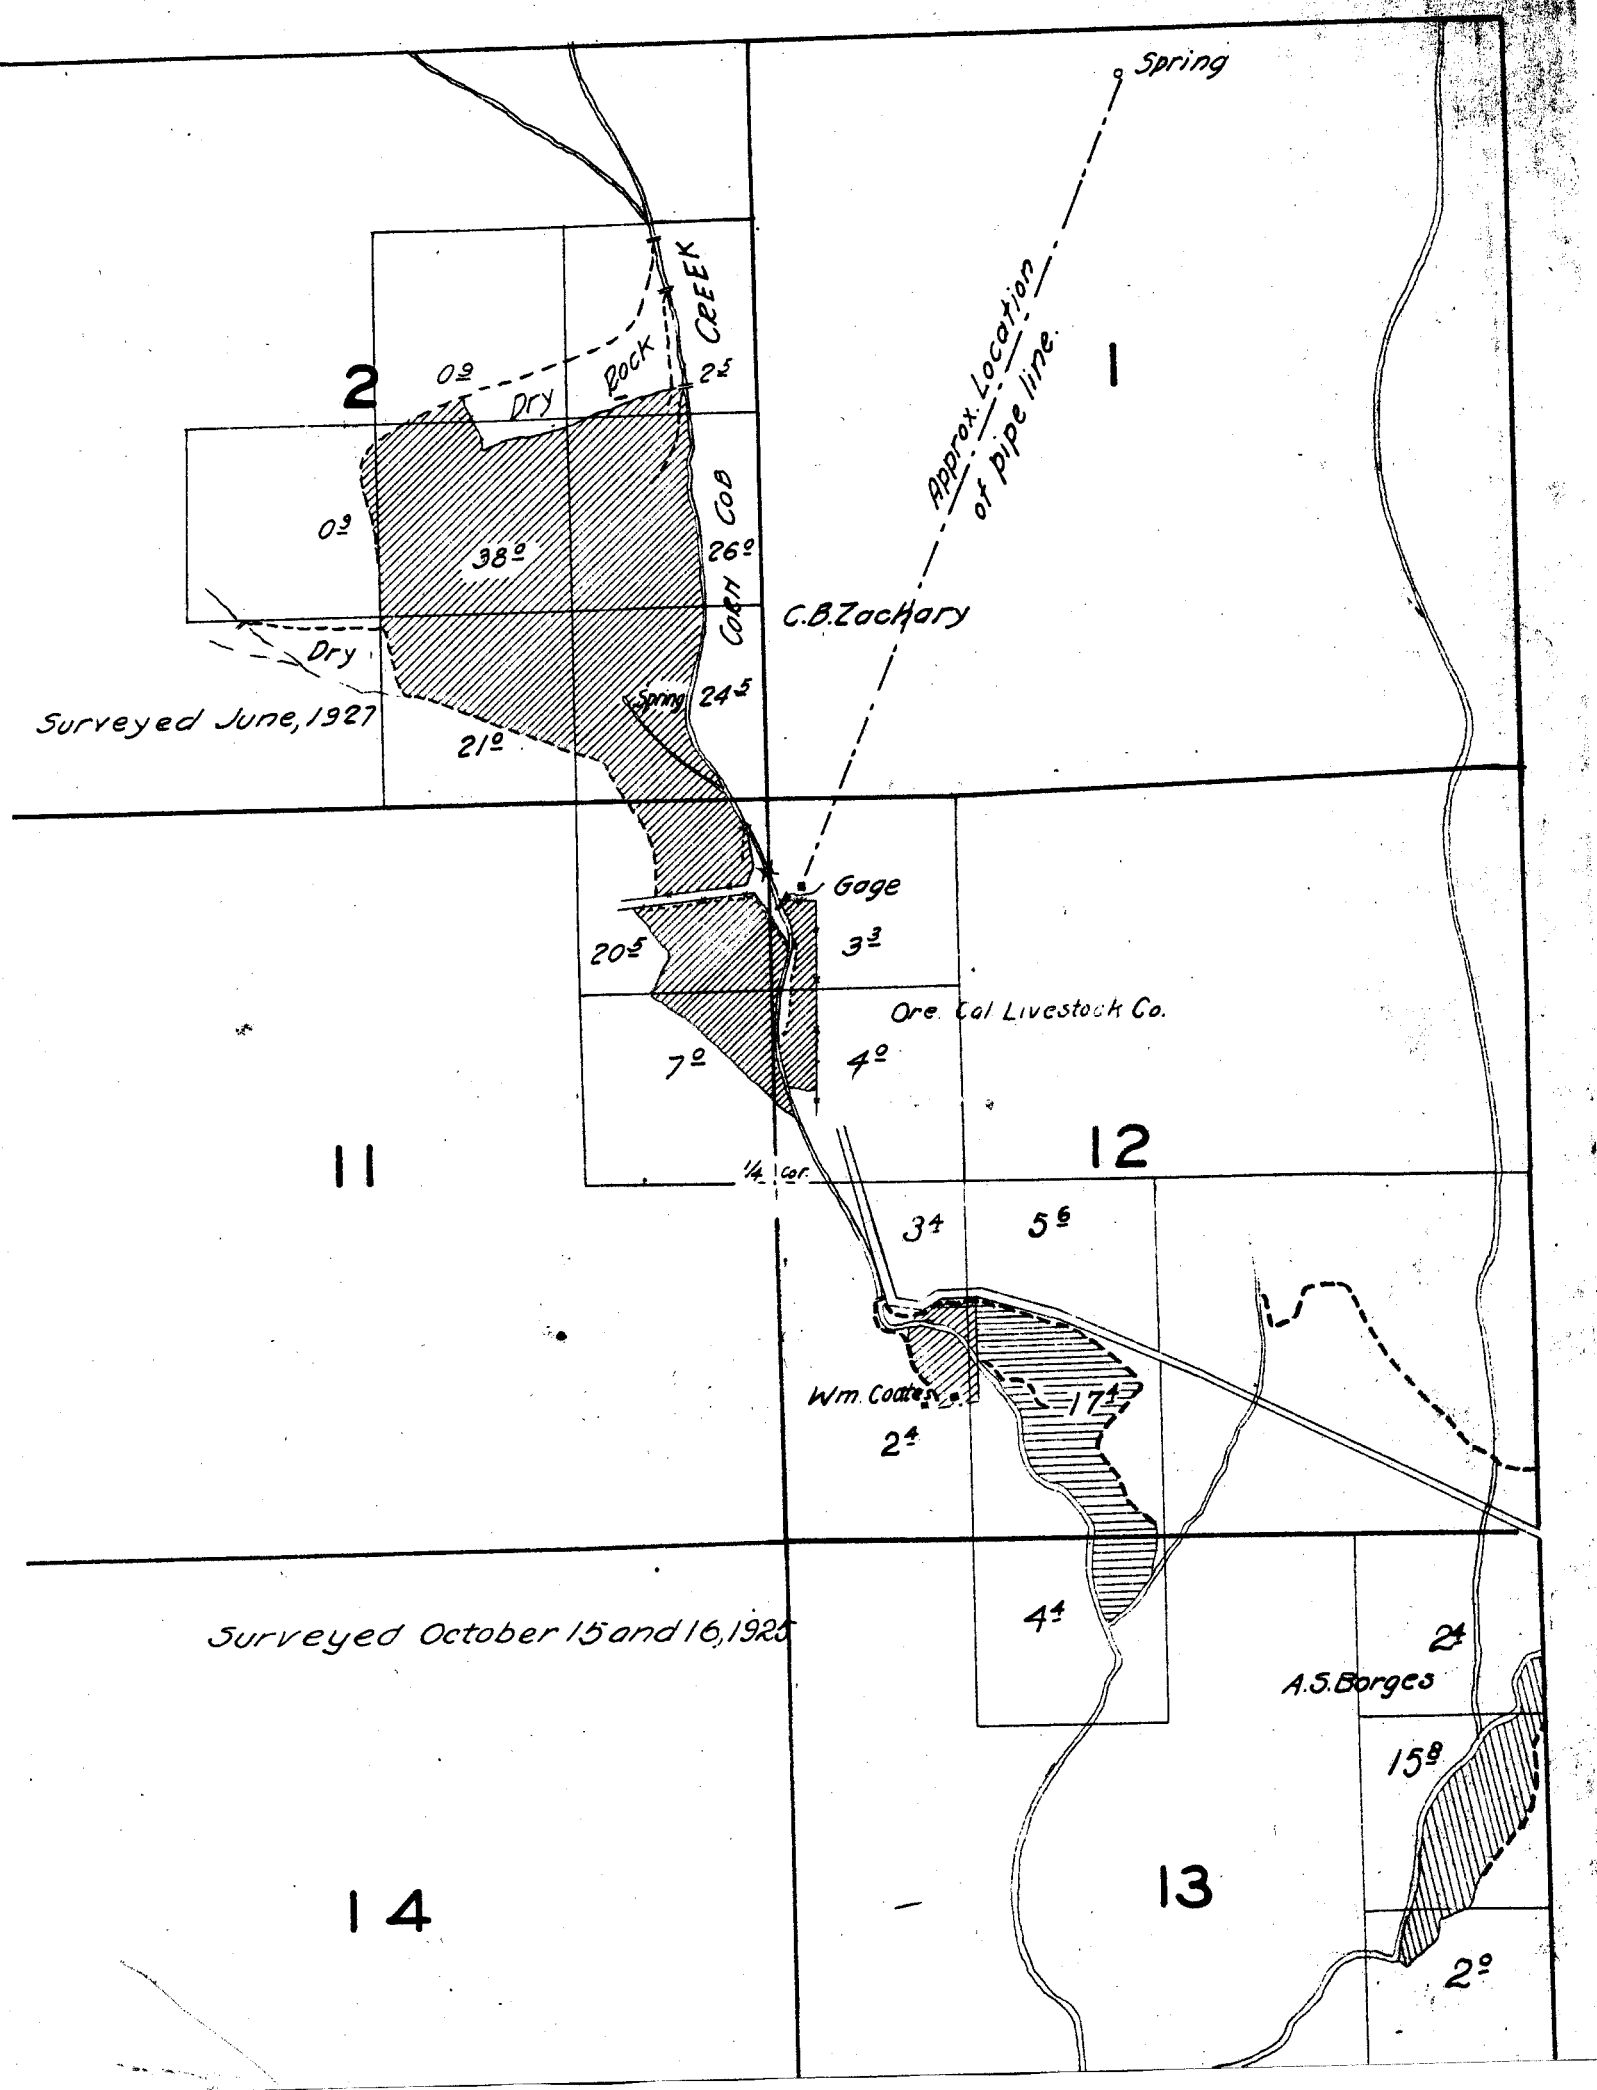


15

22

16

21

L.H. Donovan

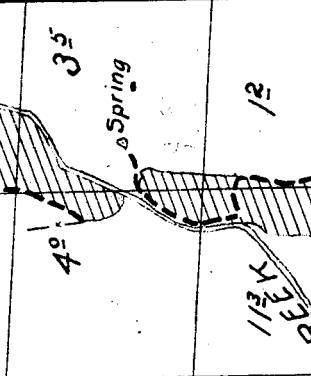

As, except
nd, is
ation.