

21

22

John Welch

2²

Brush

Sage

E.F. Loomis

28

27

0¹0⁵

ROWE

JOHN DAY

Meadow

Parson Estate
W. L. Wheeler
(D.M. Grinds)

33

34

Watering Trough

Charlie Shown

Pipe line is not
shown in exact location.

12" Pump

C.W. Thomson
(John Hawkins)

6

5

7

8

18

17


56-2-2

2

1

12

11

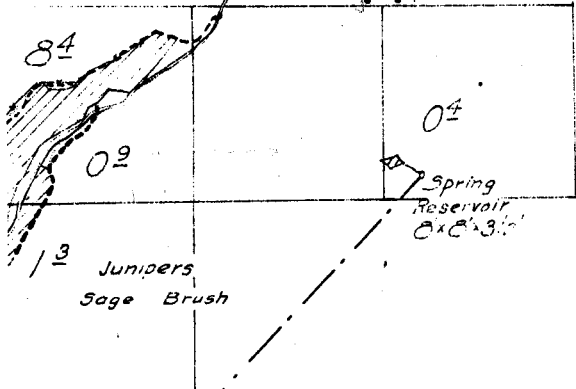

Note:— Location of pipe
line sketched in field.

14

13


TOWNSHIP 9 S., RANGE 21 E.

4

3

9

10

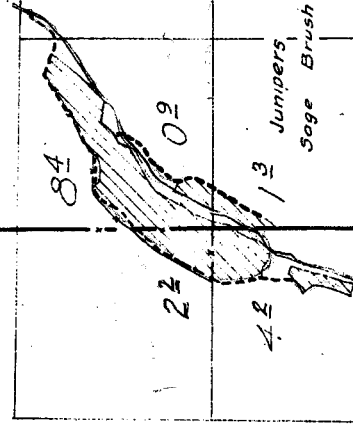

Sage Brush

Not
line

G.W. Kimber
(J.H. Bory)

Surveyed Aug

5²

Tom Huntington

7⁵

15

Flume

CREEK

7³

10⁹

10³

23²

10³

10³

13⁵

36⁰

15⁵

25⁷

6⁸







22

Gage

Brush

Flume

Sage Brush






























John Welch

30⁵

19⁴

2²

16

21

of irrigated
etched in

30

29

28

31

32

33

Watering :



18

17

16

19

*Note: Except in the vicinity of irrigated
lands streams and river are sketched in
approximate locations.*

21

27

26

25

Parson Estate
Wm L. Wheeler
(DM Grindstaff)

Pipe line is not
show in exact location

Spring
Reservoir
6164314

Joe Chapman

Henry Keys

TWICKINHAM

12" Pump

School

JK Bary

CW Thompson
(John Hawkins)

34

35

36

JAMES
CANYON

Note: Location of pipe
line sketched in field.

Tom Huntington

52

75

15

14

13

CREEK

12

73

107

G.W. Timber
(M. Bory)

232

105

60

135

60

Sage

Dr. C. B. Bory

Surveyed Aug. 30, & 31, & Sept. 1, & 2, 1926.

22

23

24

7c