

15


14

22

23

24

Location according
to Mr. Boll

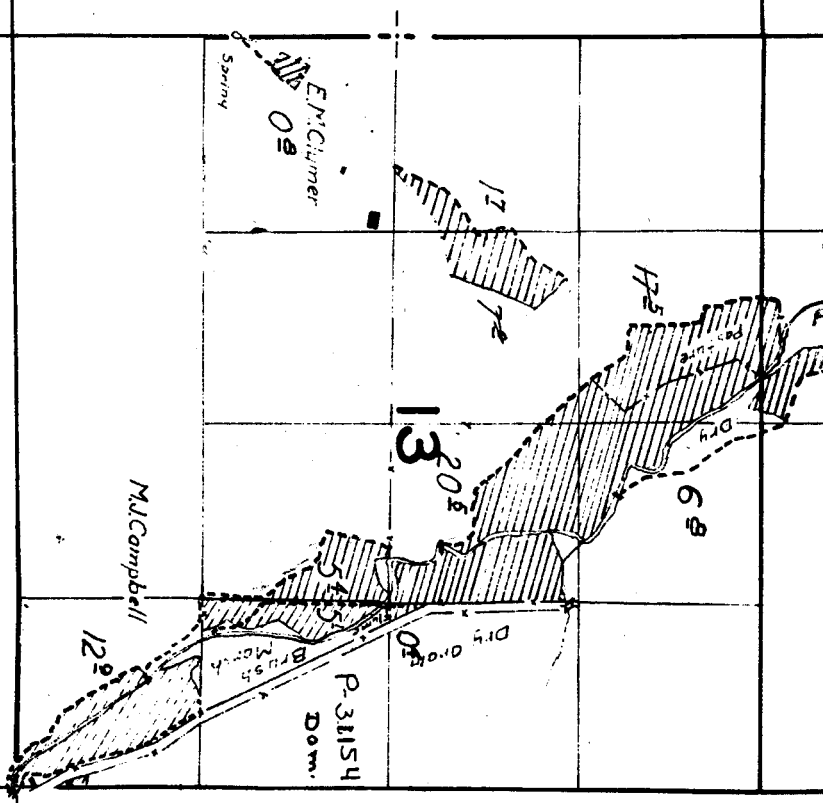

27

26


25

34

35

36

Note: Streams not in the
irrigated lands sketched

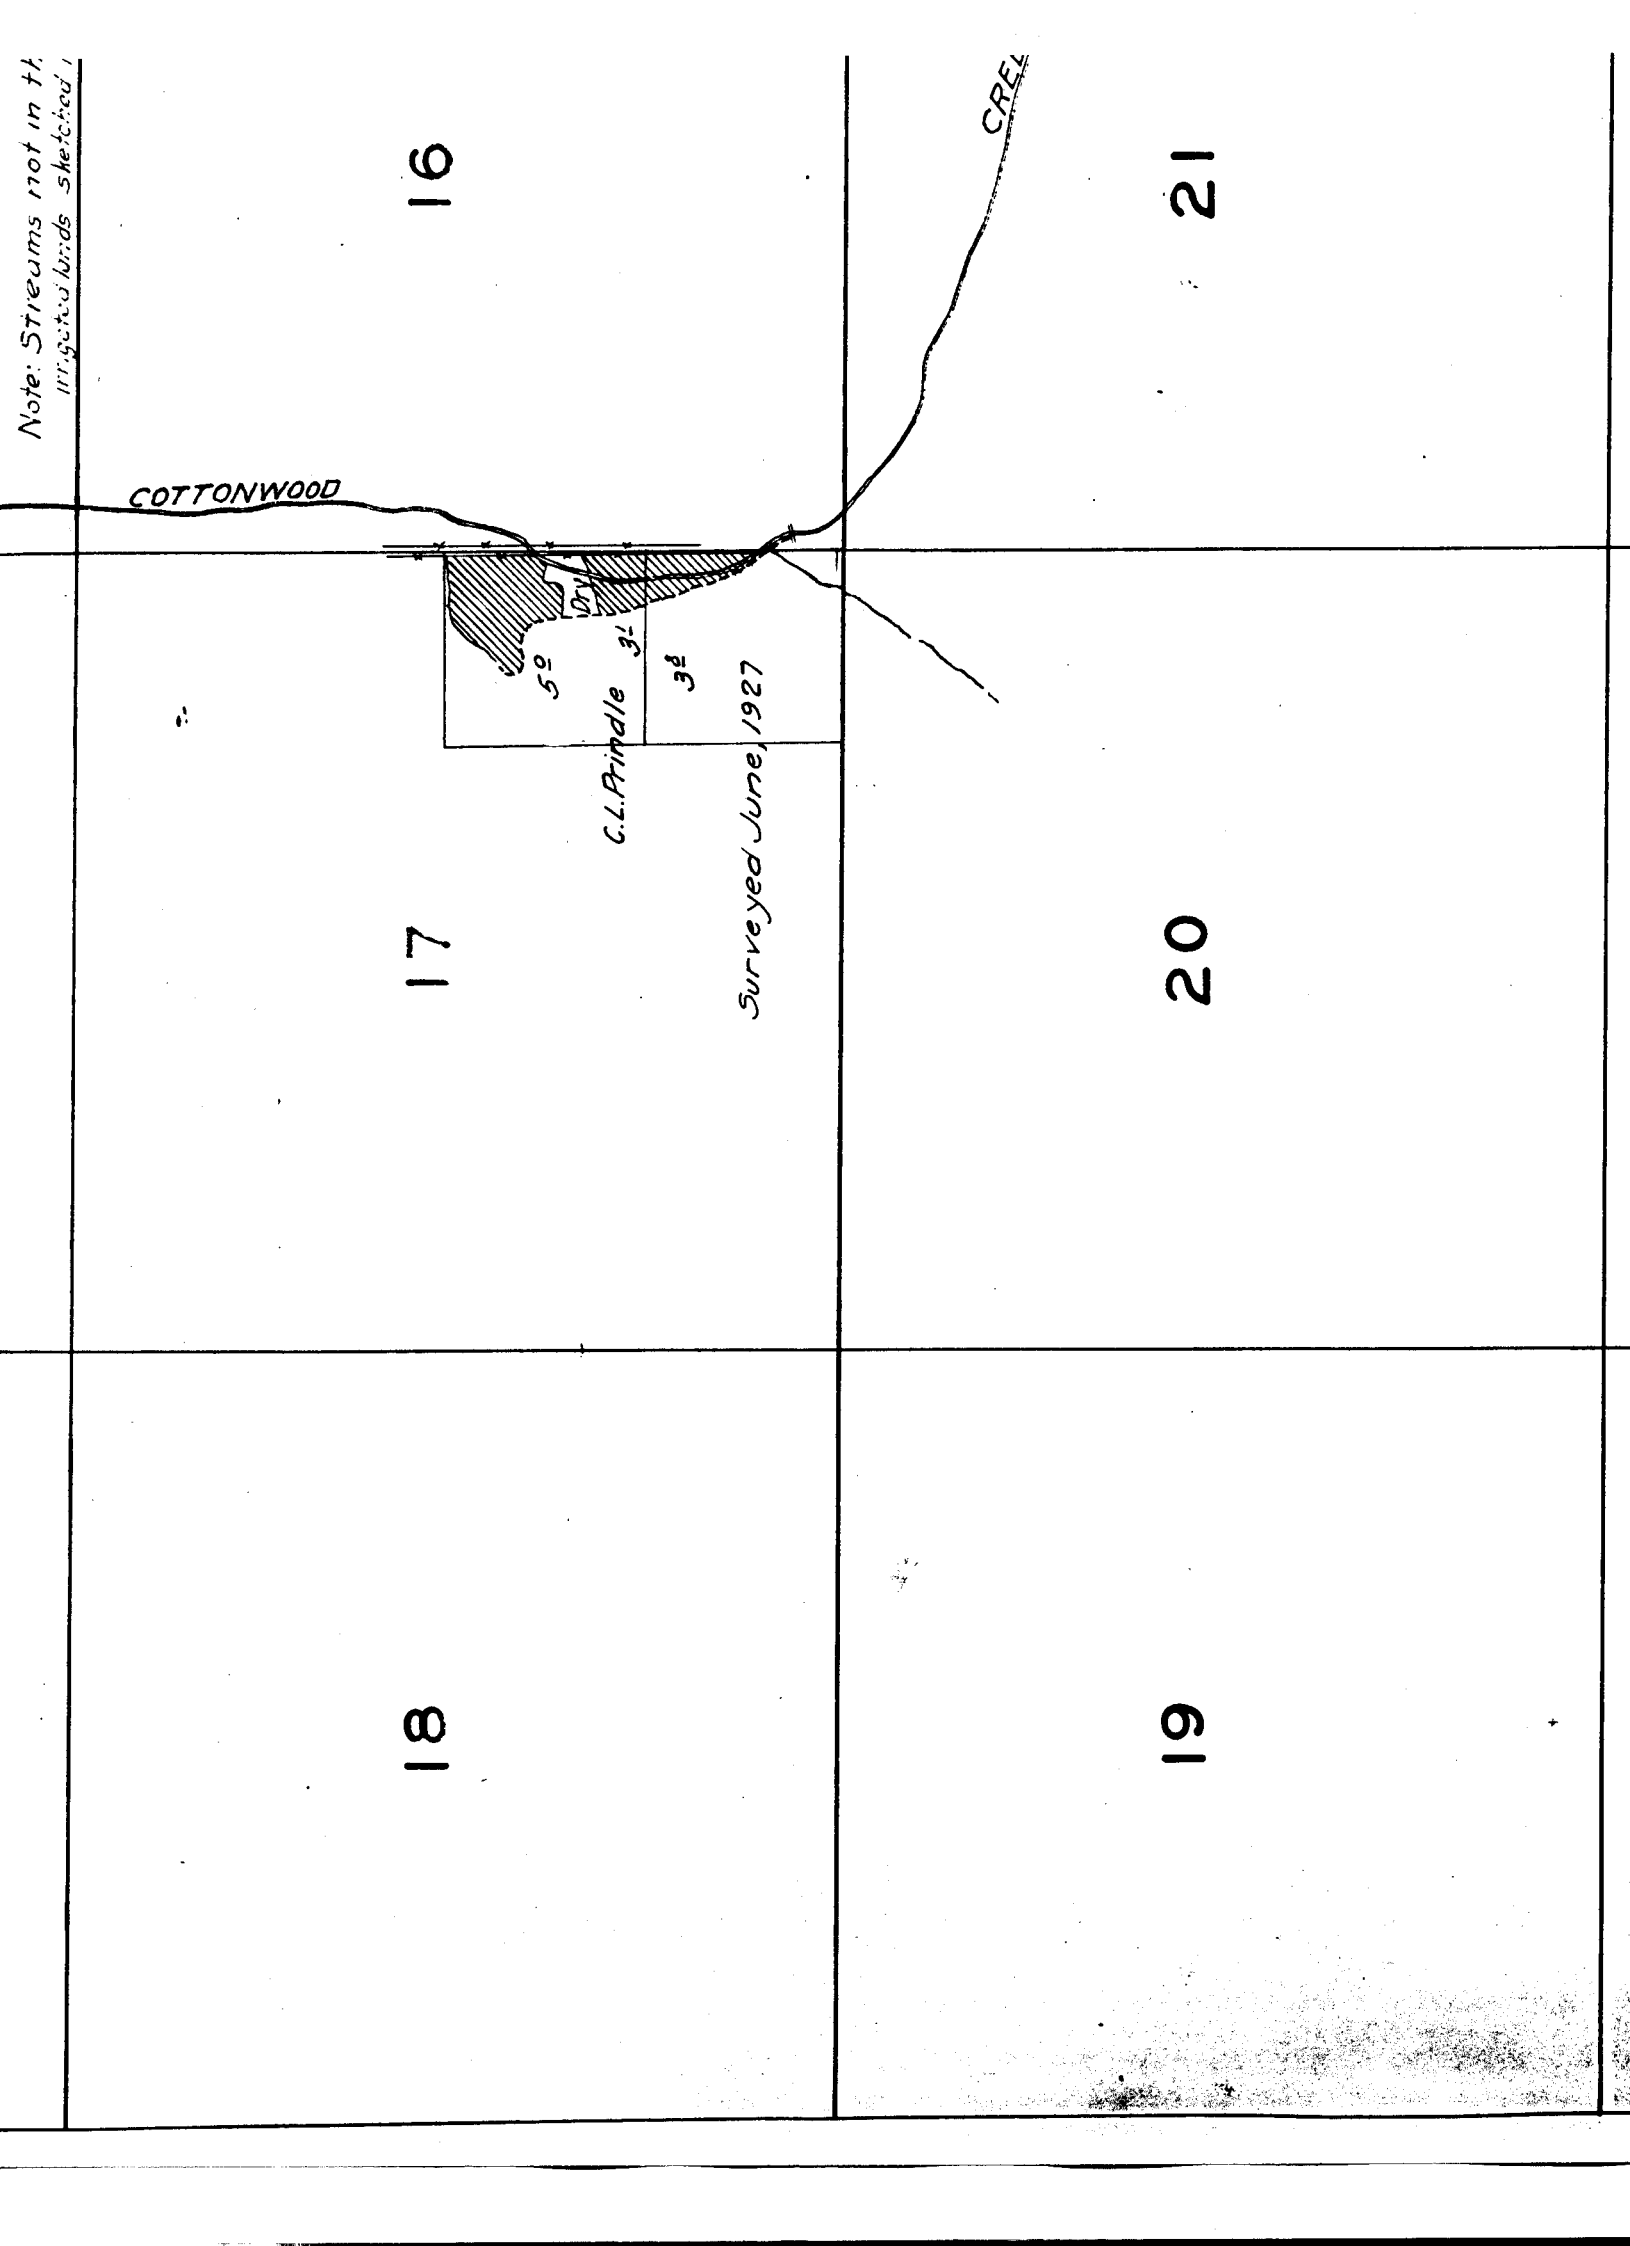

18

17

16

19

20

21

COTTONWOOD

CREK

C.L. Prindle

Surveyed June, 1927

50


31


२७

28

23

33

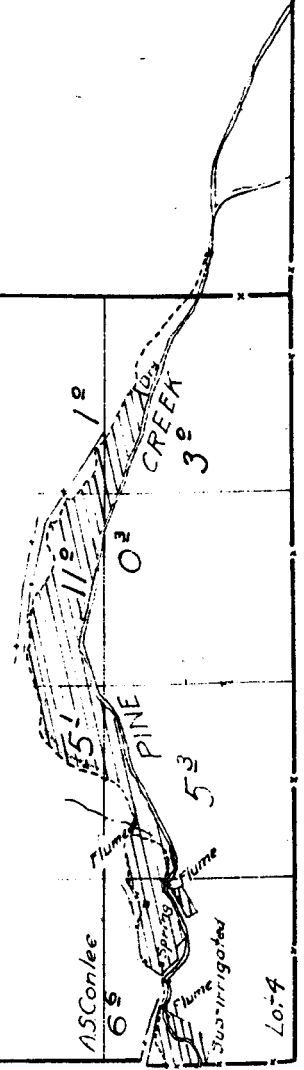

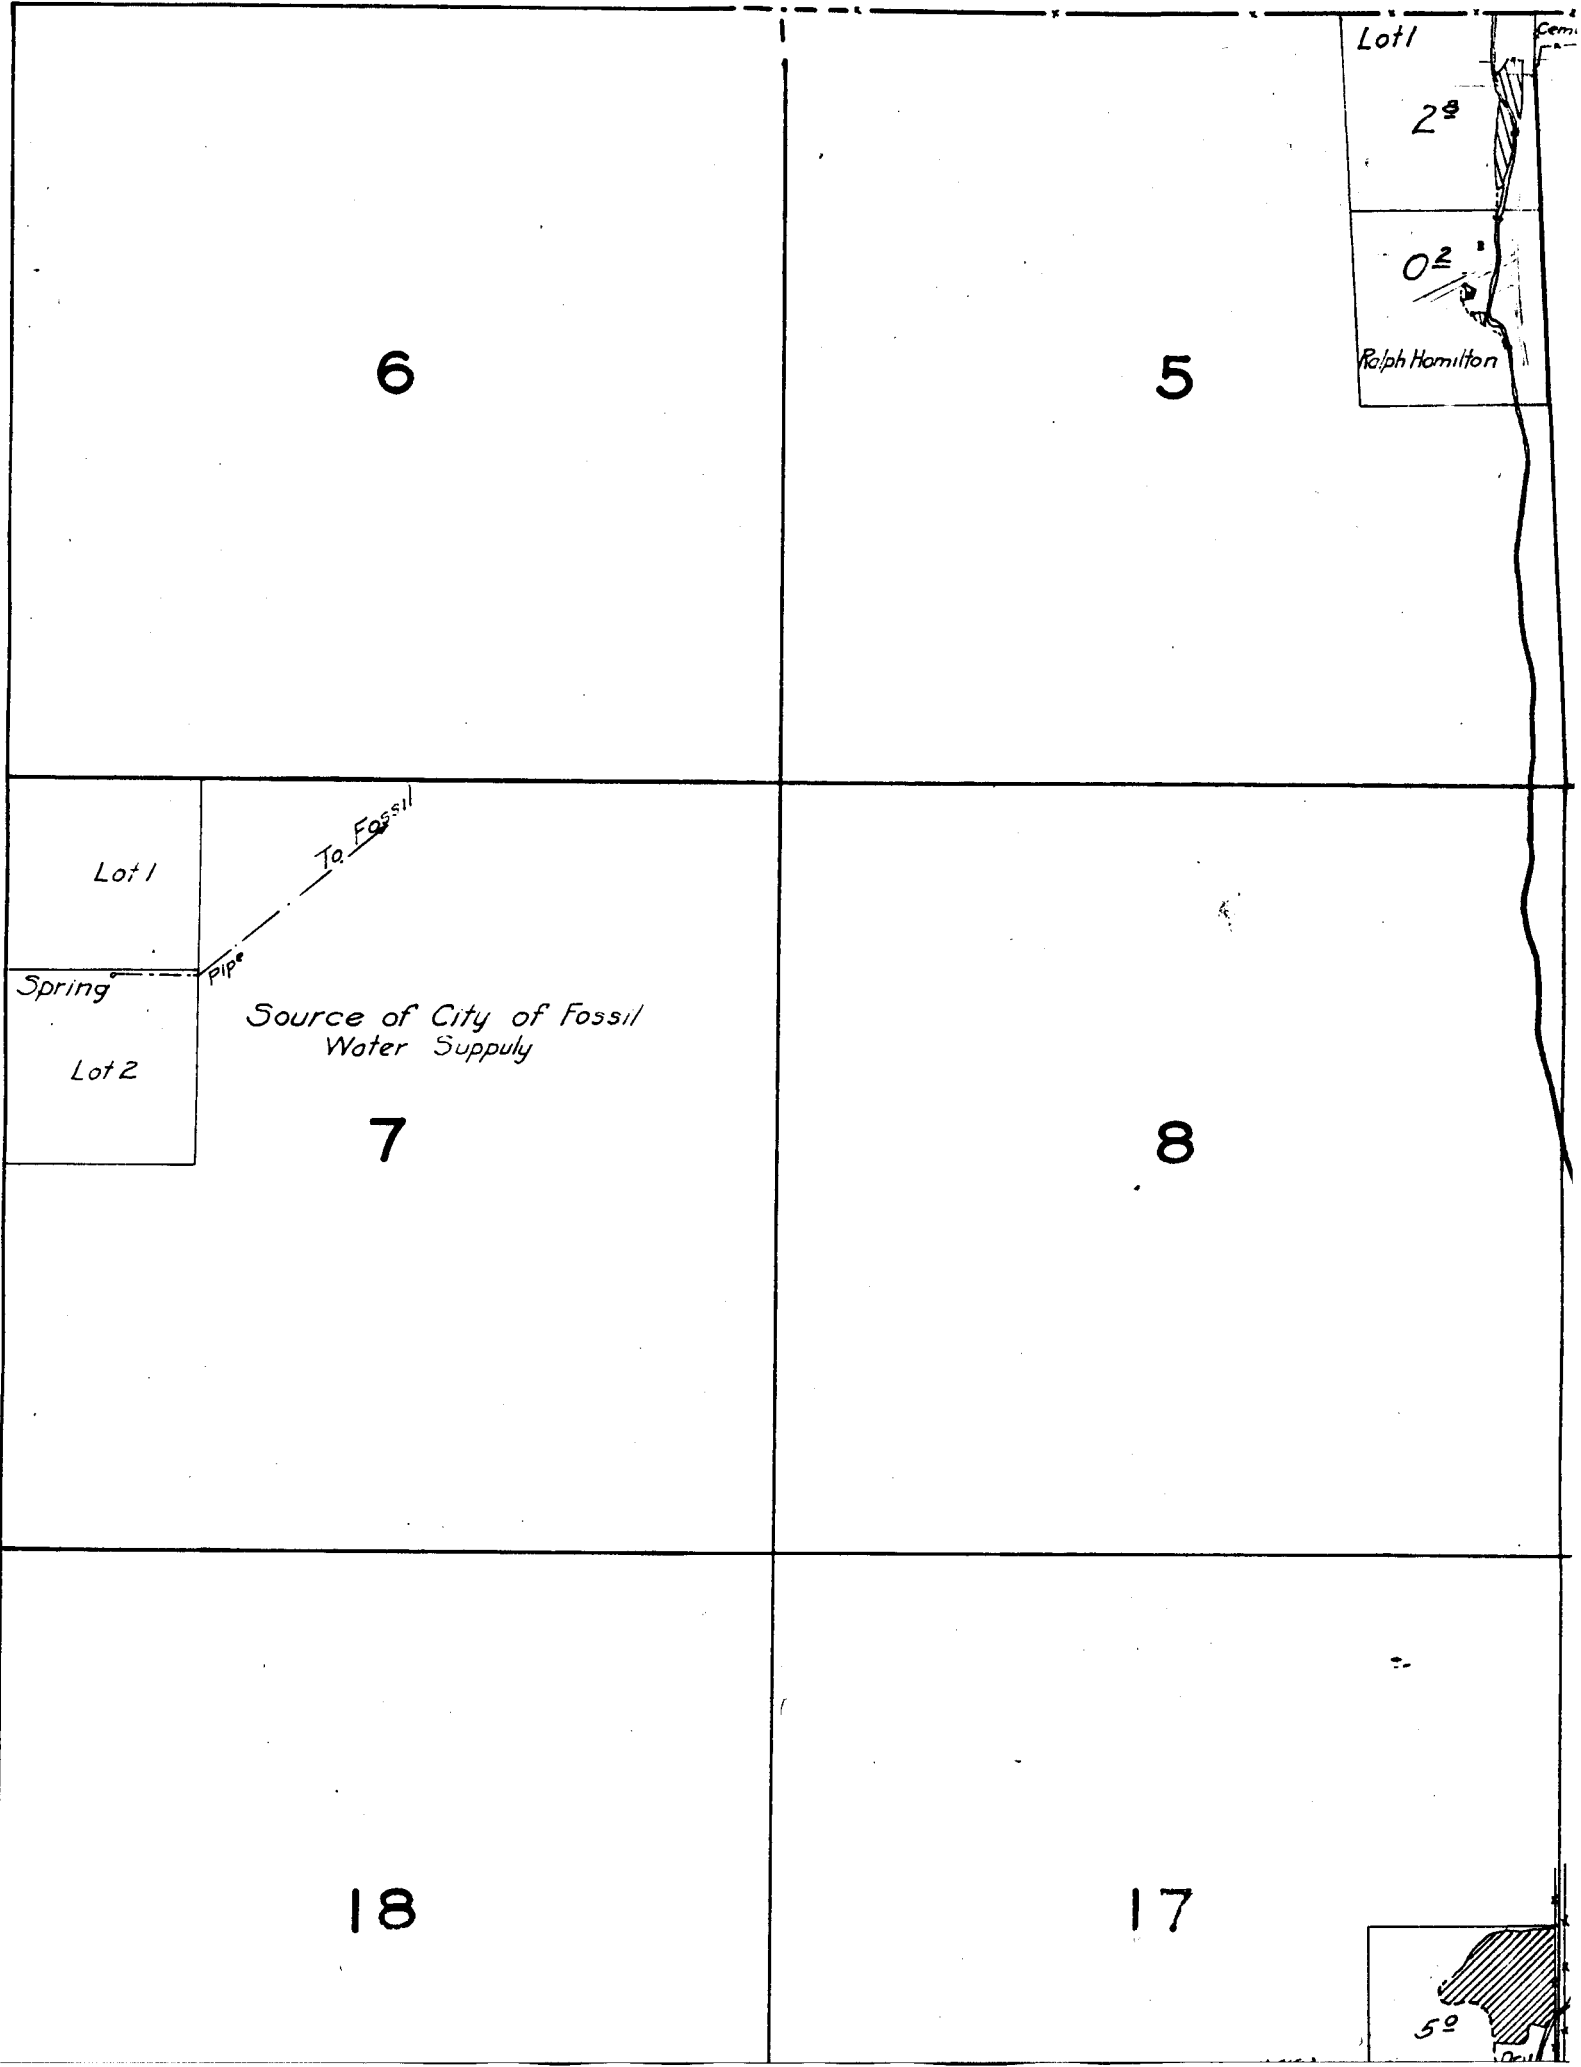

6

5

Lot 1

2nd

02

Ralph Hamilton

Lot 1

Spring

Lot 2

To Fossil

Pipe

Source of City of Fossil
Water Supply


7

8

18

17

50

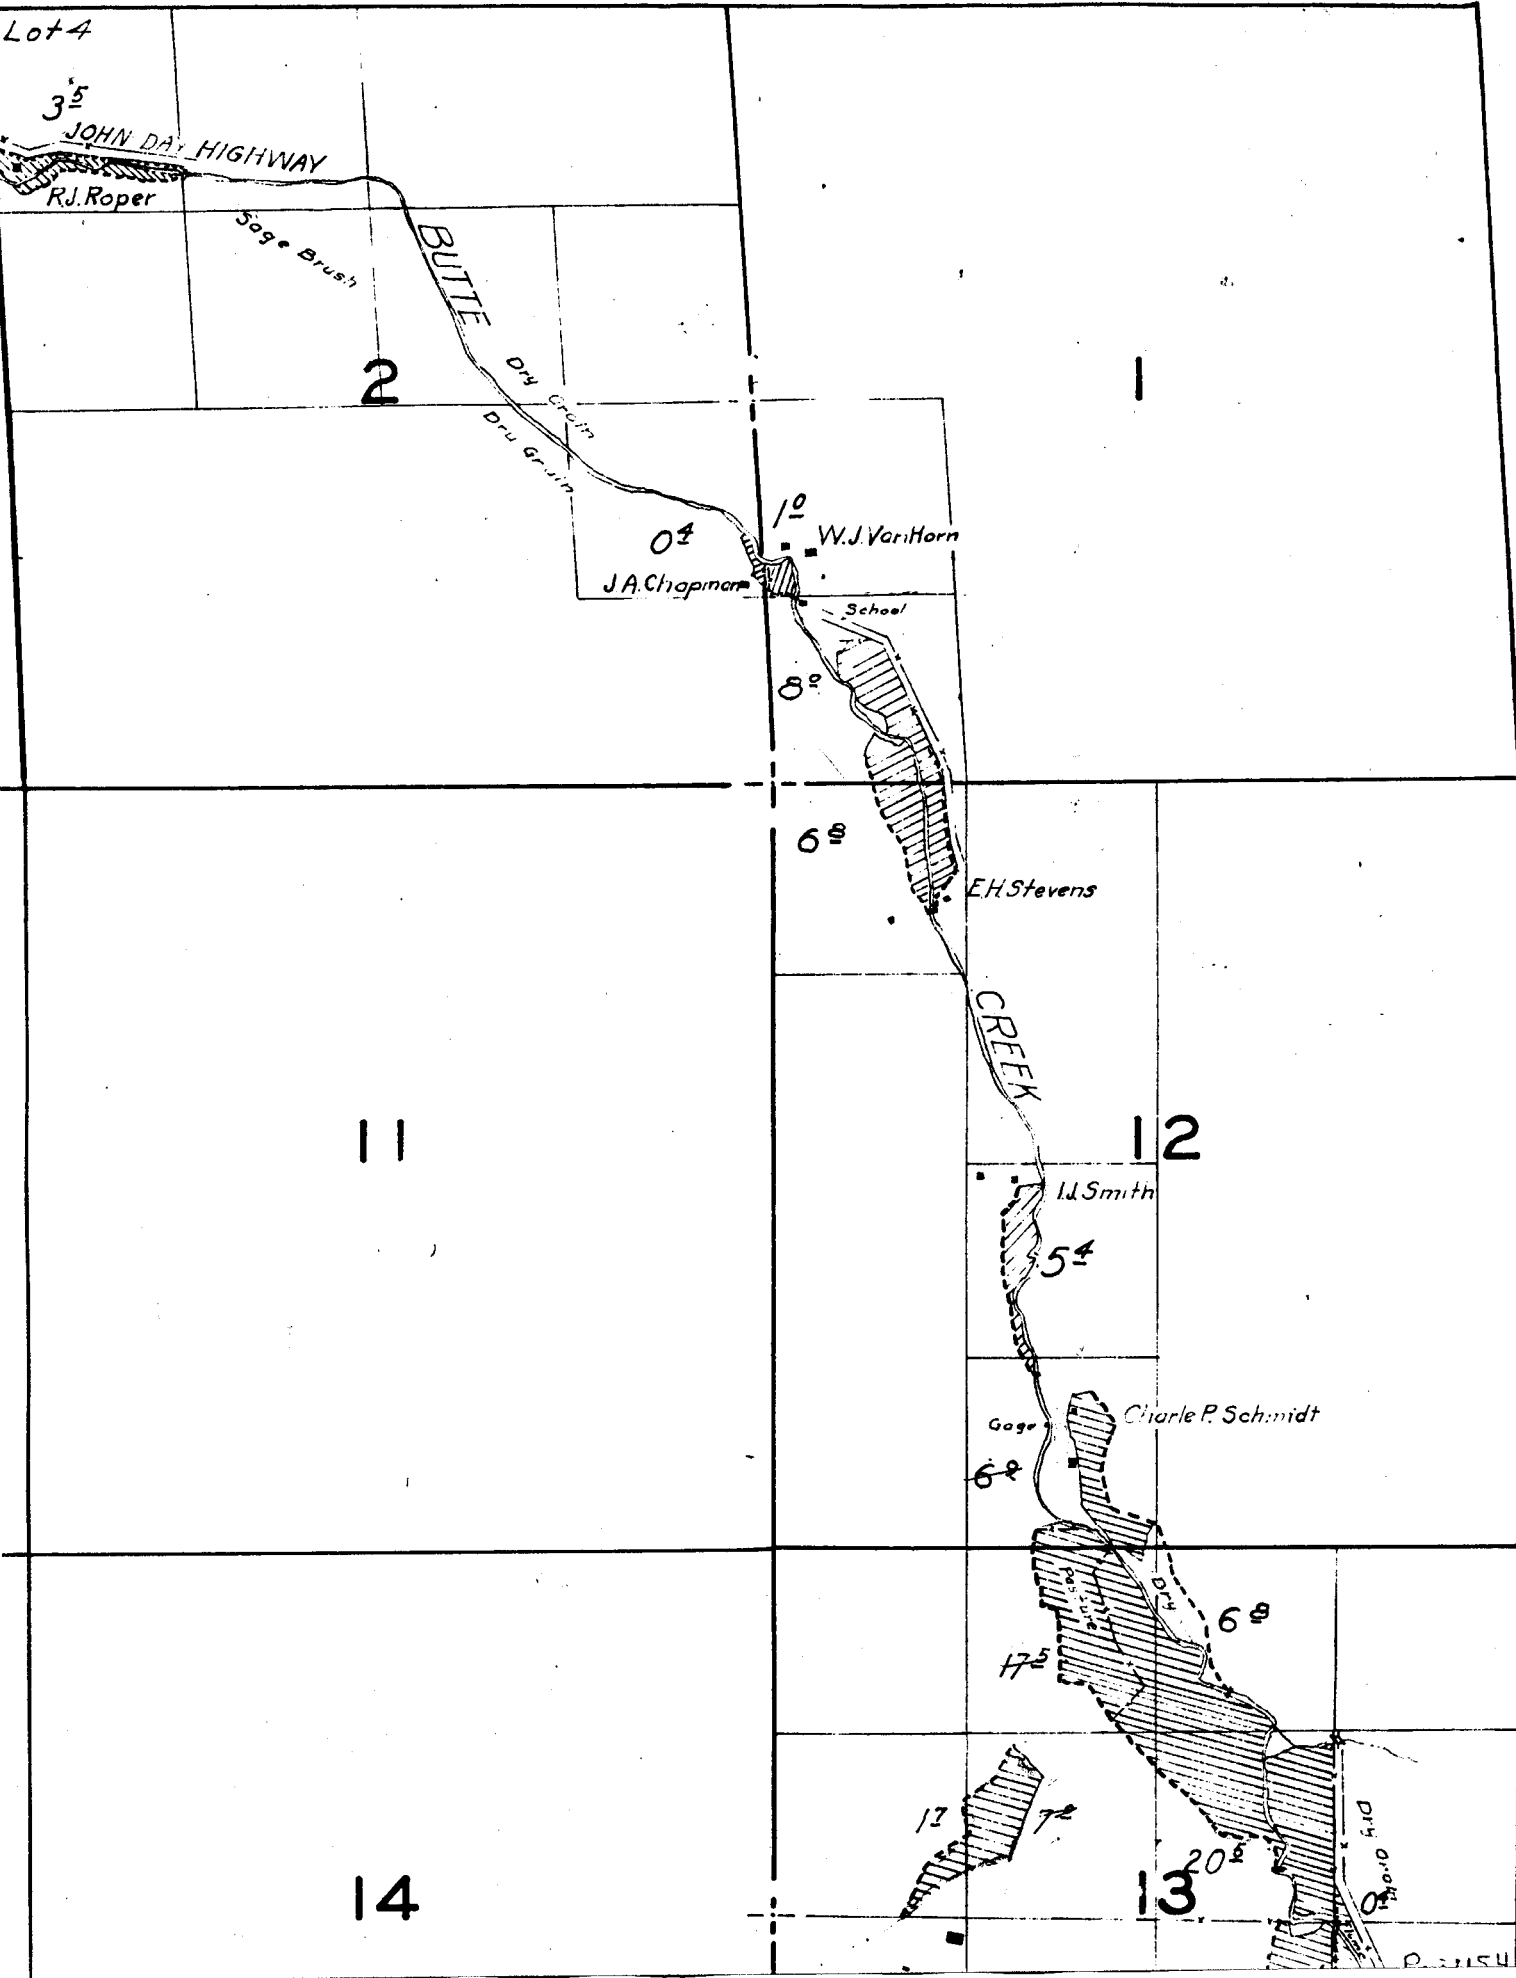

*Note: Streams not in the vicinity of
irrigated lands sketched in approximate location.*

COTTONWOOD

7

16

15

C.L. Rindie 32

52

32

Surveyed June, 1927

CREEK

0


21

22

22
FW Ball

*Note: Location according
to Mr. Ball
School*

TOWNSHIP 7 S., RANGE 21 E.

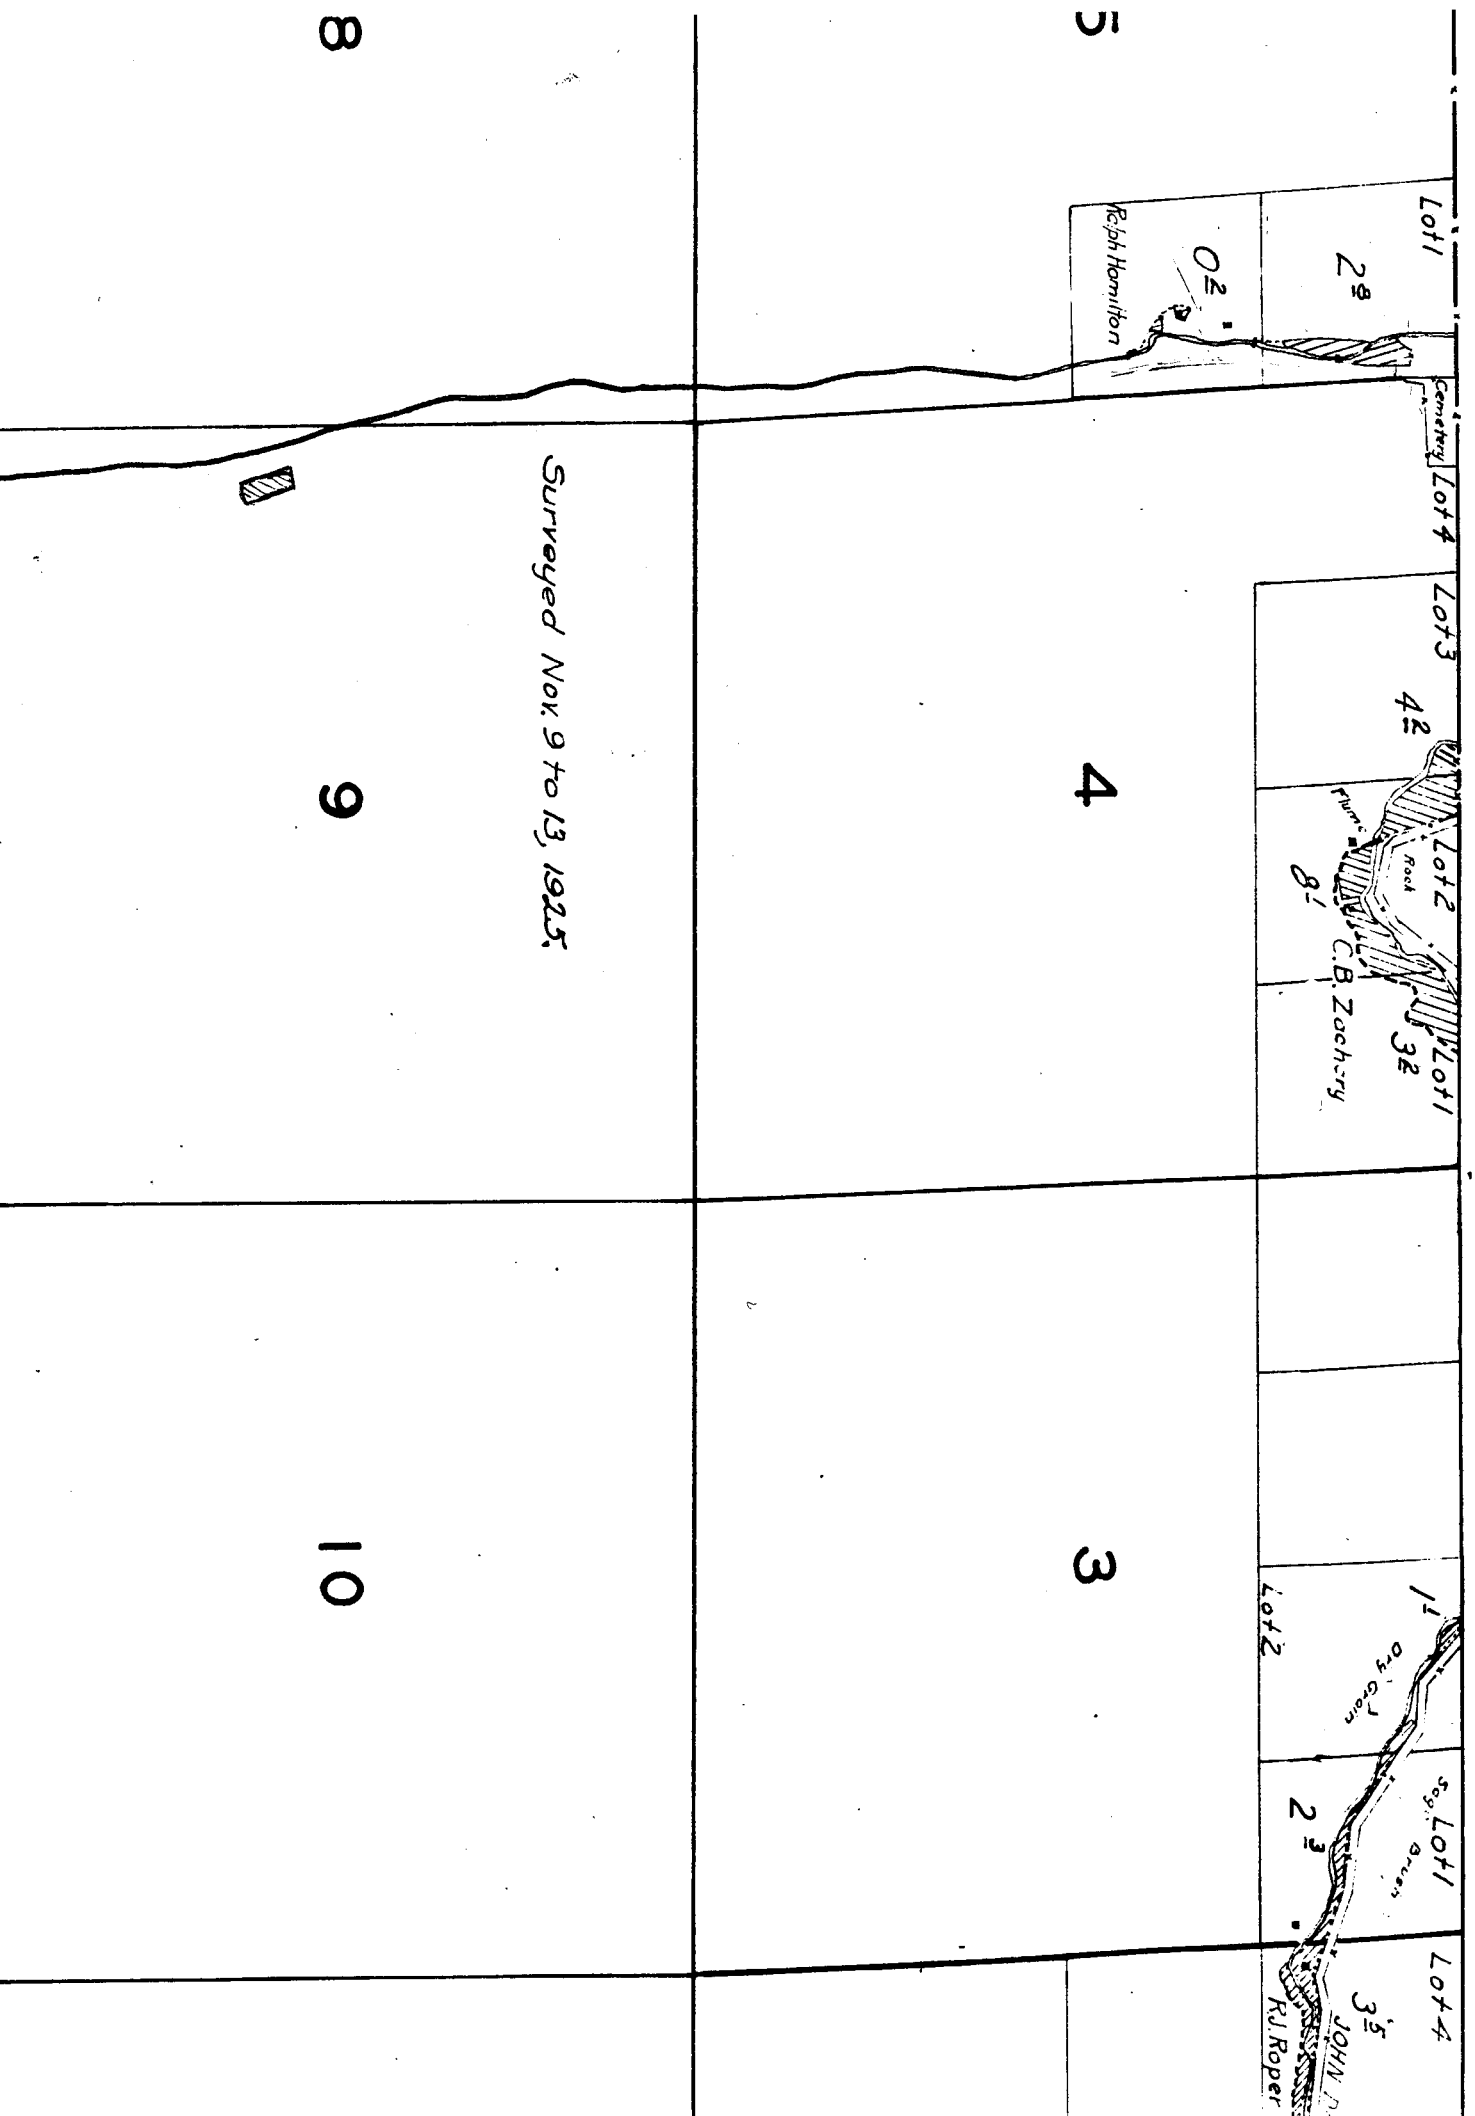

21

22

2^d
FWBall

*Note: Location according
to Mr. Ball.*
School

28

27

33

34