

2

1

11

12

14

13


27

25

34


35

36

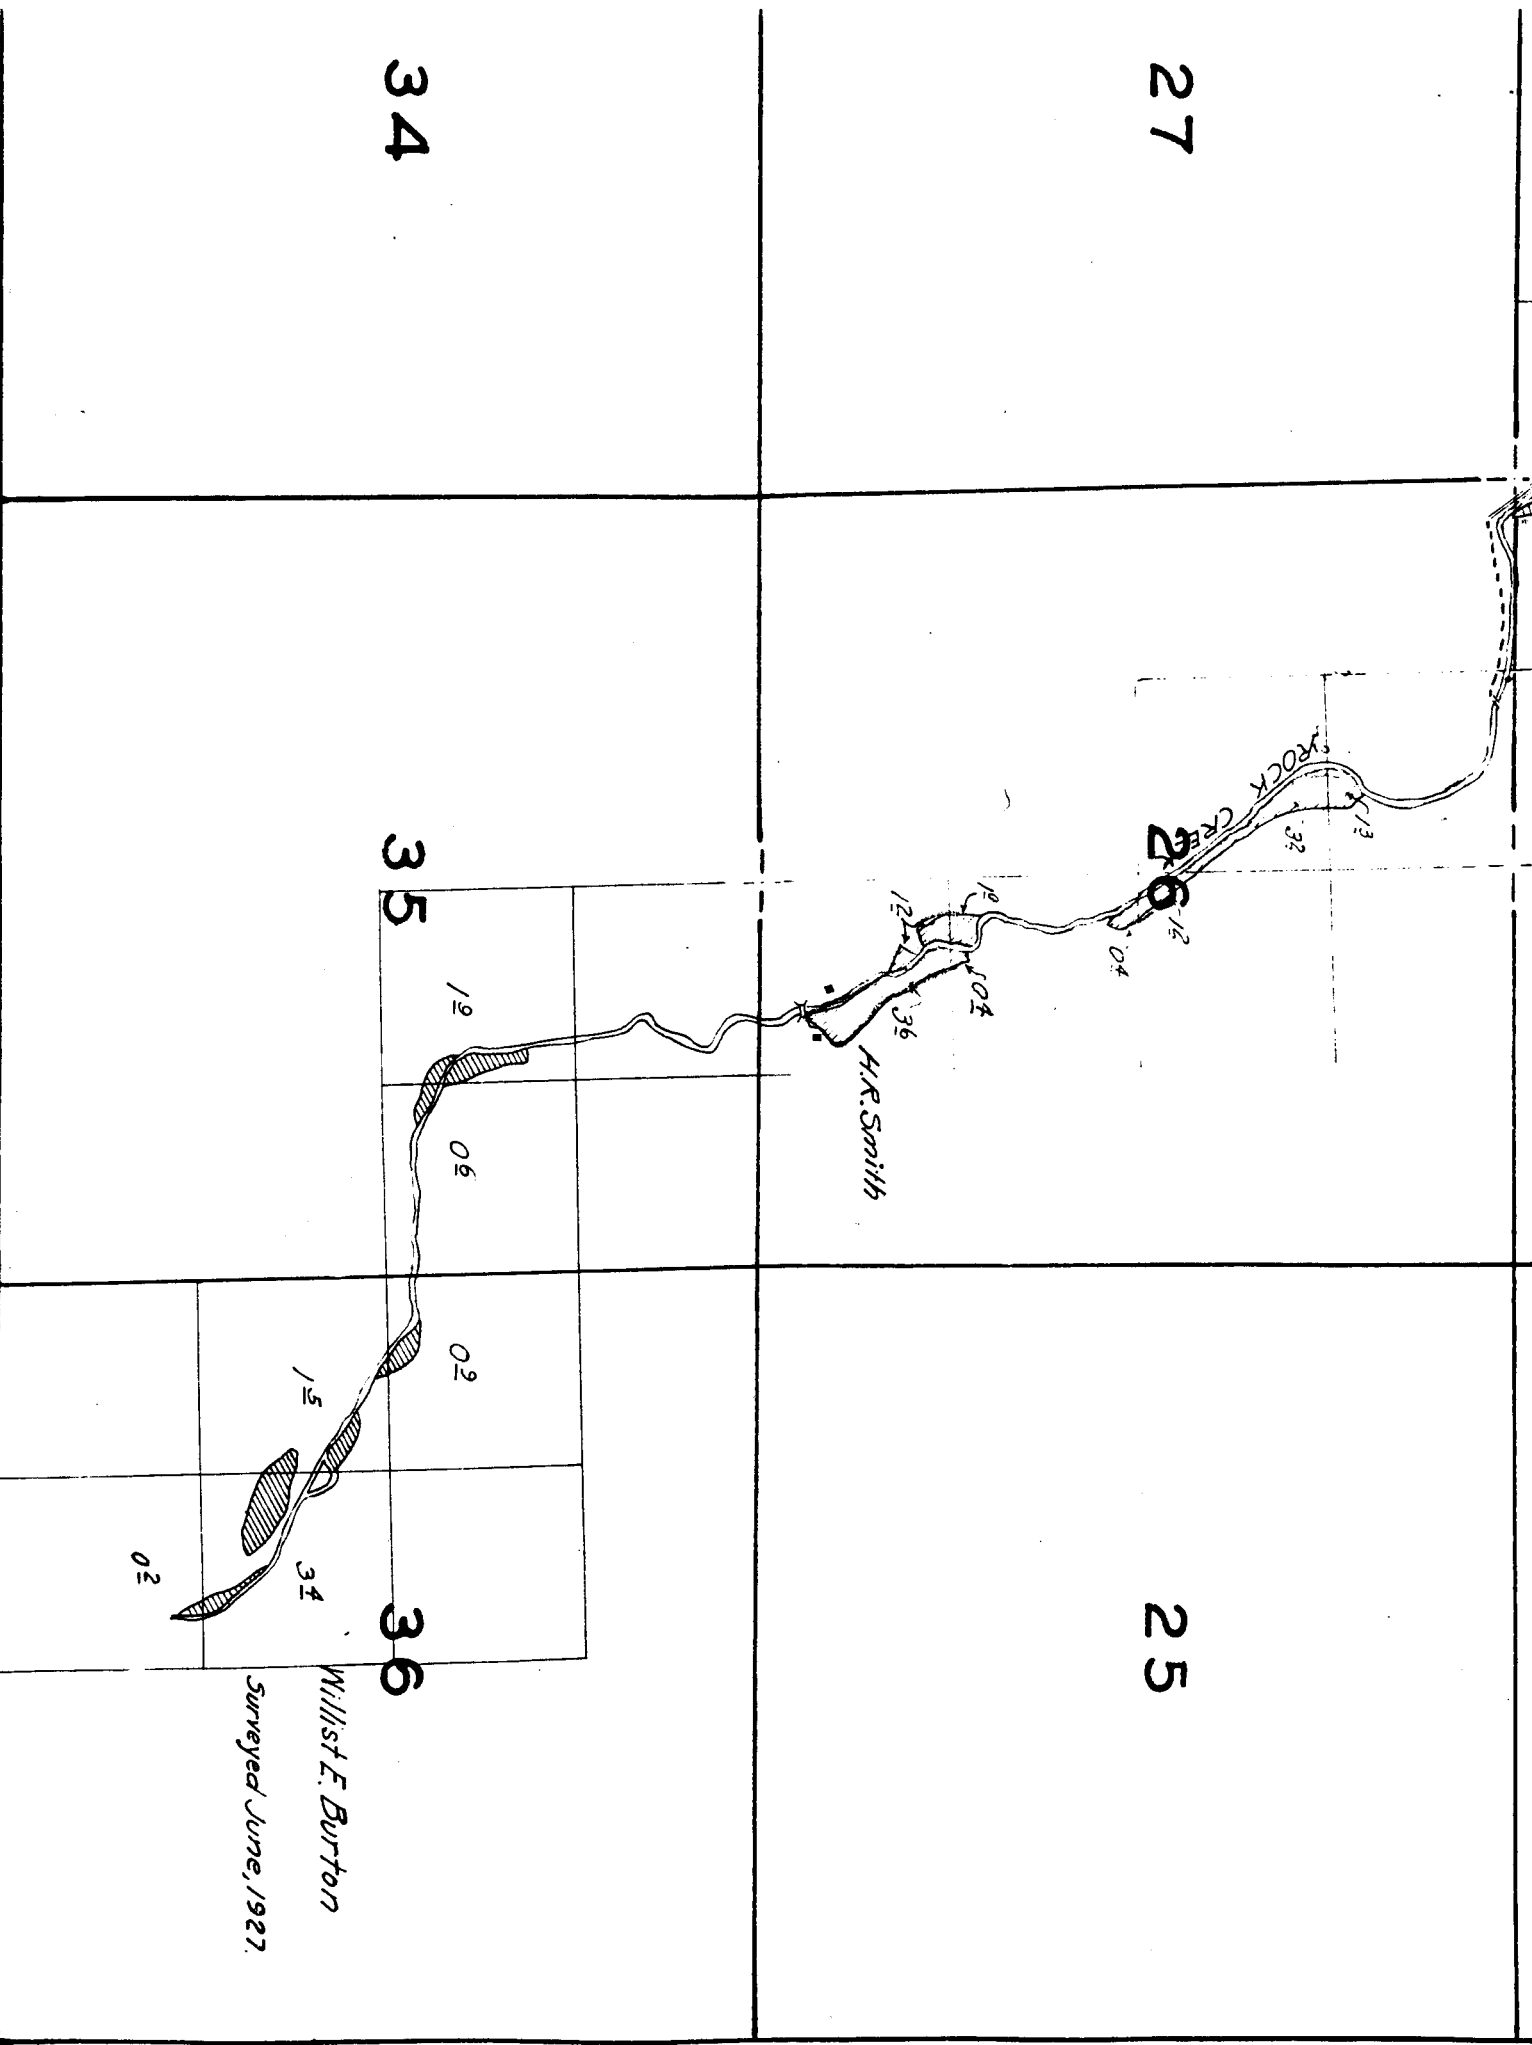

Willist E. Burton  
 Surveyed June, 1927.

BROWN  
(BROWN)

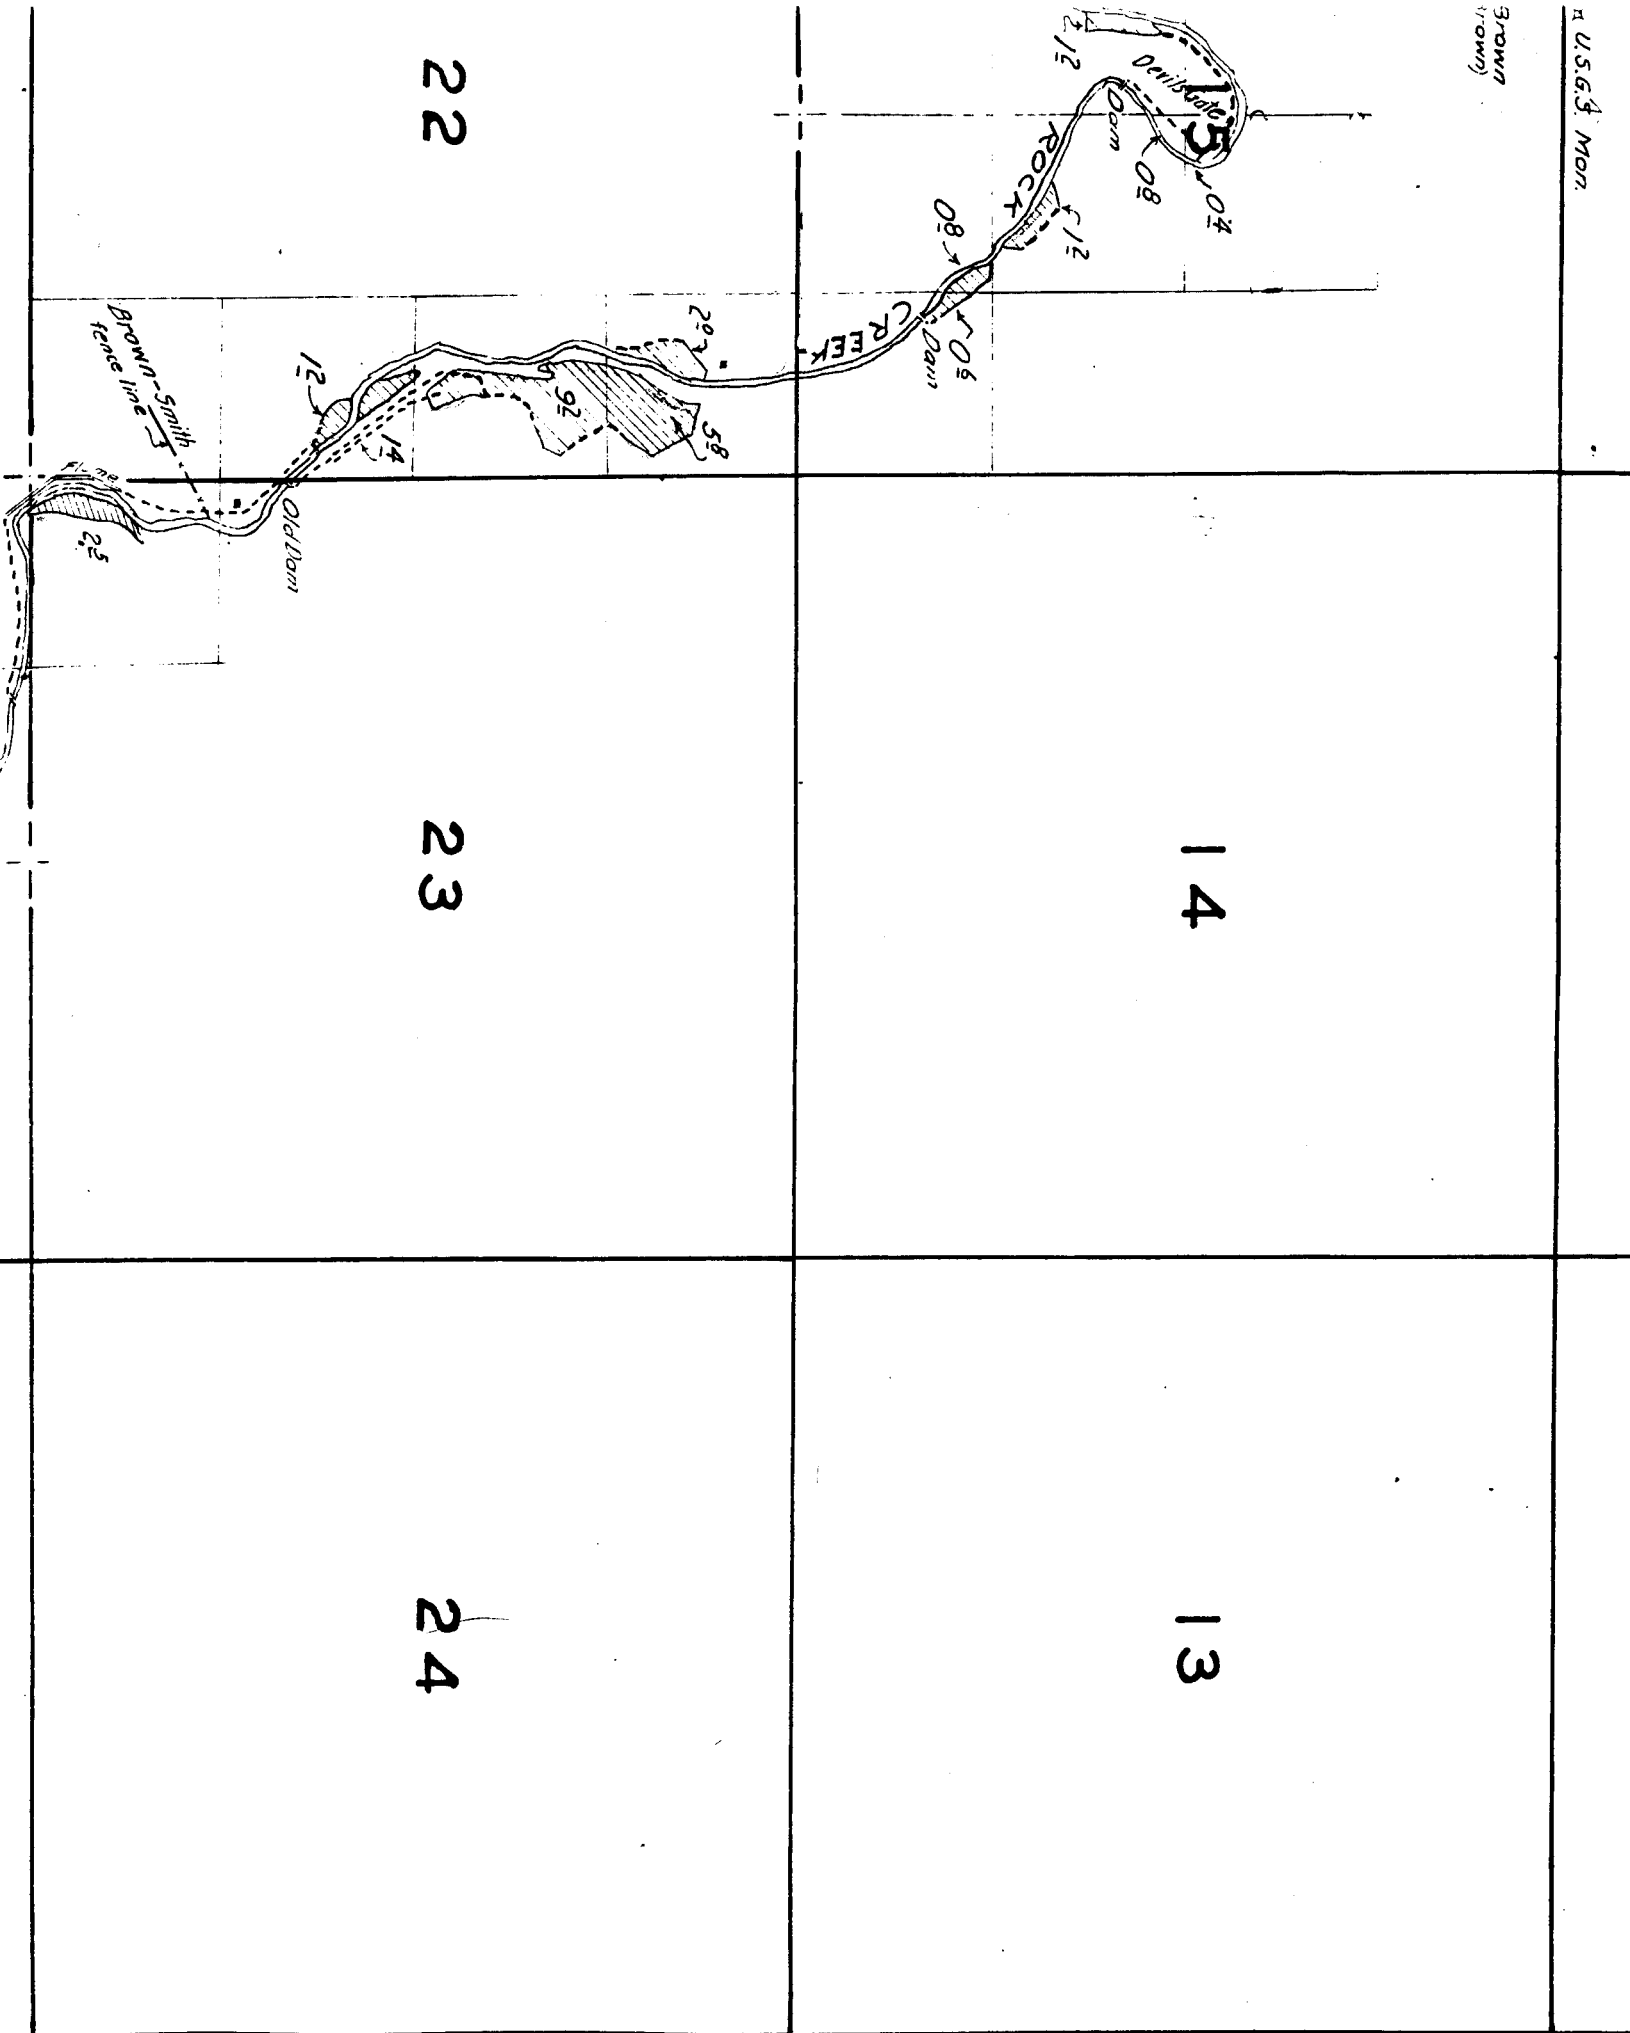

30

29

28

31

32

33

18

16

19

20

21


SOUTH FORK OF ROCK CREEK  
Dam

Joe Trevett  
Condon, Ore.  
01


John Trevett  
Condon, Ore.  
067


Note:  
Streams, except in the  
of irrigated land, are  
in approximate locati

Surveyed May 12 and 13

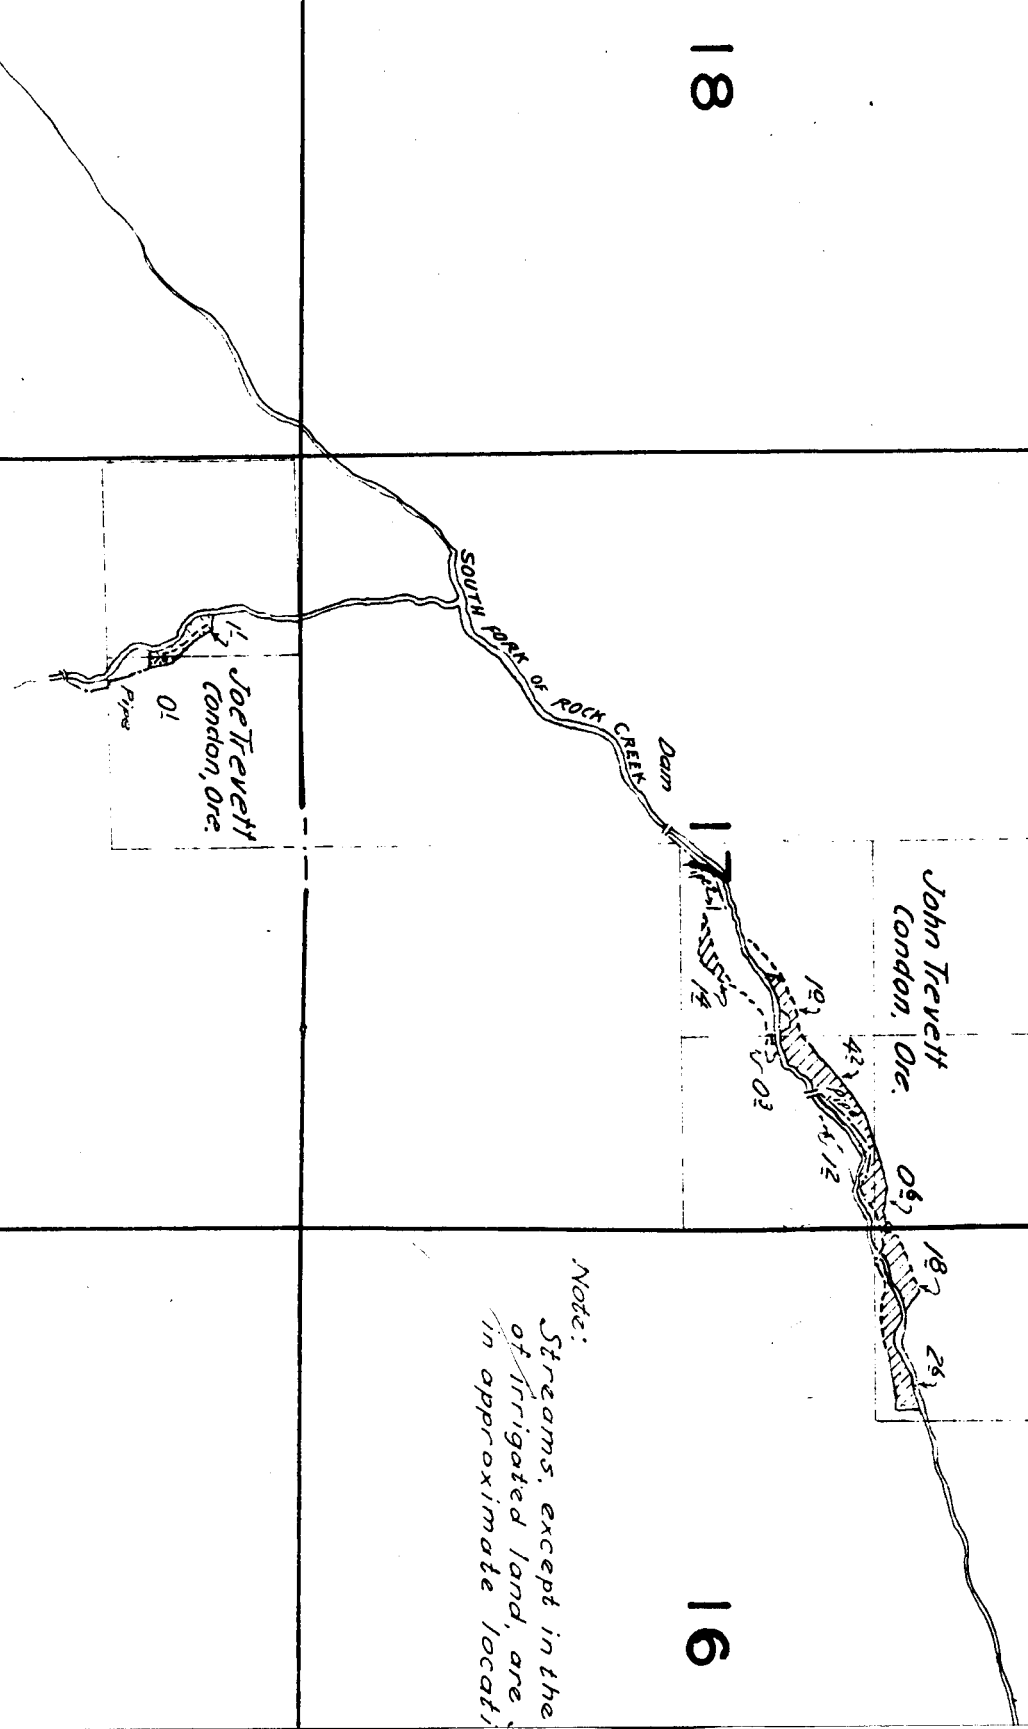


TOWNSHIP 3 S., RANGE 22 E..

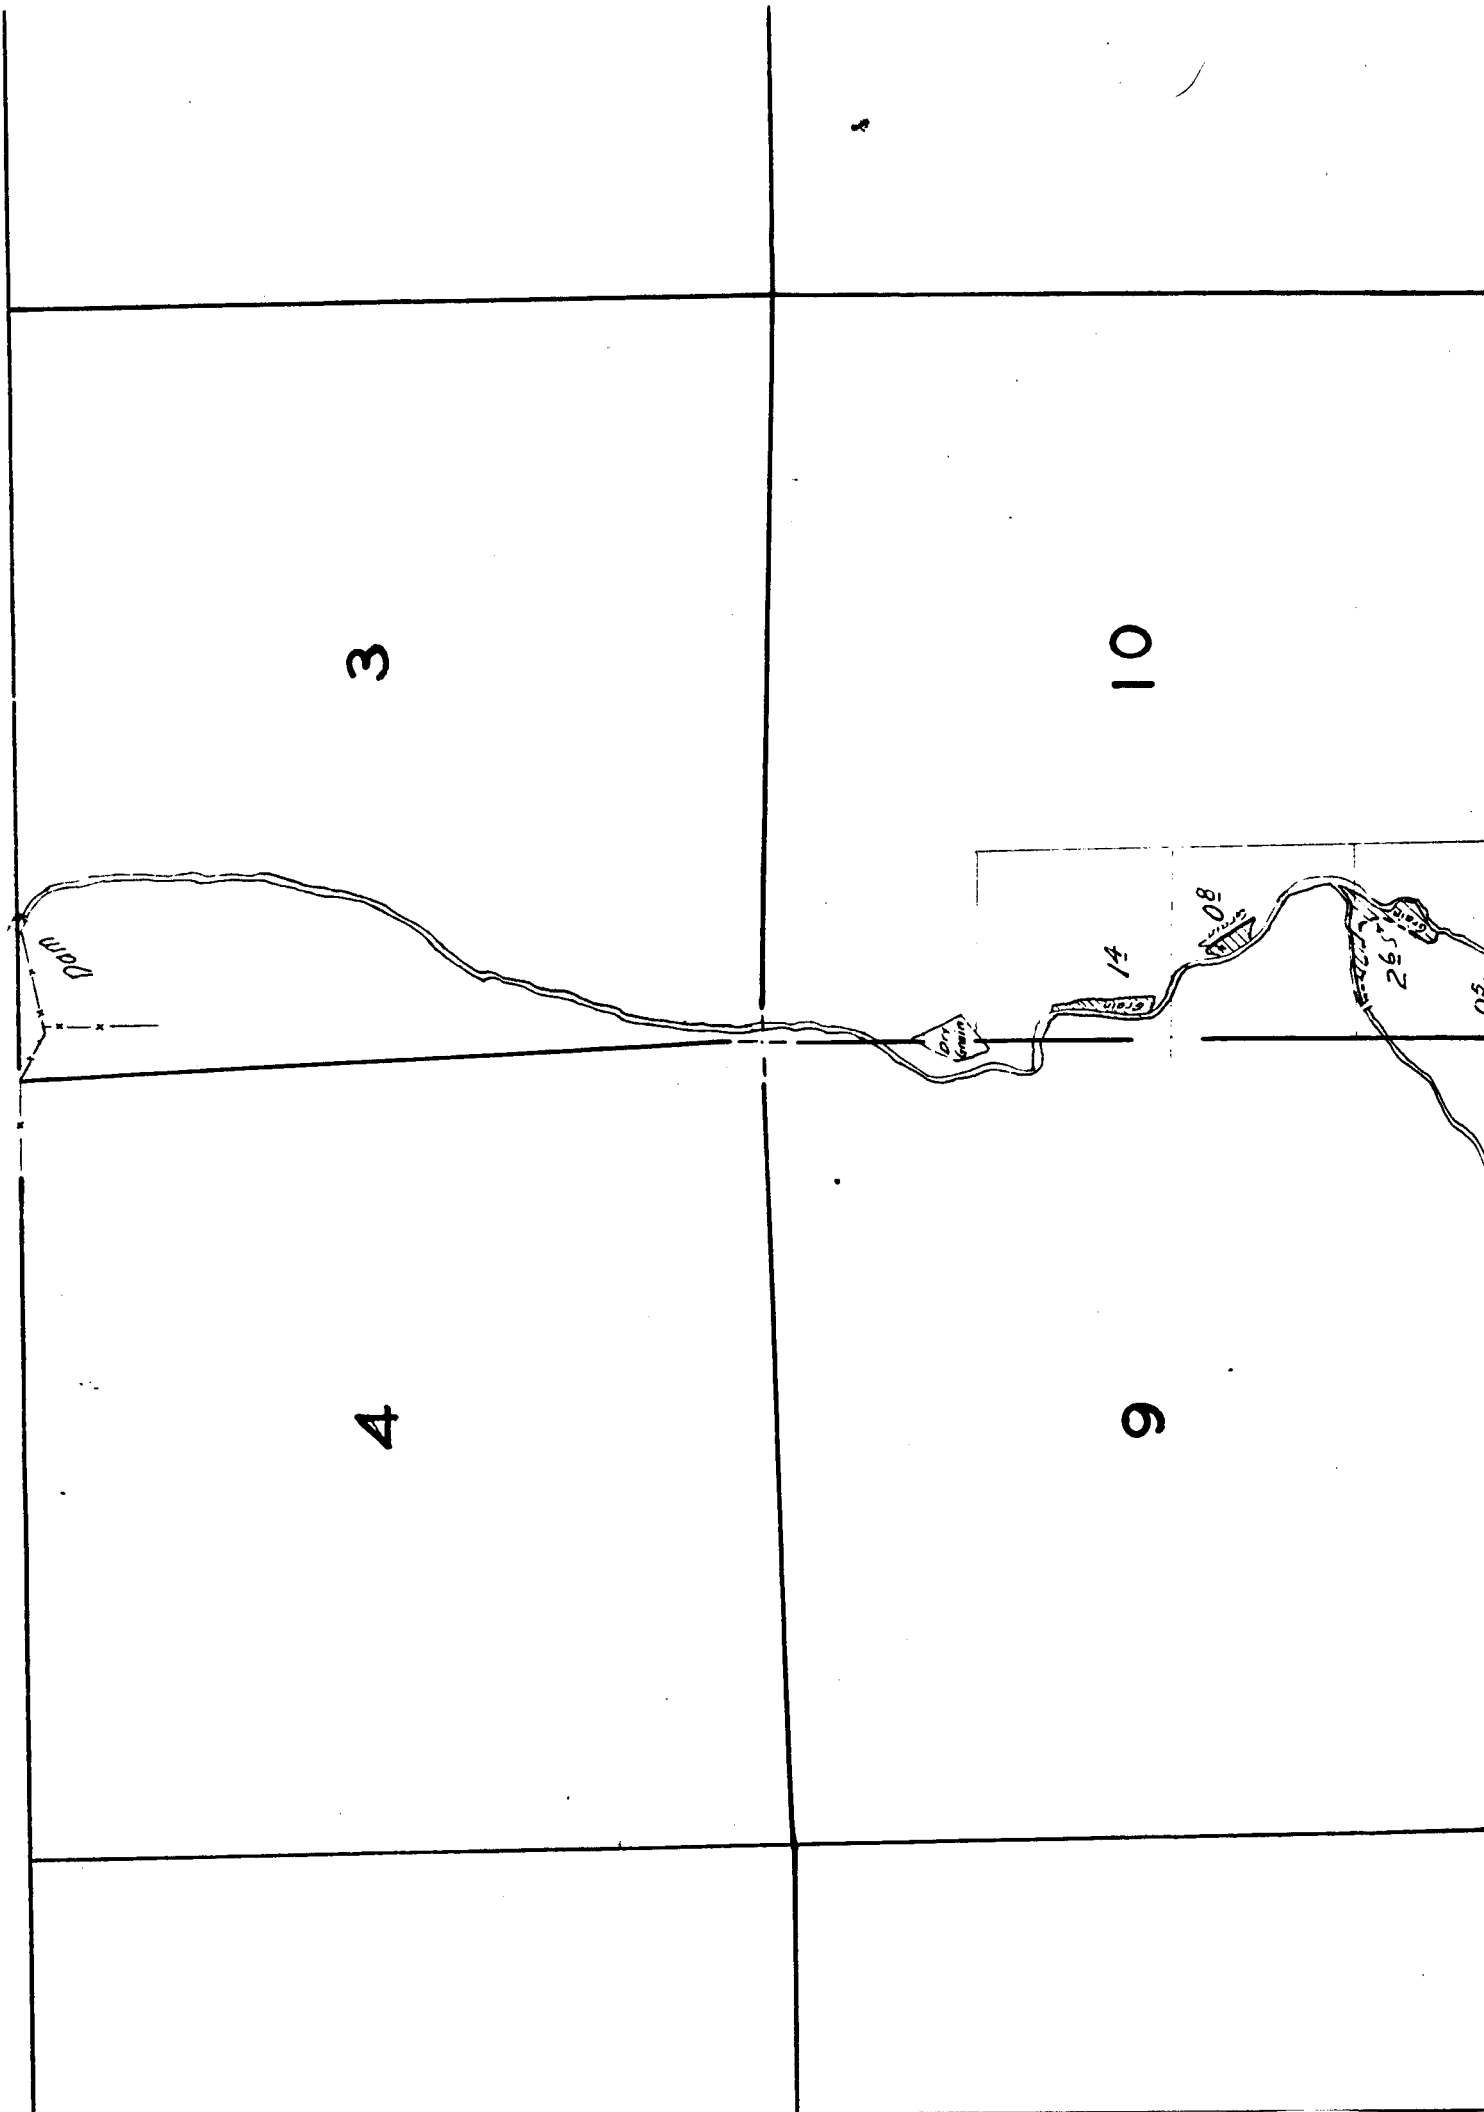

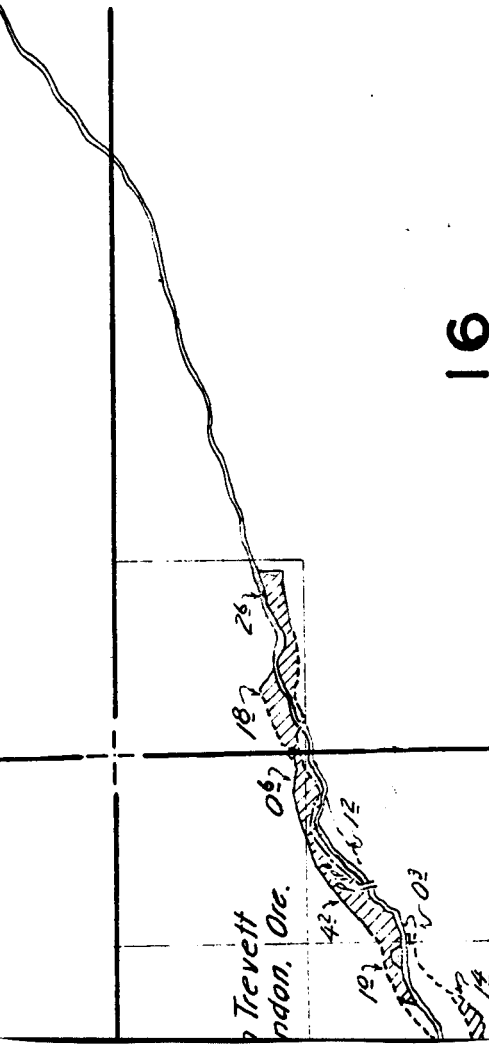


16

Note: Streams, except in the vicinity of irrigated land, are sketched in approximate location.

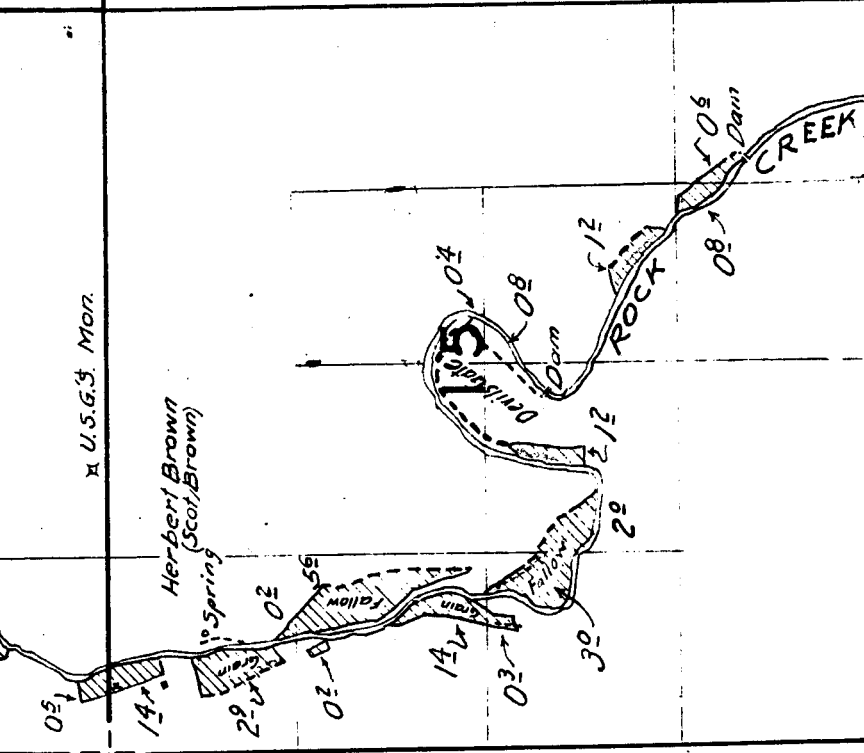

22

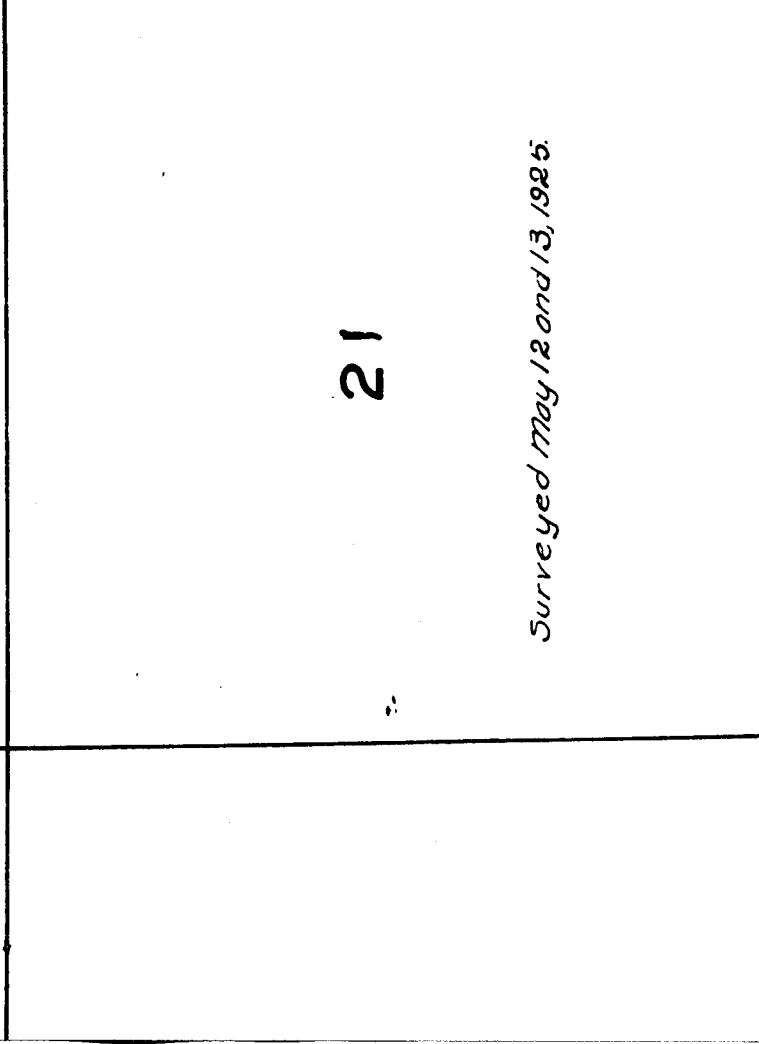

21

Surveyed May 12 and 13, 1925.

21

22

Surveyed May 12 and 13, 1925.



Brown-Smith  
fence line

28

27

33

34



6

5

7

8

18

