

19

20

Lot 3

1/4

Charlie Shown

GIRDS

Rim

Rim

Rocks

30

Rocks

CREEK

29

7²

1¹

1²

8¹

Spring
3/4 Km

Winlock Hendricks

Pond

10²

6²

31

32

7¹

3²

6²

Surveyed Sept. 4, 1926.

23

24

4³

02

6²

Dom

6²

8²

7²

Flume

04

Ed. Shoun
(R.R. Willis)

25

4²

28²

04

27²

13⁵

Sage Brush

26

Surveyed Nov. 4, 1925.

35

36

OWNSHIP 10 S., RANGE 22 E.

4

3

9

10

16

15

9

28


27

is

2

33

34

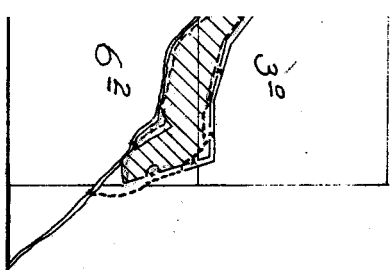

17

16

15

20


21

22

Note: Streams and river, except in vicinity of irrigated land, sketched in approximate location.


15

22

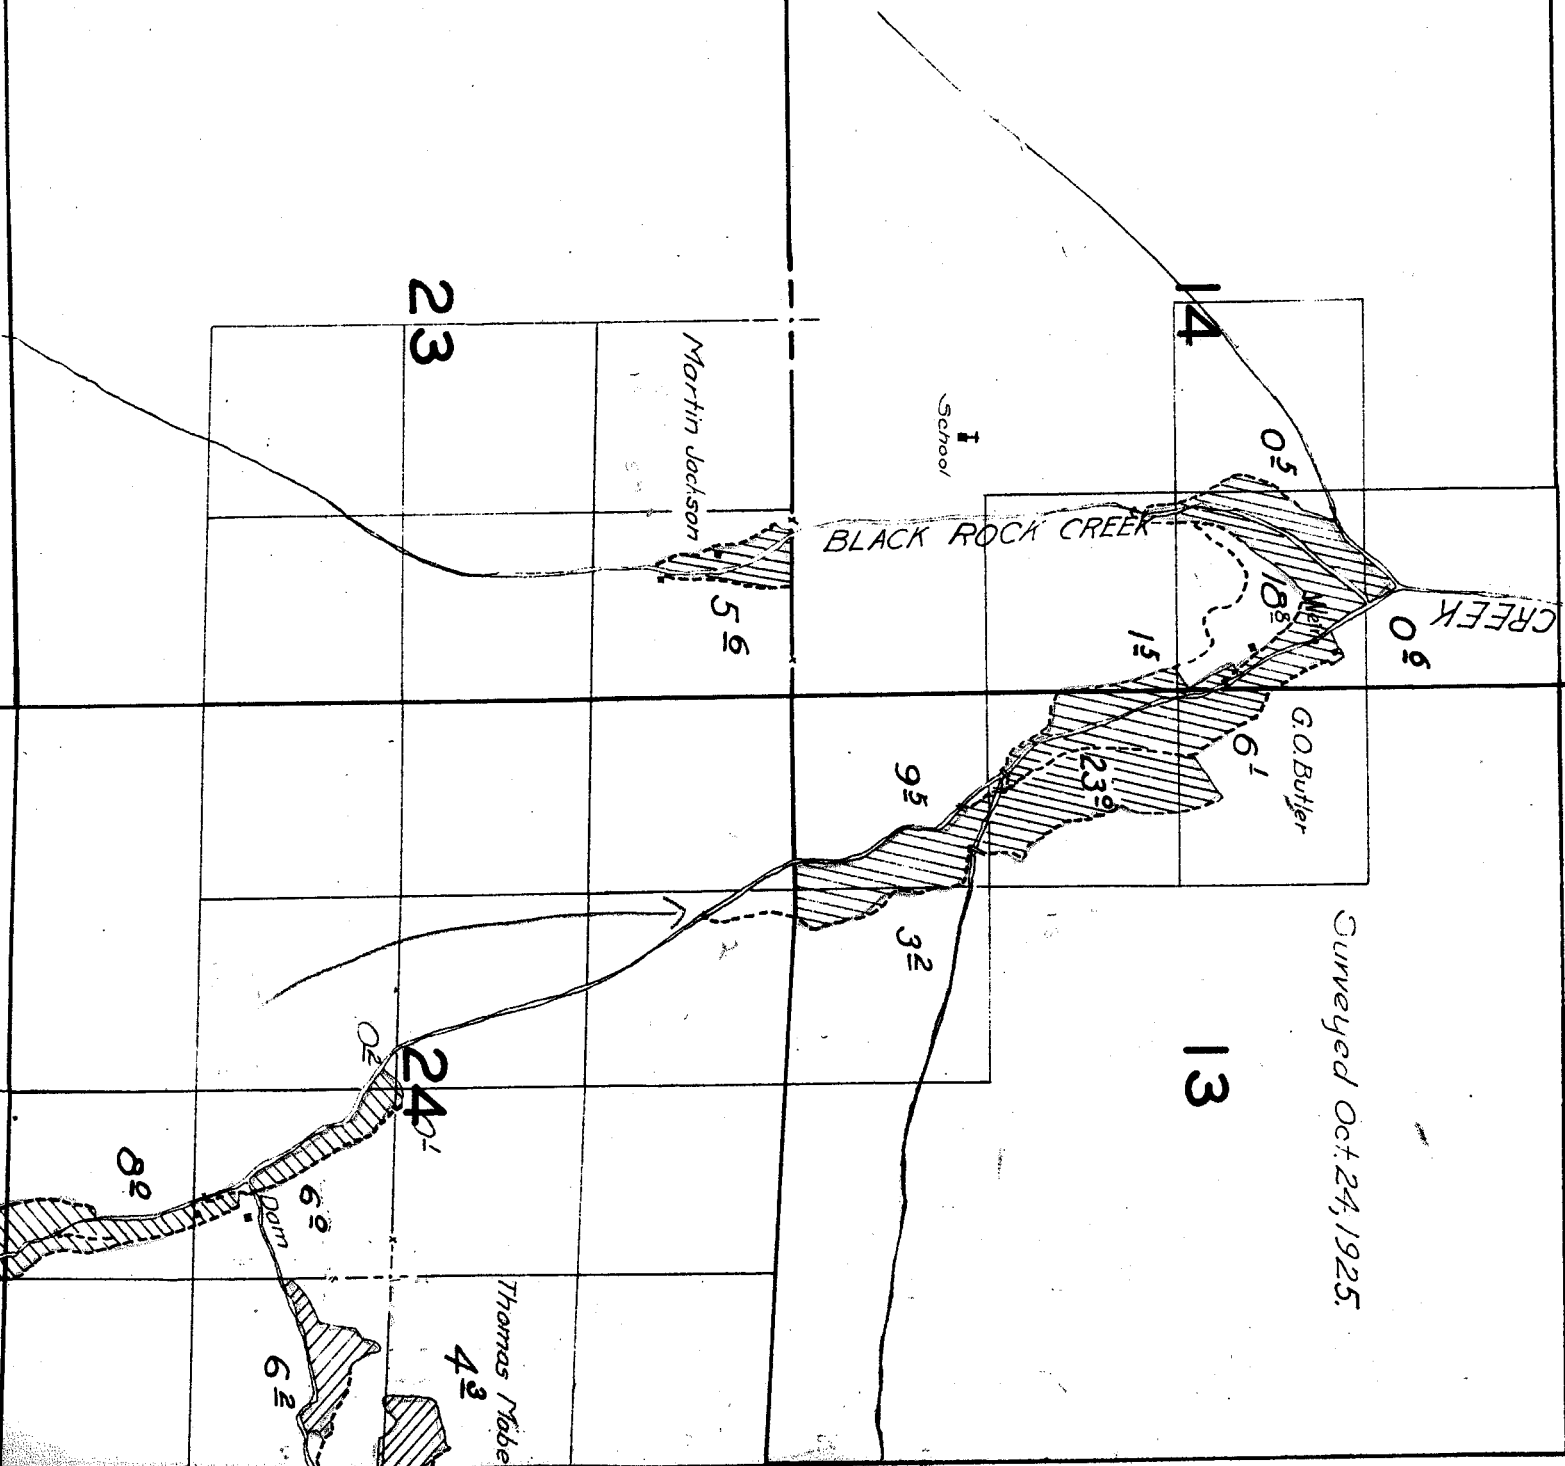

NGE 22 E.

75-2-2

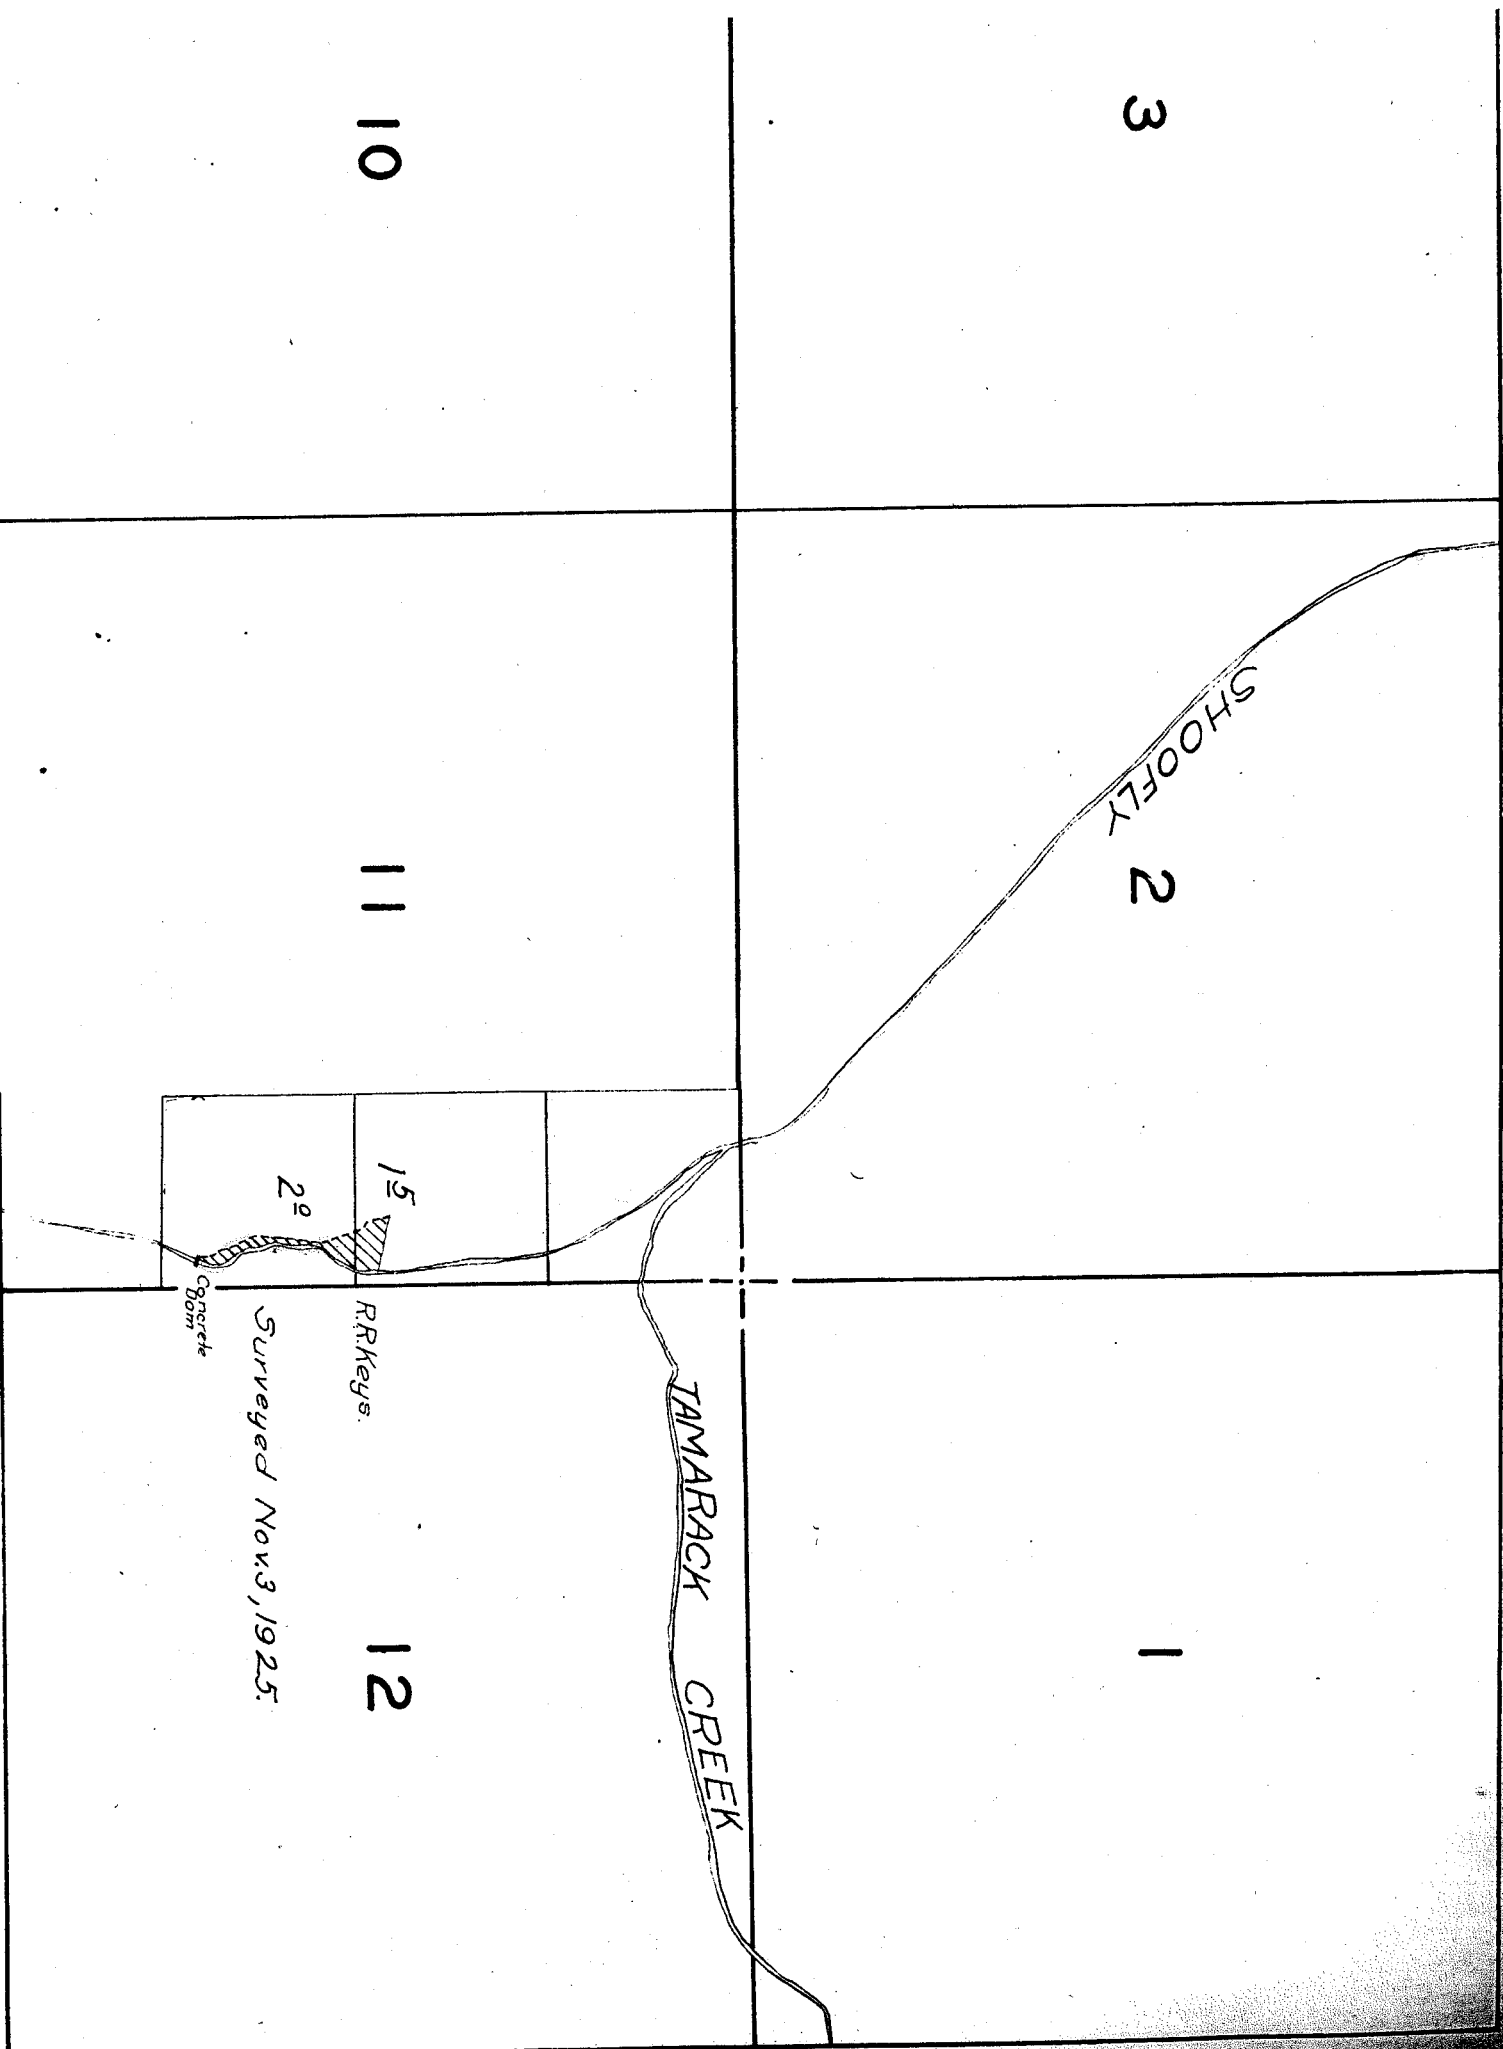

18


17

16

19

20


21

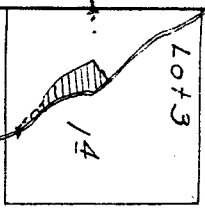

Charlie Shown

Note: Streams and river
vicinity of irrigated land, is
approximate location.

TOWNSHIP

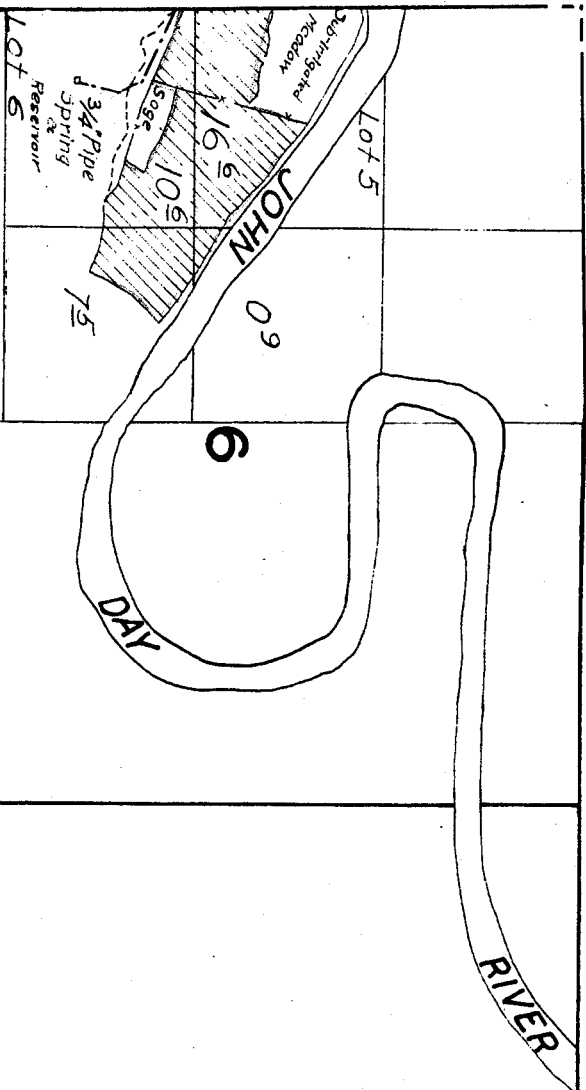

Surveyed Aug. 30, 1926

7

8

9

5

4