

19

20

Lot 3

1/4

Charlie Shown

GIRDS

Rim

Rim

Rocks

30

CREEK

7°

19

1/2

8°

Spring
3/4 ton

Winlock Hendricks

Pond

10°

6°

32

7°

3°

6°

Surveyed Sept. 4, 1926.

31

23

24

4²

6²
Dam

6²

8²

7²
Flume

04

Ed. Shoun
(R.R. Wills)

25

4²

28²

04

27²

13⁵

Sage Brush

26

35

36

Surveyed Nov. 4, 1925.

OWNSHIP 10 S., RANGE 22 E.

4

3

9

10

16

15

17

16

15

20

21

22

*Note: Streams and river, except in
vicinity of irrigated land, sketched in
approximate location.*

52

27

34


28

33

9


3^o

6^o

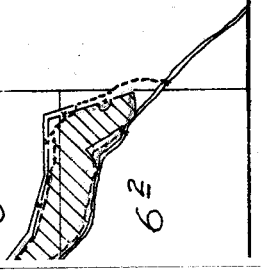


NGE 22 E.


75-2-2

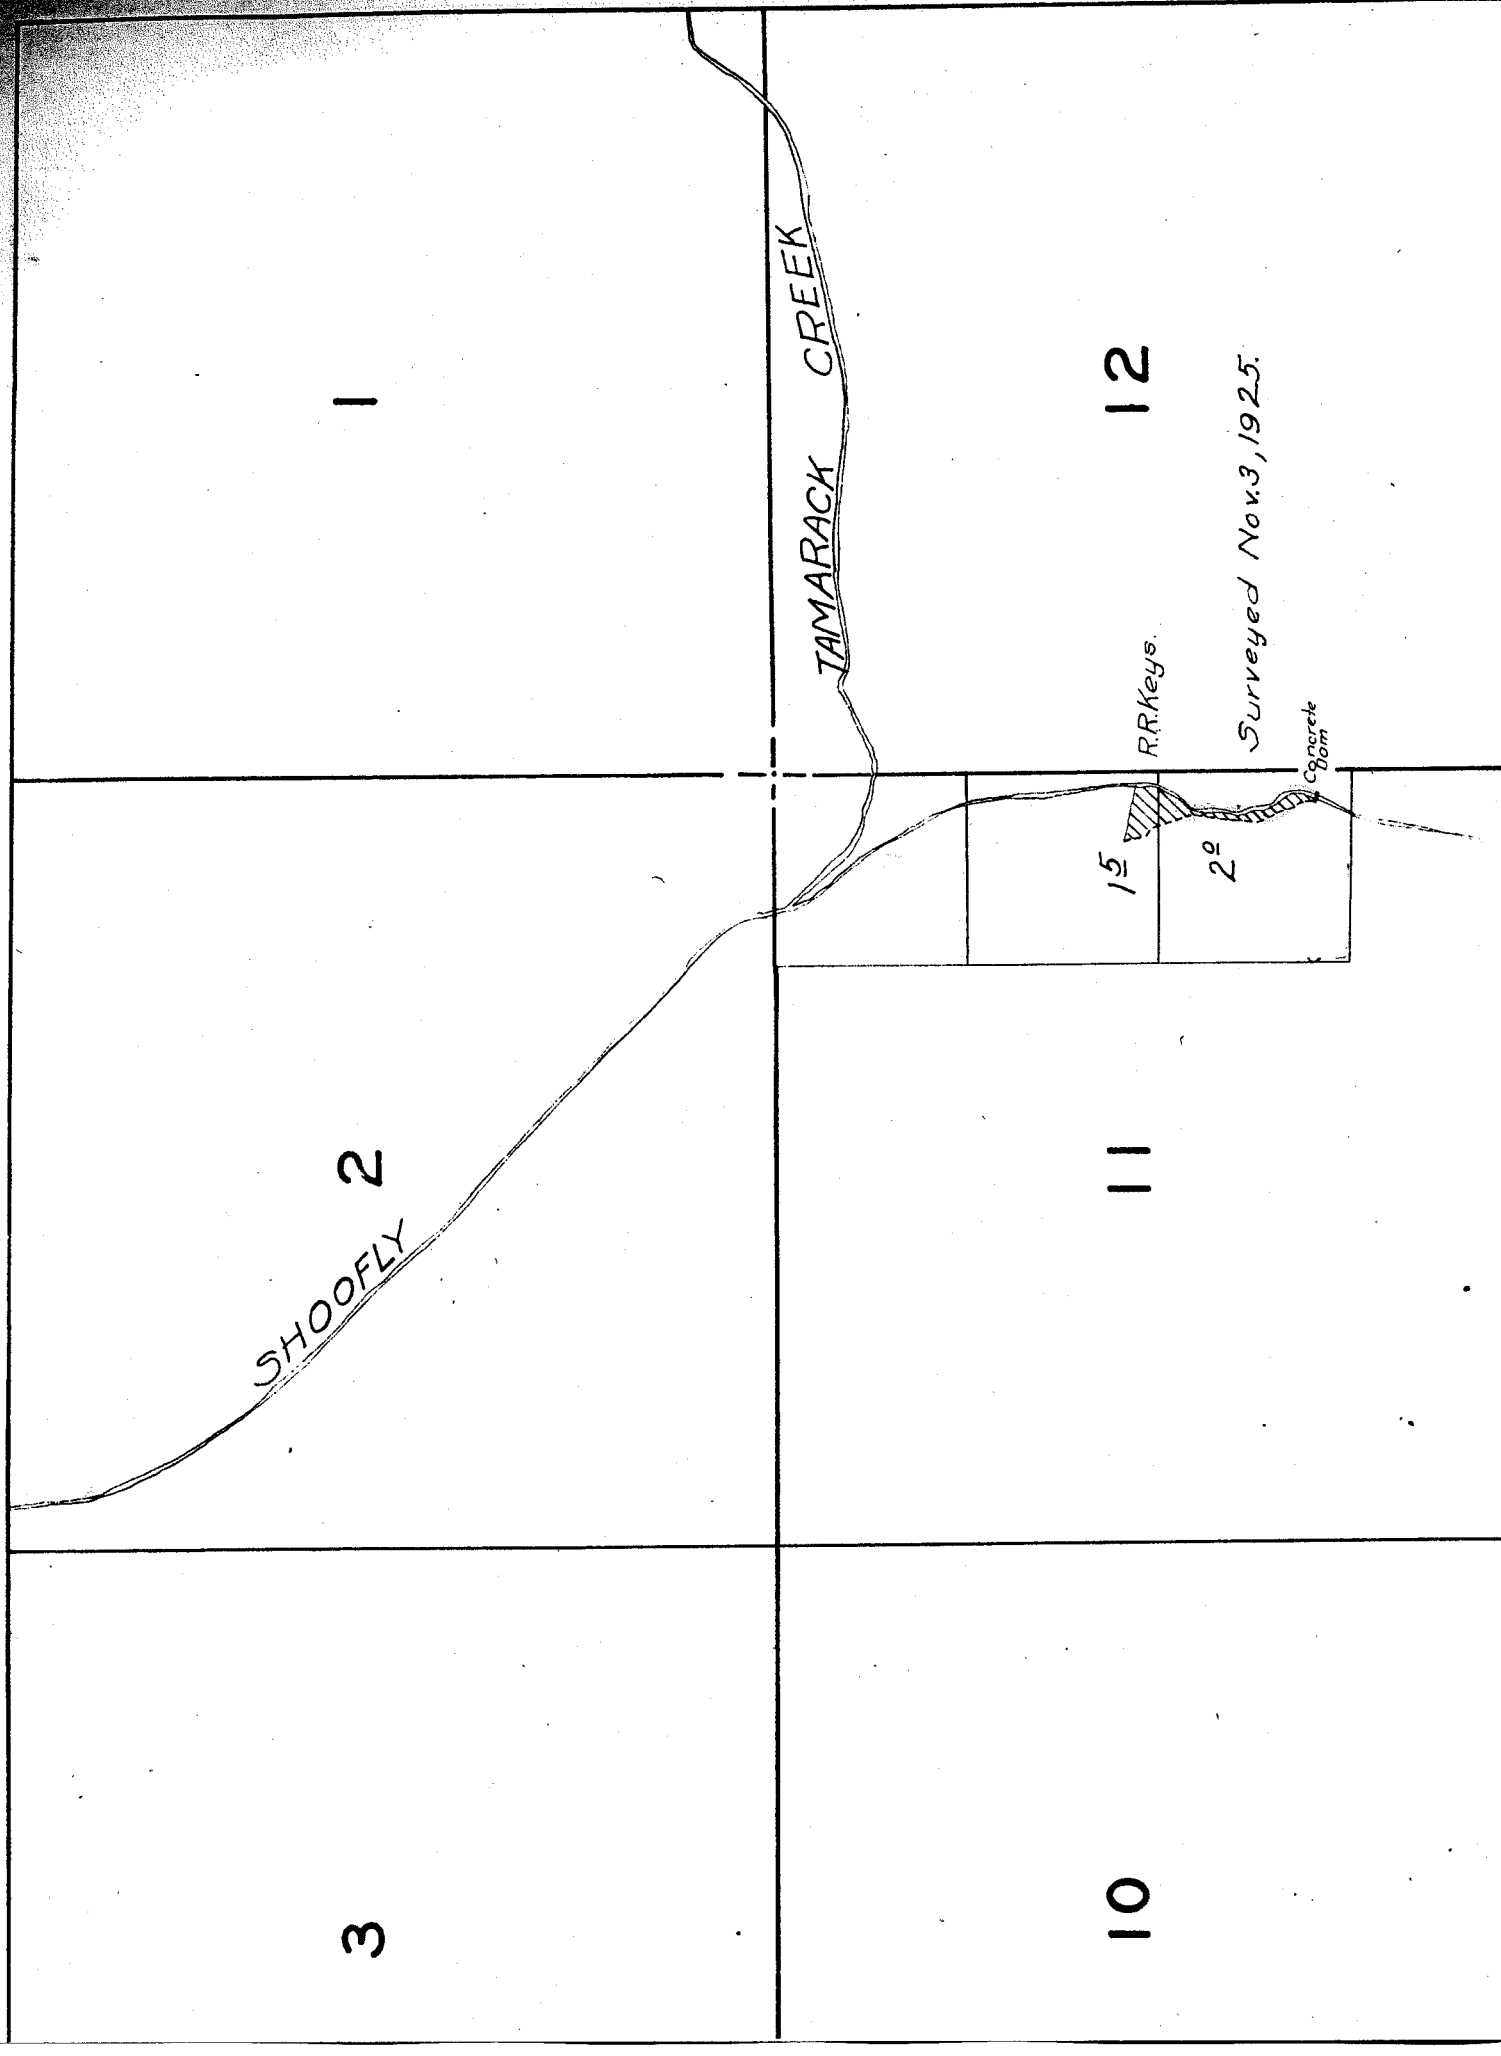

Surveyed Oct. 24, 1925.

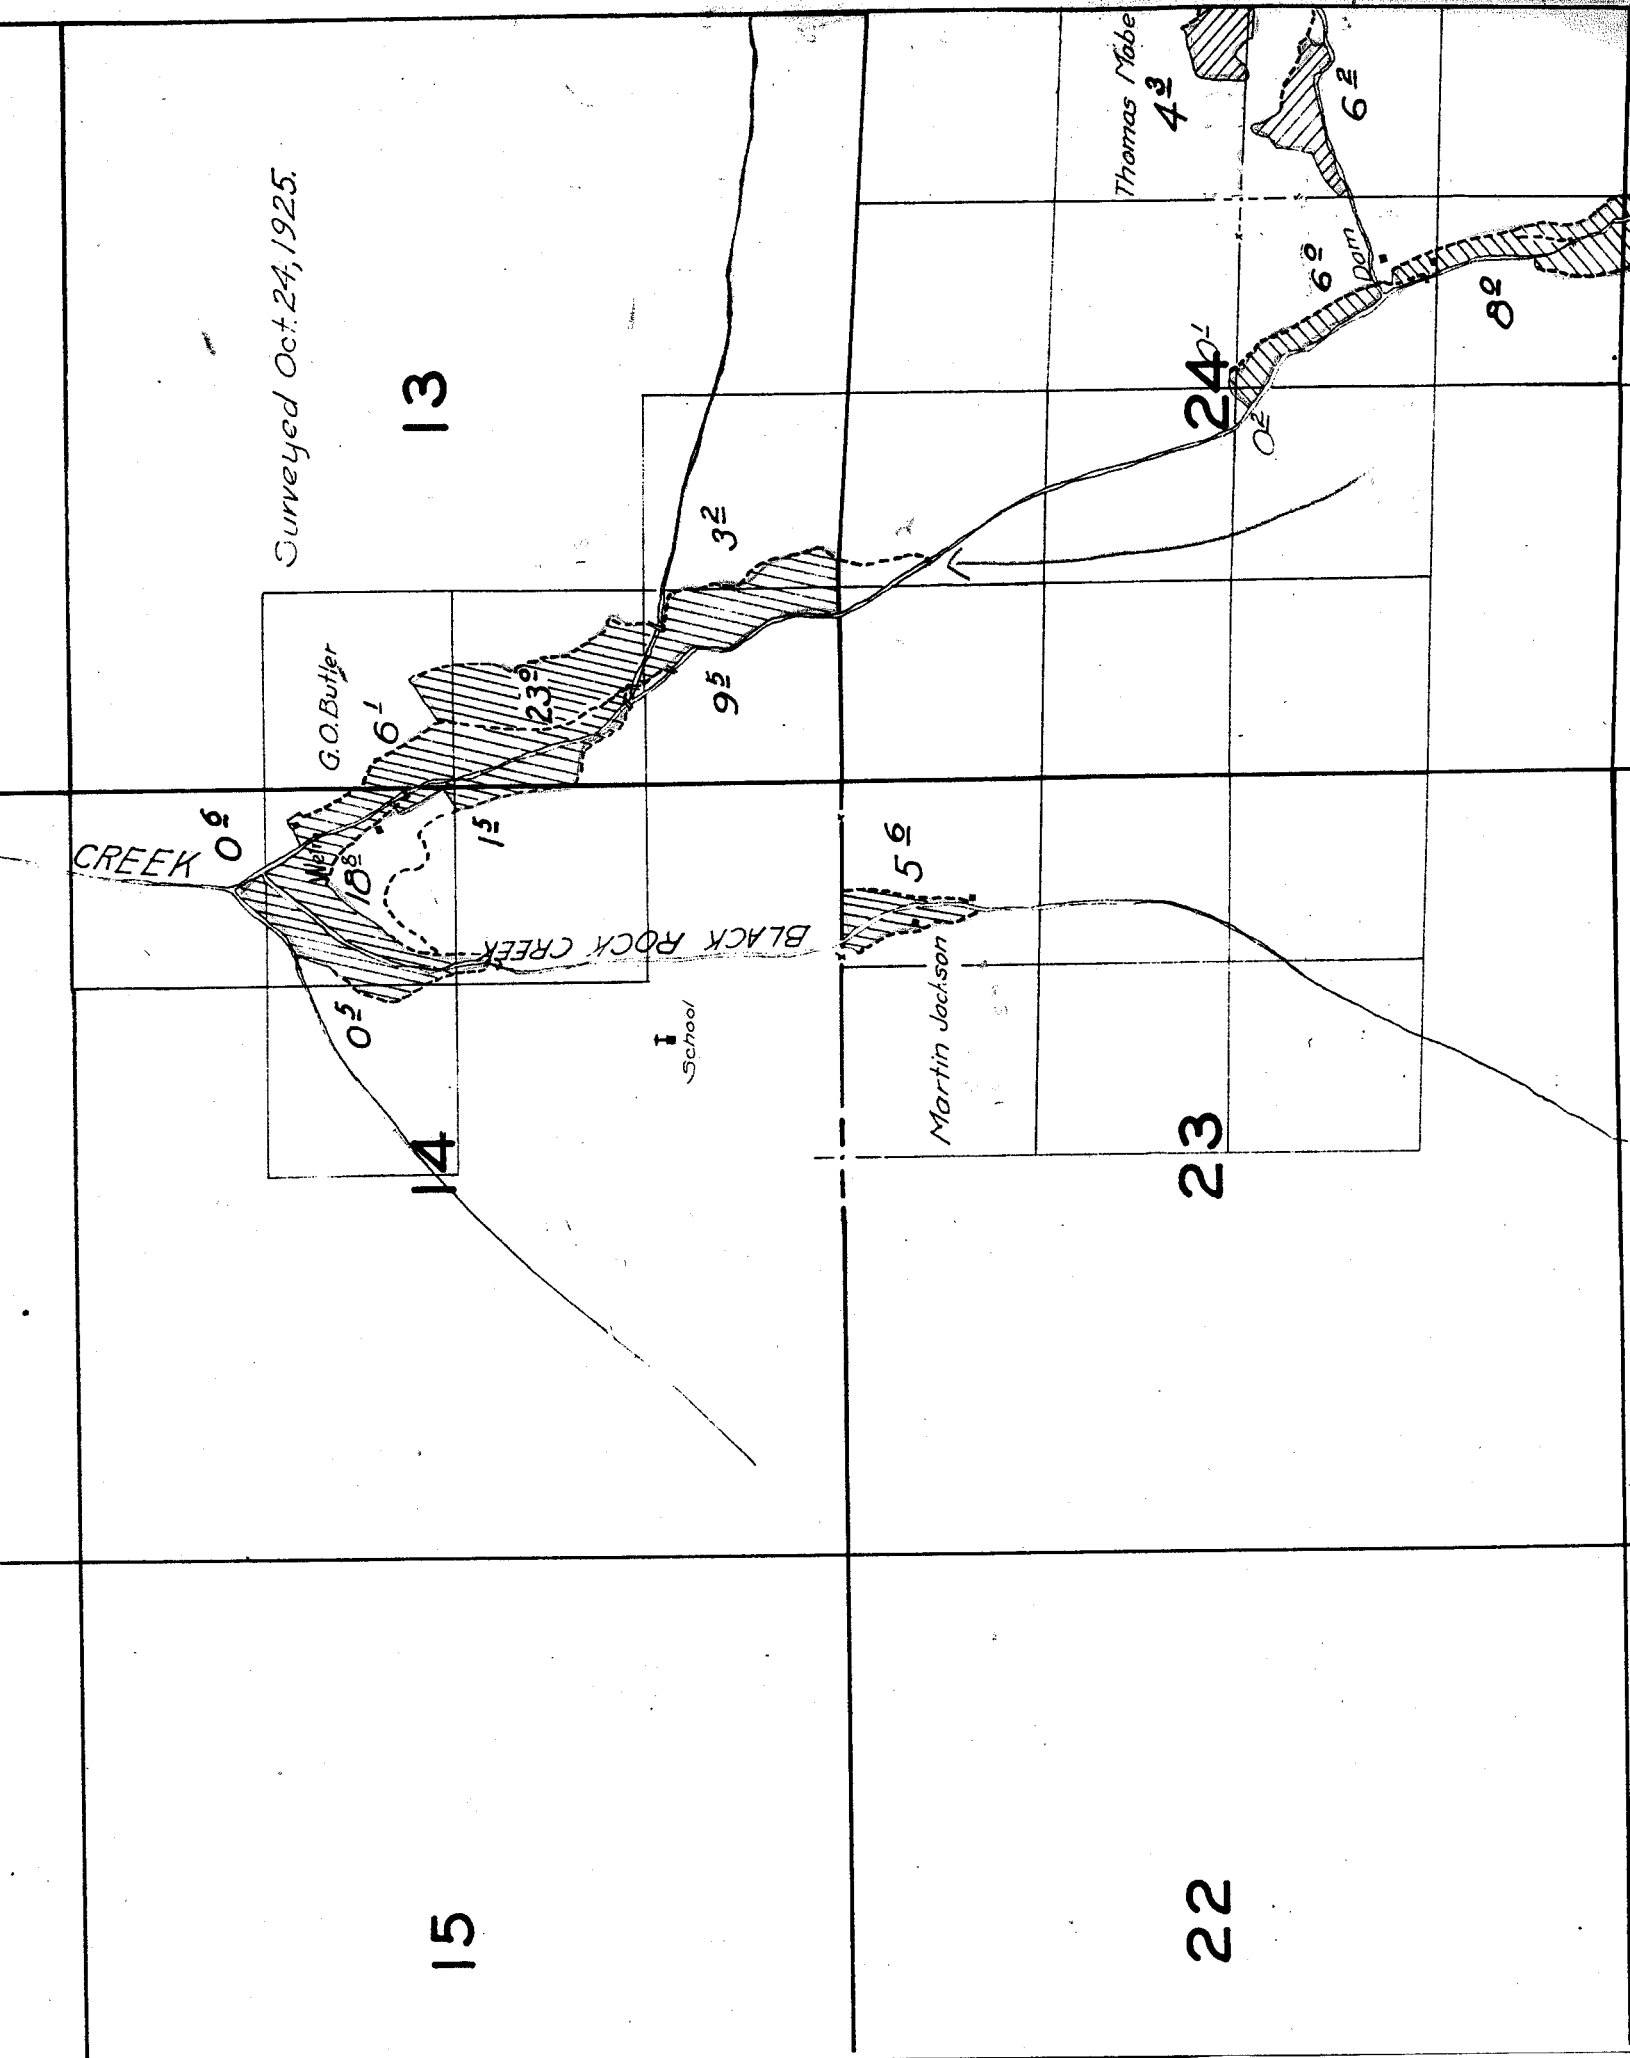

TOWNSHIP

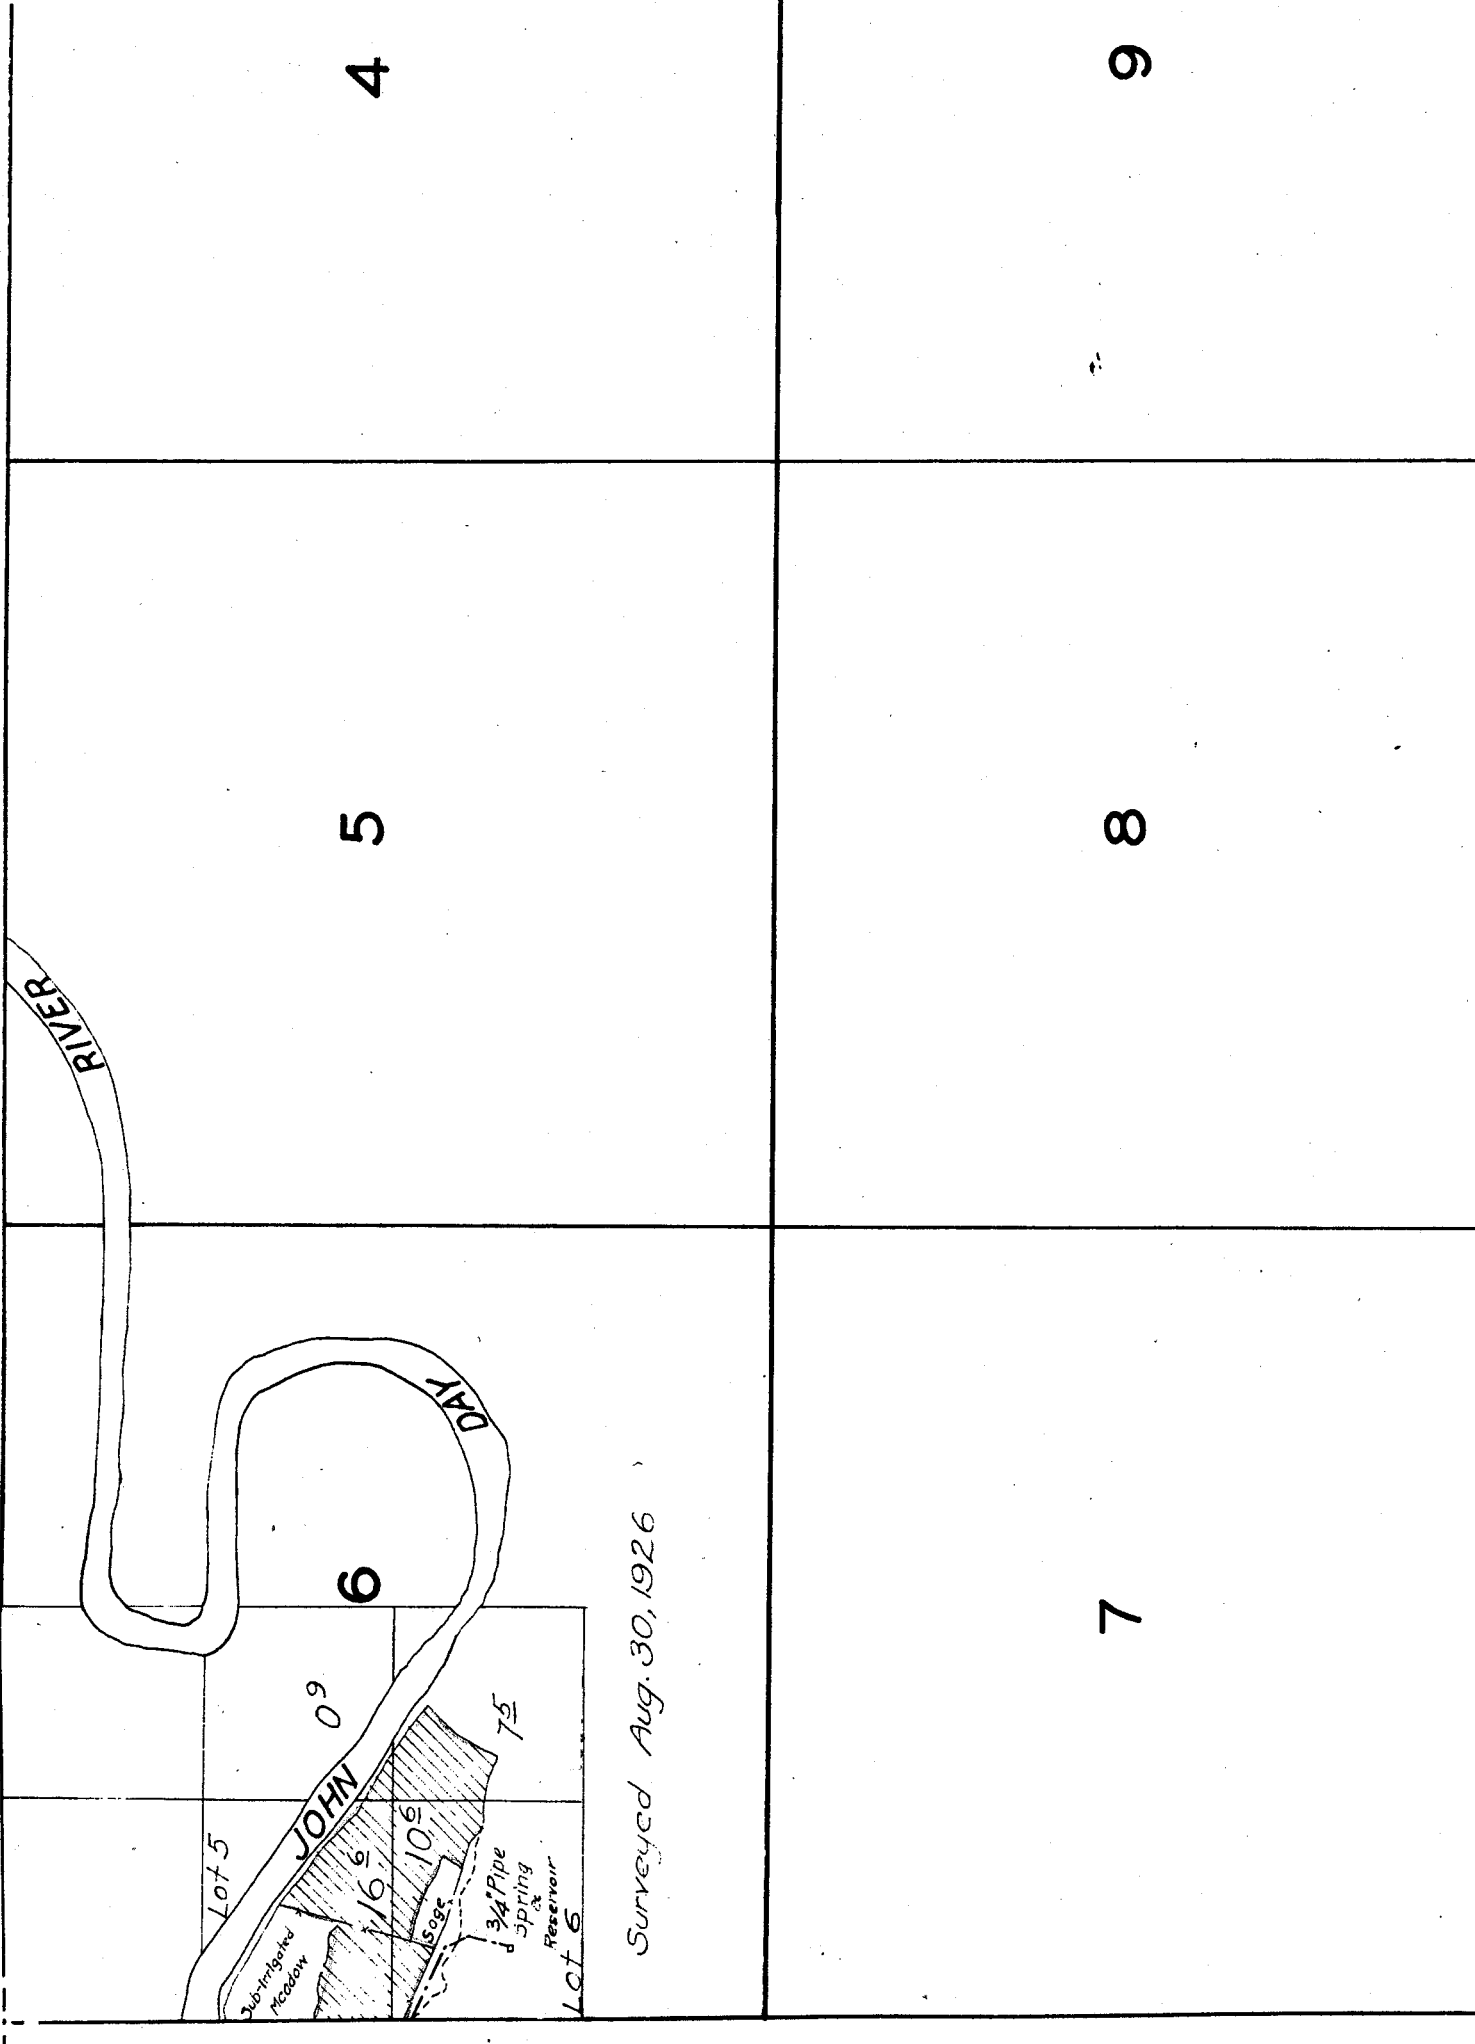

18

17


16

19

20

21

Charlie Shown

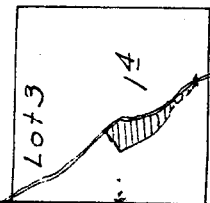

*Note: Streams and river
vicinity of irrigated land's
approximate location.*