


6

5

7

8

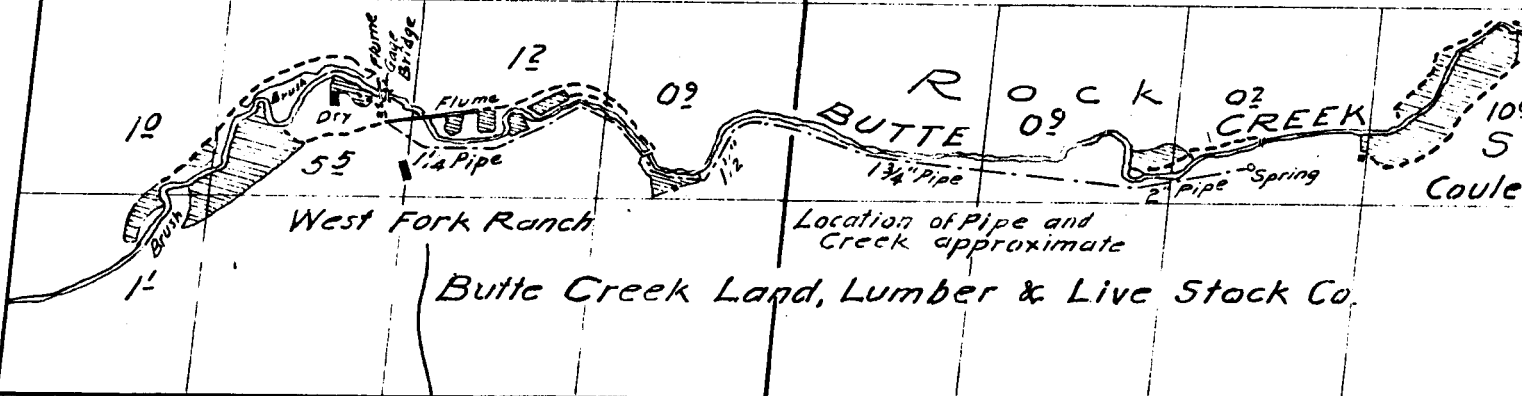

18

17

WEST
FORK

2

1

11

12

14


13

21

22

NOTE: Streams sketched in approximate location except in the vicinity of irrigated land.

28

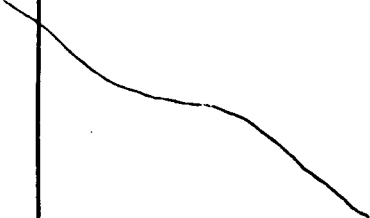


27



33

34

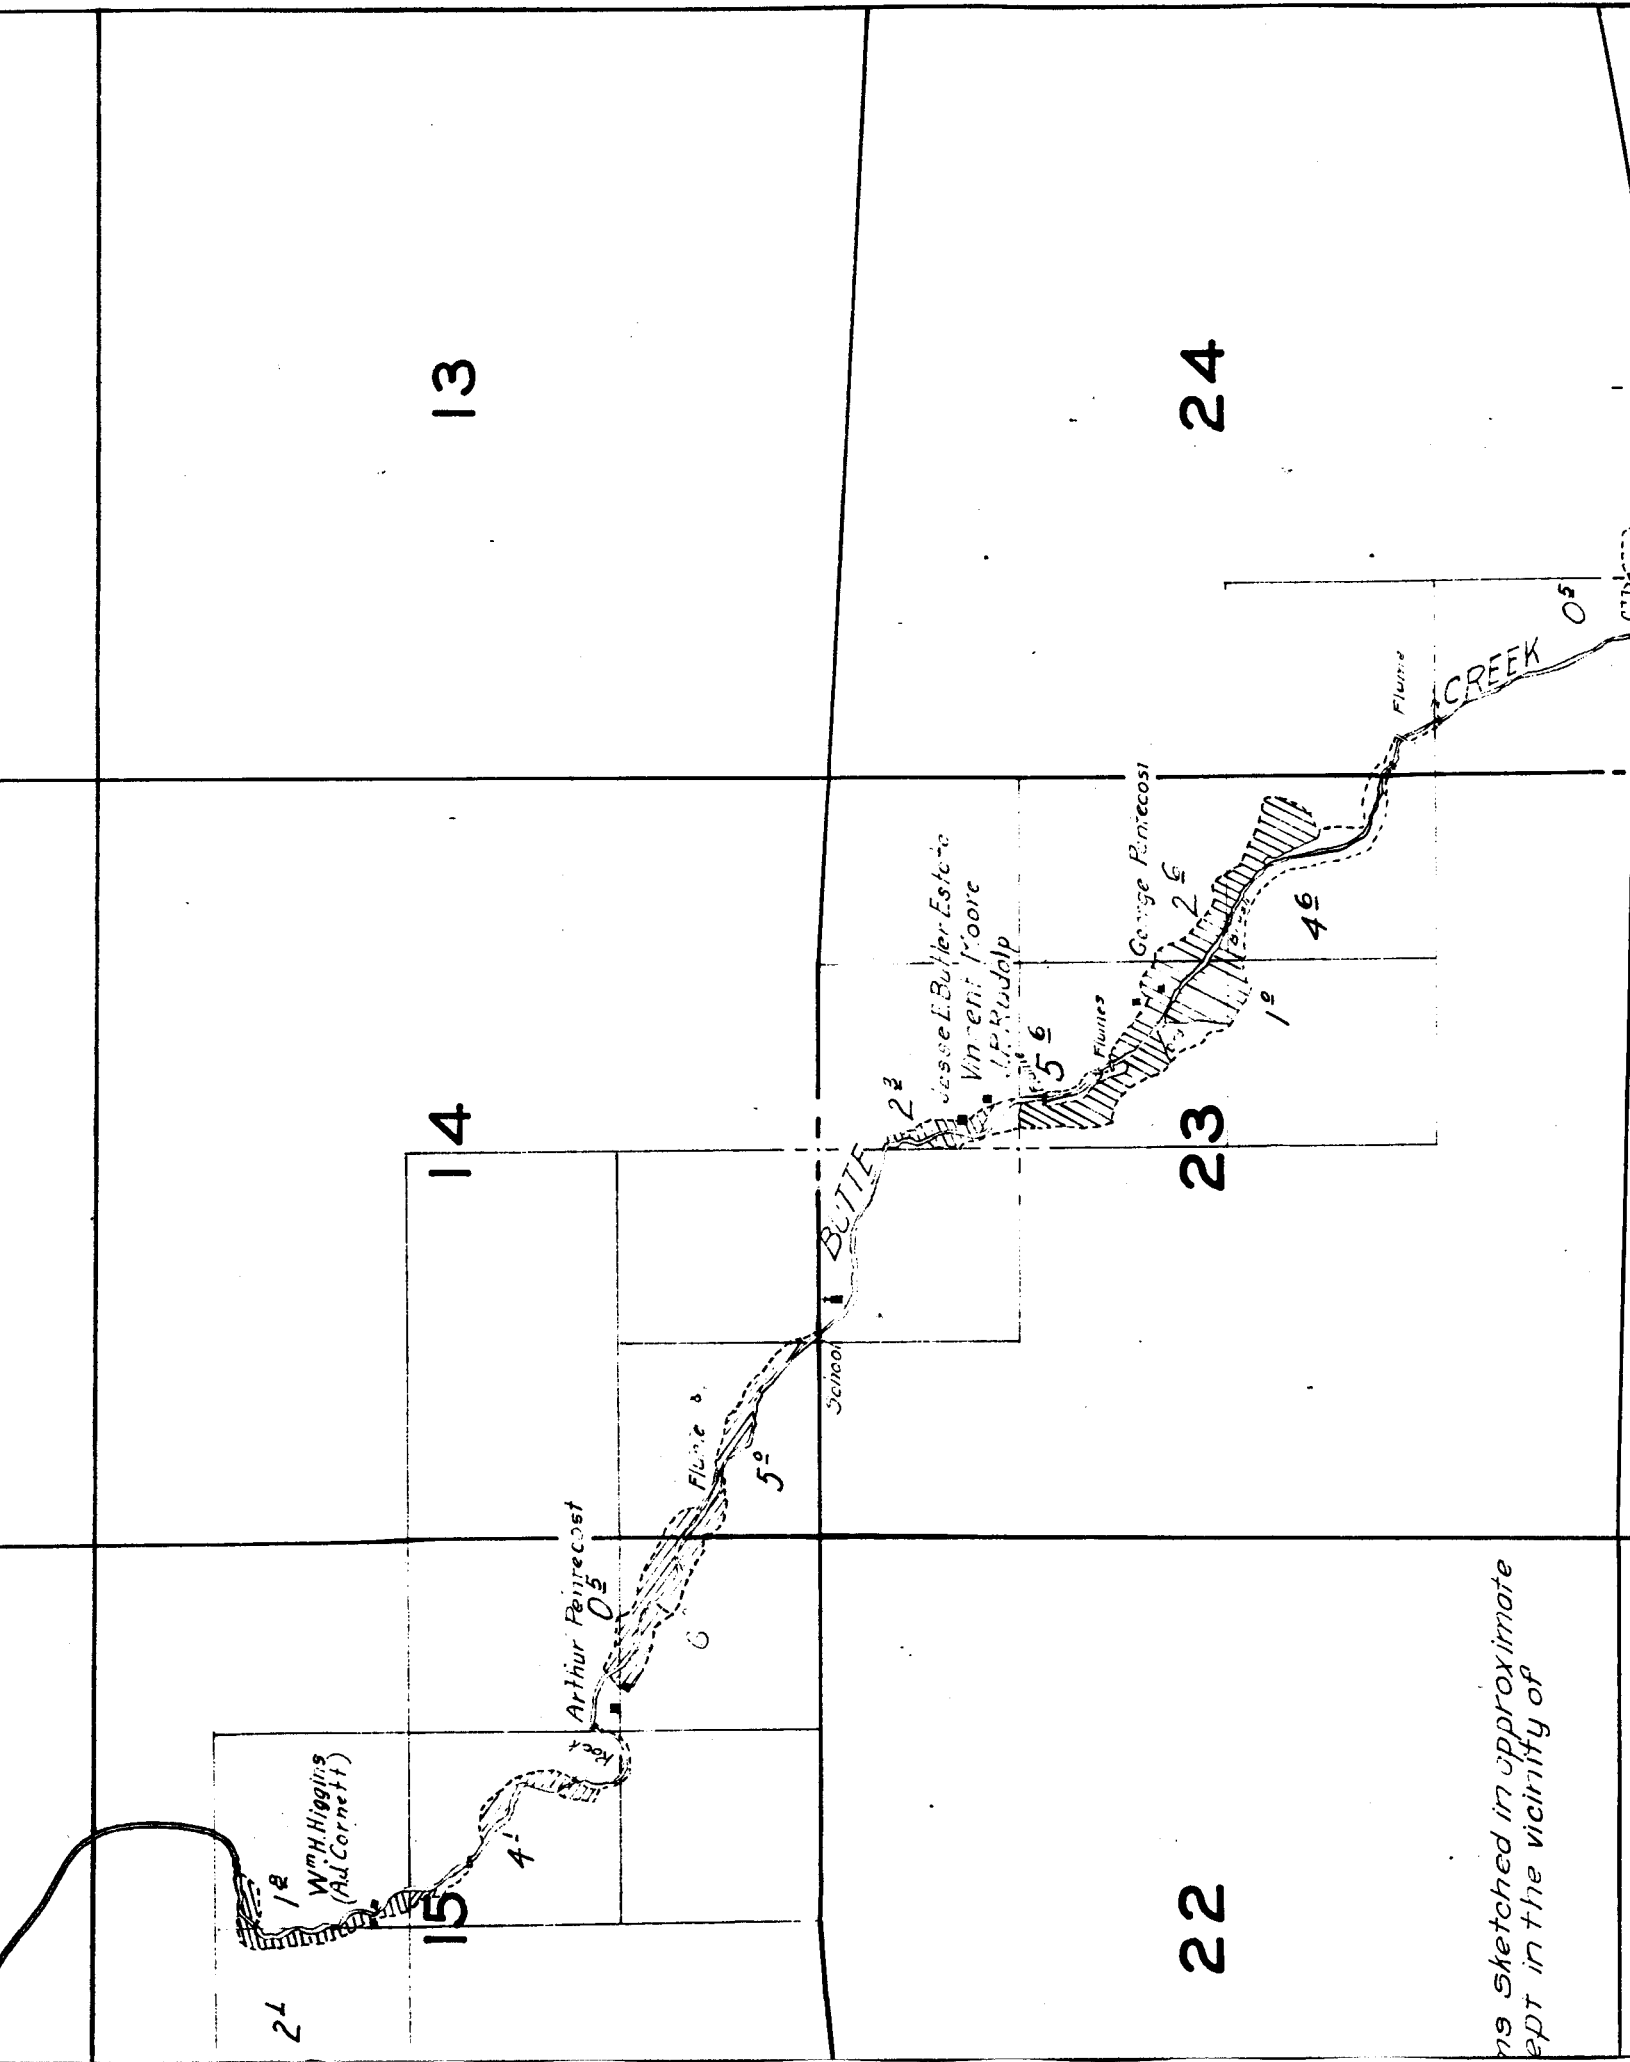

ms sketched in approximate
ept in the vicinity of

27

26

34

35

Steiner & Carpenter Bank

12

500 ft Pipe
Spring

36

Stump Creek

25

32

10

Mrs. Margaret E. Burner
Clifton

23

35

Surveyed Nov. 14 to 18, 1925.

16

21

17

20

CREEK .

FORK

WEST

18

19

x

28

33

29

32

30


31

Stack Co.

x

Surveyed Nov. 14 to 18, 1925.

16

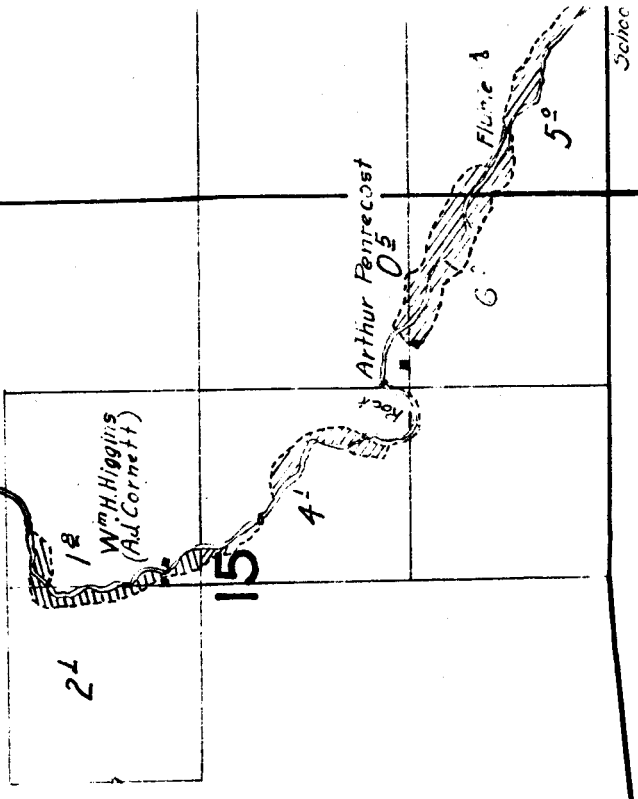

21

22

NOTE: Streams sketched in approximate location except in the vicinity of irrigated land.