


6

5

7

8

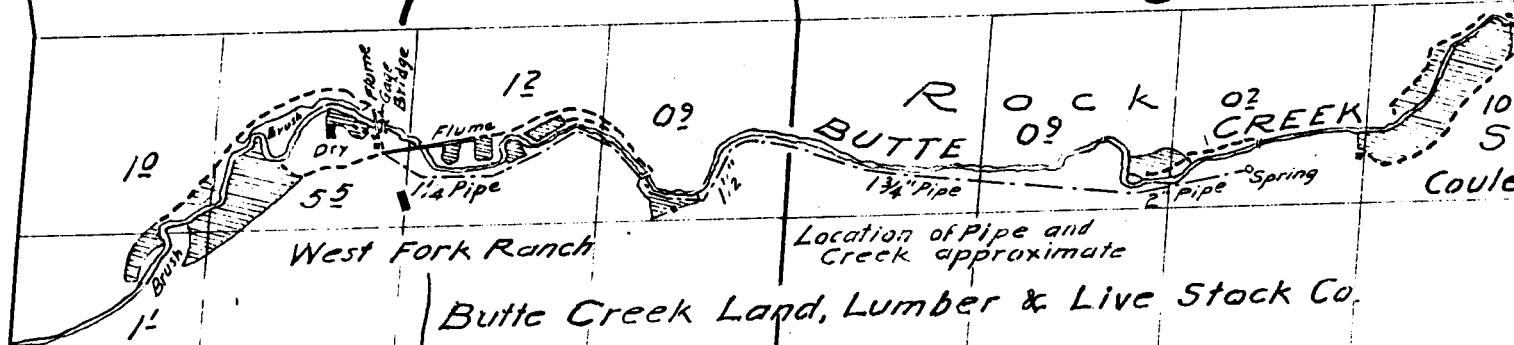

18

17

2

1

11

12

14

13

21


22

NOTE: Streams sketched in approximate location except in the vicinity of irrigated land.

28




27

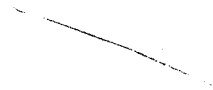


33

34

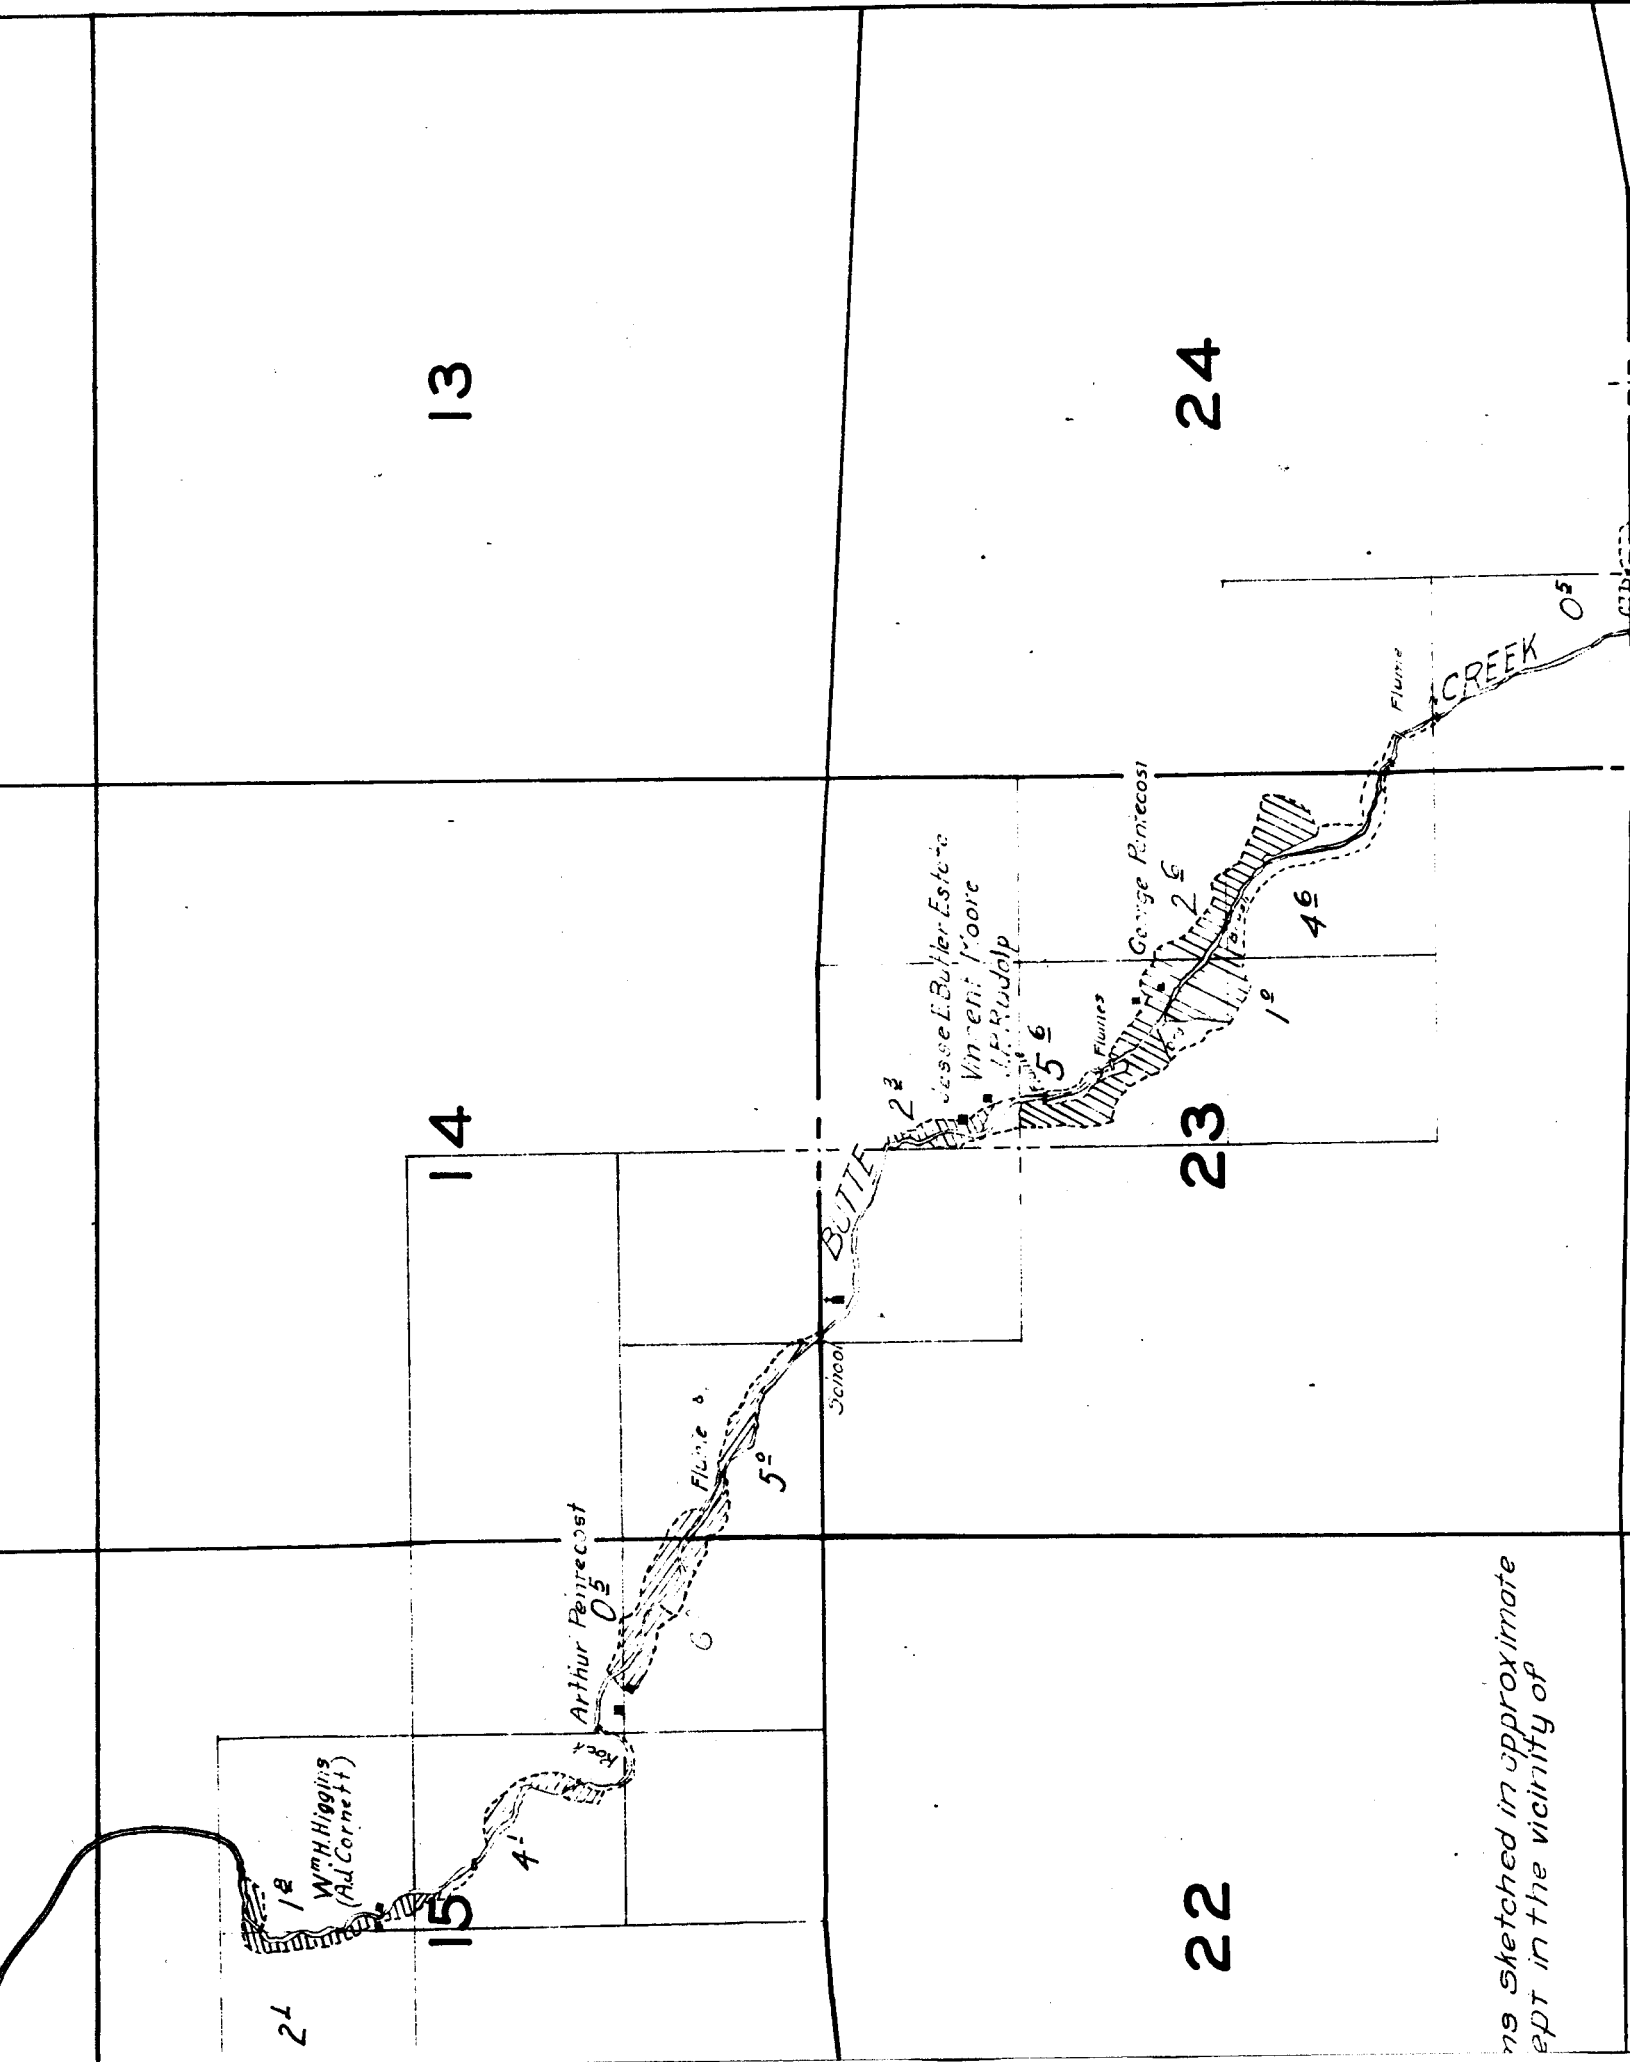

is sketched in approximate
pt in the vicinity of

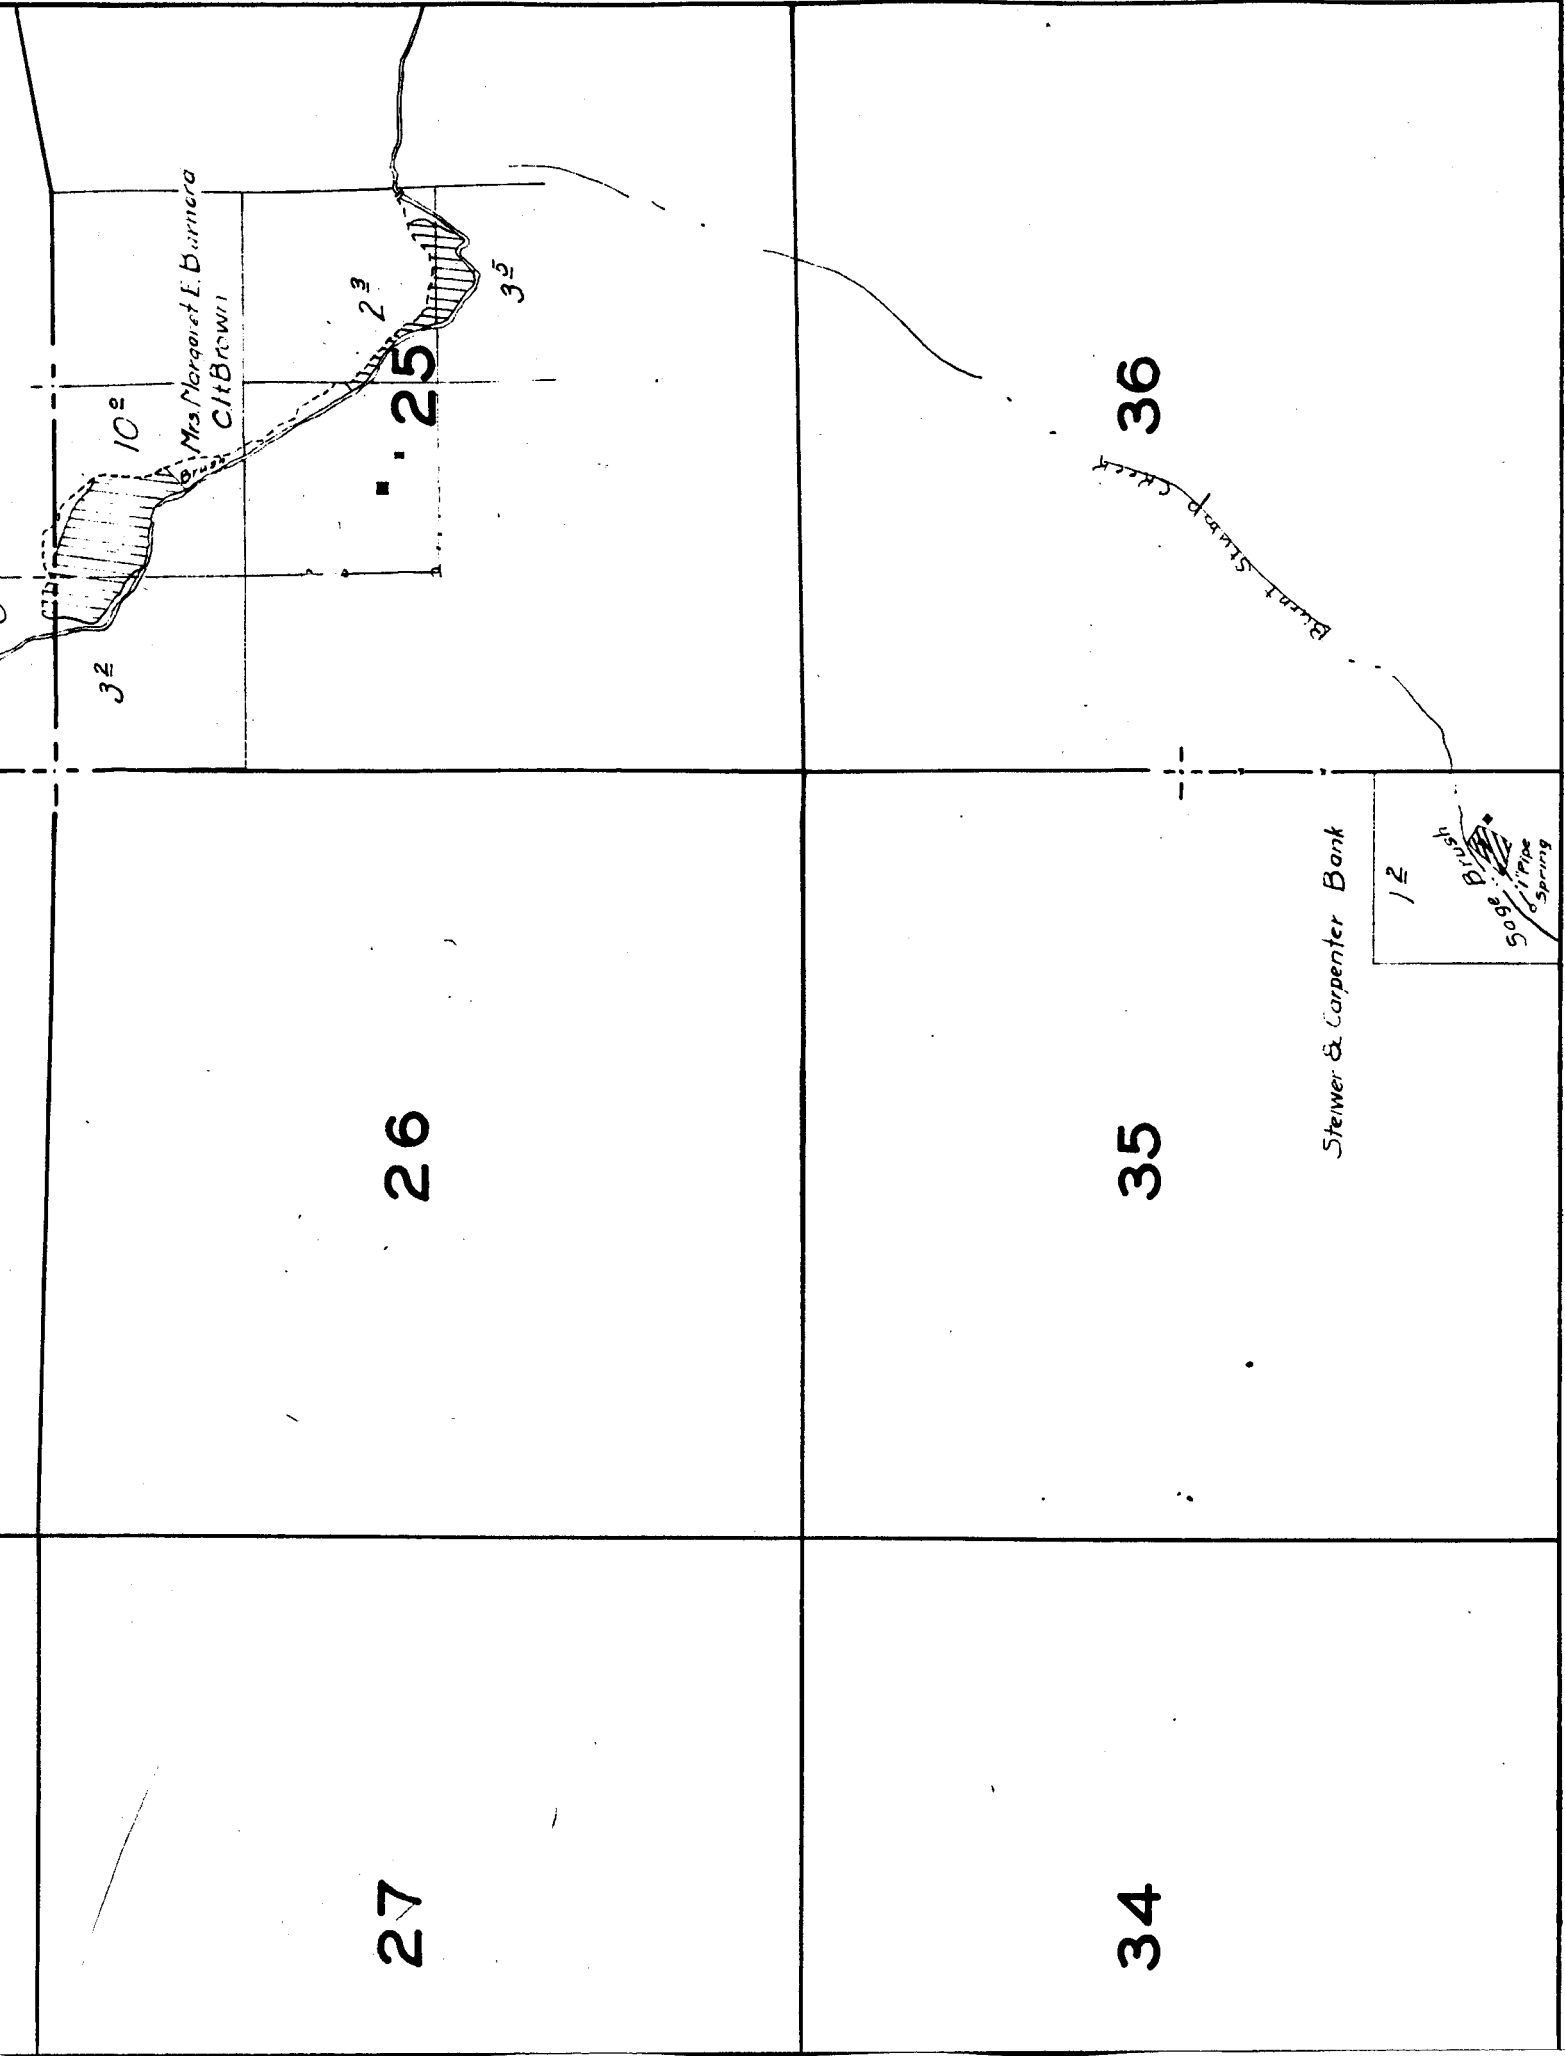

27

26

25

34

35

36

Steiner & Carpenter Bank

12

509
Blount
Pipe
Spring

Surveyed Nov. 14 to 18, 1925.

16

21

17

20

CREEK

FORK

WEST

18

19

28

33


29

32

30

31

TOWNSHIP 6 S., RANGE 20 E.

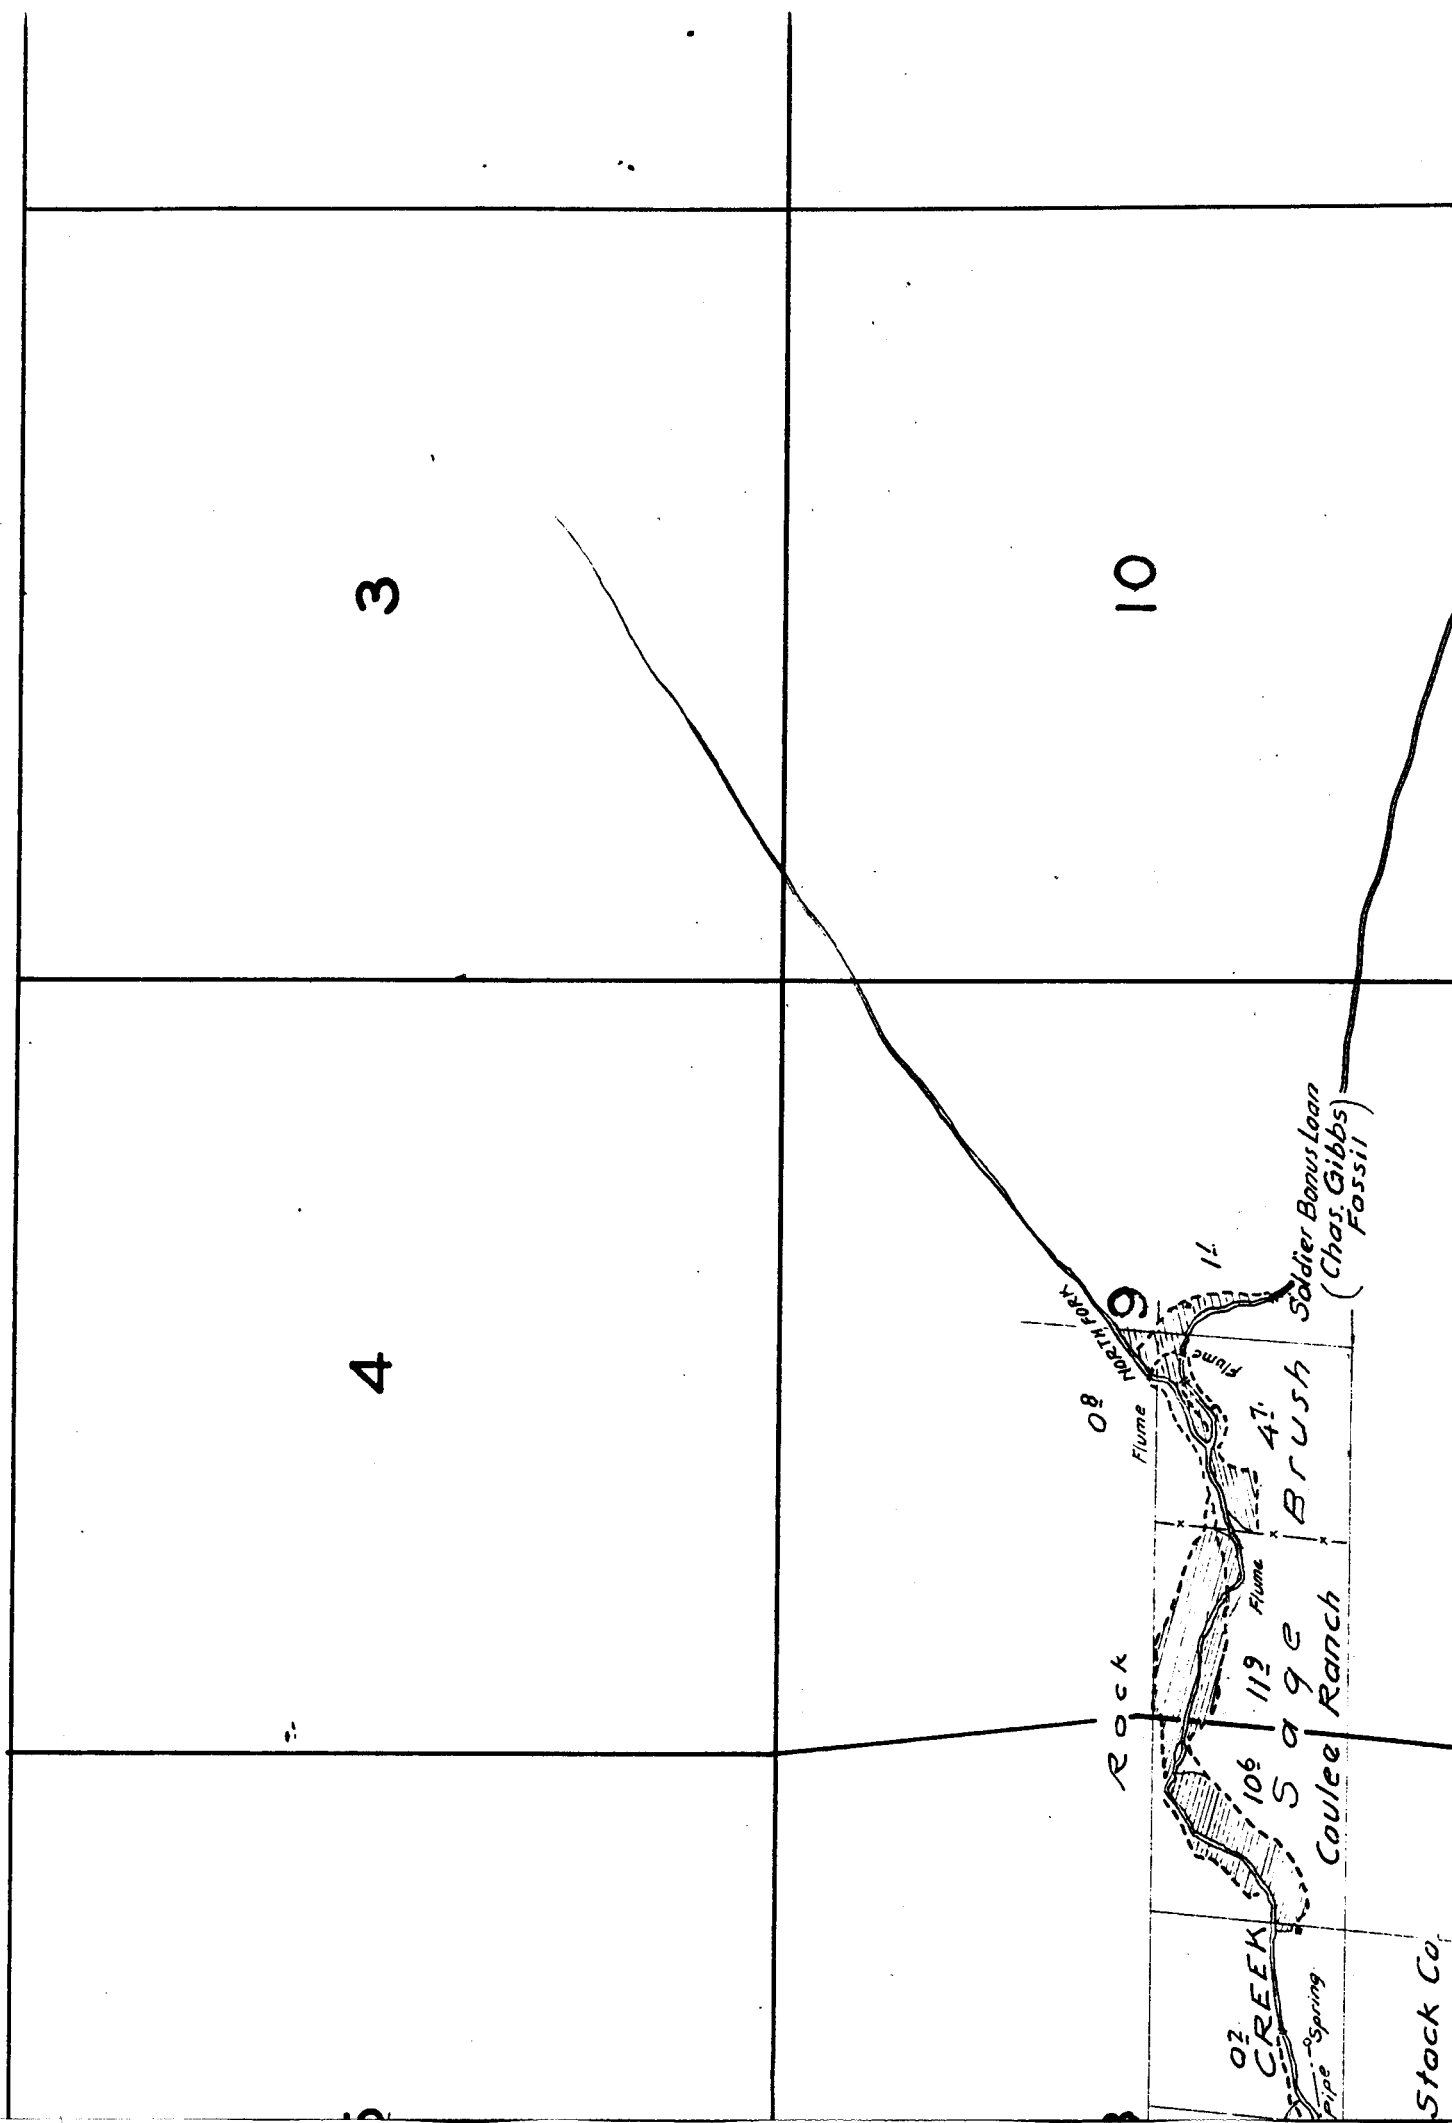

Stack Co.

x

Surveyed Nov. 14 to 18, 1925.

16

21

Wm H. Higgins
(Ad. Cornett)

15

41

Arthur Pentecost
D. S.

Flume A

50

Sebec

21

22

NOTE: Streams sketched in approximate location except in the vicinity of irrigated land.