

27

29

34

33

25,1926.

ber & Live Stock Co.

rch

15

16

Note: Streams and river, except in vicinity of irrigated lands, sketched in approximate location.

22

21

19

20

30


29

Sub-irrigation
Farm Lane

Surveyed Aug. 25, 1926.

E.A. Mauer
31

Frank Knox
32

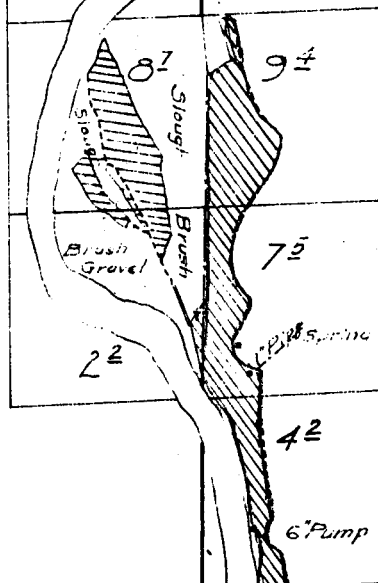

23

24

26

25

35

36

TOWNSHIP 6 S., RANGE 19 E.

4

3


9

10

16


15

k Co.

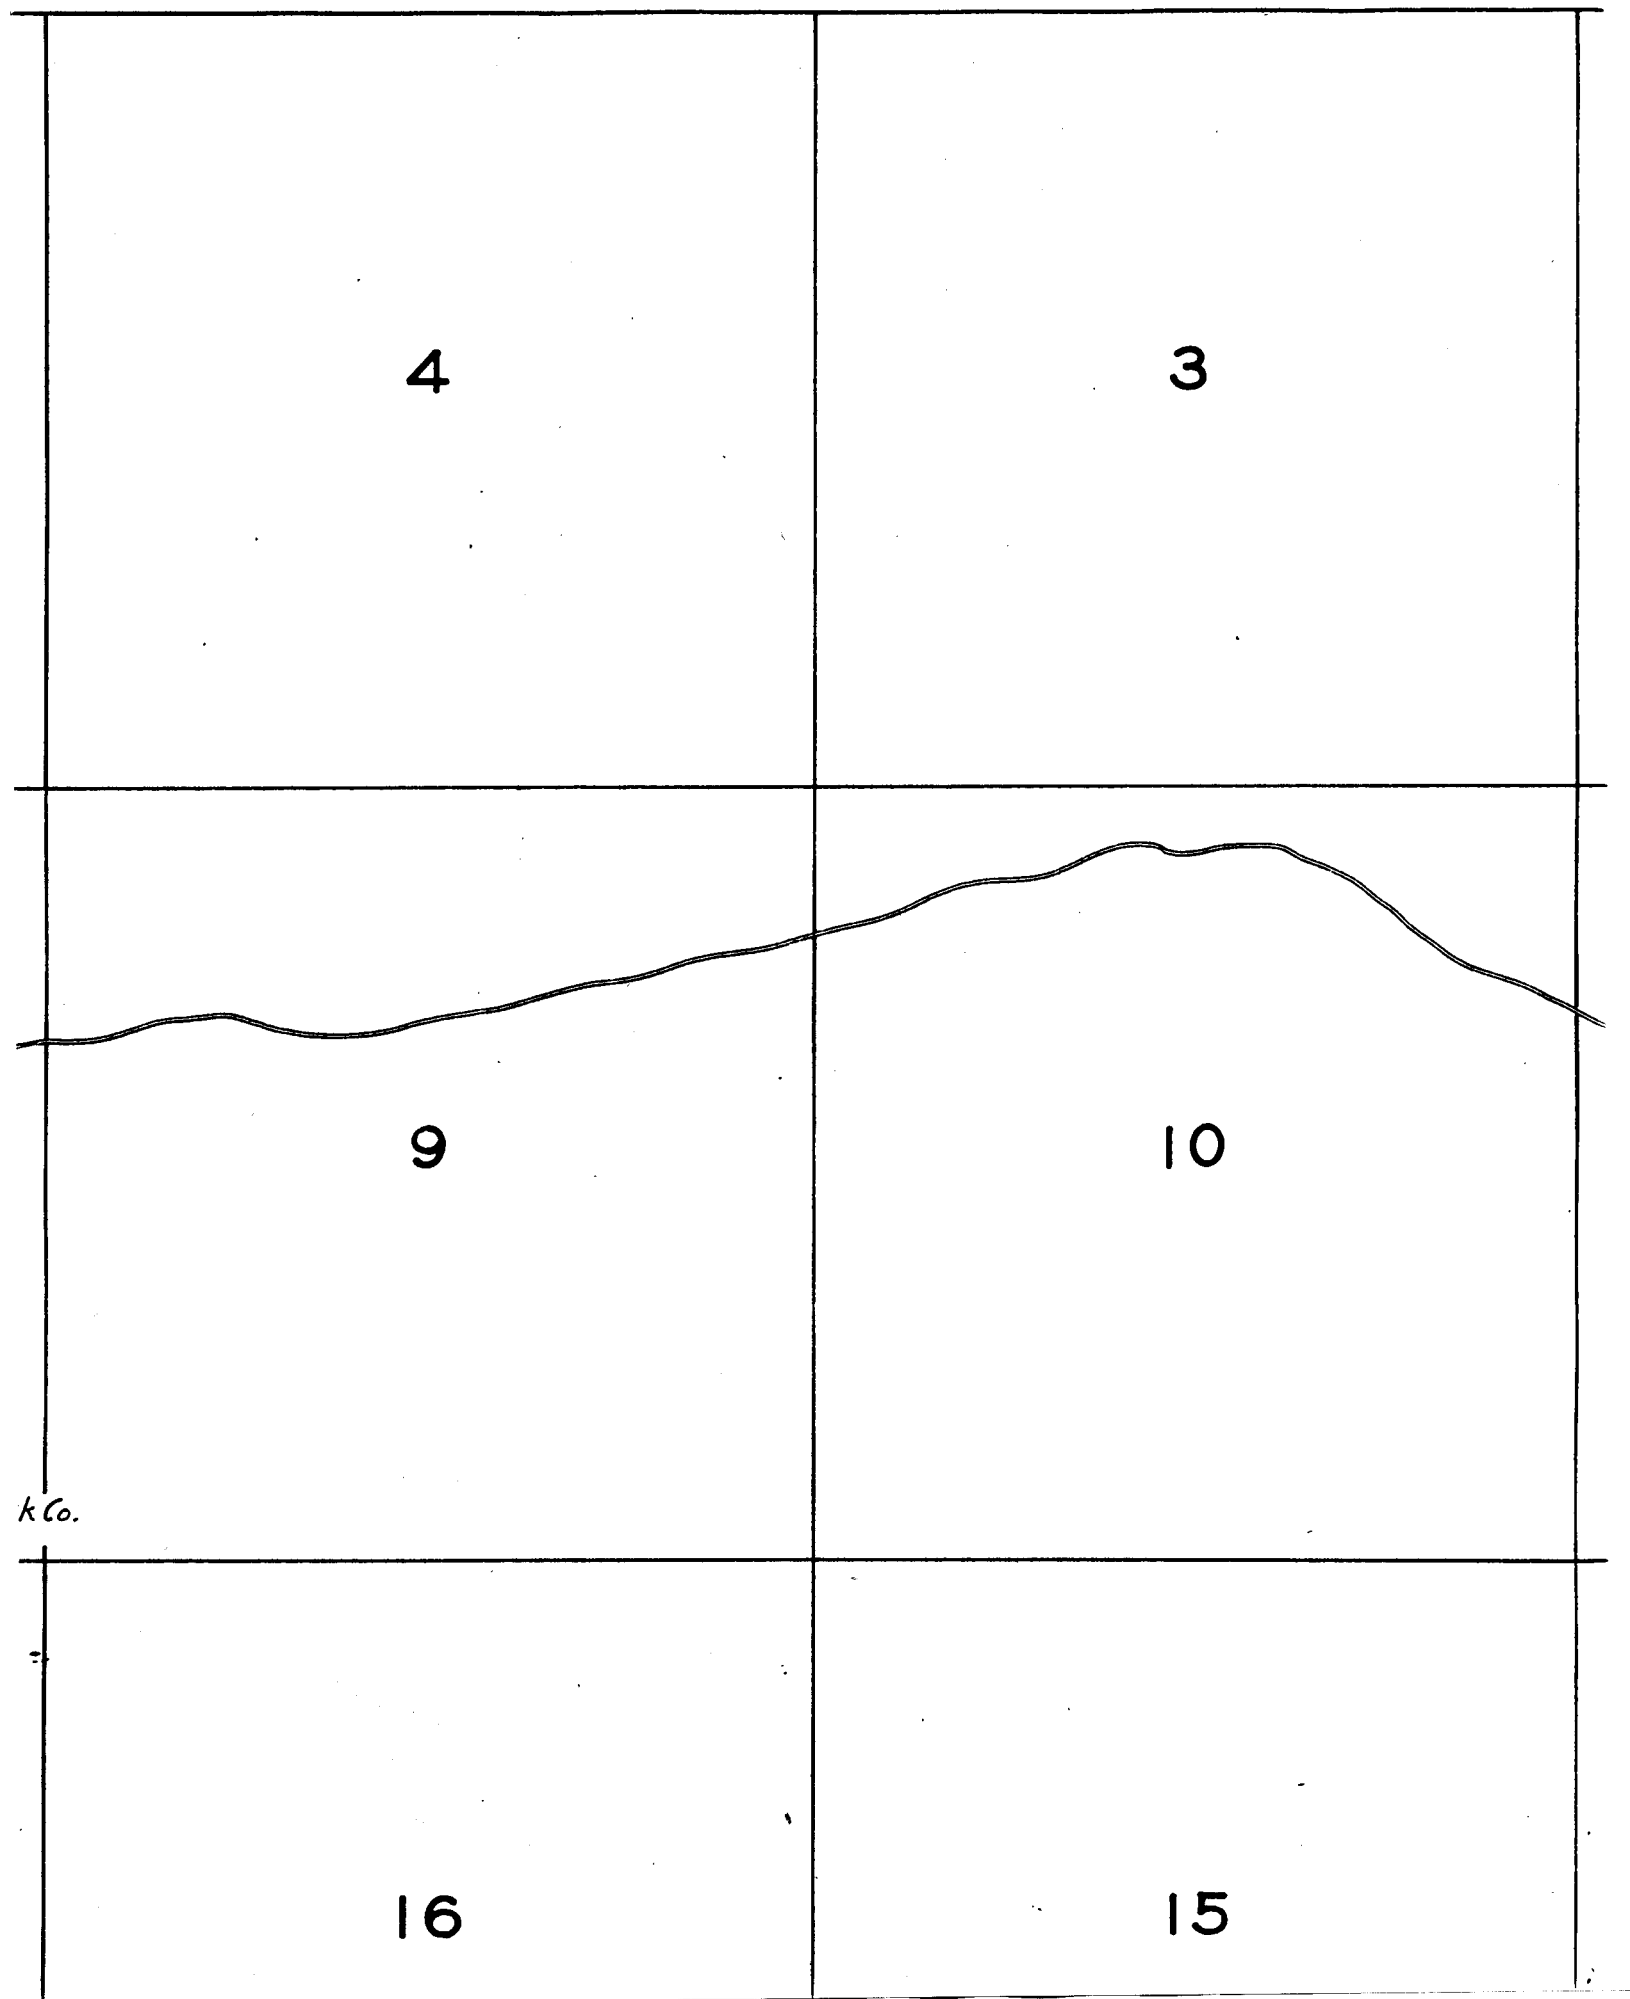


Butte Creek Land Lumber & Live Stock Co.
Fossil, Ore.

River Ranch

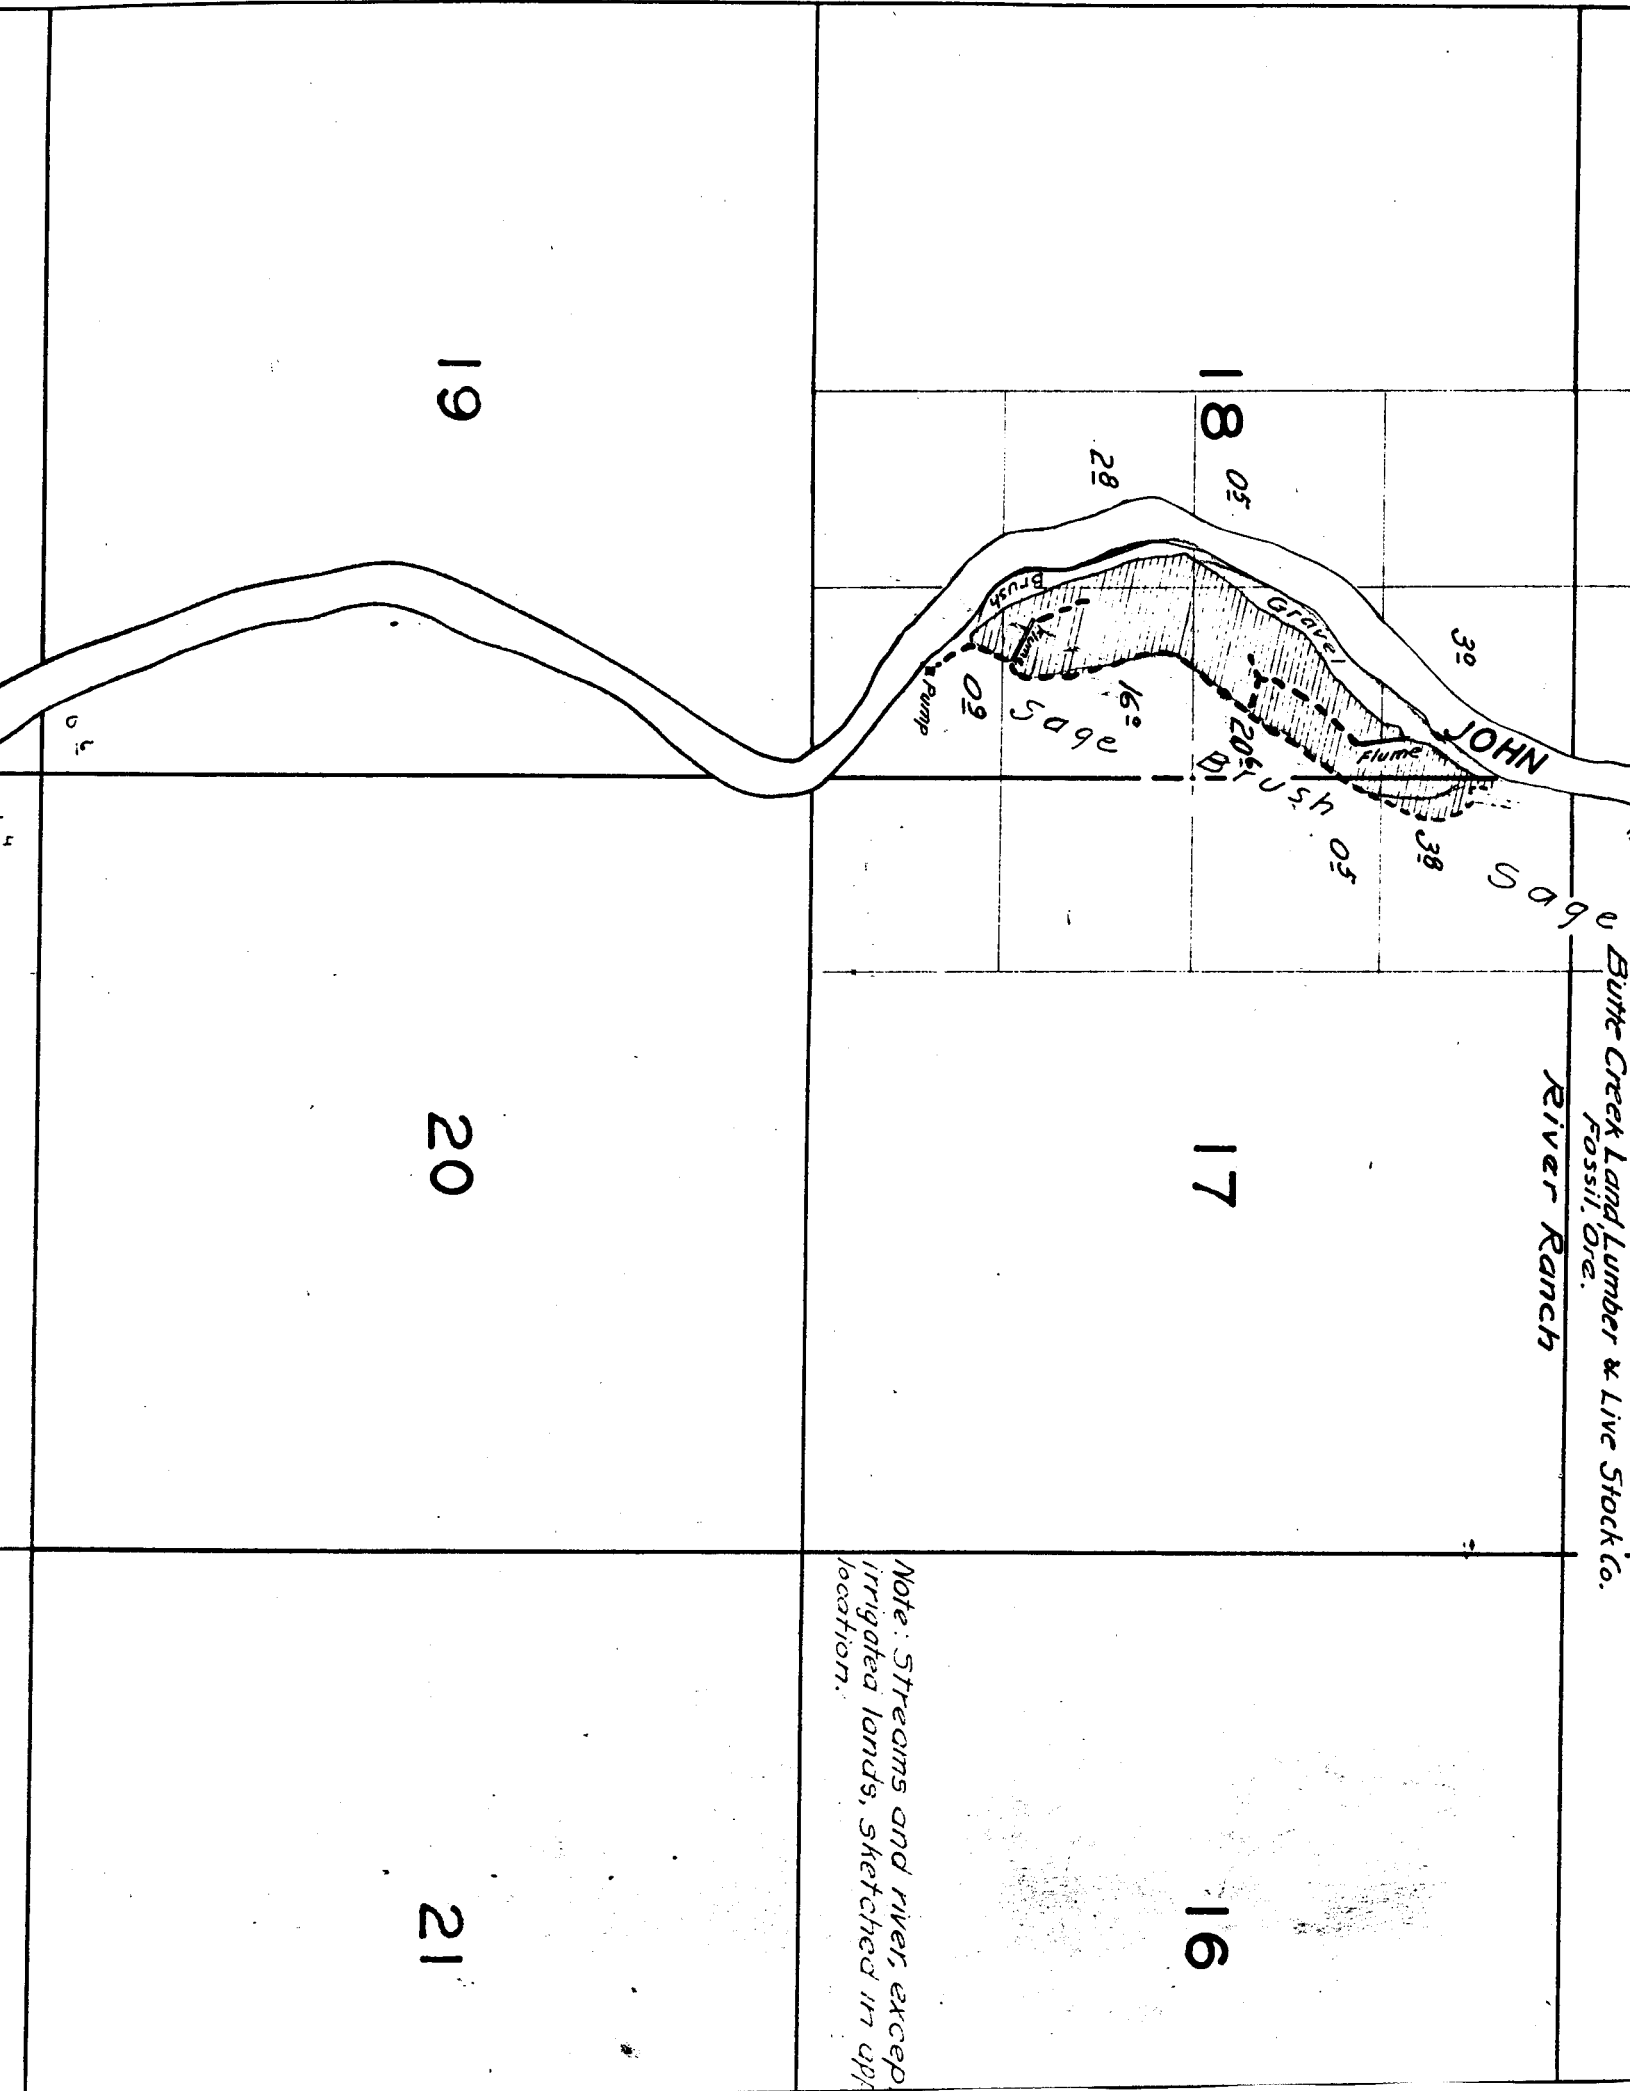

Note: Streams and river, except irrigated lands, sketched in app location.

TOWNSHIP

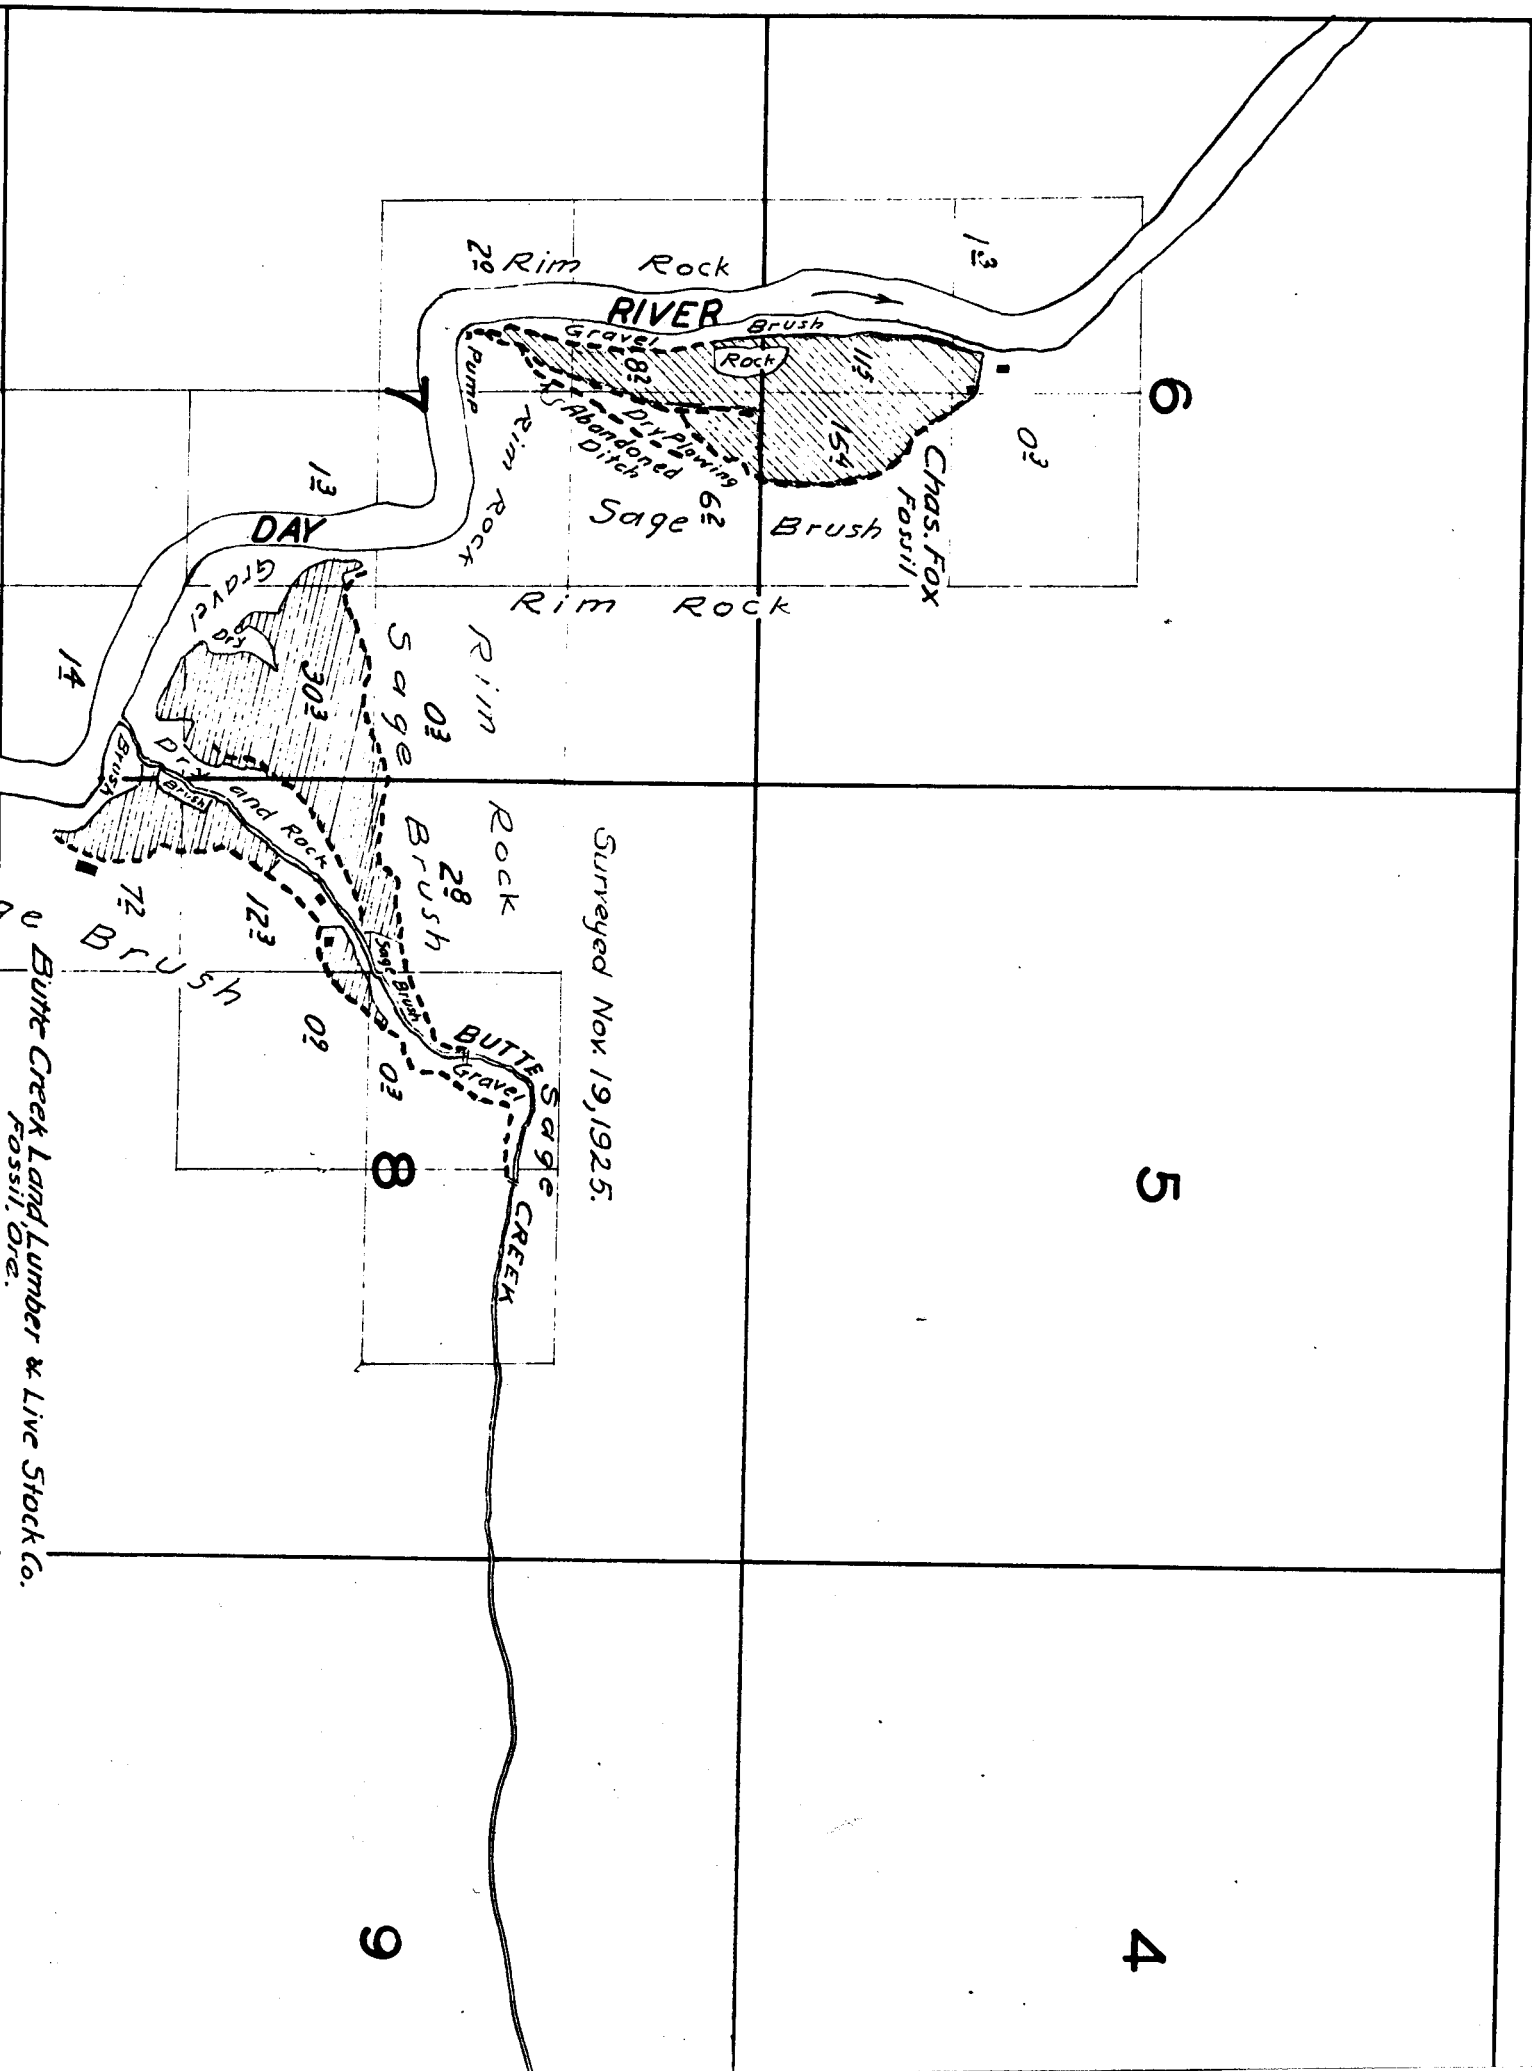

Surveyed Nov 19, 1925.

Butte Creek Land Lumber & Live Stock Co.
Fossil, Ore.

3


2

1

10

11


12

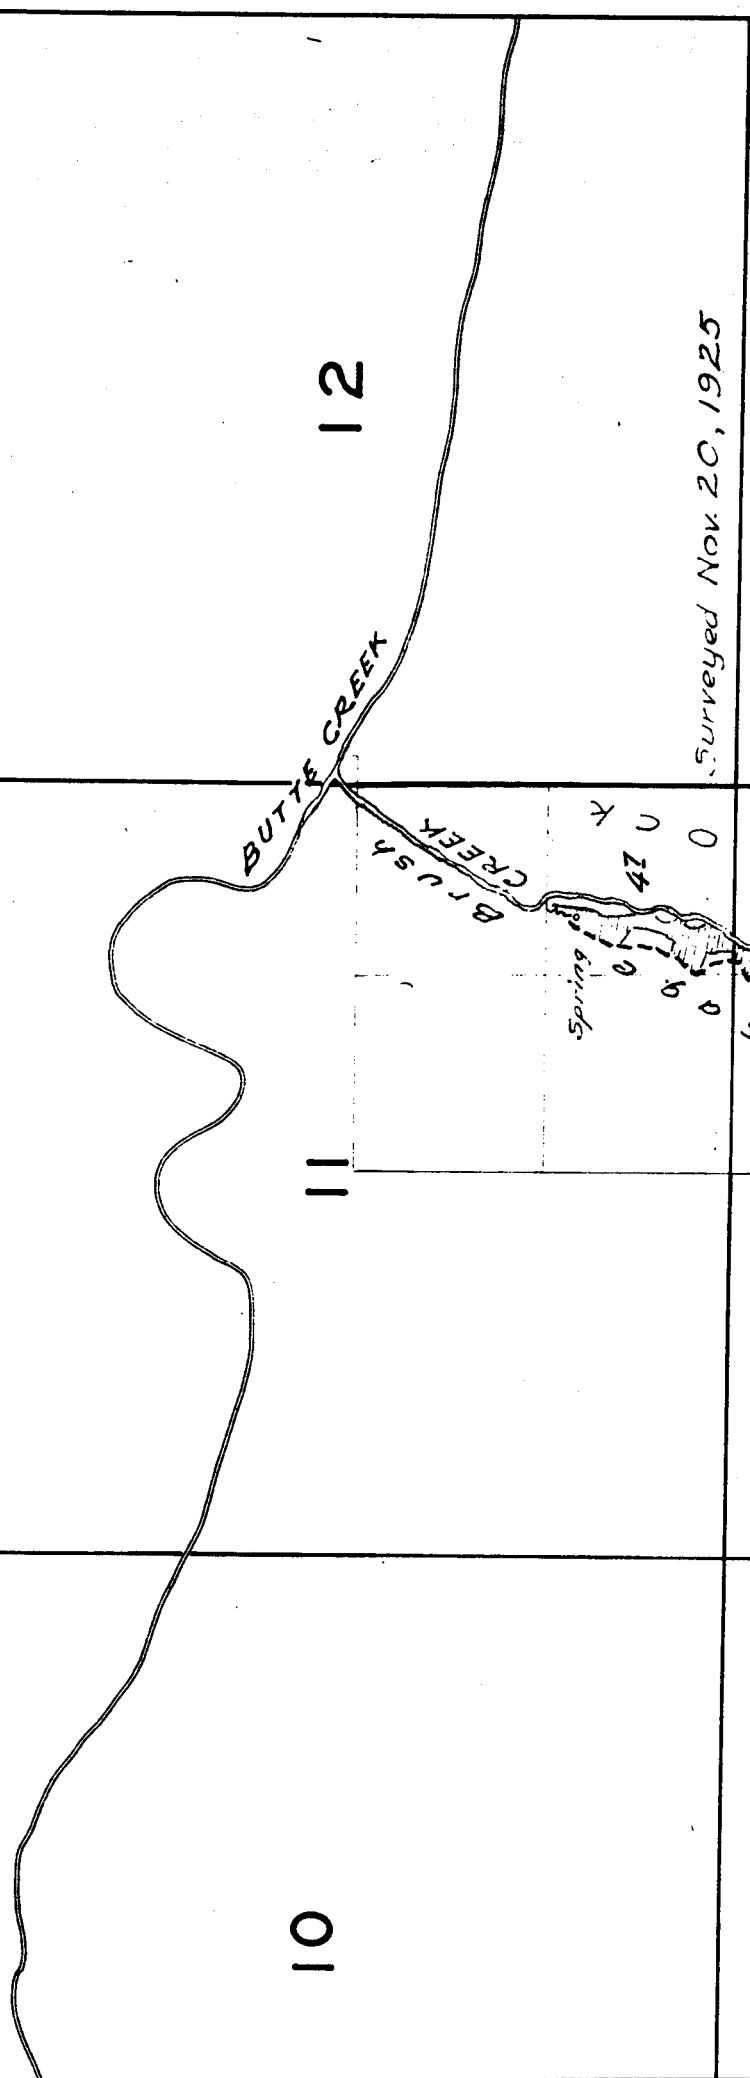

Surveyed Nov. 20, 1925

Surveyed Nov 20, 1925

0 0

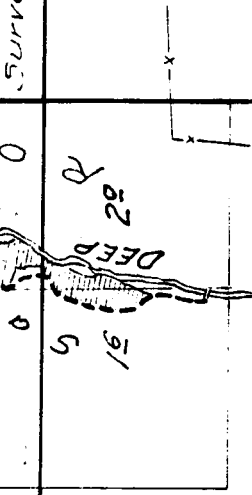

15

14

13

22

23

24