

Stock Co.

x

Surveyed Nov. 14 to 18, 1925.

16

24

18

Wm H. Higgins
(Ad. Cornett)

15

41

Arthur Penrecoast
05

Rock

Flume 1


50

Schec

21

22

NOTE: Streams sketched in approximate location except in the vicinity of irrigated land.

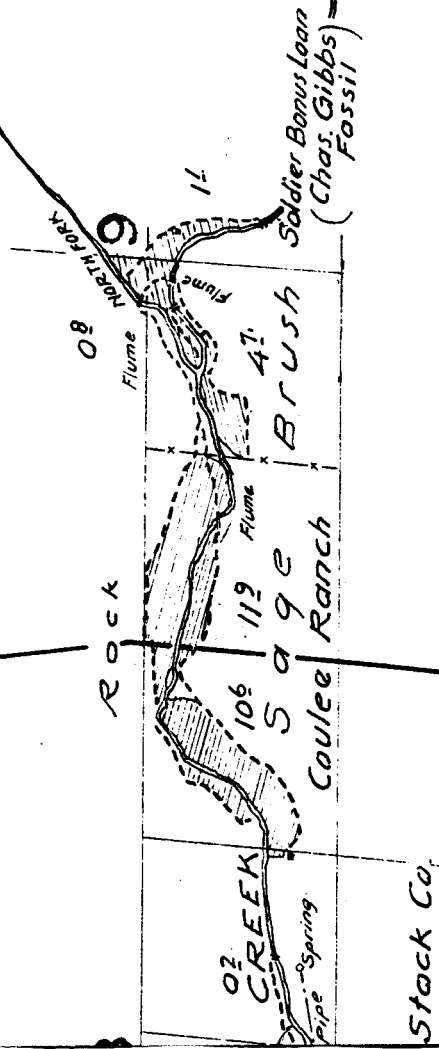

Surveyed Nov. 14 to 18, 1925.

16

21

17

20

CREEK

FORK


WEST

18

19

x

28	33
29	32
30	31

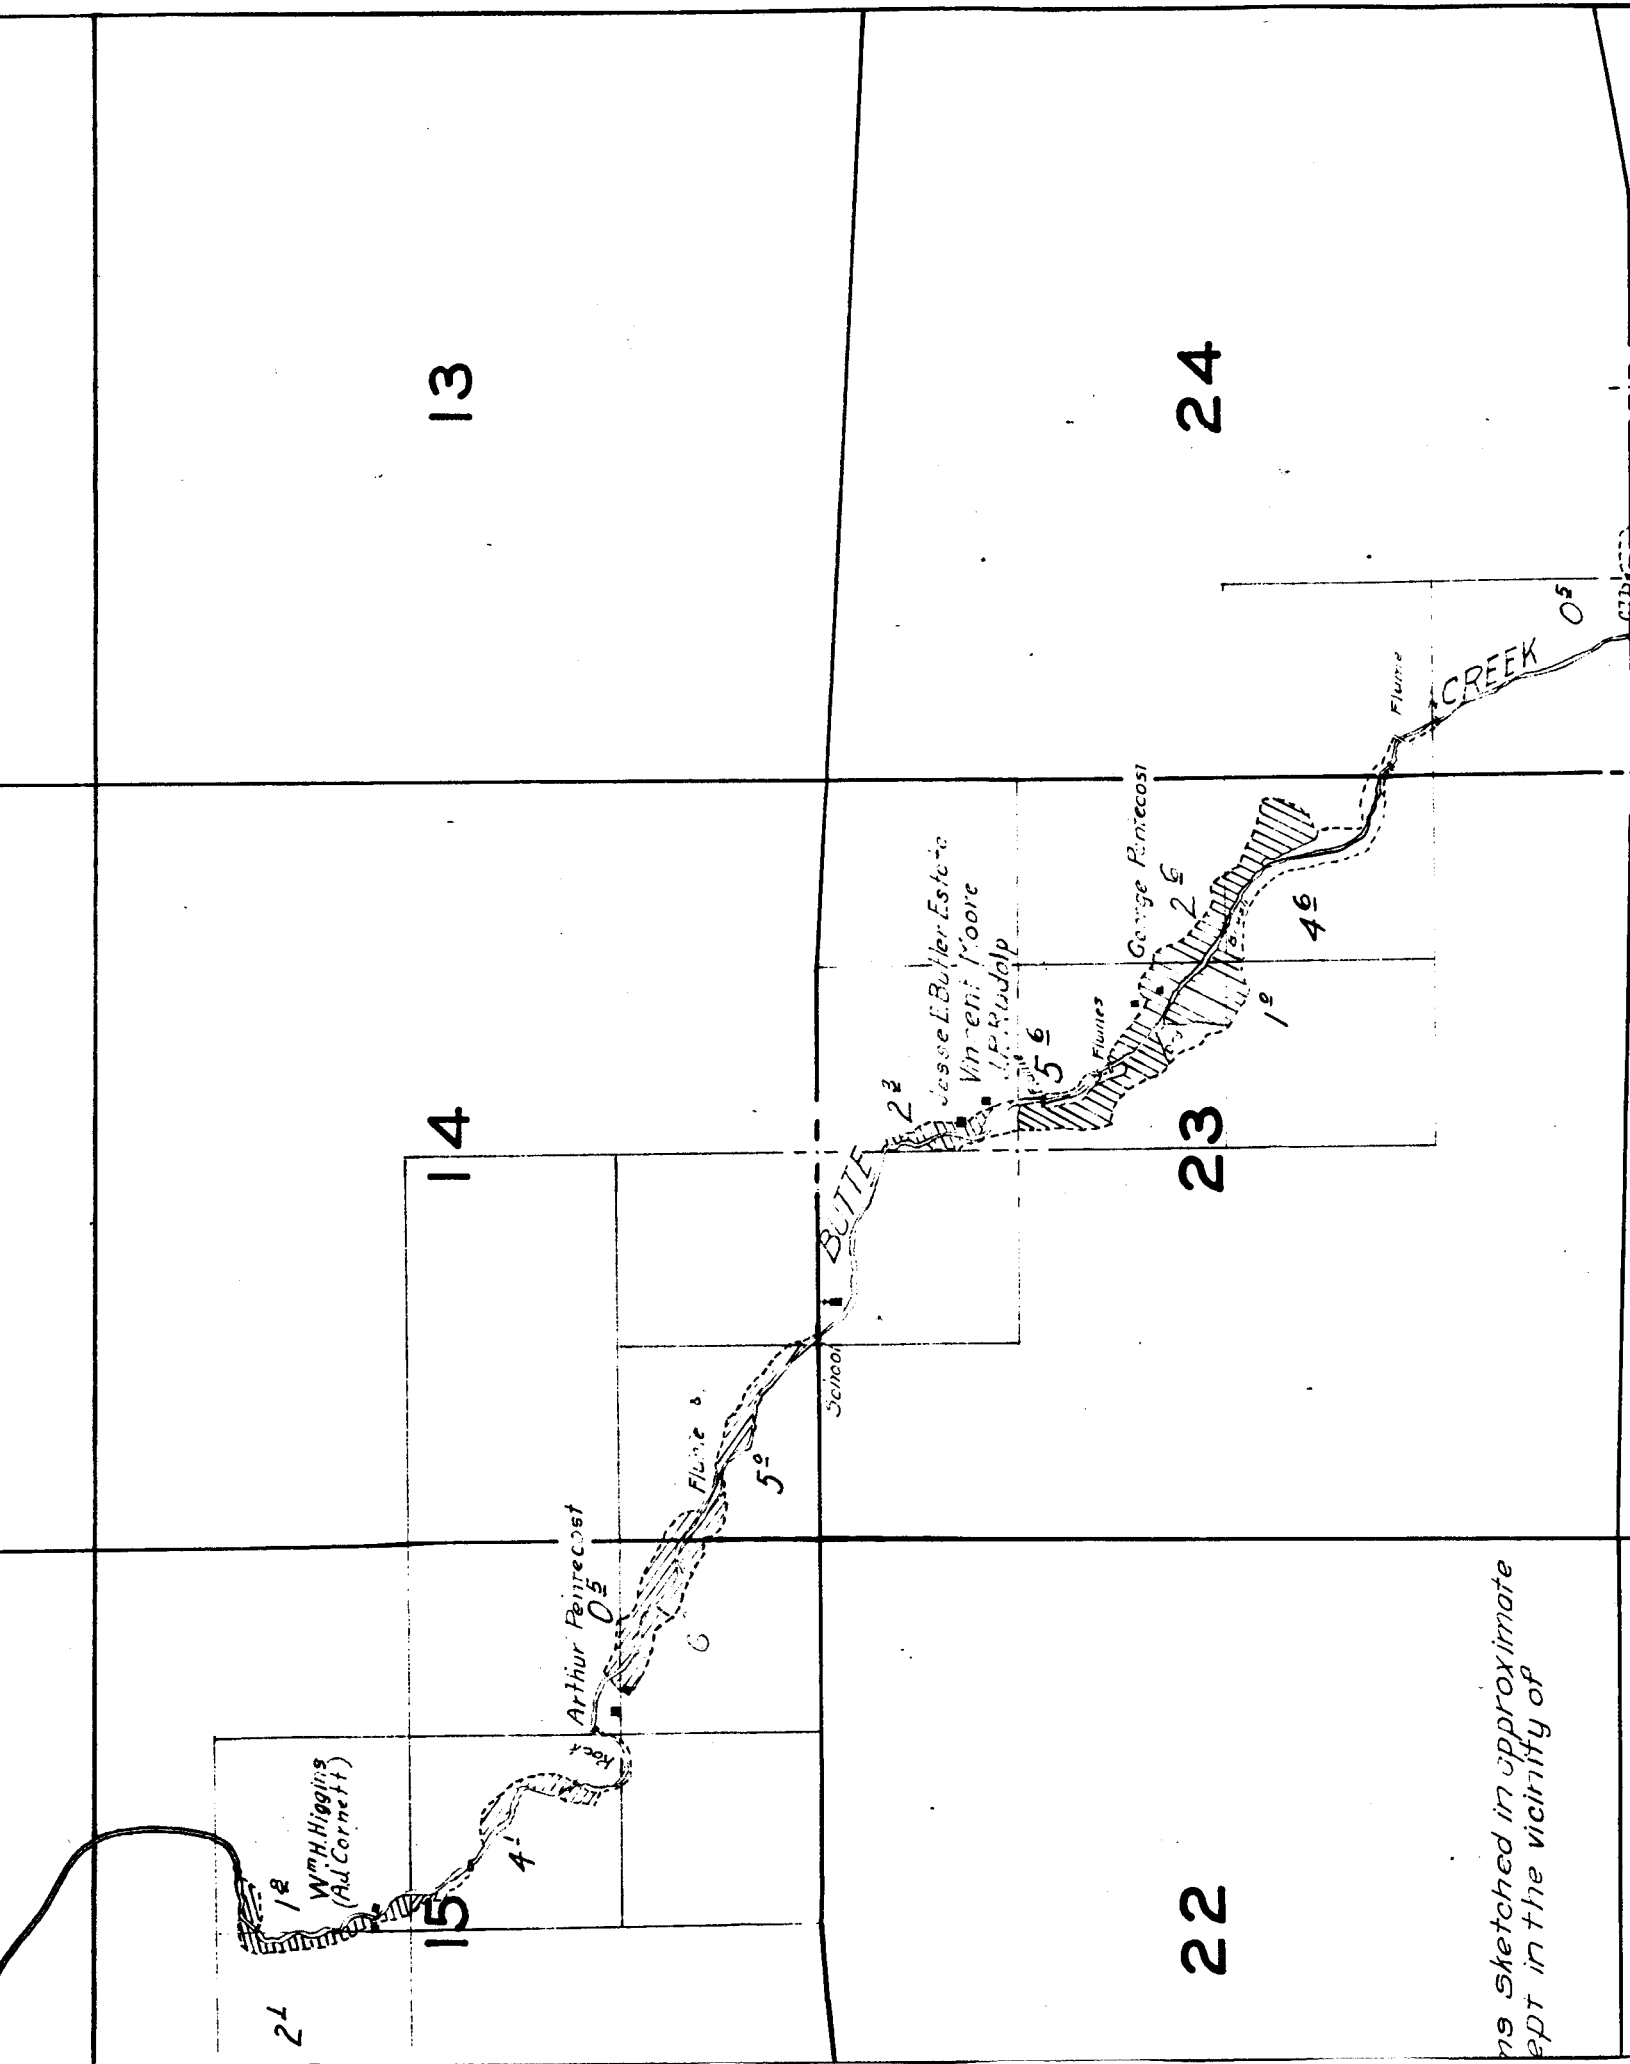

ms sketched in approximate
ept in the vicinity of

27

26

25

34

35

36

Steiner & Carpenter Bank

12

Sage
Pine
Spring

Blunt Stamp Creek

32

10

Mrs. Margaret E. Burnera
Cit Brown

23

35

21

22

NOTE: Streams sketched in approximate location except in the vicinity of irrigated land.

28



27



33

34

2

1

11

12

14


13

6

5

7

8

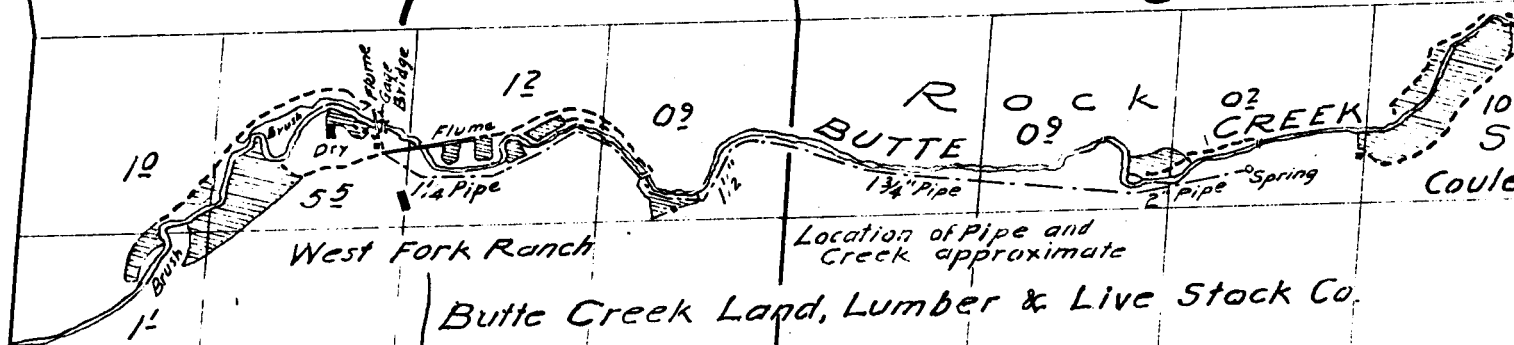

18

17