


Surveyed Nov. 20, 1925

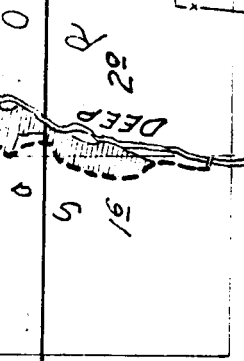

15

14

13

22

23

24

[illegible]

2

3

12

CREEK

Surveyed Nov. 20, 1925









5

River Ranch

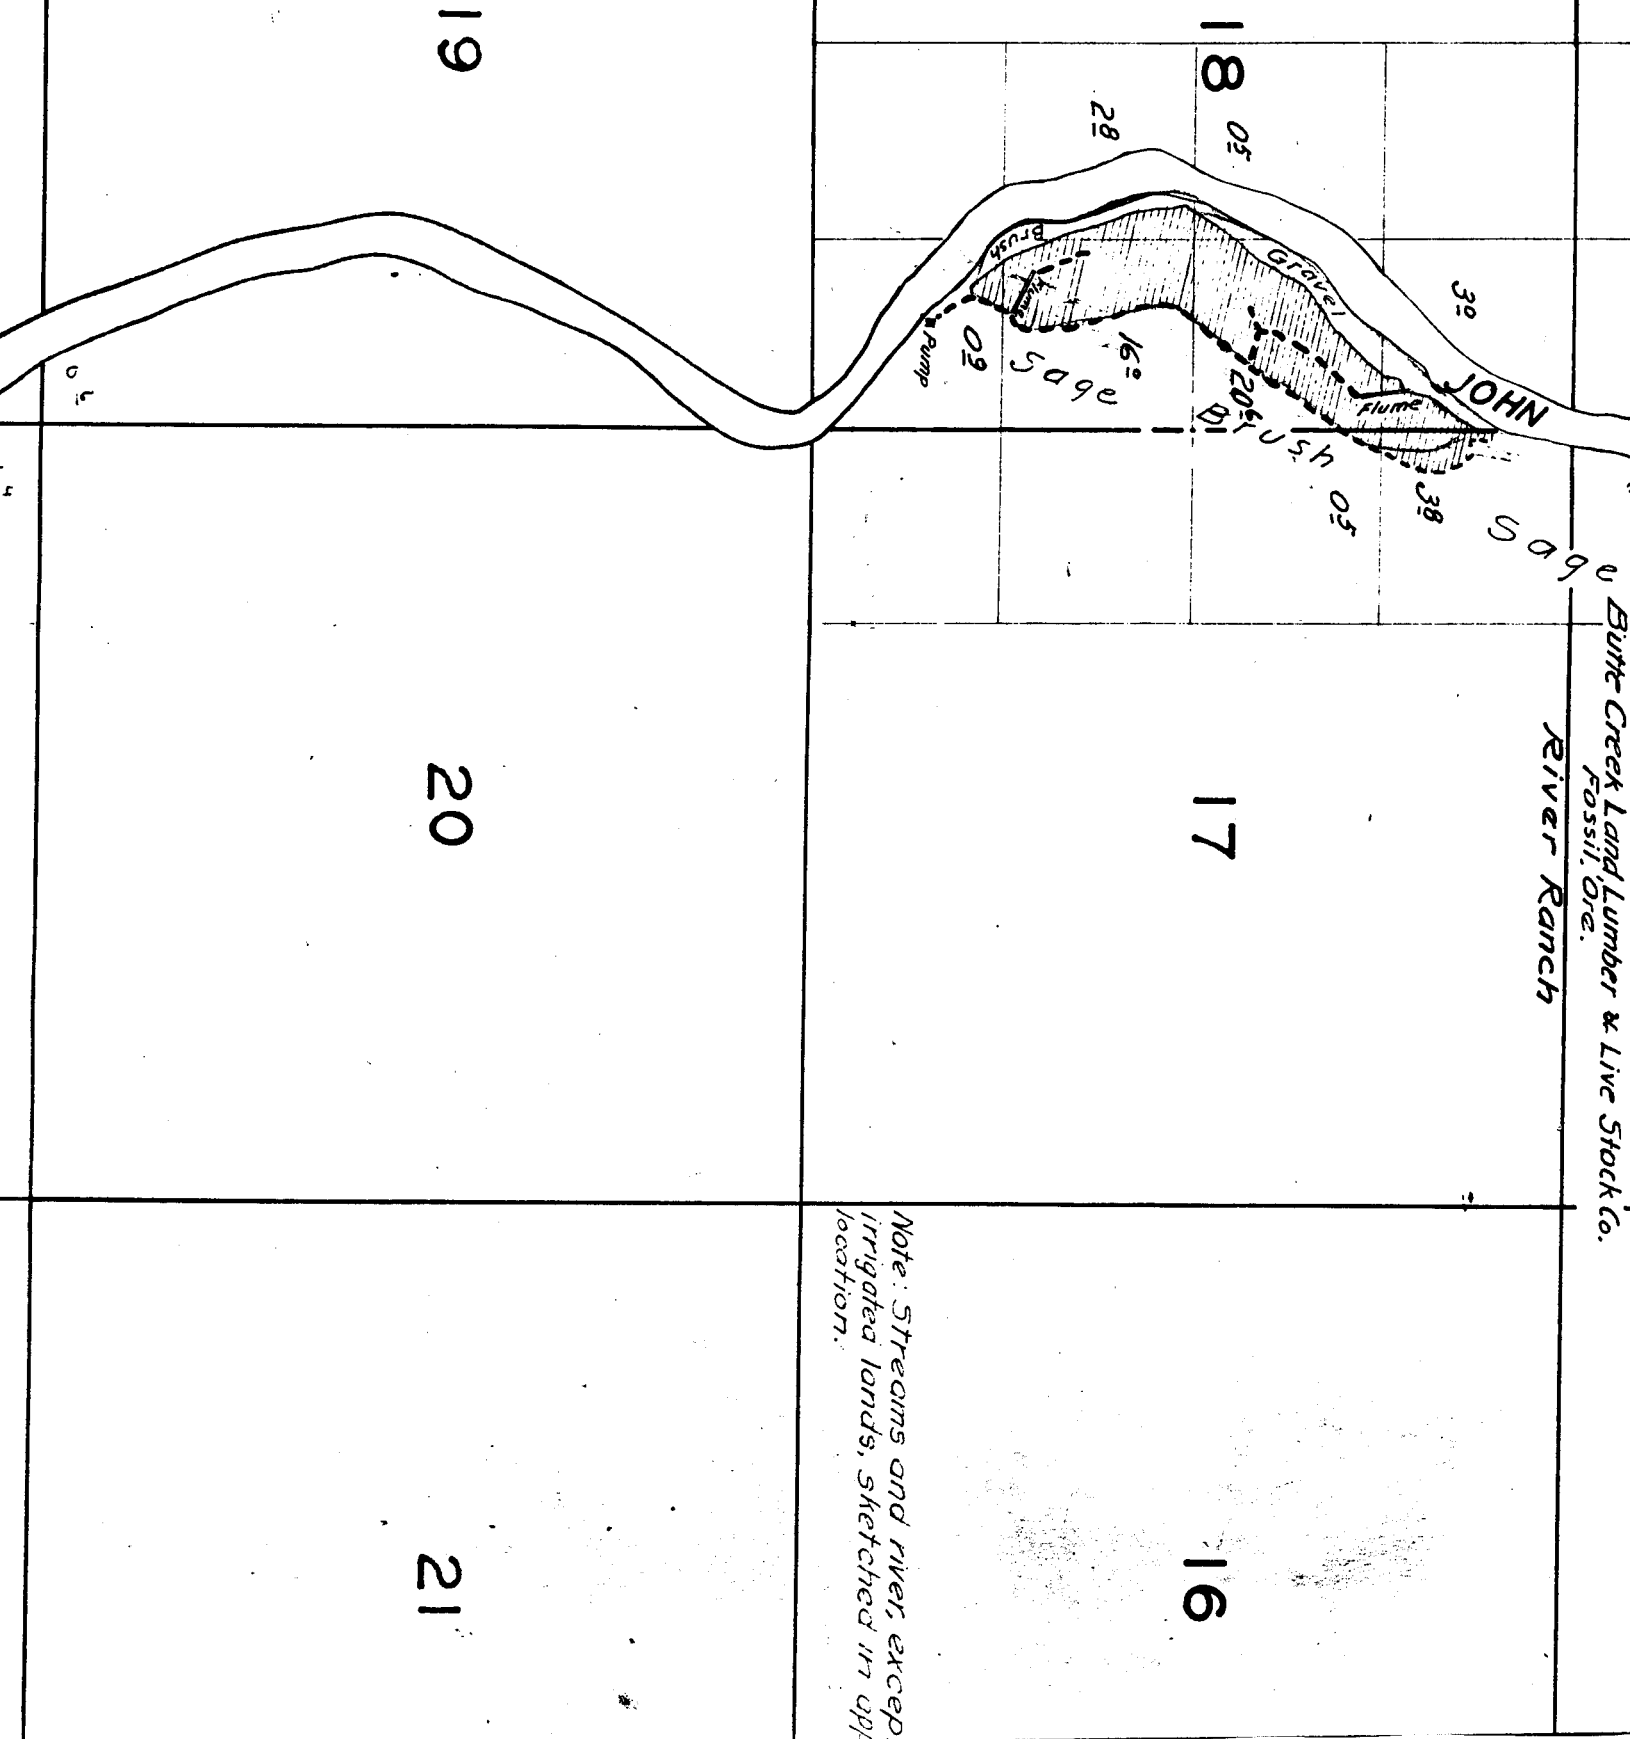

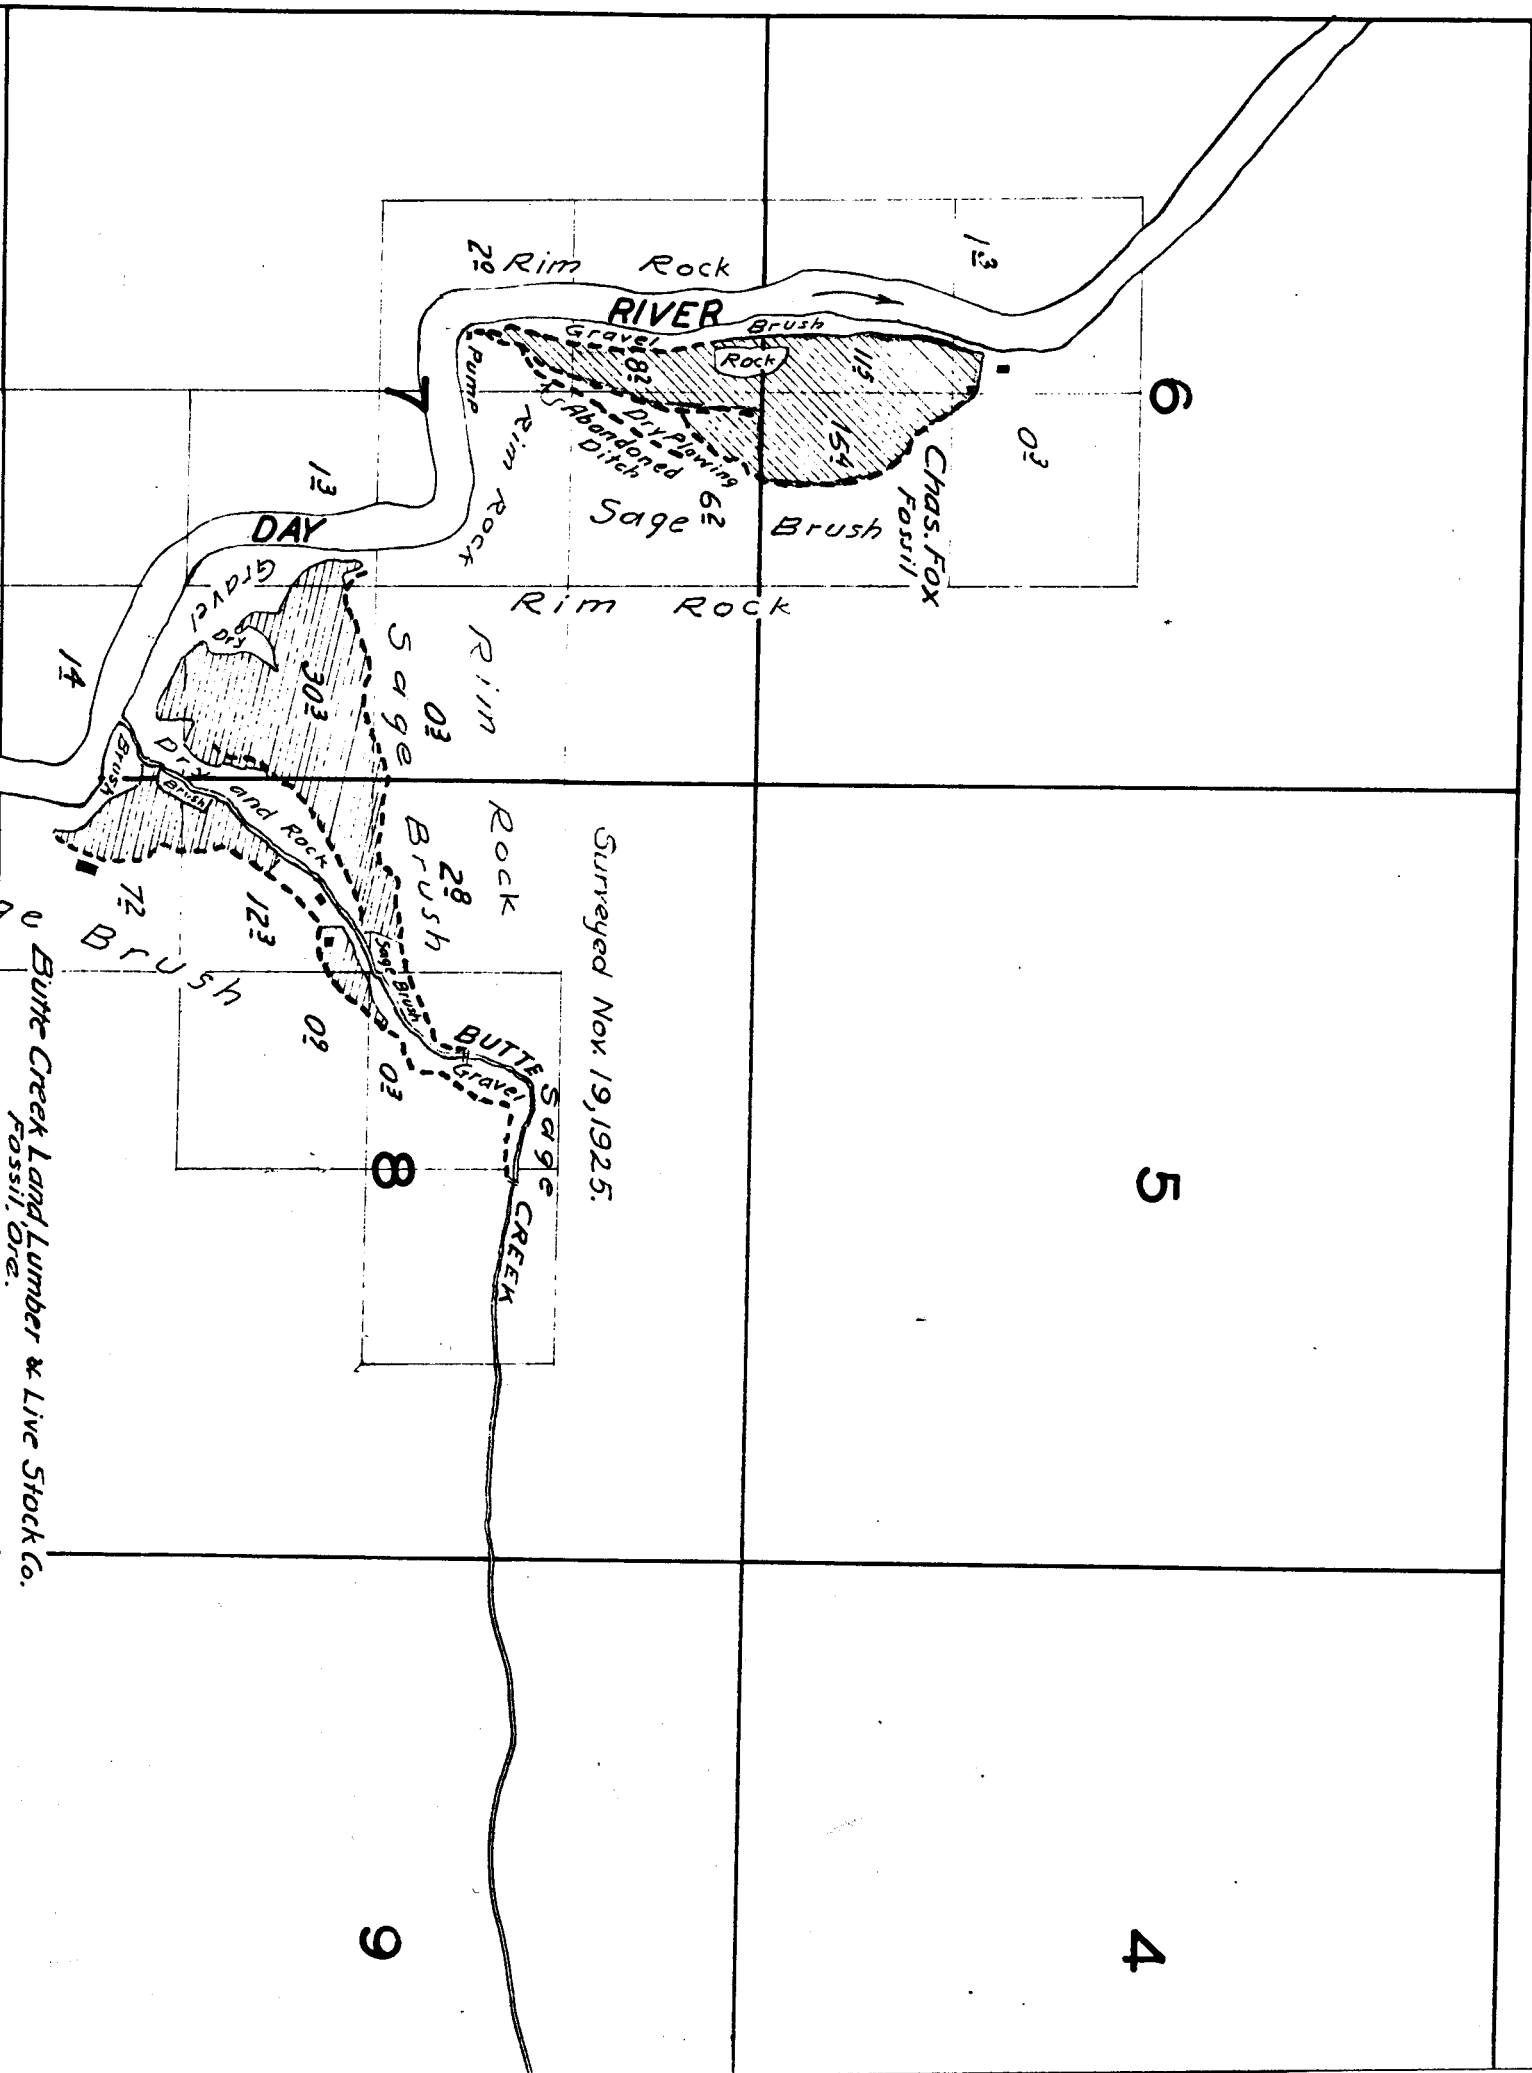

Surveyed Nov 19, 1925.

Butte Creek Land Lumber & Live Stock Co.
Fossil, Ore.

TOWNSHIP 6 S., RANGE 19 E.

4

3

9

10

16

15

k Co.

23

24

26

25

35

36

19

20

30


29

Sub-irrigation
Farm Land

Surveyed Aug. 25, 1926.

E.A. Mauer
31

Frank Knox 32

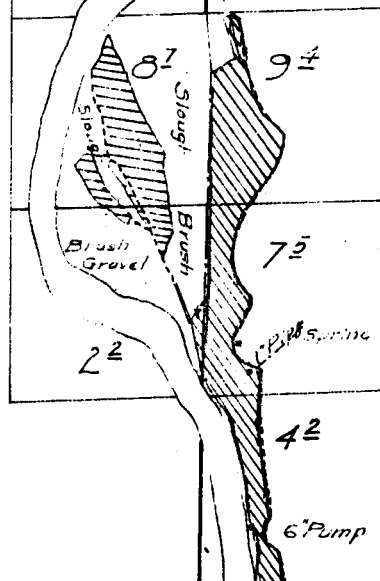

16

Note: Streams and river, except in vicinity of irrigated lands, sketched in approximate location.

15

21

22

27

29

34

33

25,1926.