

6

5

Surveyed Oct. 26, 22, 23, 1925.

7

8

Ross Thomas

JOHN DAY

CREEK

8²

5°

John Tilley

Keys Donnley

18

17

Lot 1

Lot 2

Lot 3

Lot 4

Lot 1

Lot 2

Lot 3

S.J. Howard

Lot 4

M.J. Campbell

SERVICE CREEK POST OFFICE

John Tilley

8" Pipe

4⁶

4³

1 1/2" Pipe

John Day Highway SERVICE

0⁵

0²

0⁶

1³

1²

0⁶

5³

0³

3²

6⁵

1²


4³

3⁶

2⁹

2

1

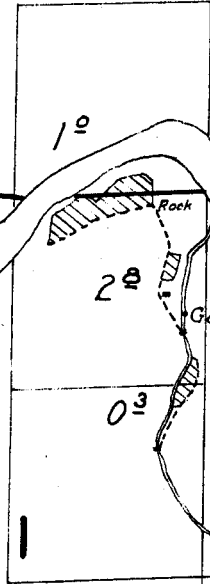

1

J.E. Butler
Gage

2

3

L.H. Wright

urveyed Nov. 7 1925.

12

14

13

HORSESHOE
CREEK

21

22


28

27

33

34

TOWNSHIP 9 S., RANGE 23 E.

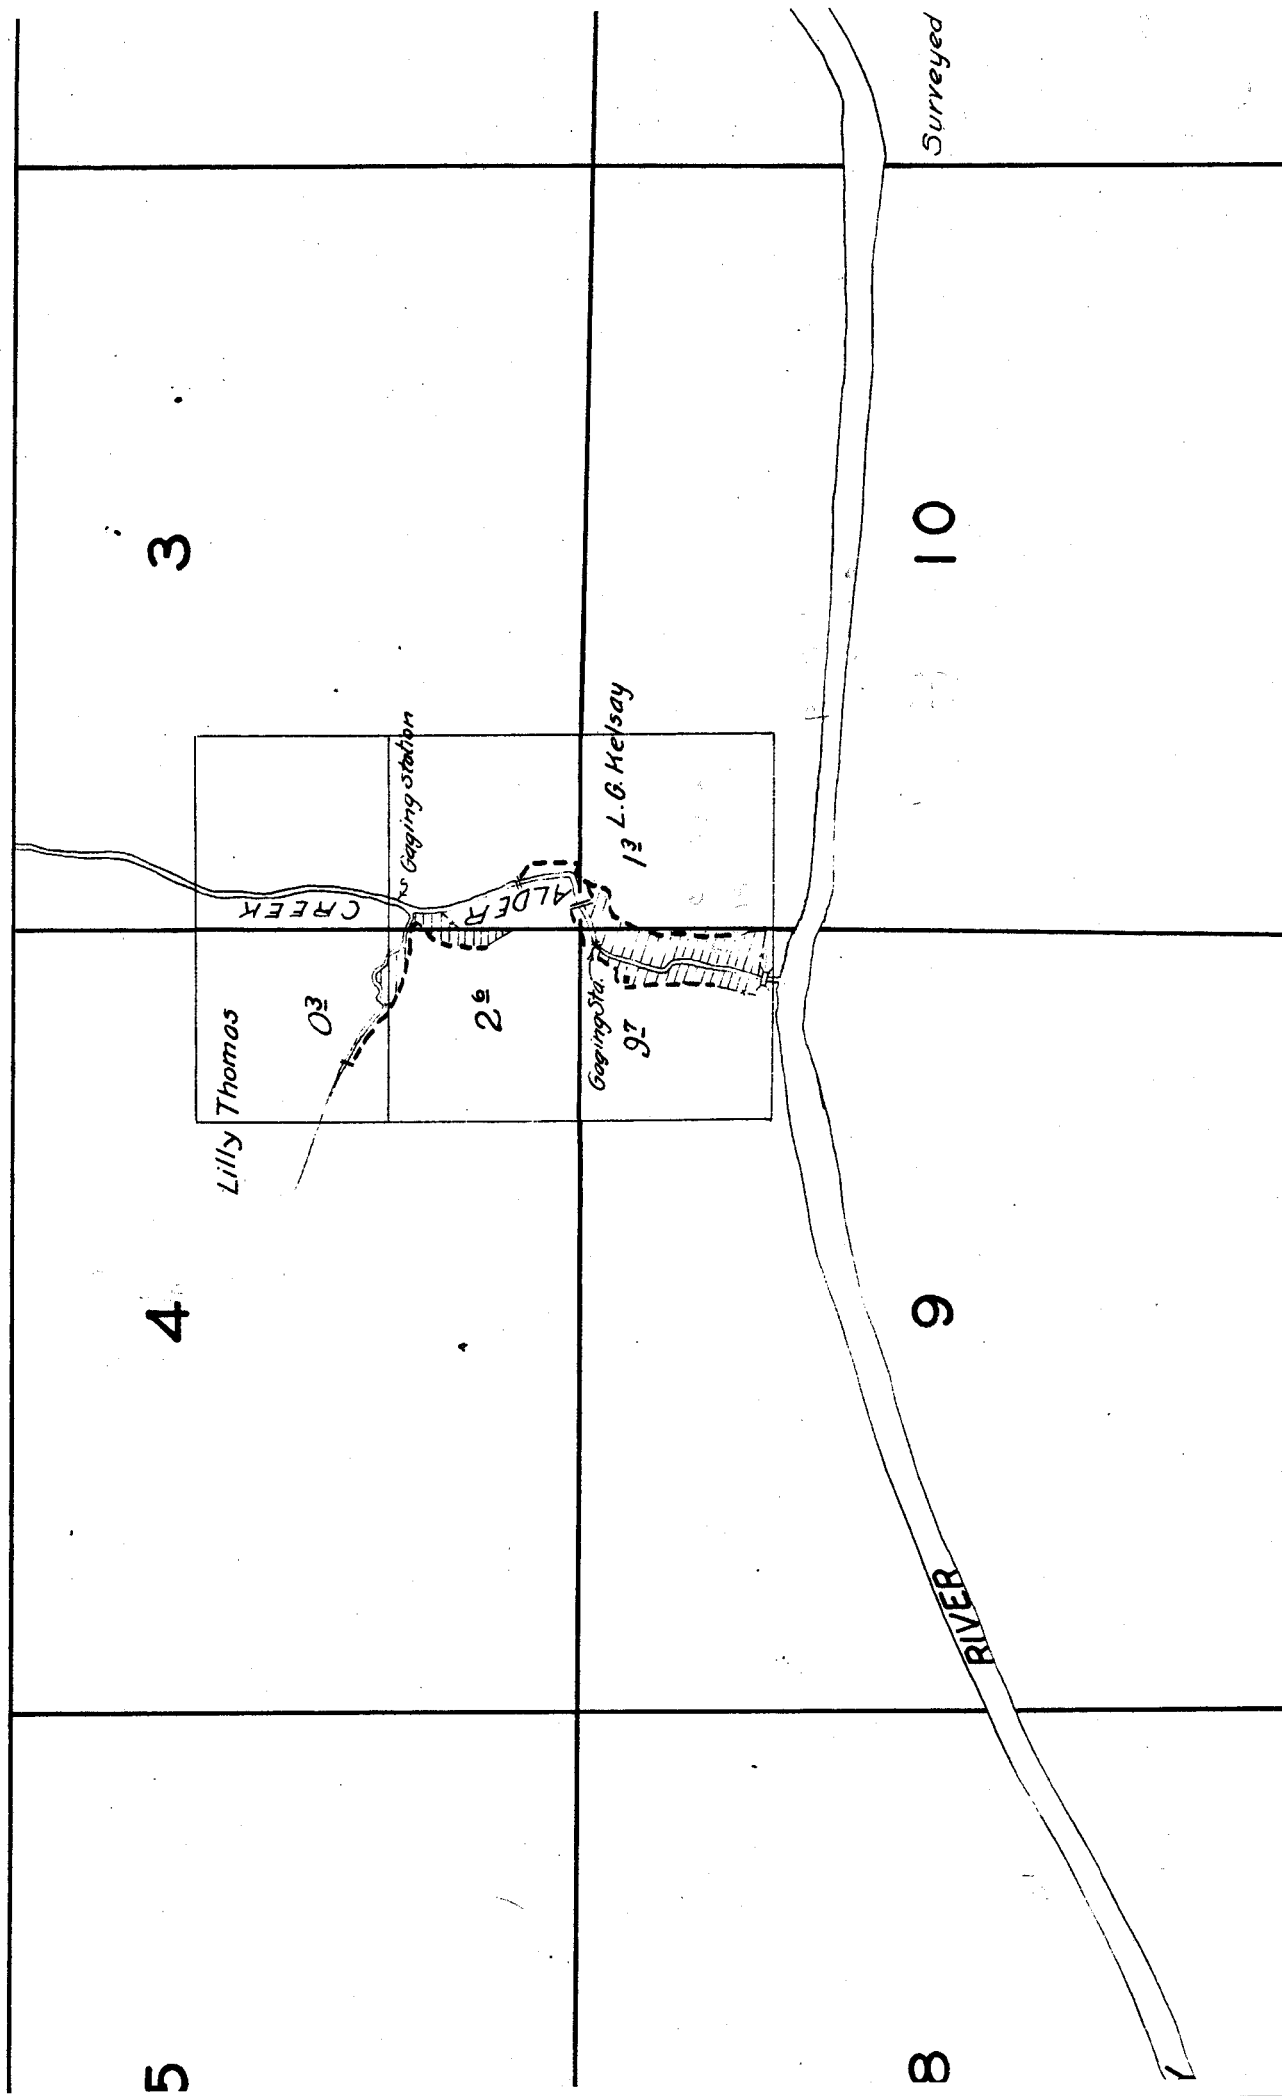

7

16

15

NOTE: Streams and river except in the vicinity of irrigated land, sketch in approximate location.

135

21

22




2


33

29

32

30

31

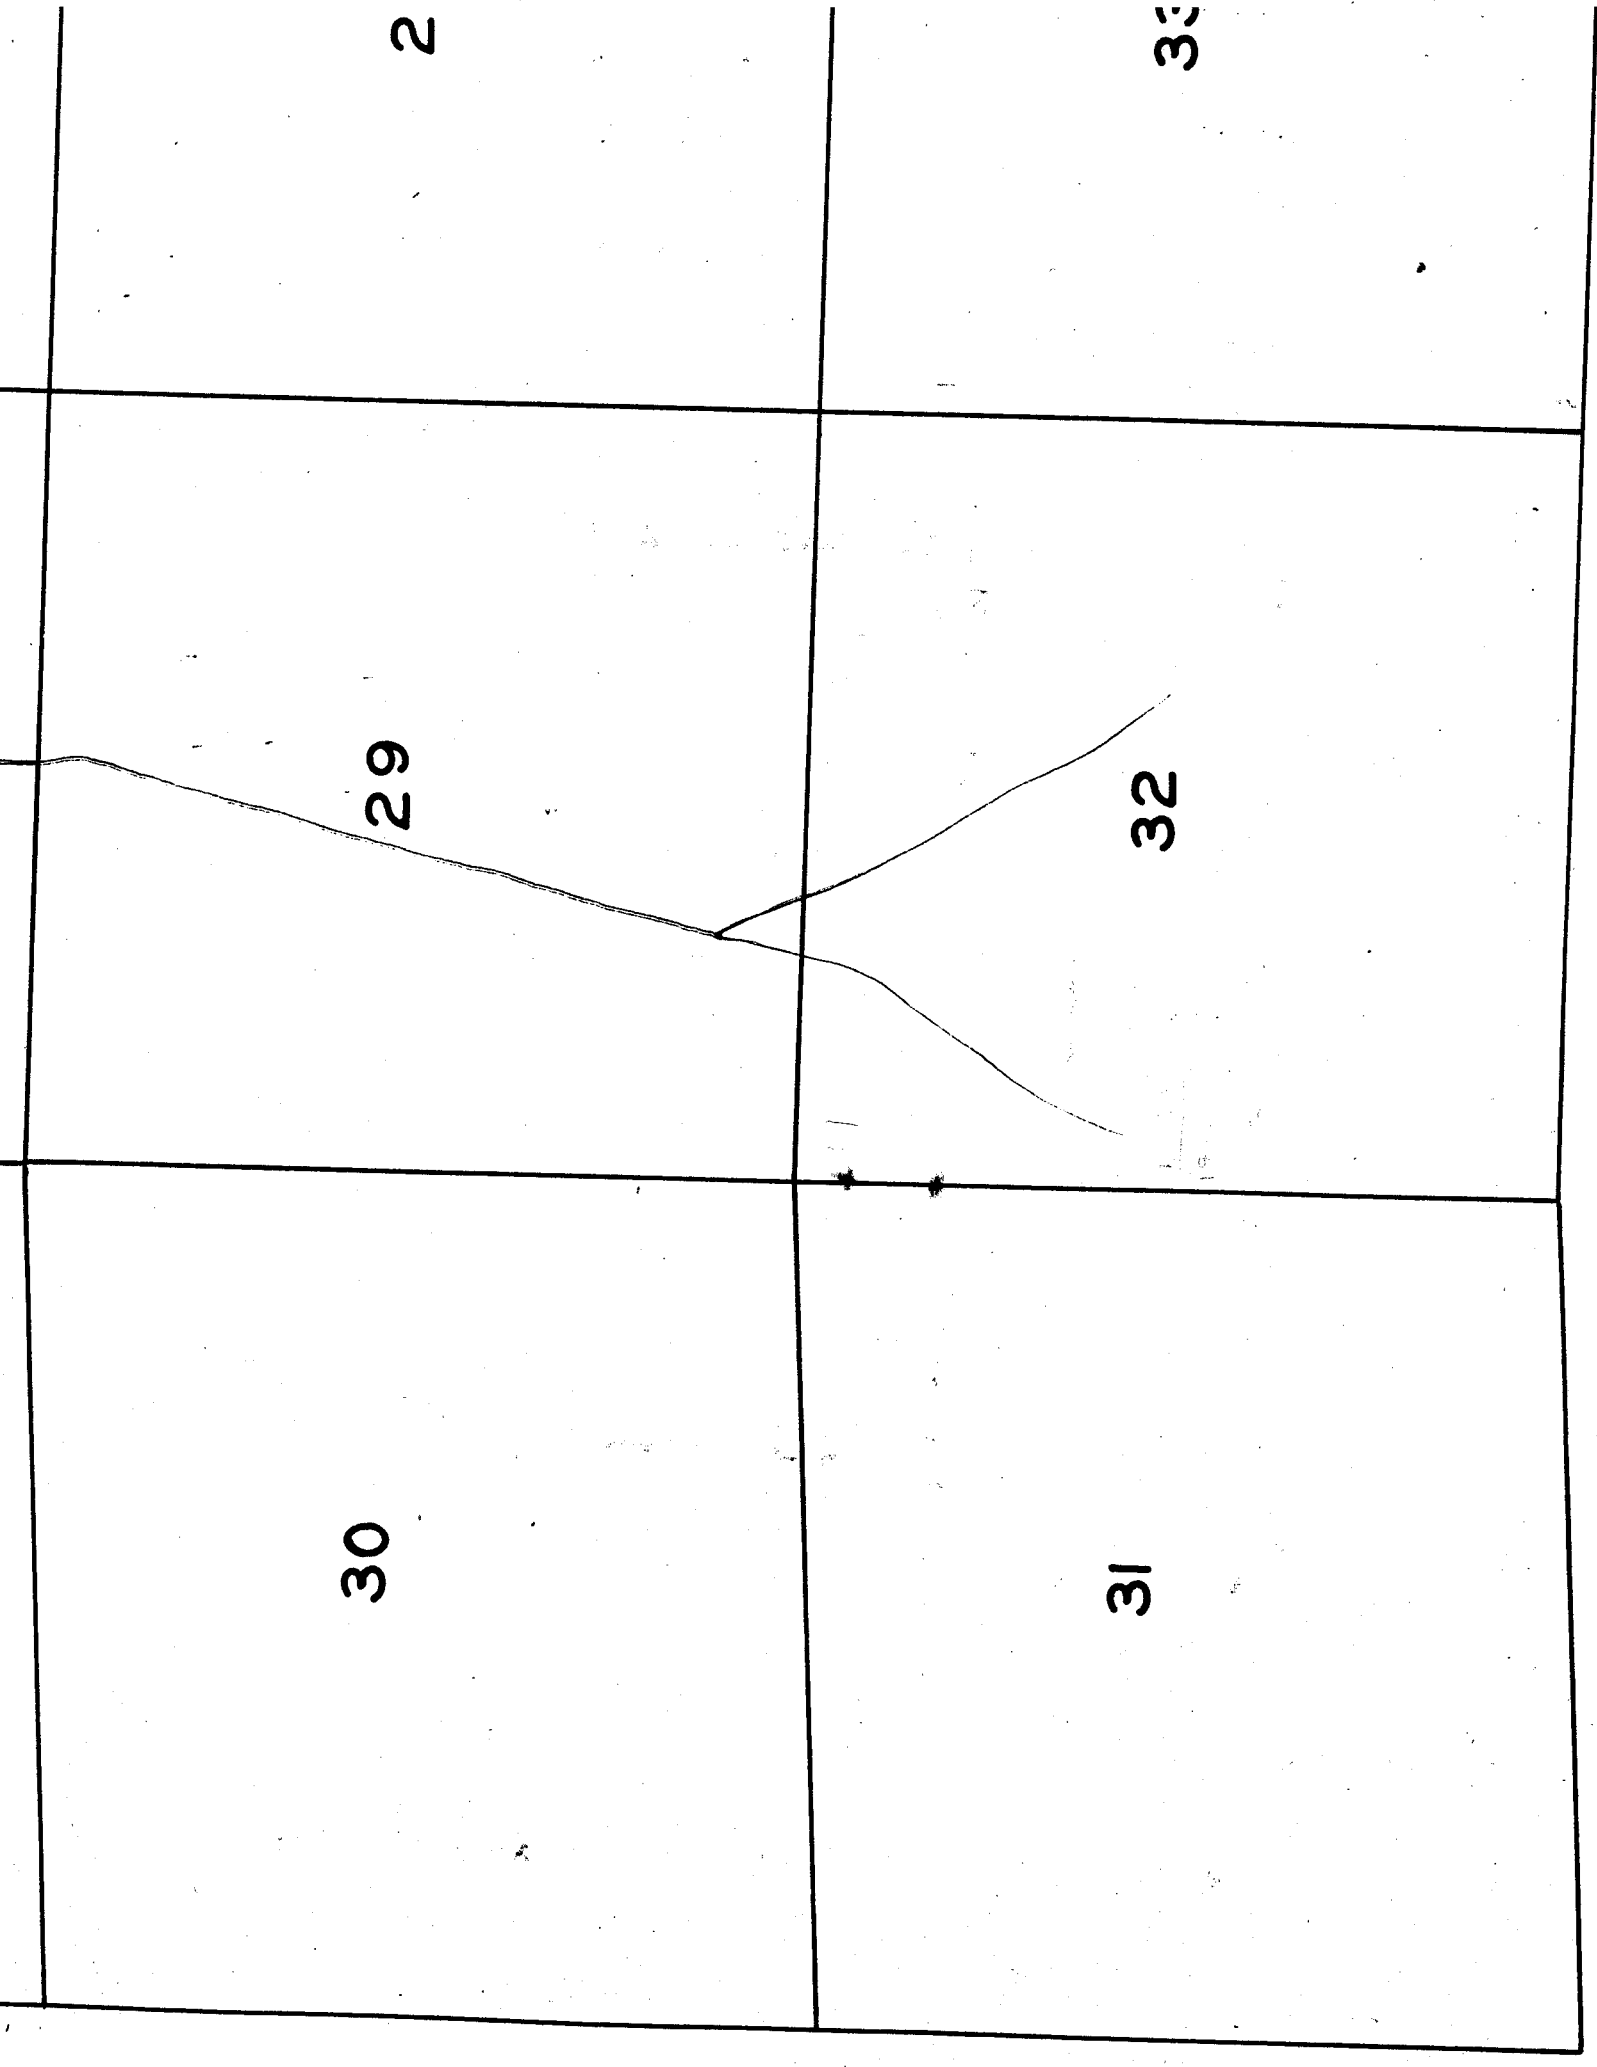

HORSESHOE CREEK

13

24

14

23

15

22

32

62

Surveyed - Oct 30, 1925.

