

2

1

11

12

14

13

6

7

18

Lot 3.

Lot 2.

Lot 1.

0°

JOHNSON CREEK

Dale Stevens

5

15

6°

36°

1°

20°

Dam

J.B. and Roy Huddles

LONEROCK CREEK

8

Spring

Lot 4.

1°

Lot 1.
2°

Dam

17

21

22


28


27

*Streams, except in the vicinity of
irrigated land are sketched in the
approximate location.*

33

34

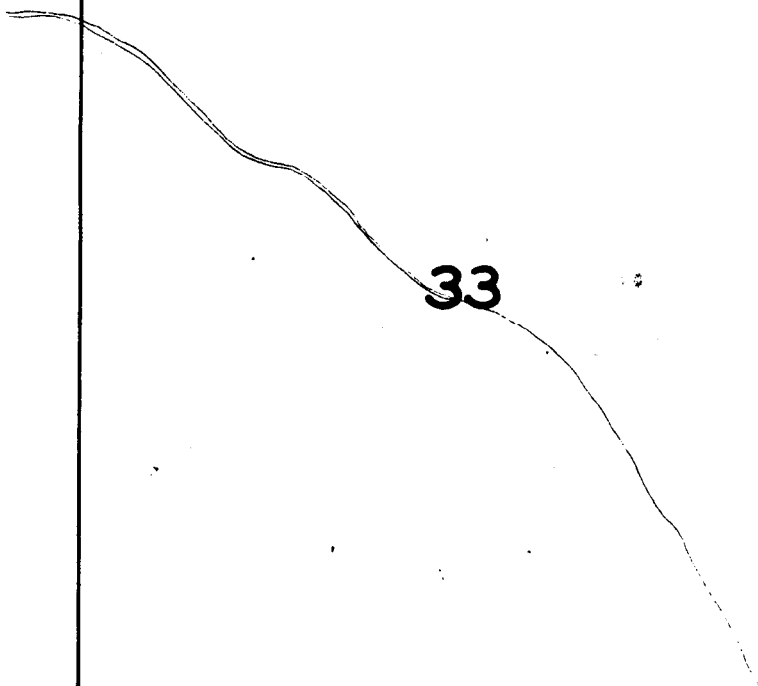

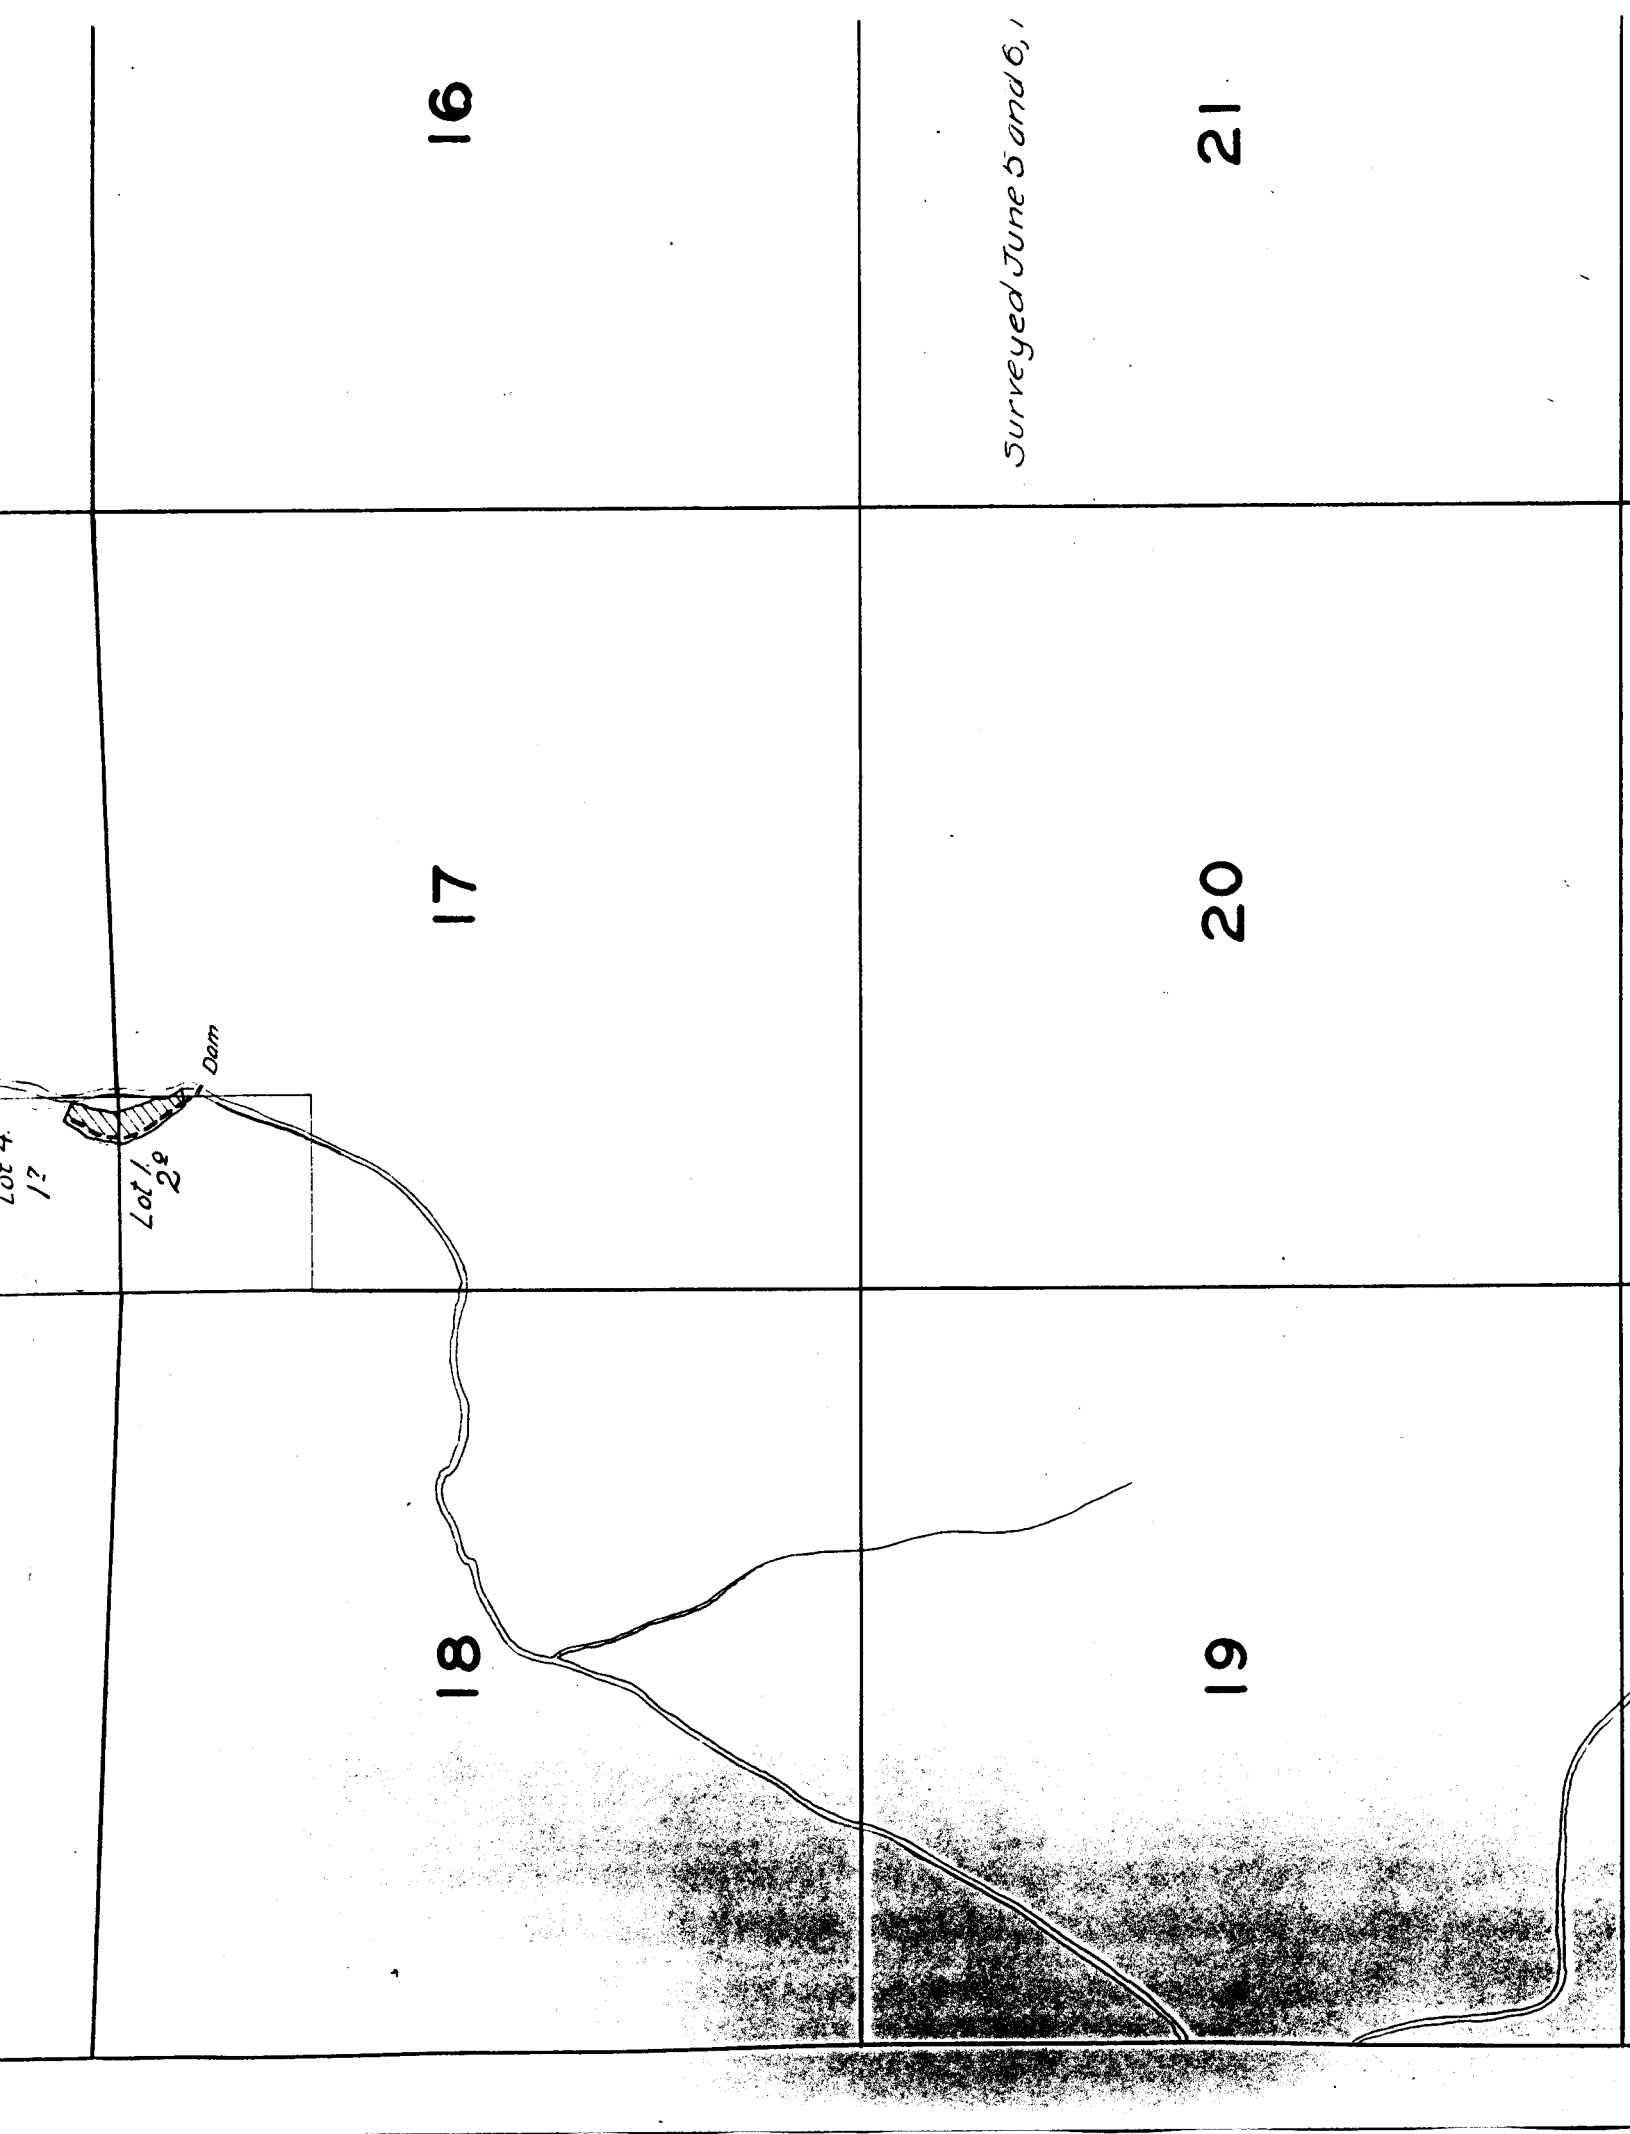

16

Surveyed June 5 and 6, 1

21

17

20

18

19

28


33

29


32

30

31

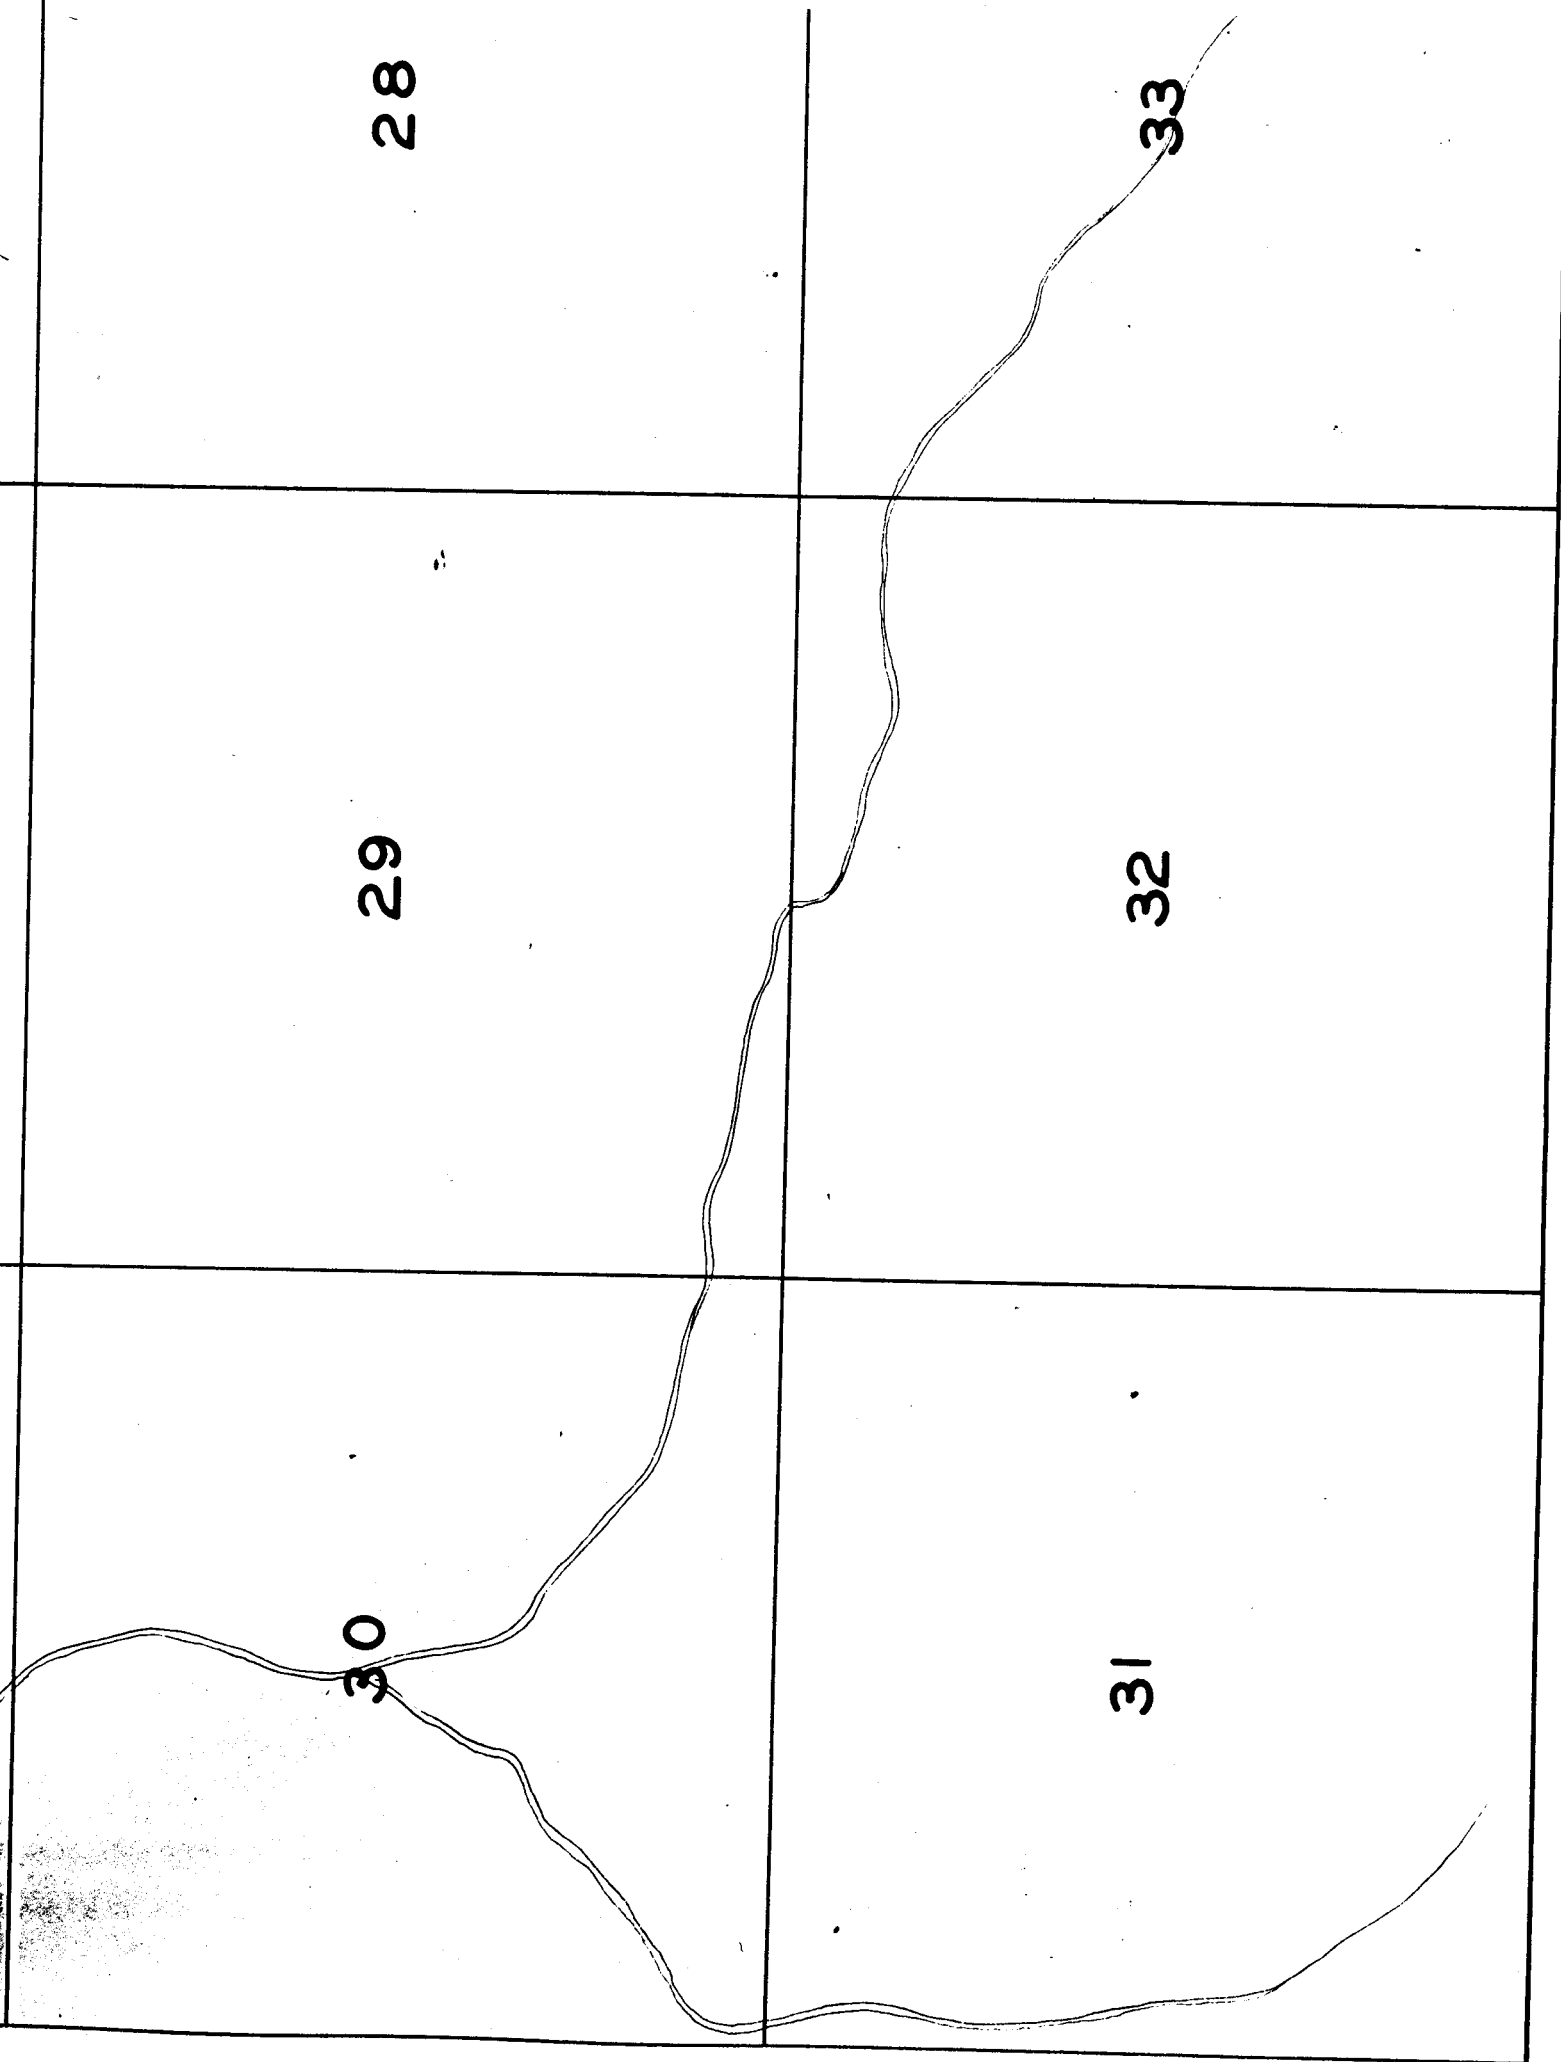

TOWNSHIP 6 S., RANGE 24 E.

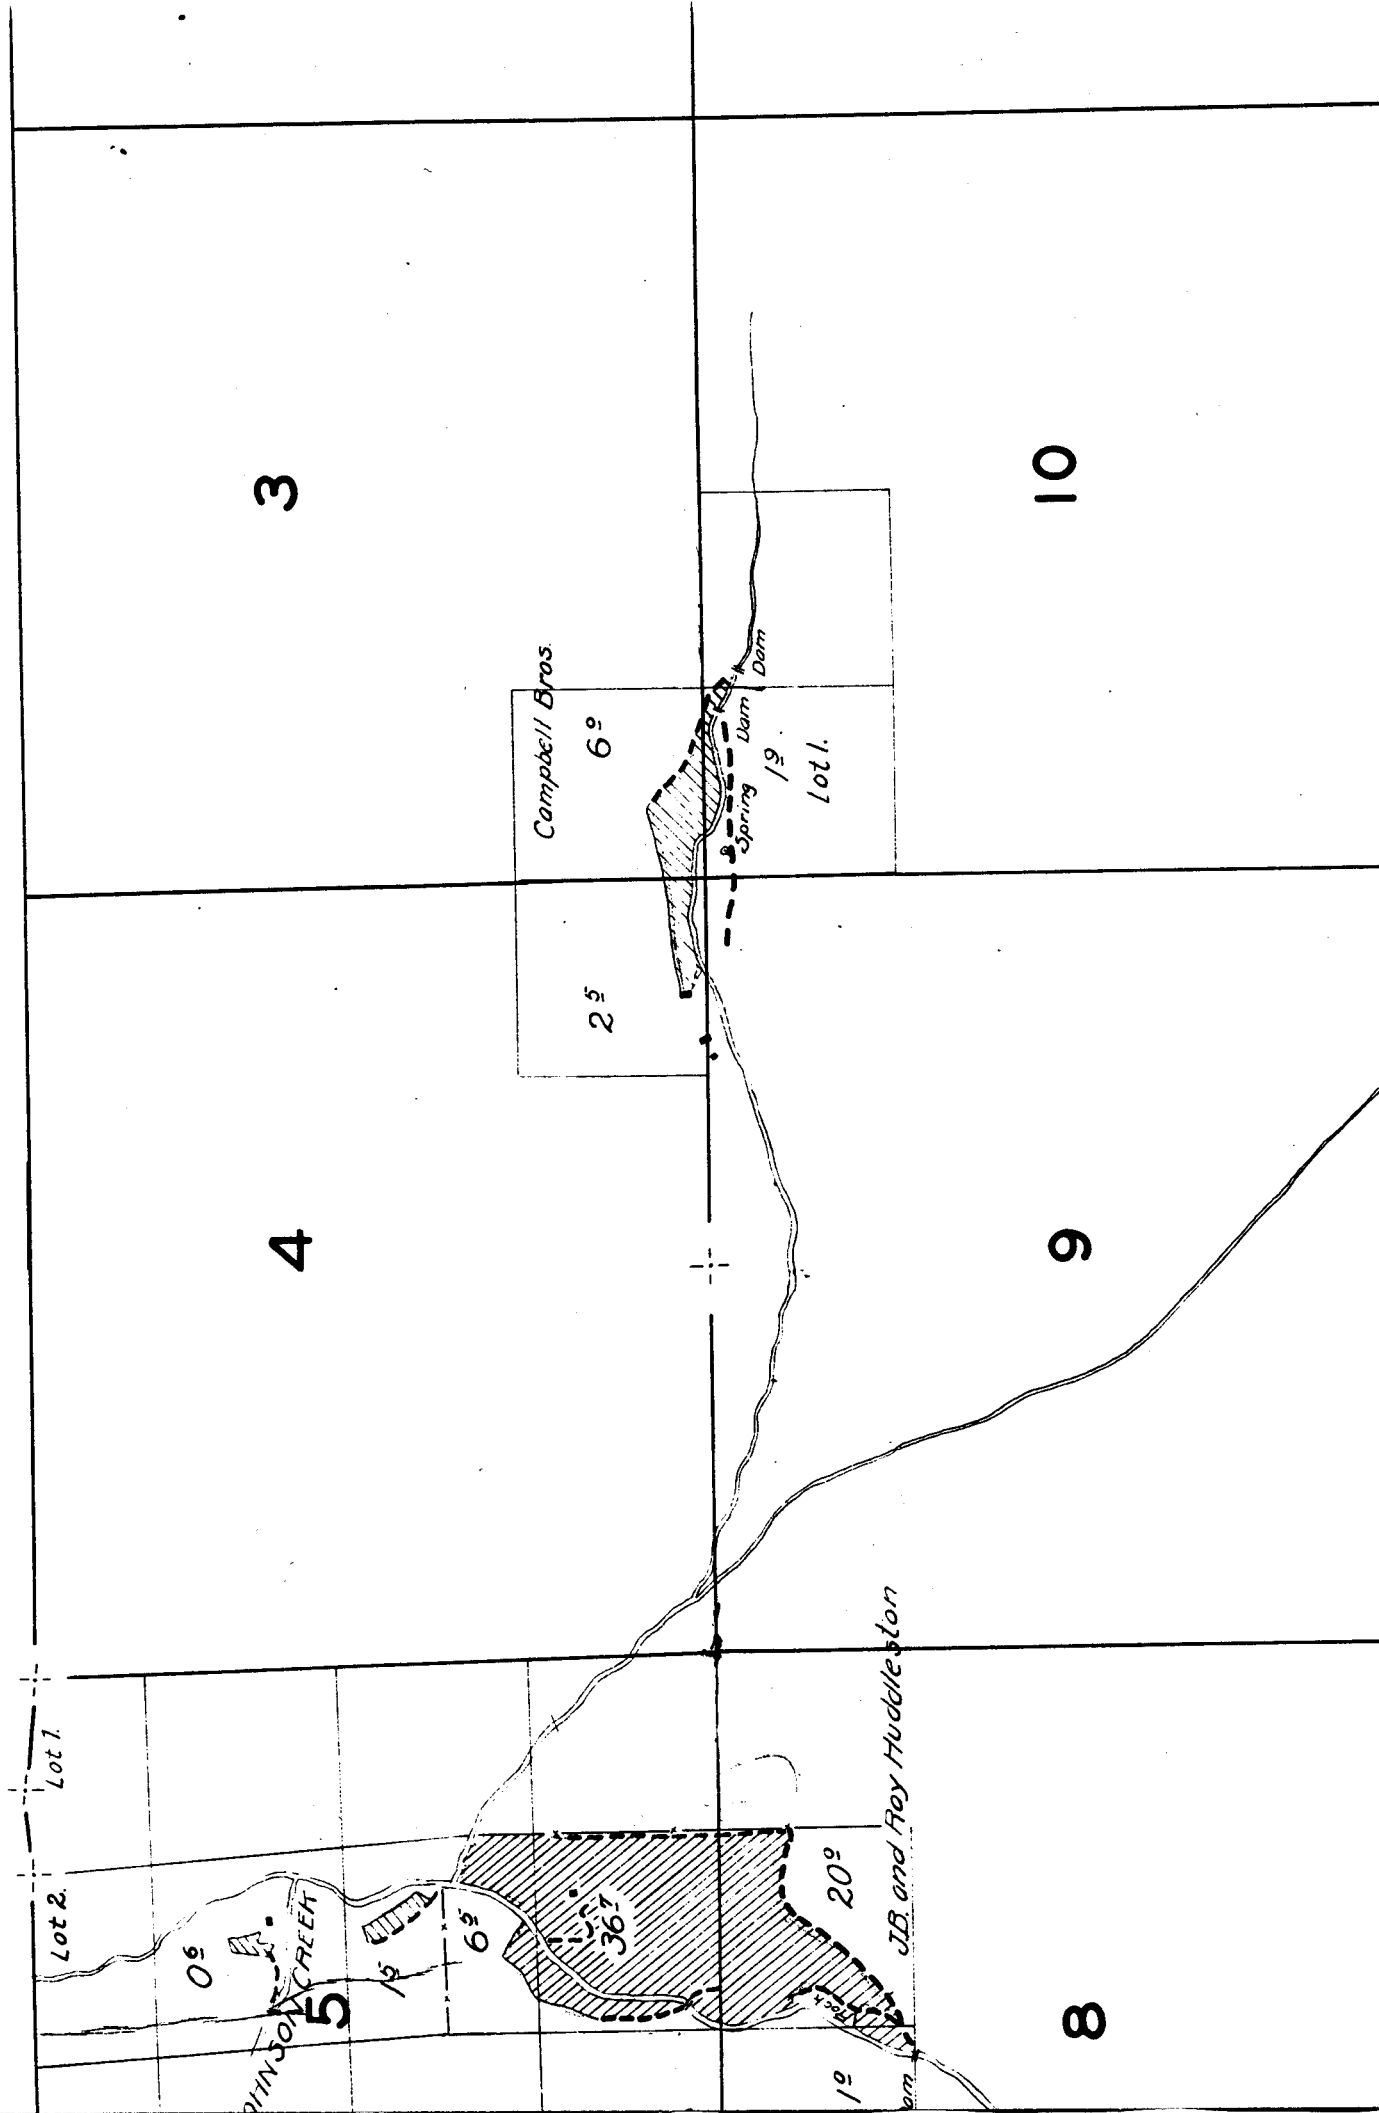

17

16

15

20

21

22

Surveyed June 5 and 6, 1925.

C-25034
1907 Dom
stock

13


24

14

23

15

22

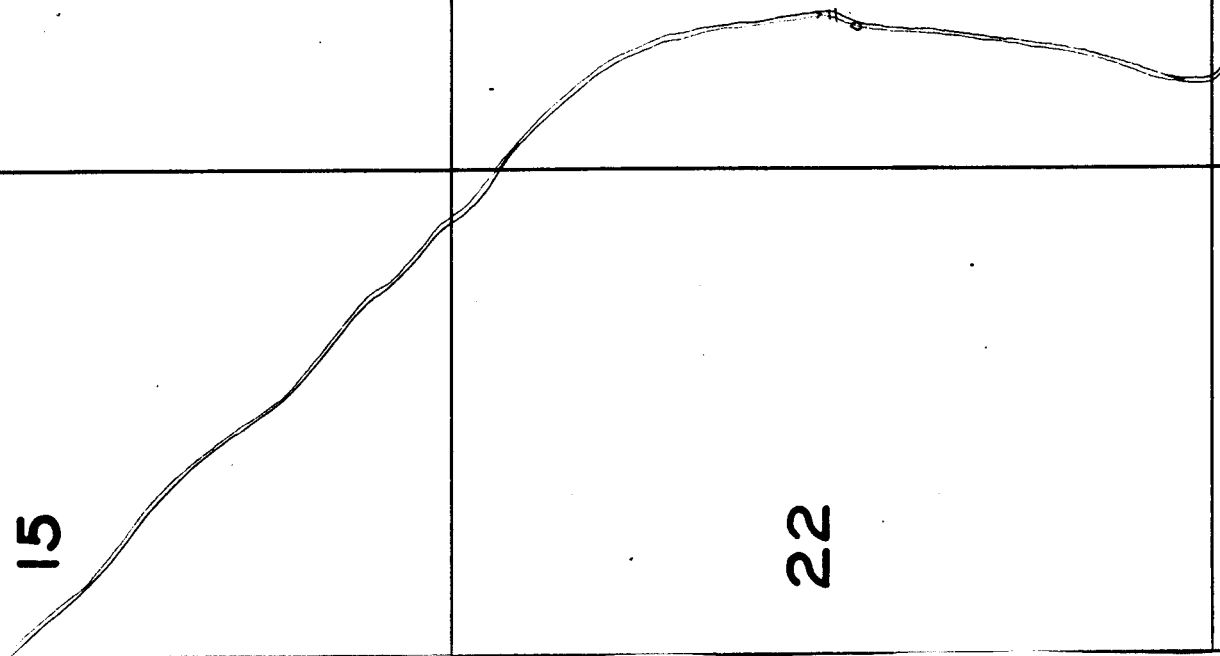

27

pt in the vicinity of
are sketched in the
location.

26

25

34

35

36