

15

14

13

22

23

24

IVES CREEK

02

62

RIJ Carsoner

17

05



Surveyed Sept. 29, 1925.

Palm Cr.

27

26


25

34

35

36

TOWNSHIP 8S., RANGE 25E.

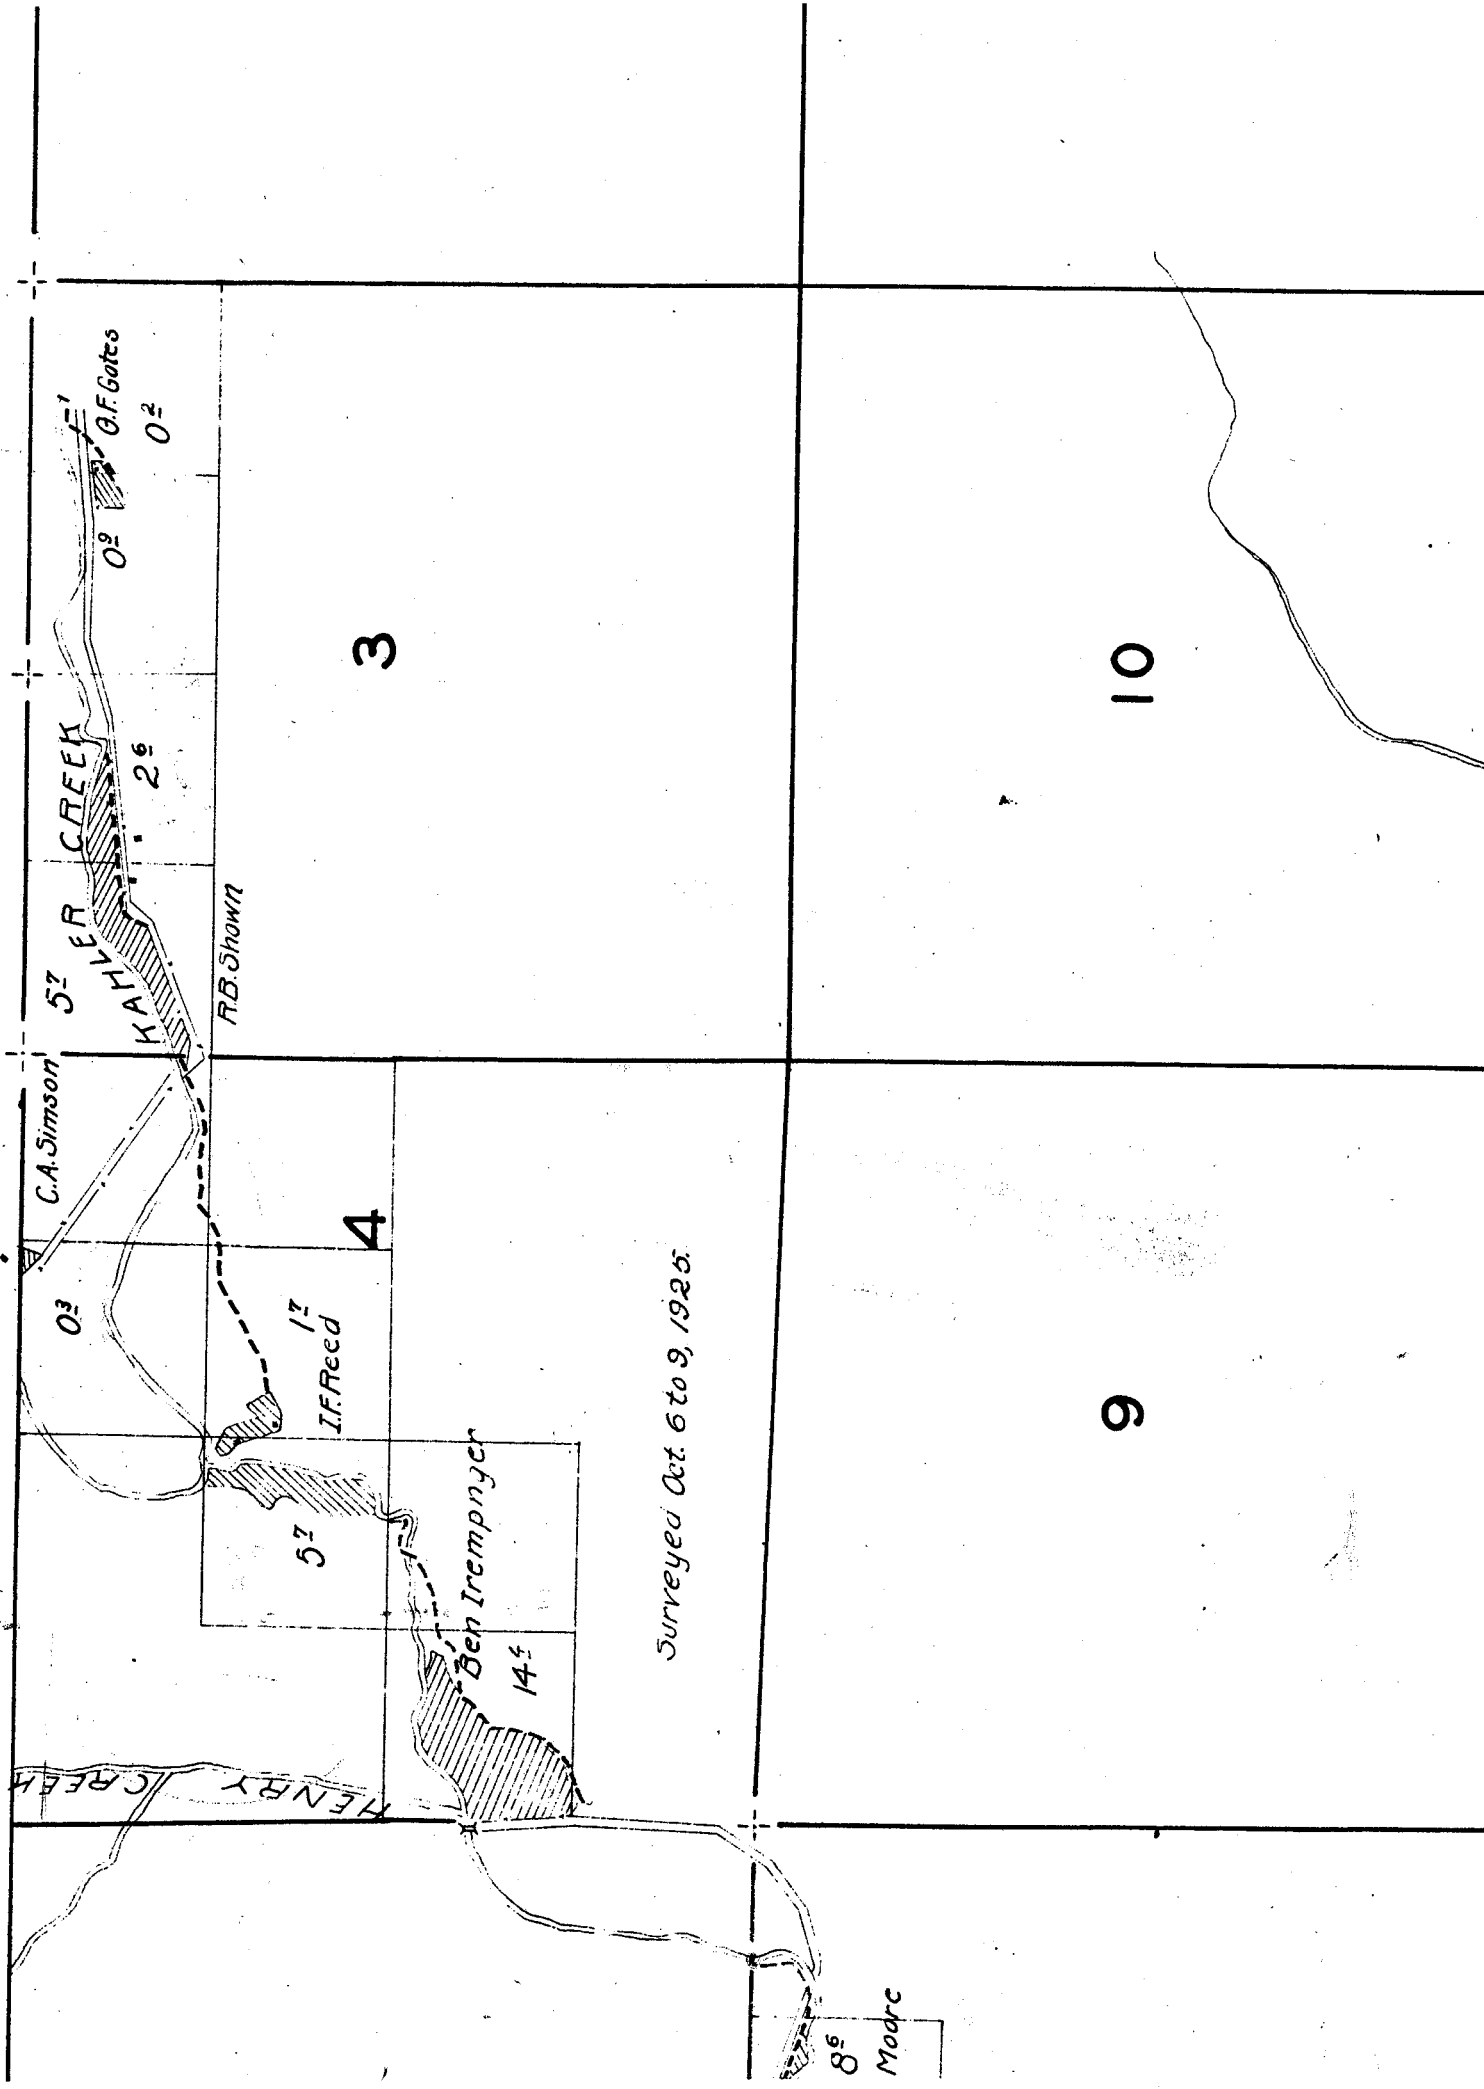

15

22

16

21

L.H. Donavon

Spring

35

75

40

1/2

1 1/2

is, except
nd, is
ation.

30

29

28

HAYSTACK

Bob Wrig 54

J. Fisher

Spring

Surveyed 56

L.L. Steiner

24

16

C. W. Walls

28

32

33

31

Surveyed Sept. 29, 1925

Carl Wagner

L.L. Steiner

263

40° Now

27°

12°

34








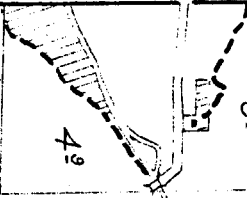

AS Borges

18

17


16

19

20

21

Note: Location of streams and roads, except in the vicinity of irrigated land, is sketched in approximate location.

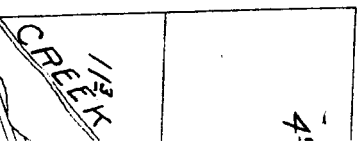

2

1

11

12

14

13

6

5

7

13

03

8

page 8^e
E. R. Moore

07

4^e

A. S. Borges

18

17

21

22

4°

3°

Spring

L.M. Donovan

112
CREEK

12

175

4°

HAYSTACK

Bob Wright

J.F. Asher

28

27

Spring

17°

Surveyed Sept. 19 to 23, 1926

Steiner

5°

C.W. Walls

1°

33

A.E. Cress

12

34

13°

40° Now C-35285

27°

02

12°

21°

Pump

32

Art Jenkins