

21

22

7⁶

4⁰

3⁵

Spring

L.M. Donovan

113
CREEK

12

HAYSTACK

Bob Wright

175

4⁵

J.F. Asher

28

27

Spring

17²

Surveyed Sept. 19 to 23, 1926

Steiner

5⁰

C.W. Walls

1⁰

A.E. Cress

1²

33

34

13⁰
40⁰ Now C-35285
27⁰

02

12⁰


21⁰

Pump

3⁰

R.H. Jenkins

TOWNSHIP 8 S., RANGE 25 E.

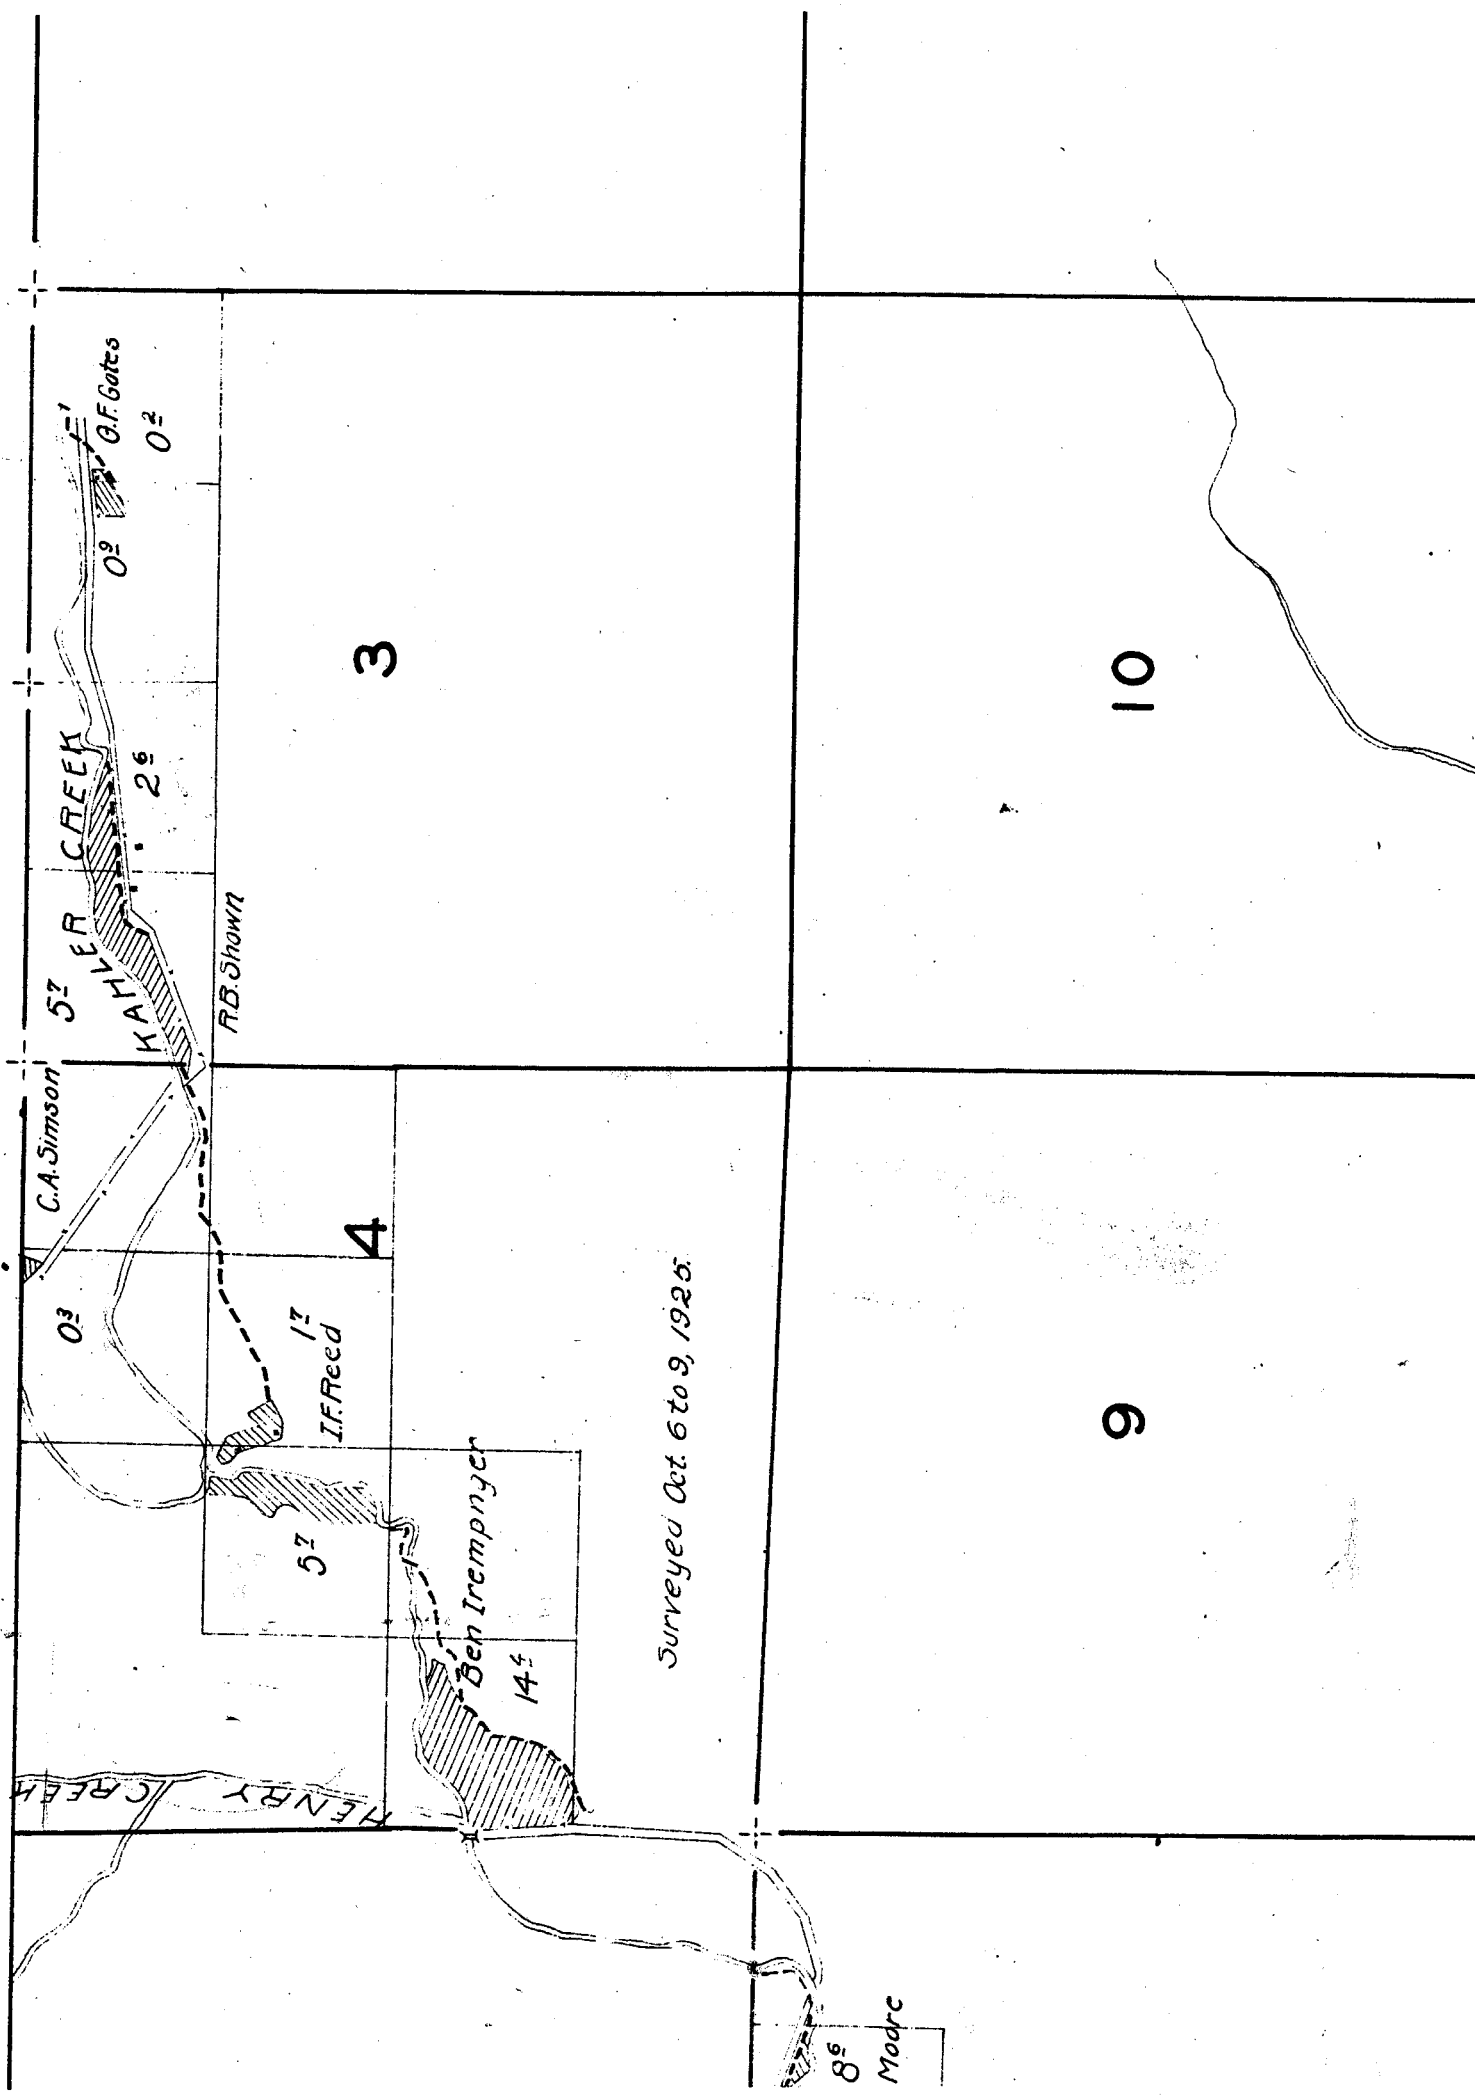


15

22

16

21

L.H. Donovan

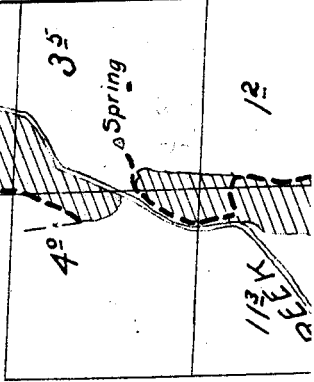

As, except
nd, is
ation.

6

5

7

13

page 8⁶

E. R. Moore

03

8

02

A. S. Borges

4⁹

18

17

2

1

11

12

14

13

30

29

28

31

32

33

Surveyed Sept. 29, 1925.

Surveyed Se

First National Bank
London
03

Carl Wagner

L. Steiwer


L.L. Steiwer


J. Fisher

C.W. Walls

HAYSTACK

Bob Wright 54

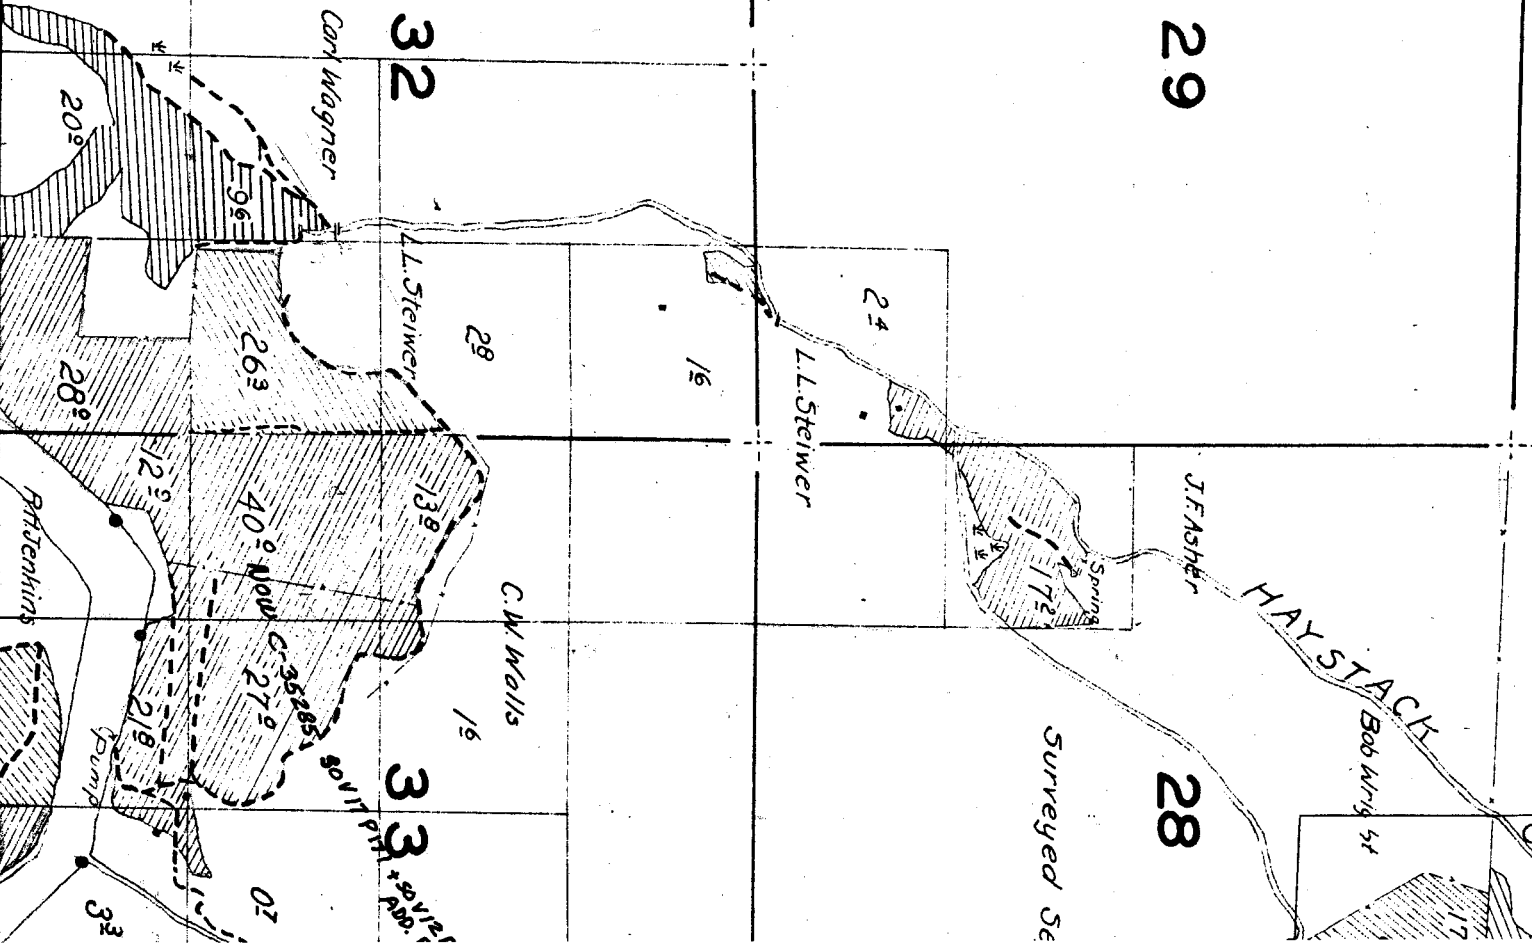

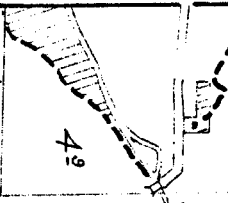

A5 Borges

49

18

17


16

19

20

21

Note: Location of streams and roads, except in the vicinity of irrigated land, is sketched in approximate location.

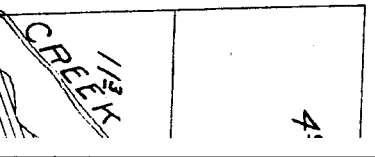

4

Surveyed Sept. 29, 1925.

Palm Cr.

27

26

25

34

35

36



15

14

13

22

23

24

IVE'S CREEK

02

69



RJ CORNER

17

05

