

6

5

7

13

03

8

Gage 8⁶

E.A. Modre

02

4⁹

A.S. Borges

18

17

Surveyed Sept 29, 1925.

Balm Cr.

27

26

25

34

35

36

15

14

13

22

23

24

IVE'S CREEK

02

62

AD CORNER

17

05



30

29

28


31


32

33

Surveyed Sept. 29, 1925

First National Bank
Condon
O.S.

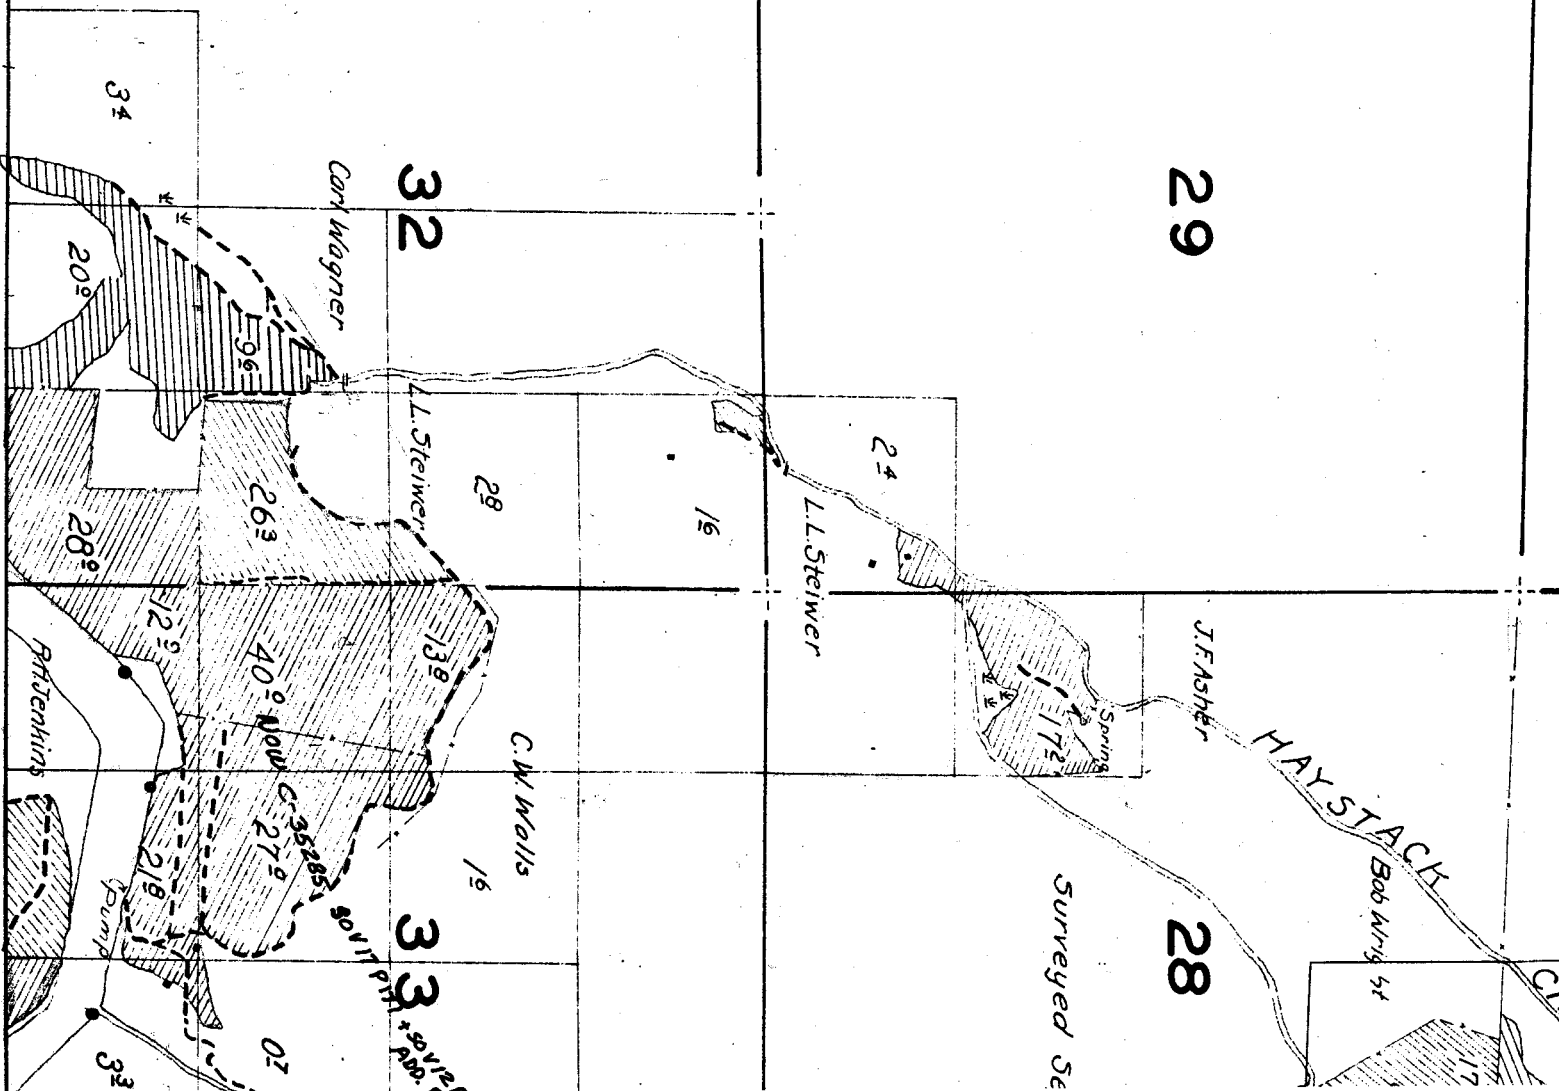

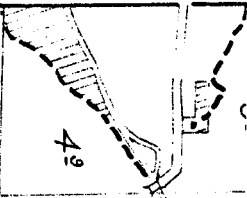

AS Borges

18

17


16

19

20

21

*Note: Location of streams and roads, except
in the vicinity of irrigated land, is
sketched in approximate location.*

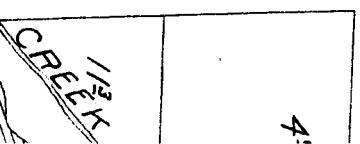

2

1


11

12

14

13

TOWNSHIP 8 S., RANGE 25 E.

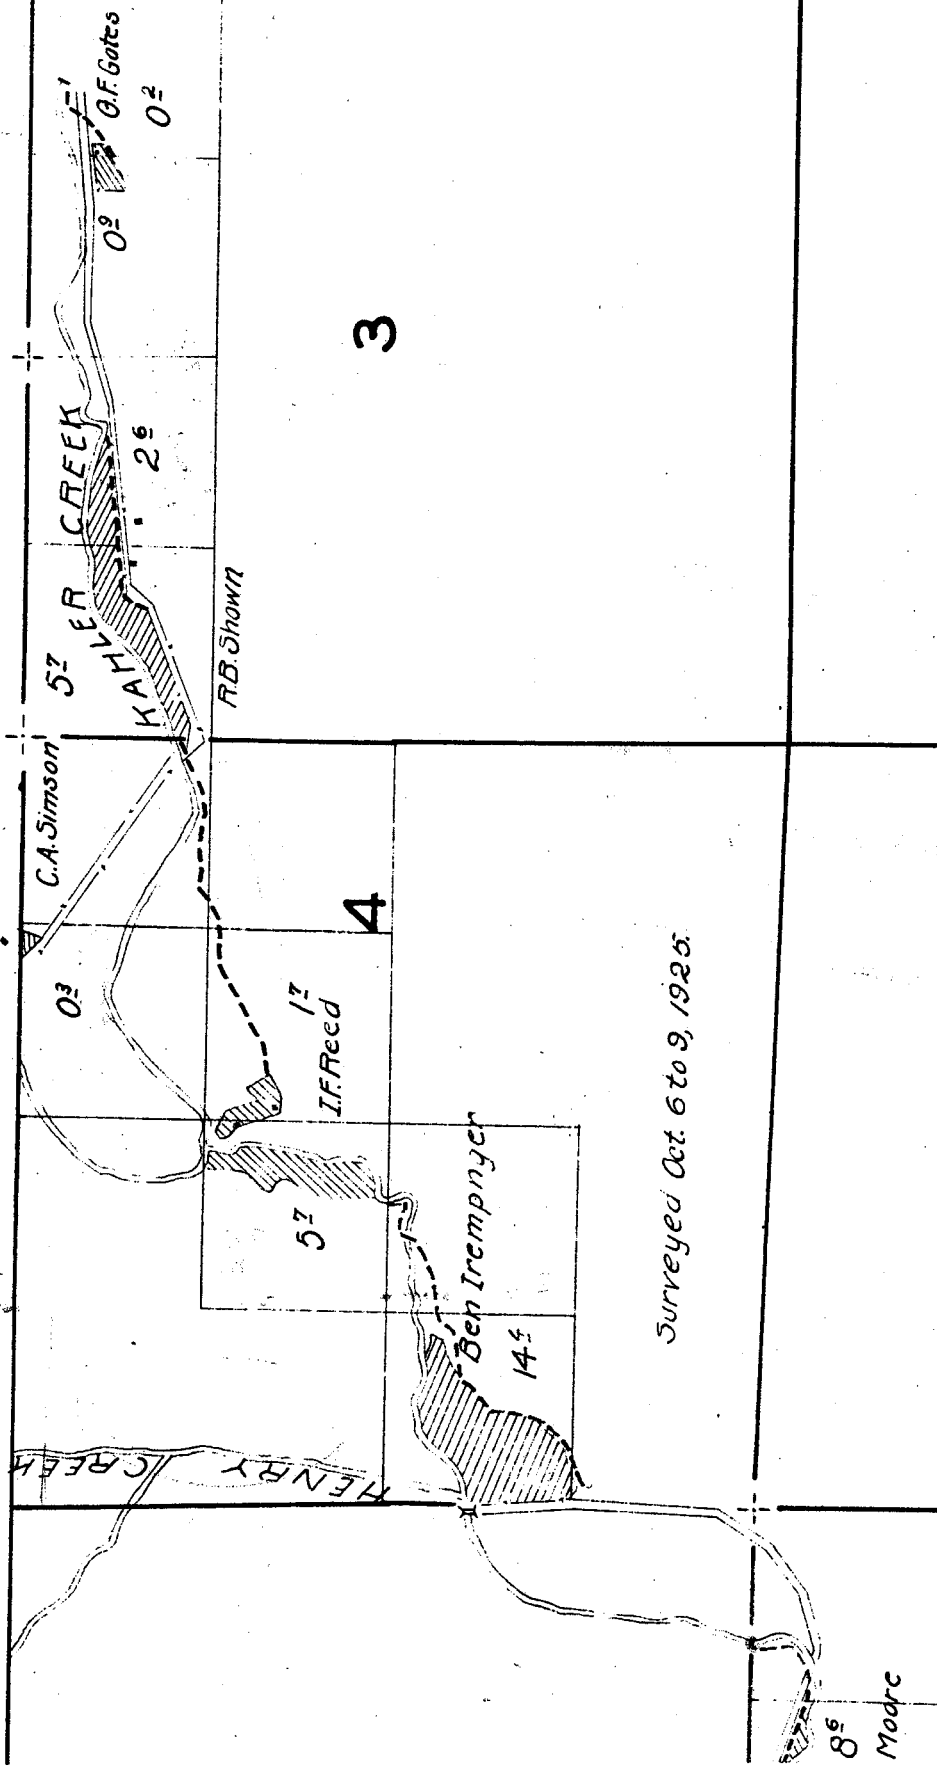


15

22

16

21

L.H. Donarvon

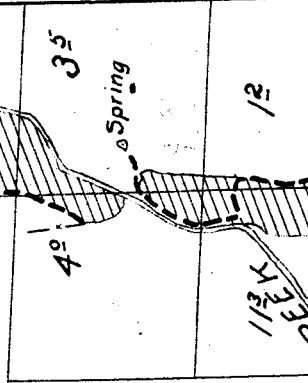

is, except
nd, is
ation.

21

22

L.H. Donarvon

113
CREEK

12

HAYSTACK

Bob Wright

J.F. Asher

28

27

Surveyed Sept. 19 to 23, 1926

Steiner

C.W. Walls

33

A.E. Cress

34

40° Now C-35285

218

Pump

Pr. Jenkins