




, Range 27 E.W.M..

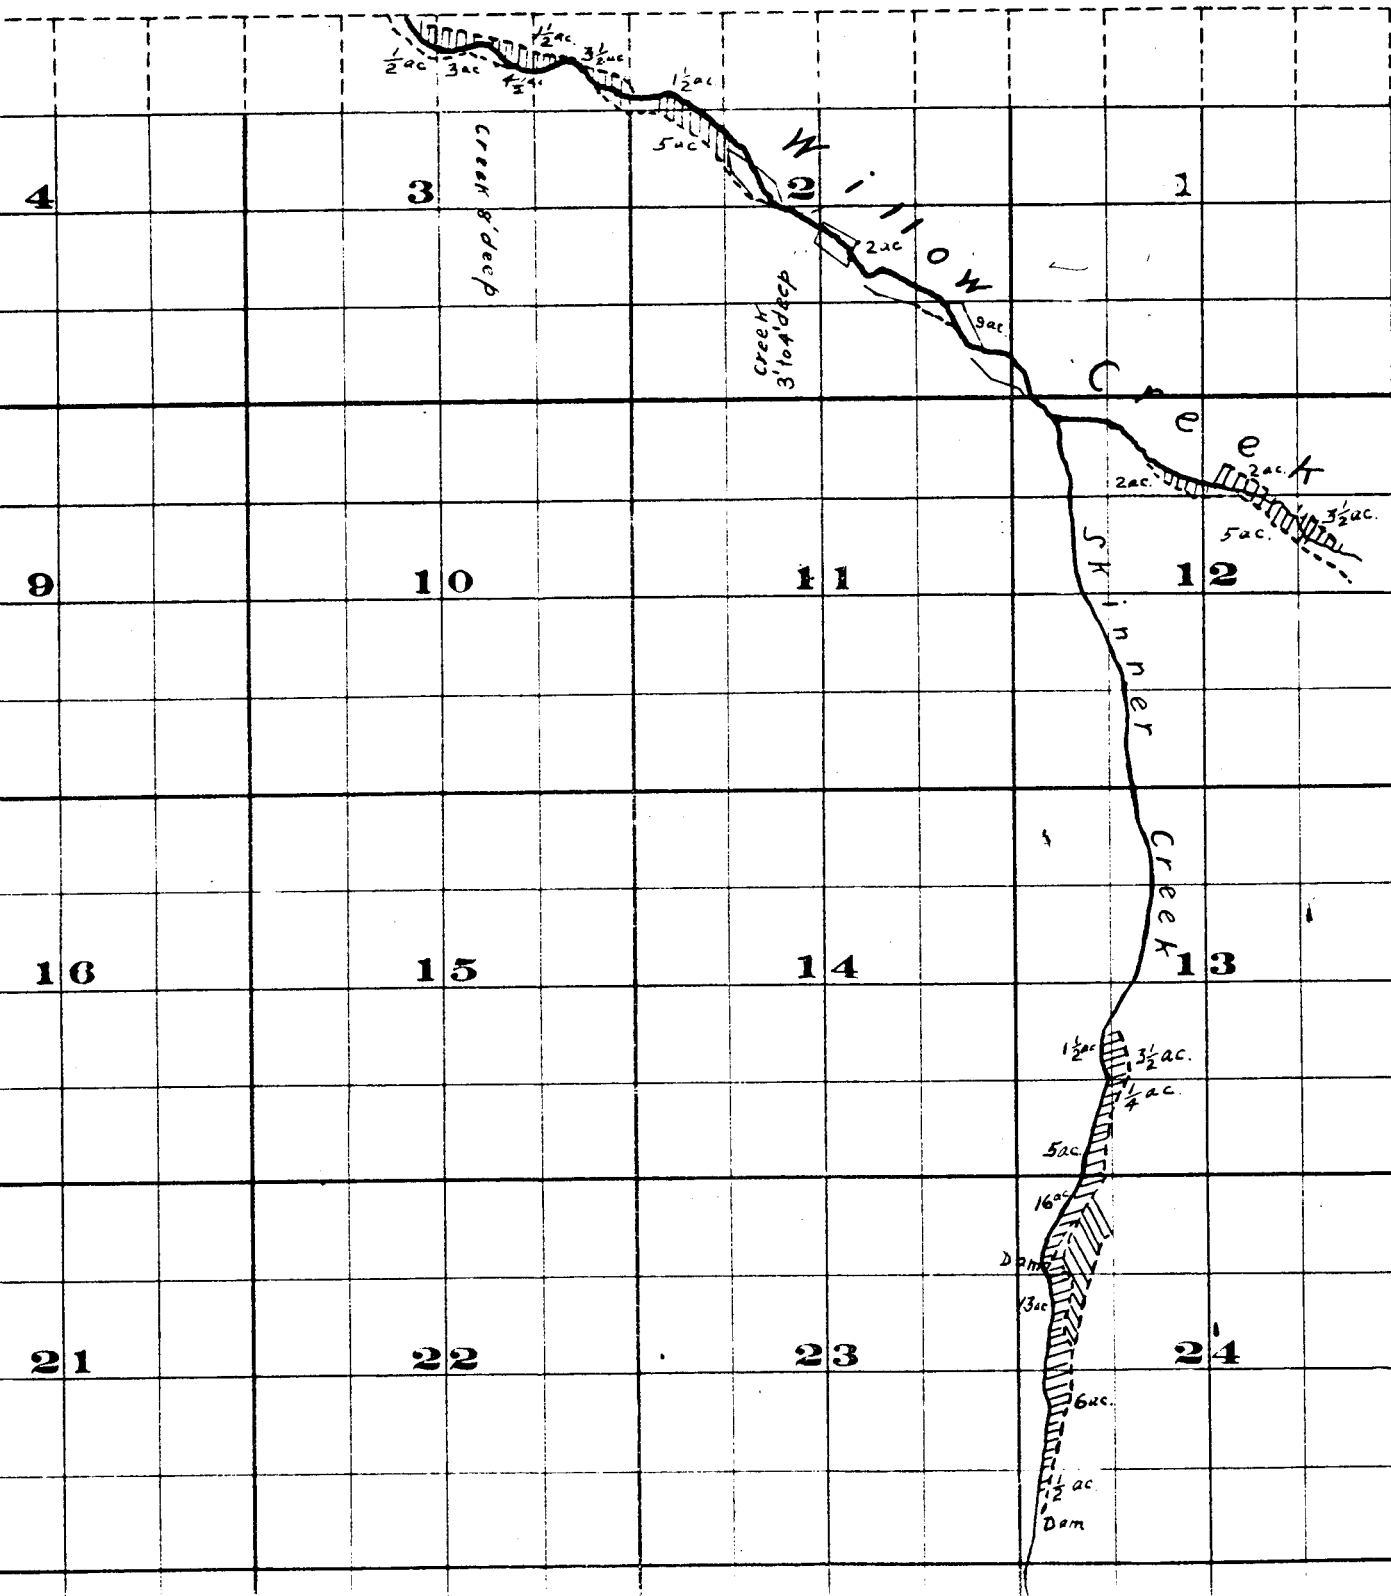

7

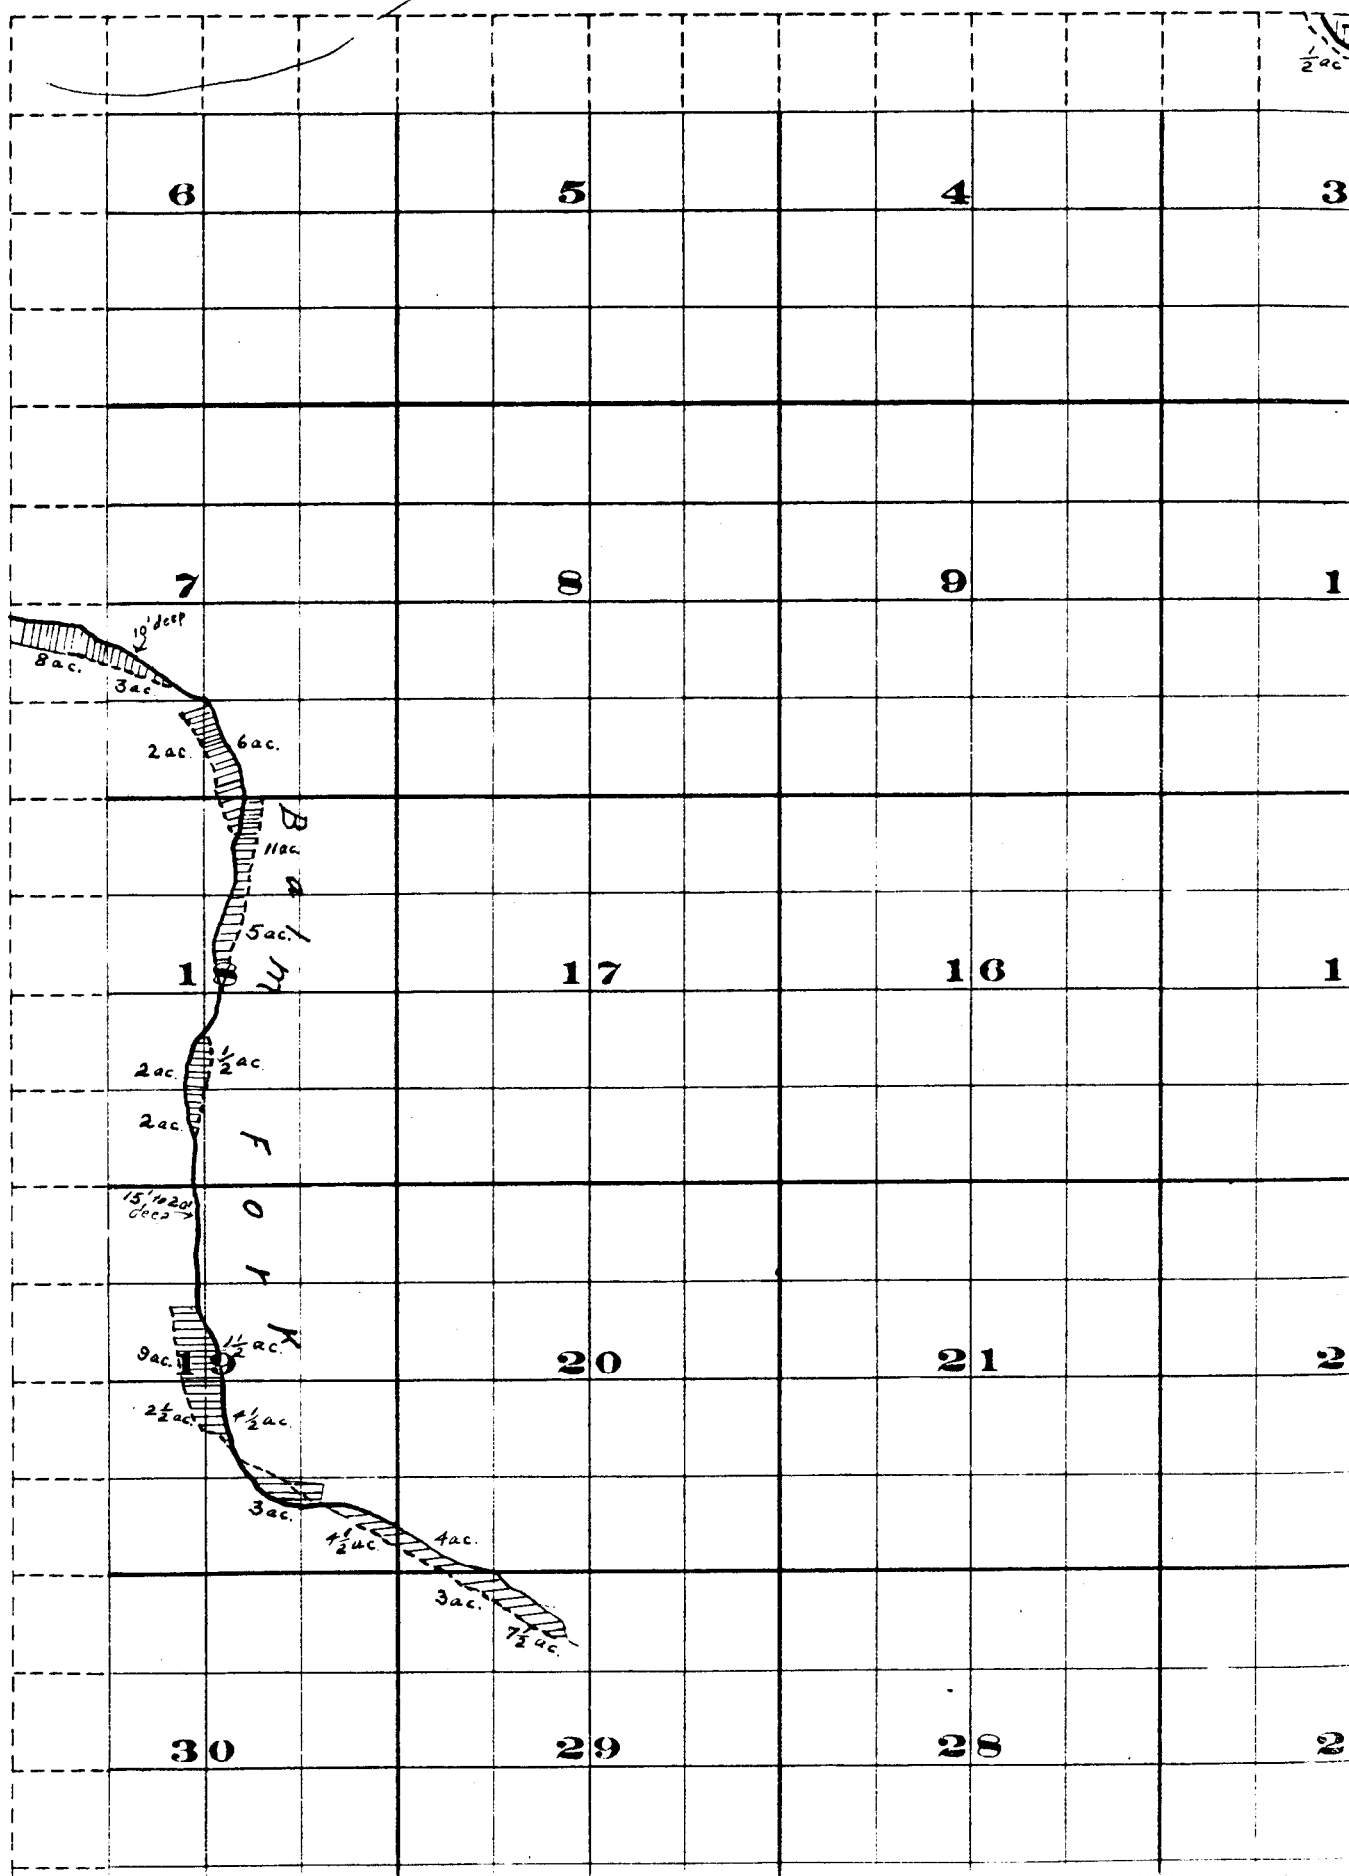

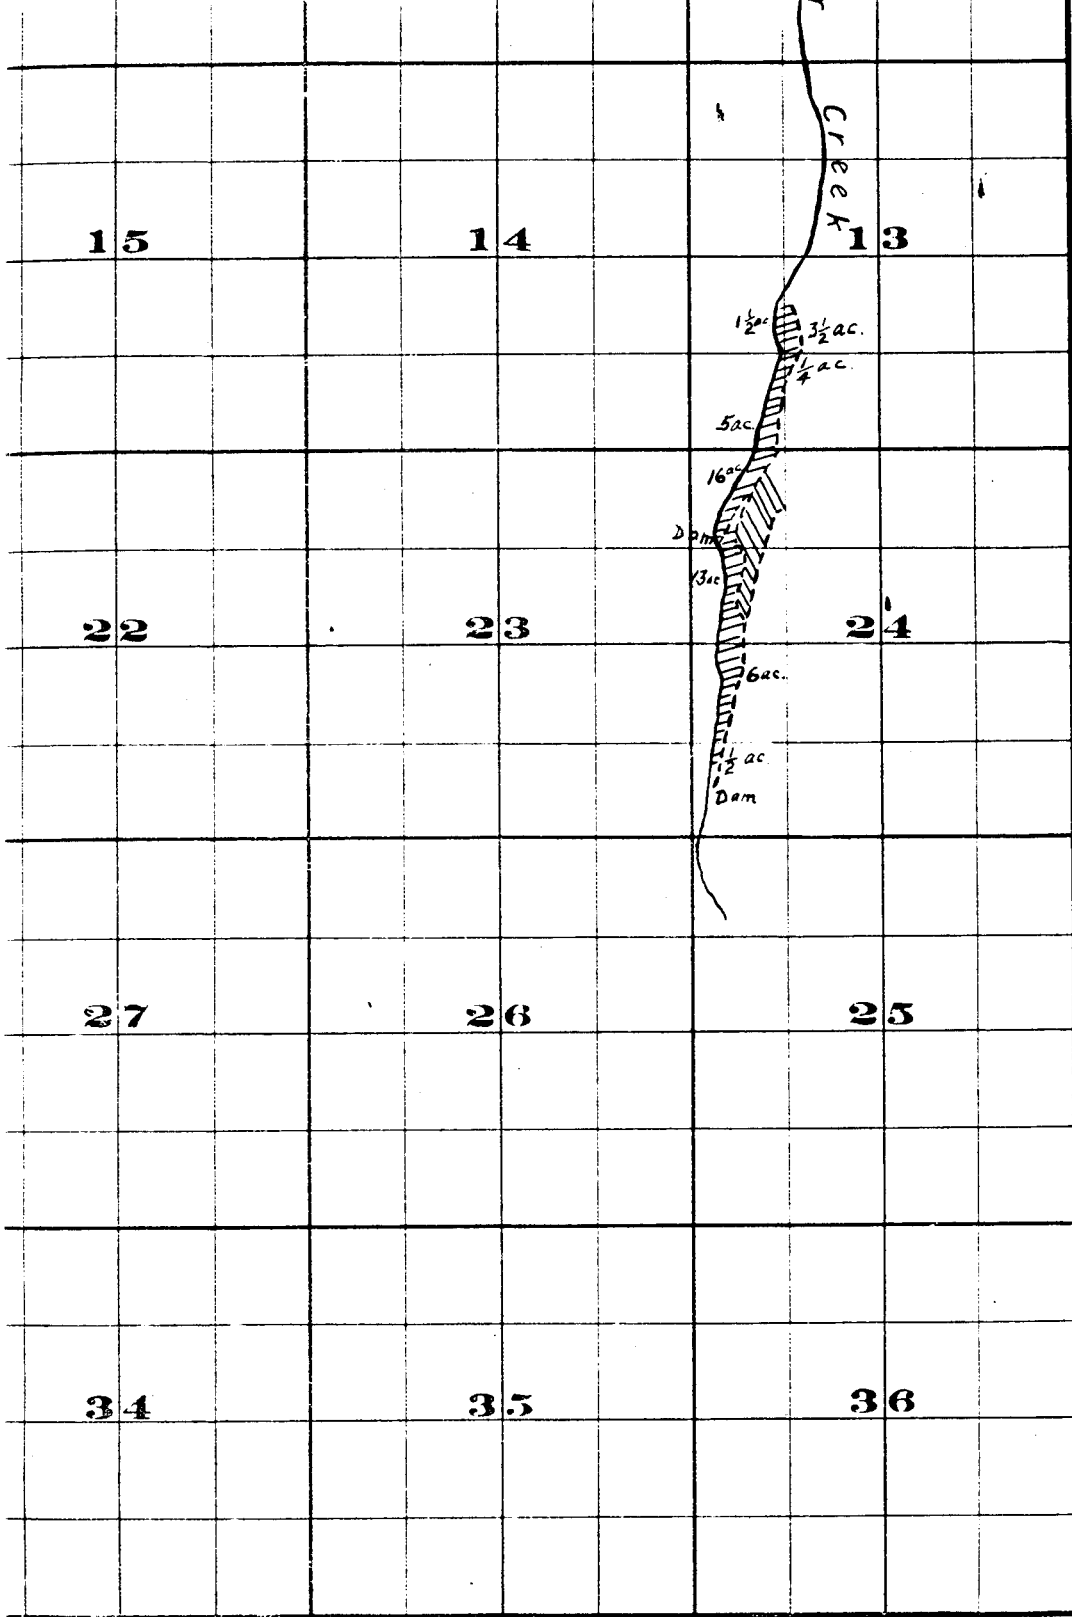

FROM OFFICE OF THE STATE ENGINEER, SALEM, OREGON
Willow Creek Adjudication

35.27 E.