

21

22

2^d
FW.Ball

Note: Location according
to Mr. Ball.
School


28

27

33

34

TOWNSHIP 7 S., RANGE 21 E.

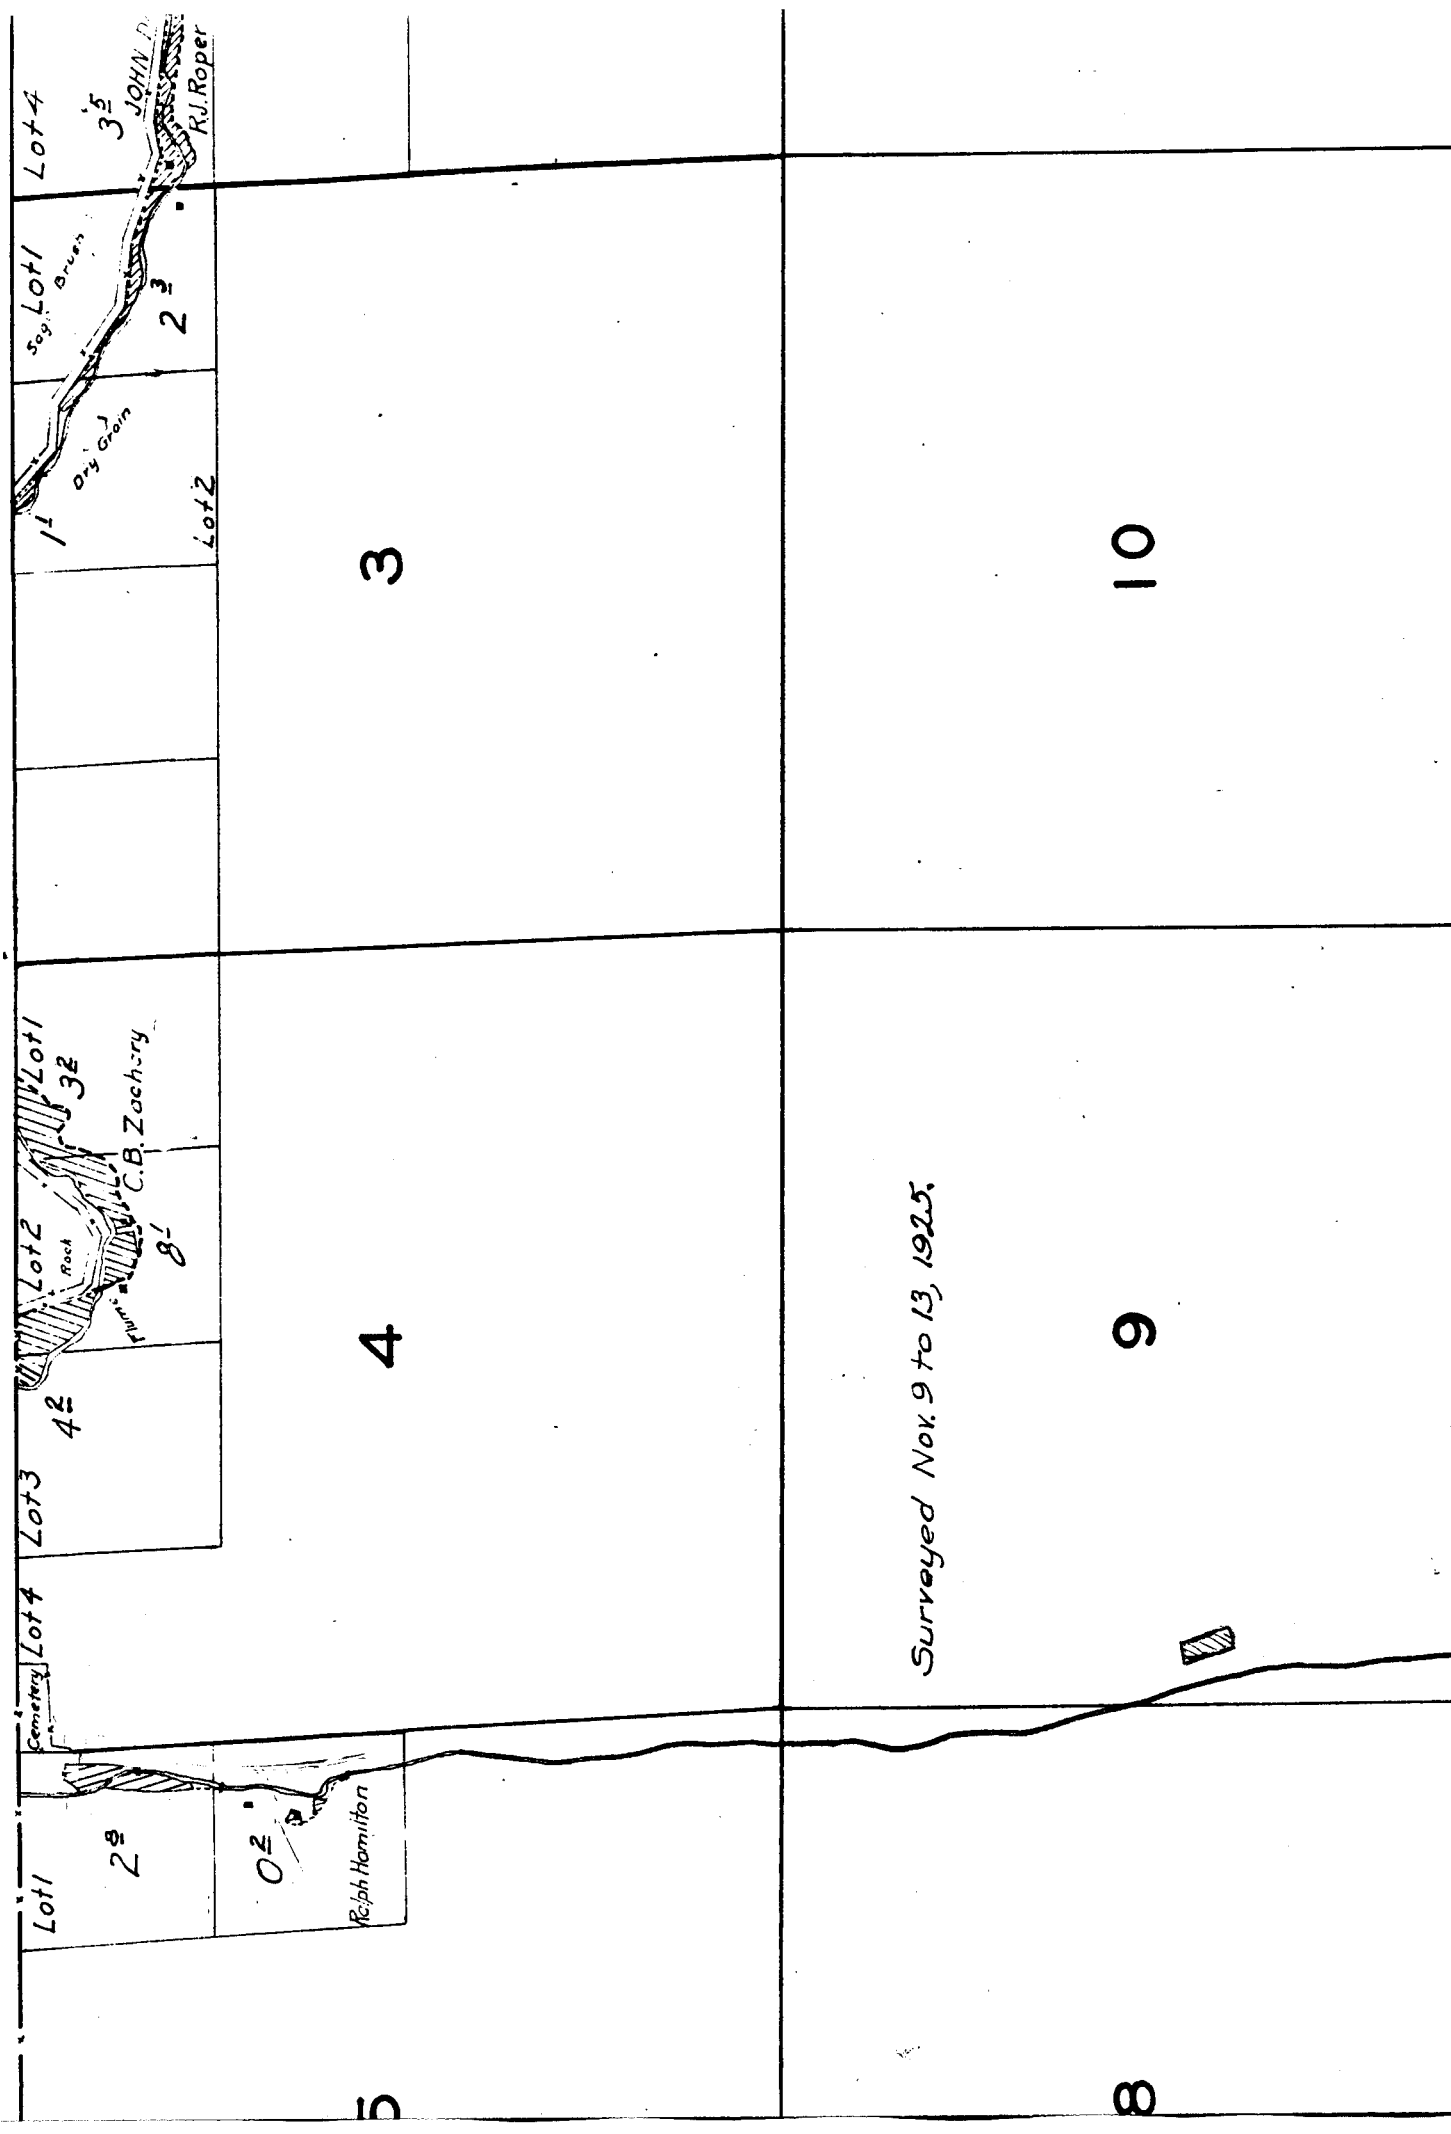


Note: Streams not in the vicinity of
irrigated lands sketched in approximate location.

COTTONWOOD

15

16

7

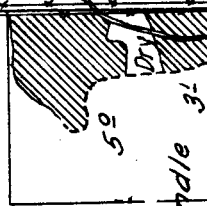

C.L. Prindle

31

veyed June, 1927

CREEK

22


21

0

Note: Location according
to Mr. Ball
School

2^d

FWBall

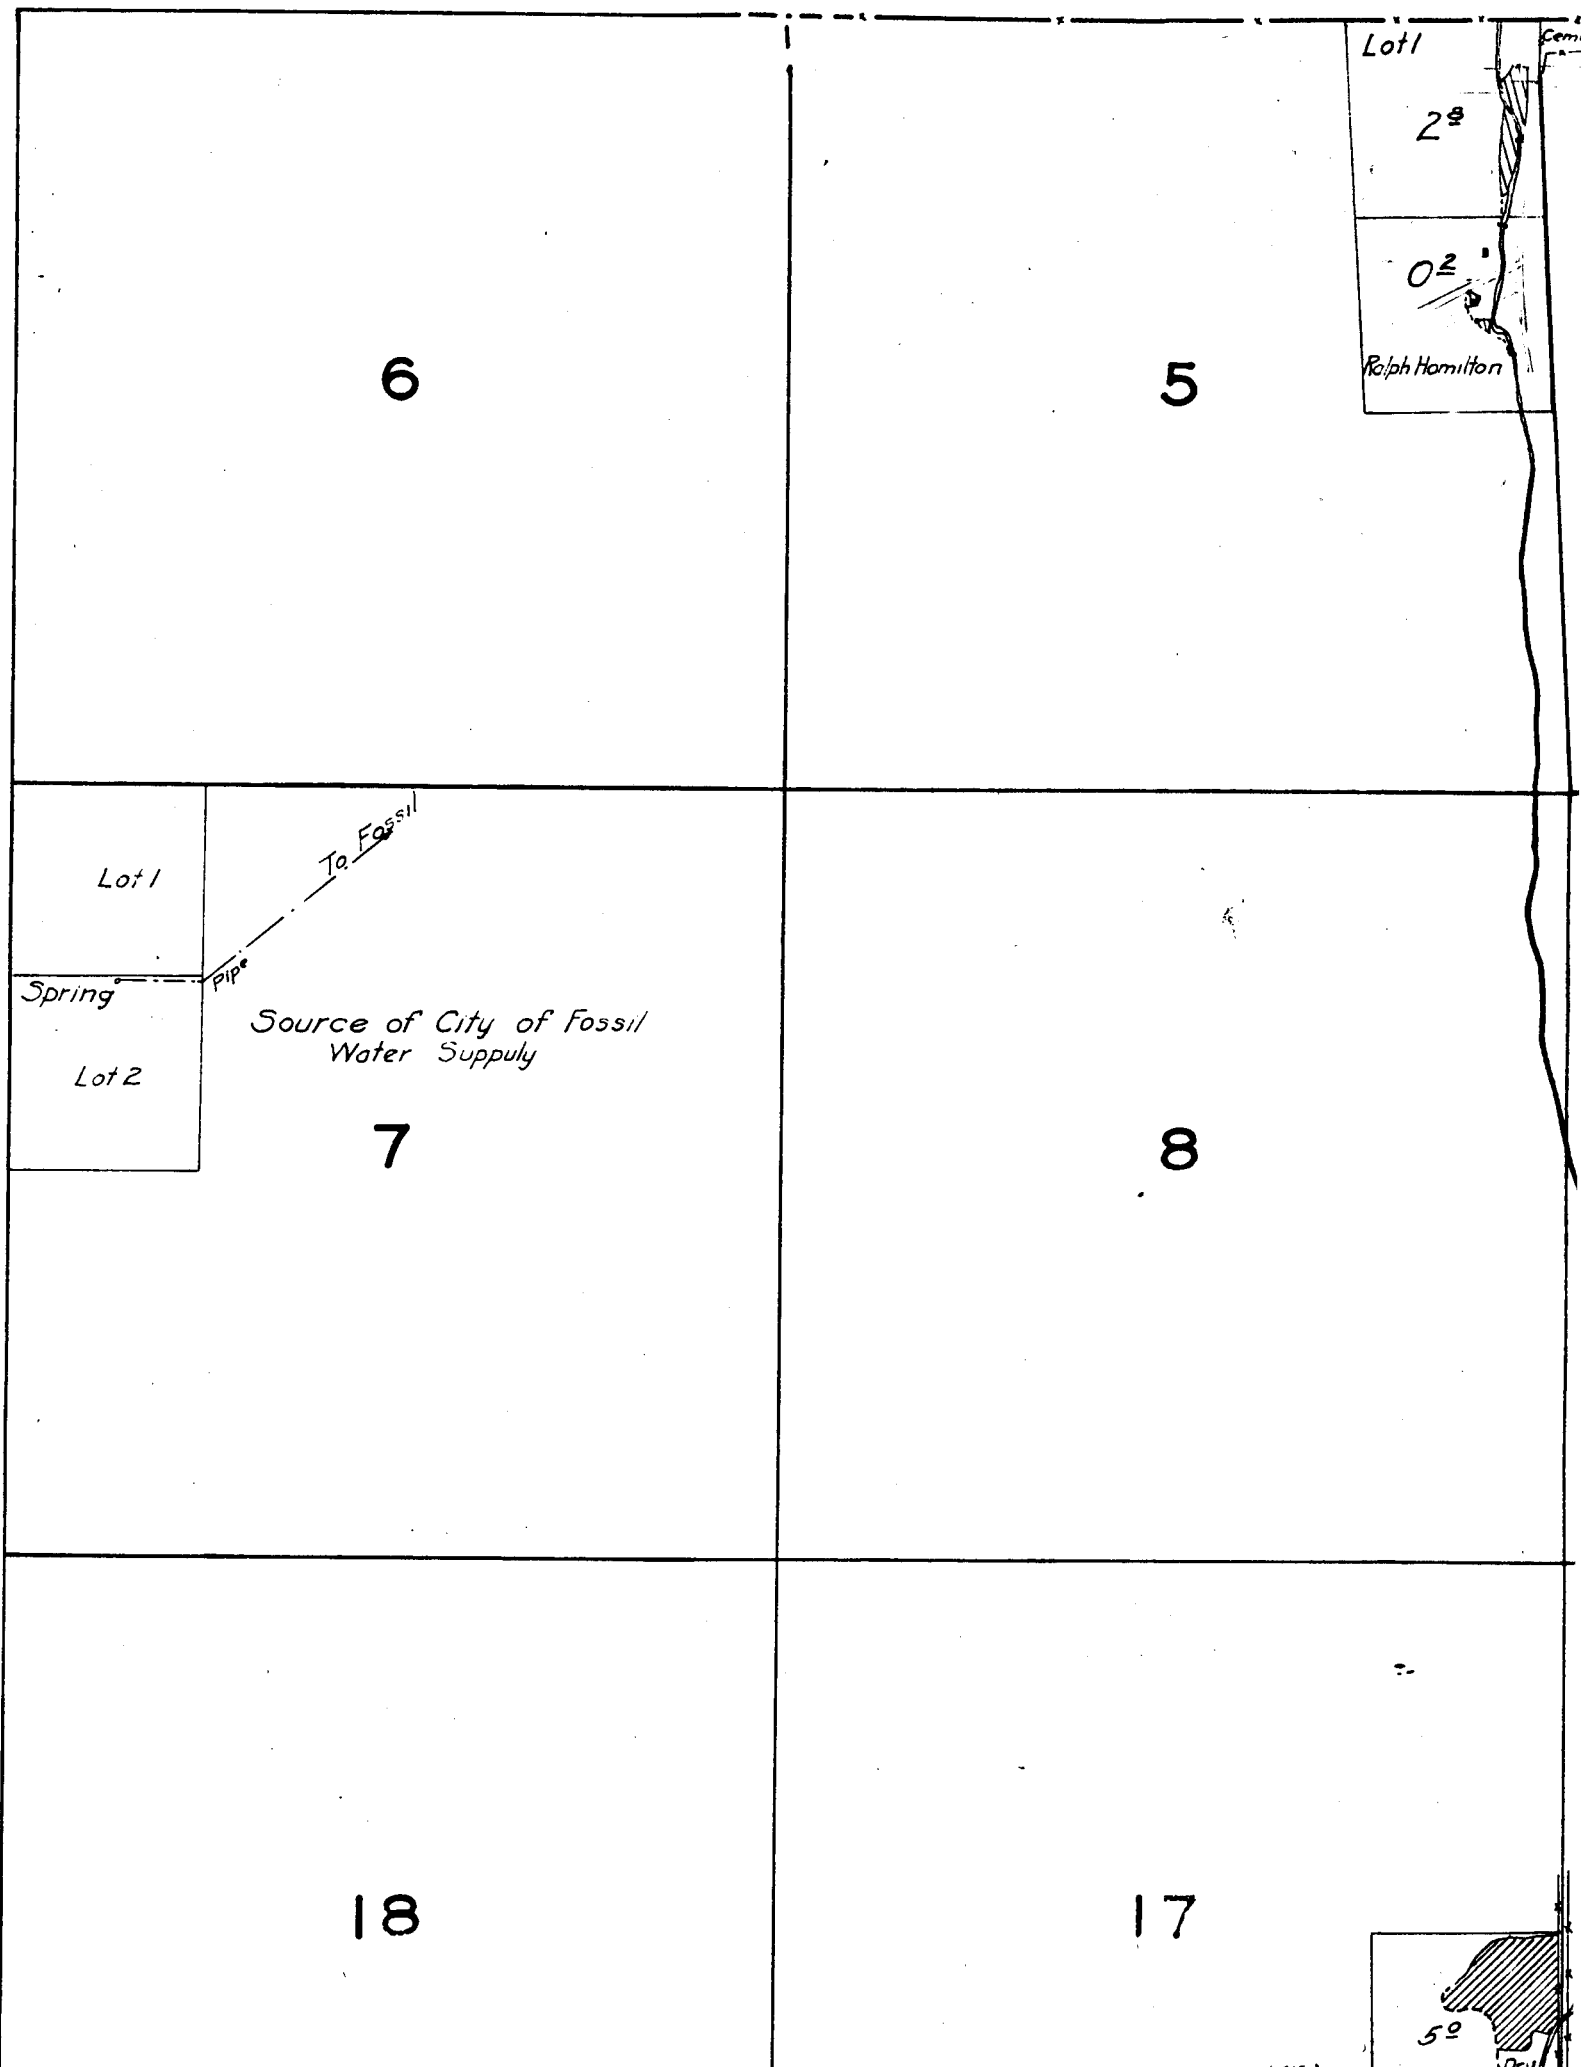

6

5

Lot 1

2^d

0²

Ralph Hamilton

Lot 1

Spring

Lot 2

To Fossil

Pipe

Source of City of Fossil
Water Supply

7


8

18

17

50

Note: Streams not in the
irrigated lands sketched

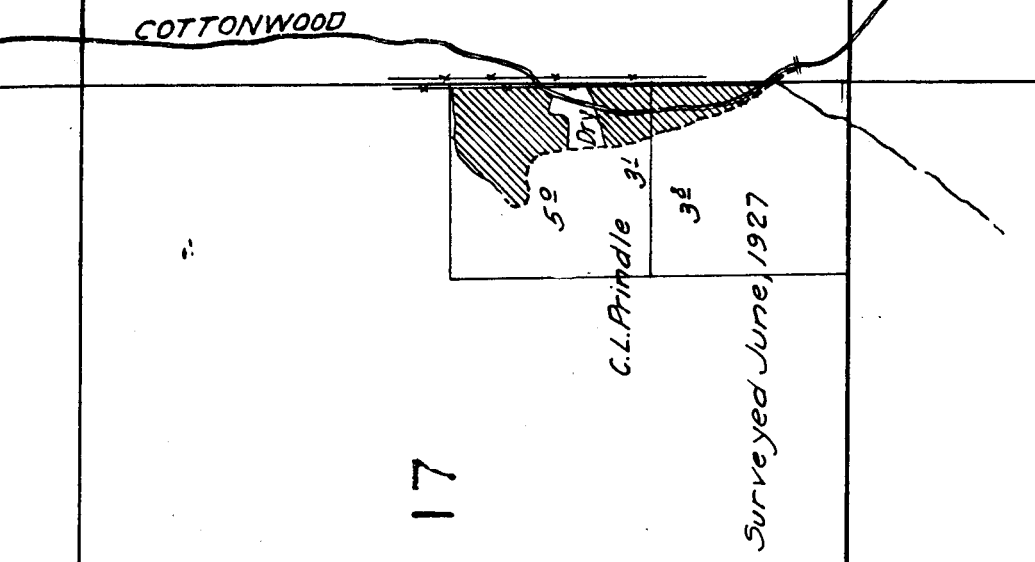

28


29

30

33

32

31

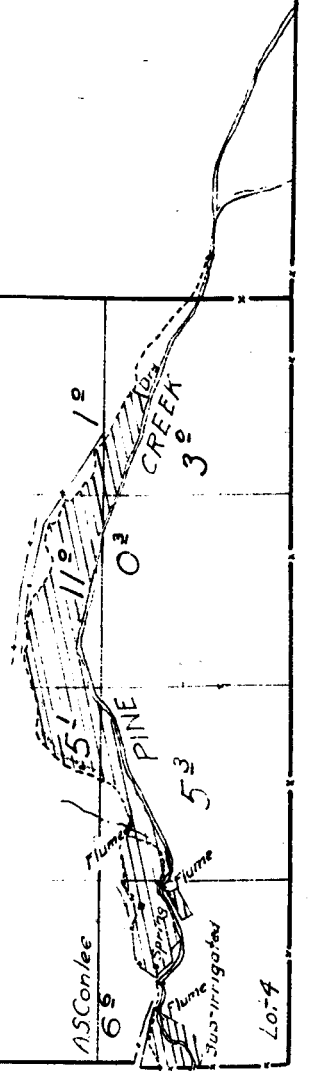

27


26

25

34

35

36

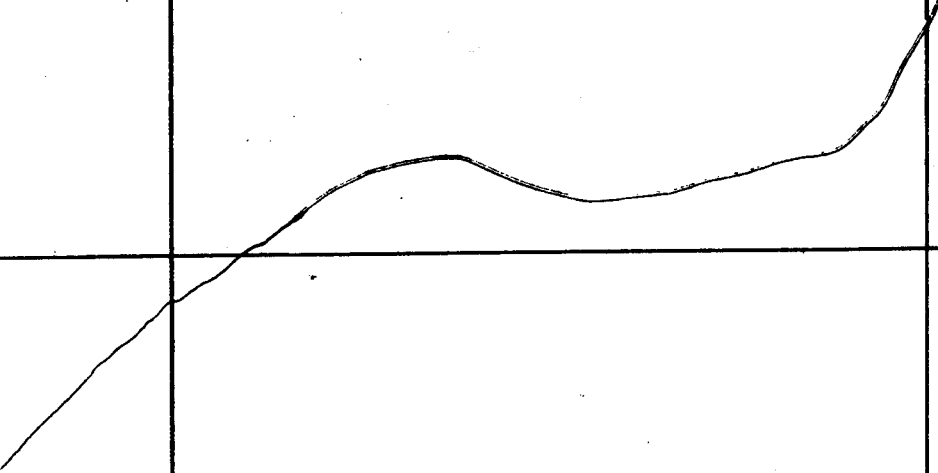


[illegible]

Location according to Mr. Ball.	22	23	24
			

			

			

			

