

21

22

2²
FWBall

*Note: Location according
to Mr. Ball.*
School

28

27

33

34

Note: Streams not in the vicinity of irrigated lands sketched in approximate location.

COTTONWOOD

7

C.L. Prindle
31

urveyed June, 1927

52

32

16

15

CREEK

0


21


22


22
FW Ball

Note: Location according to Mr. Ball School

TOWNSHIP 7 S., RANGE 21 E.

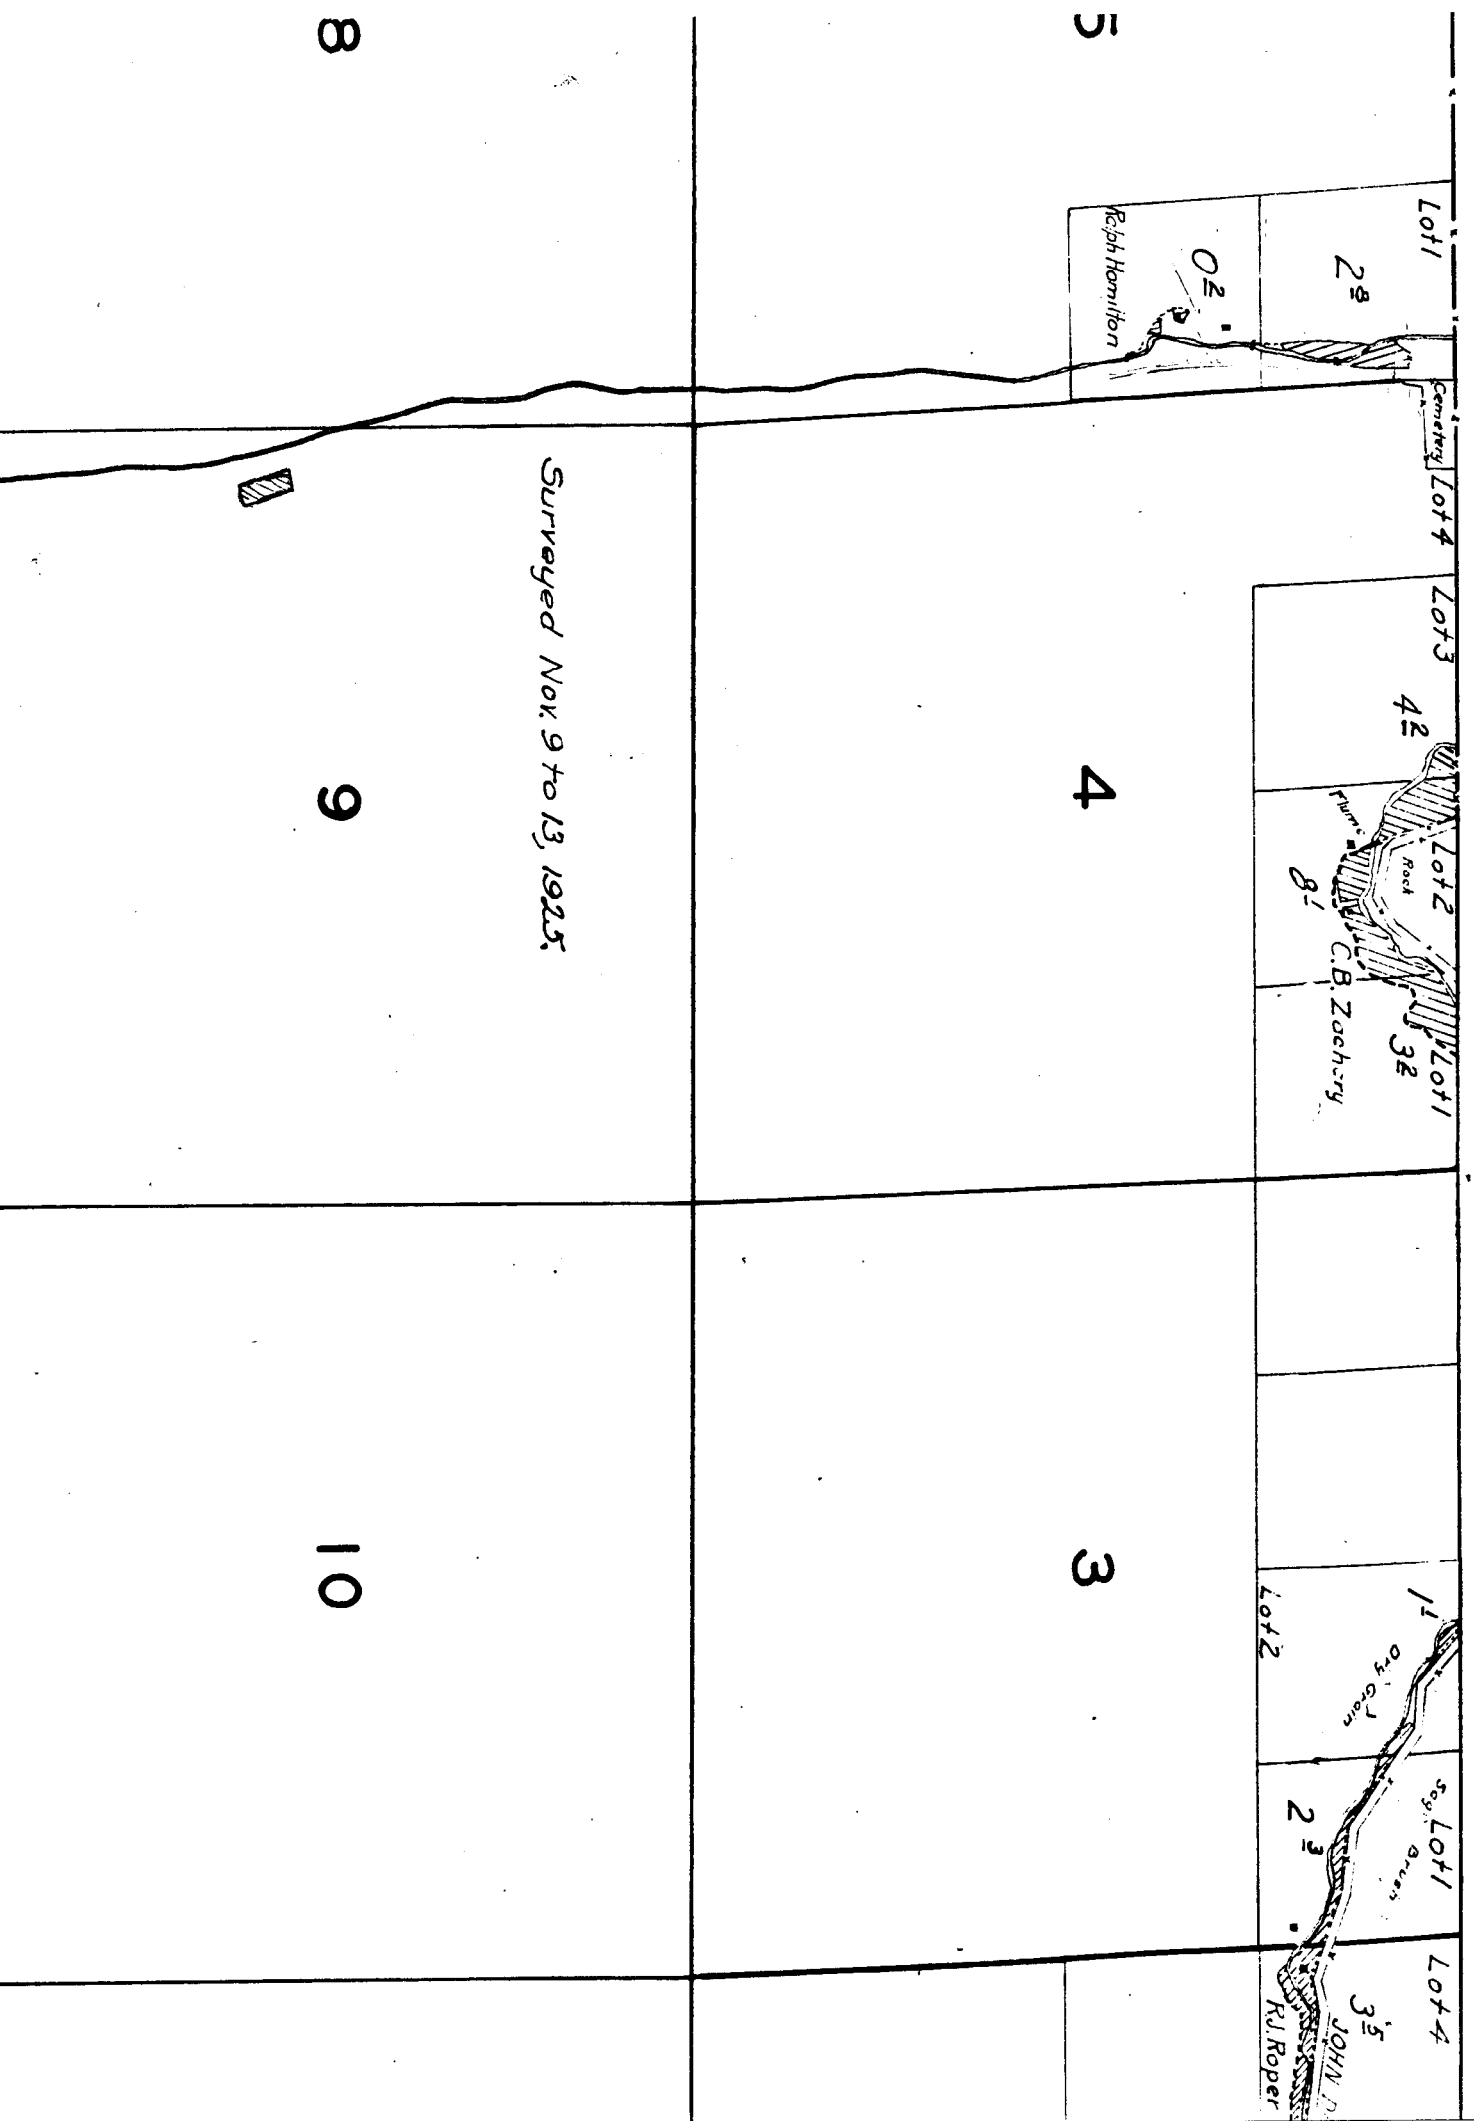

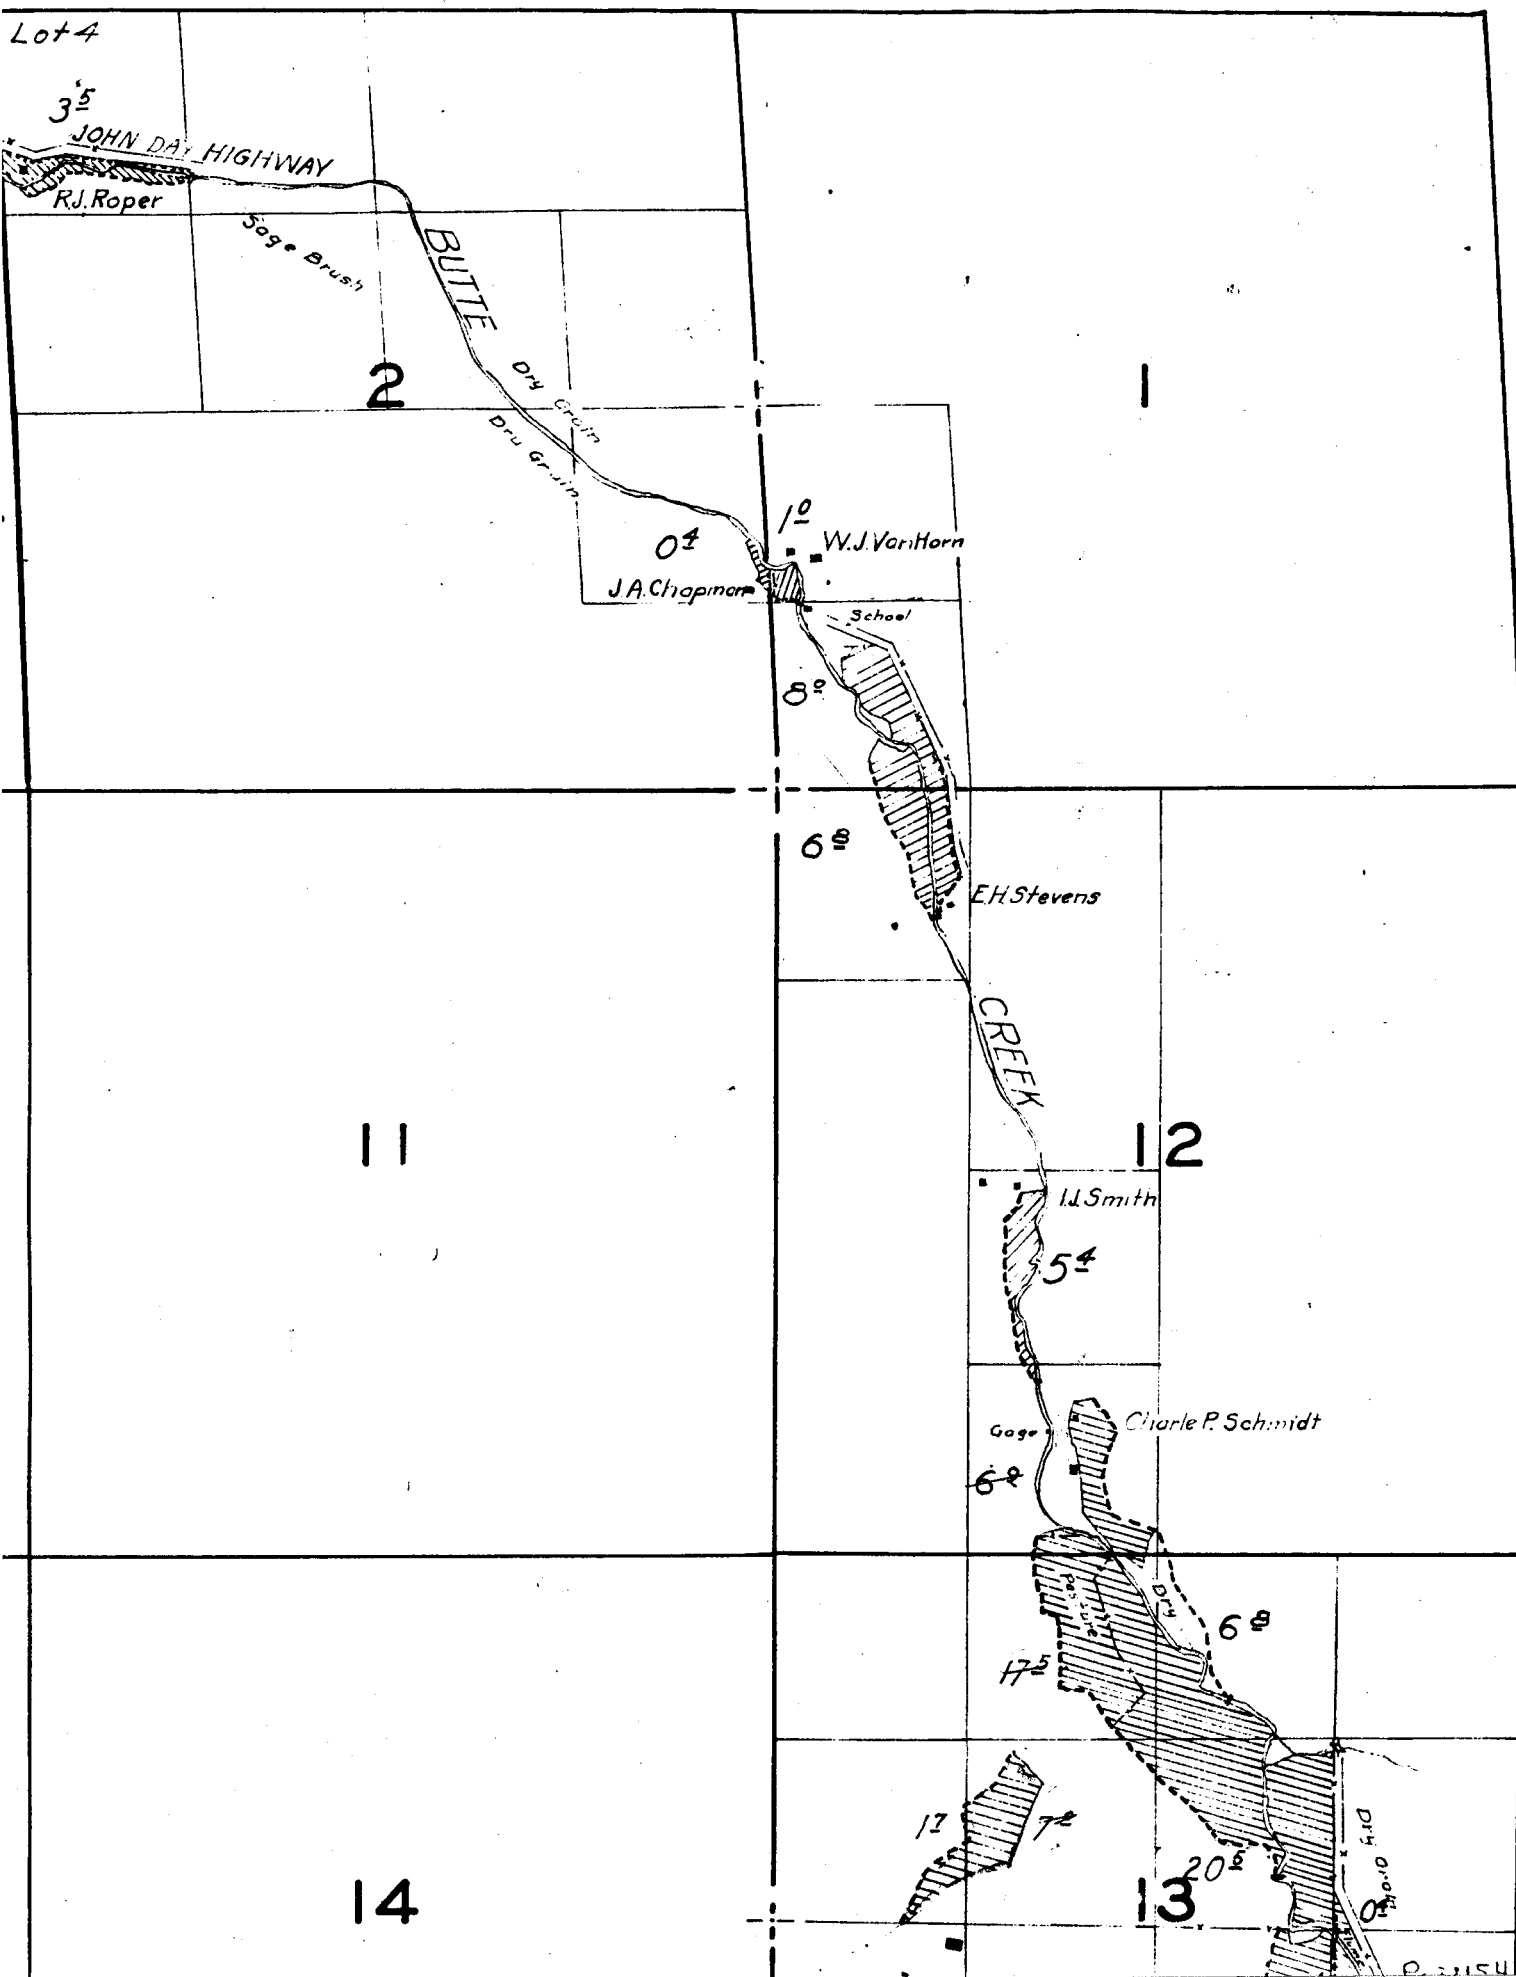

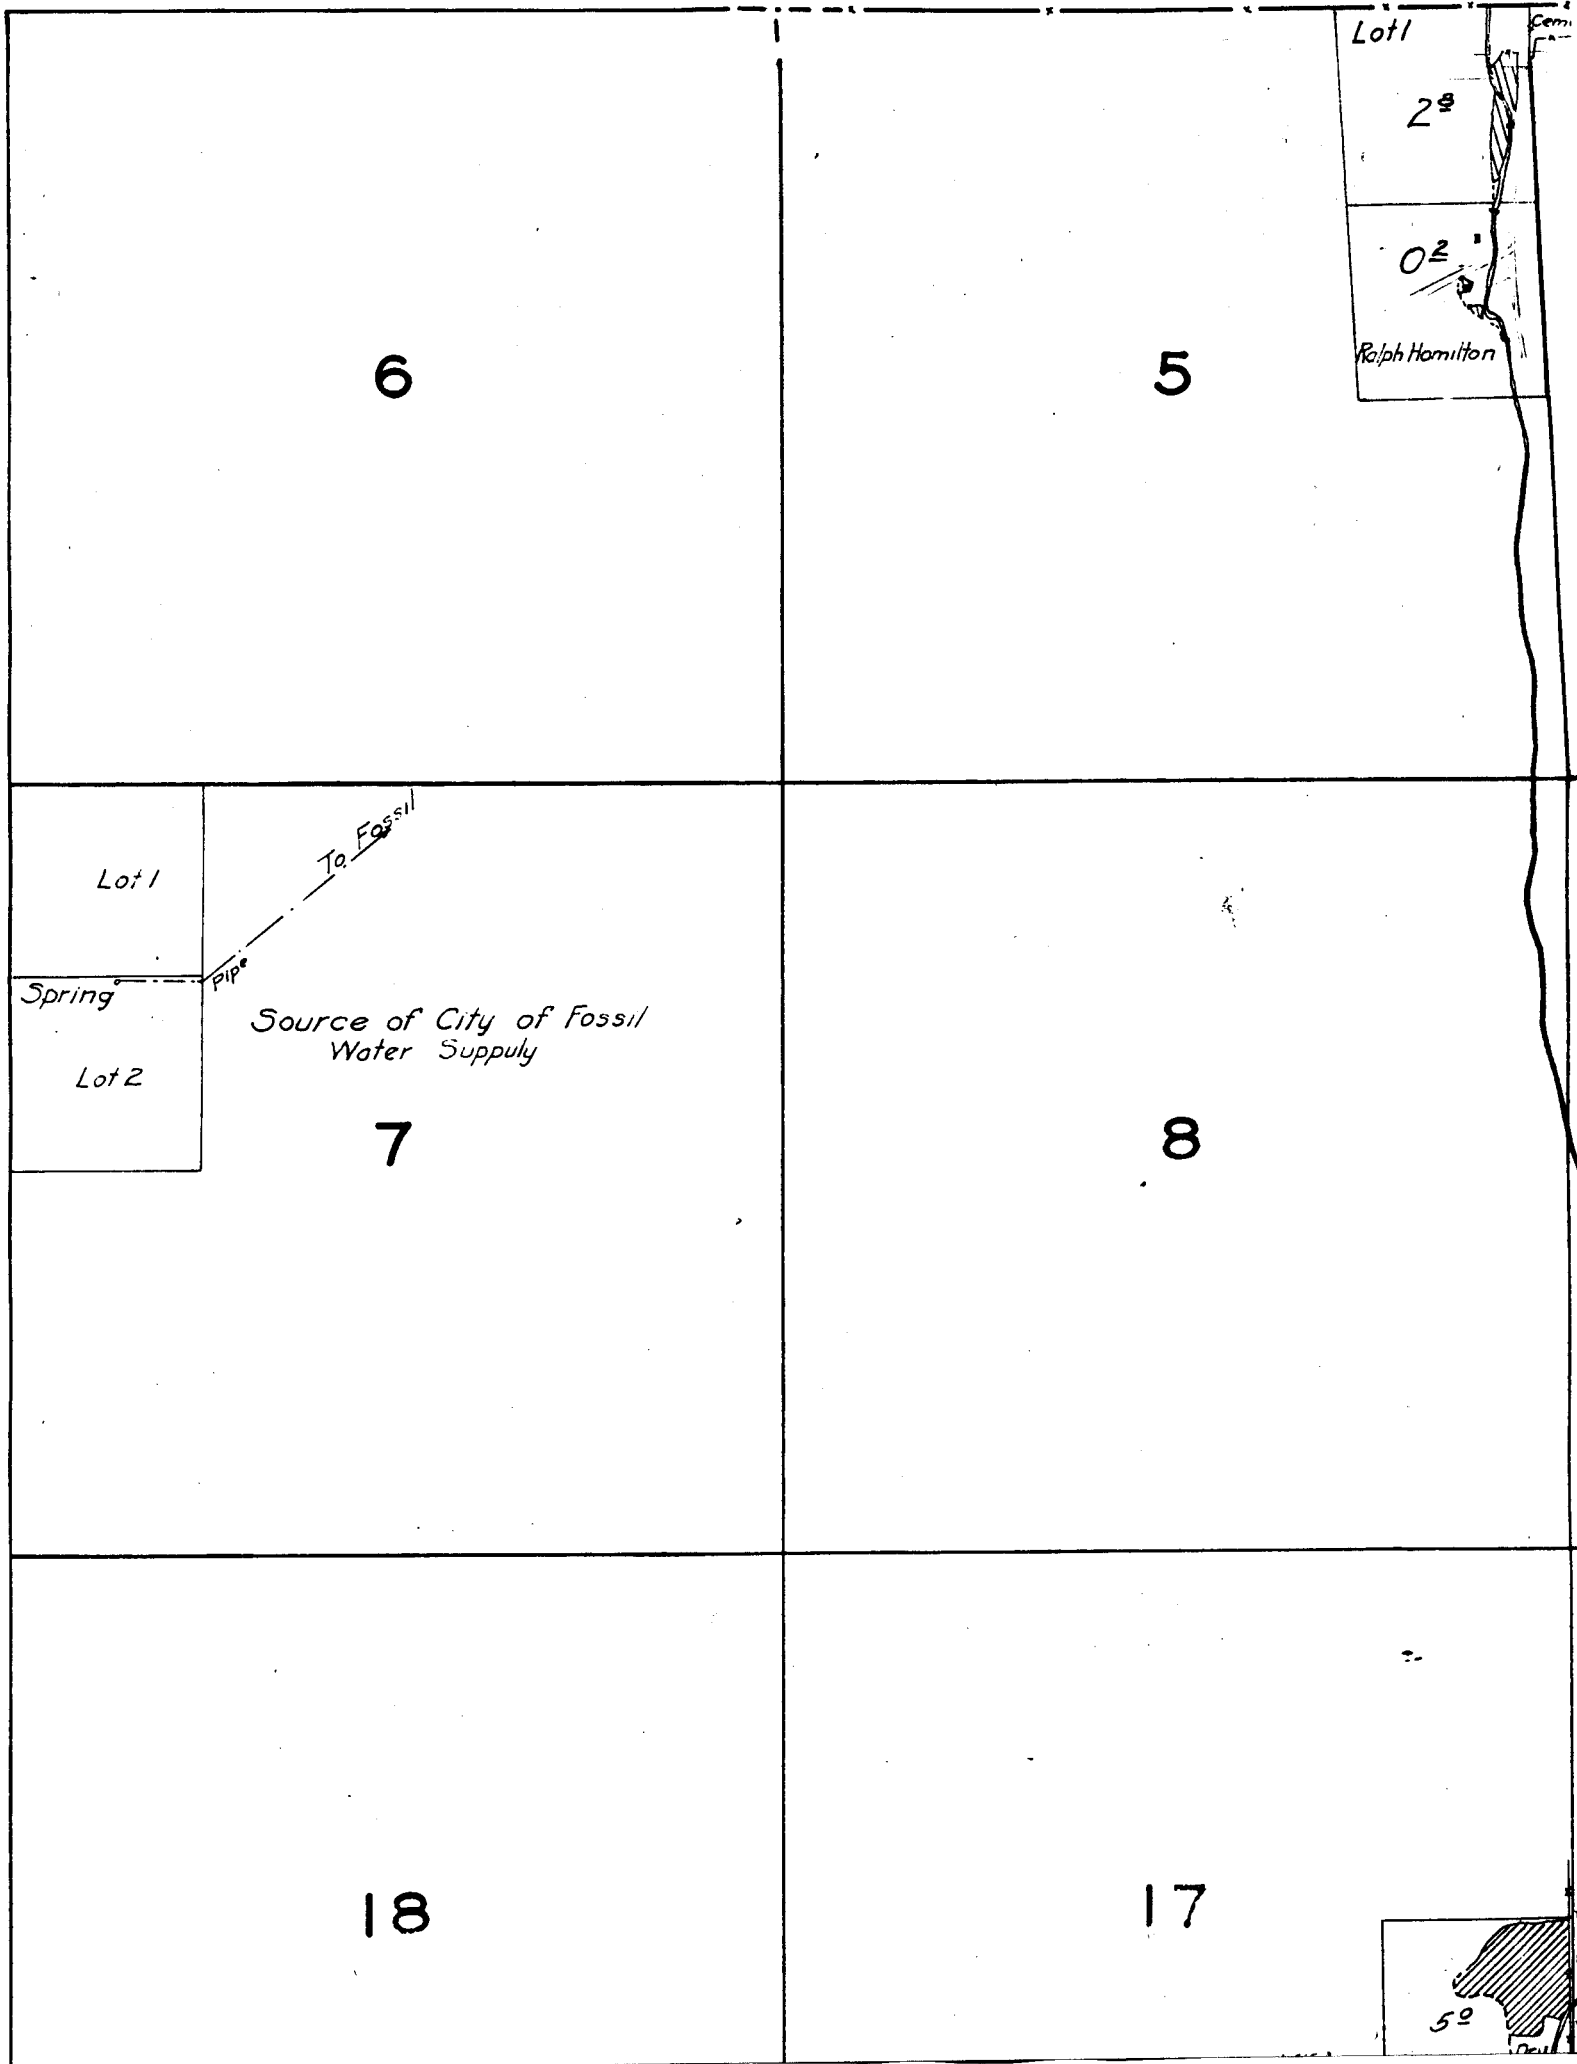






23

33

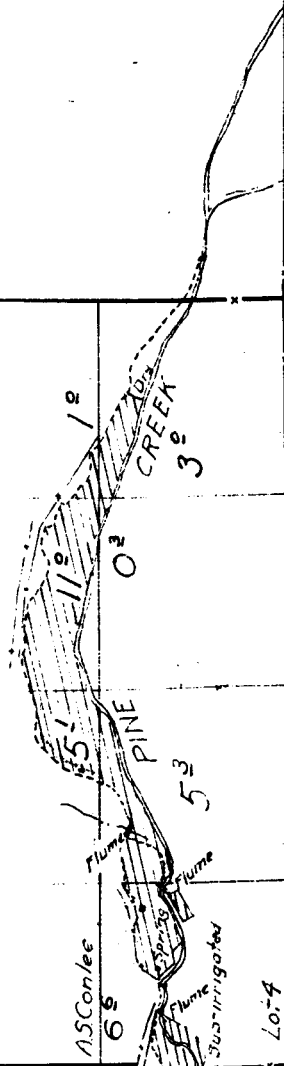

27


26

25

34

35

36

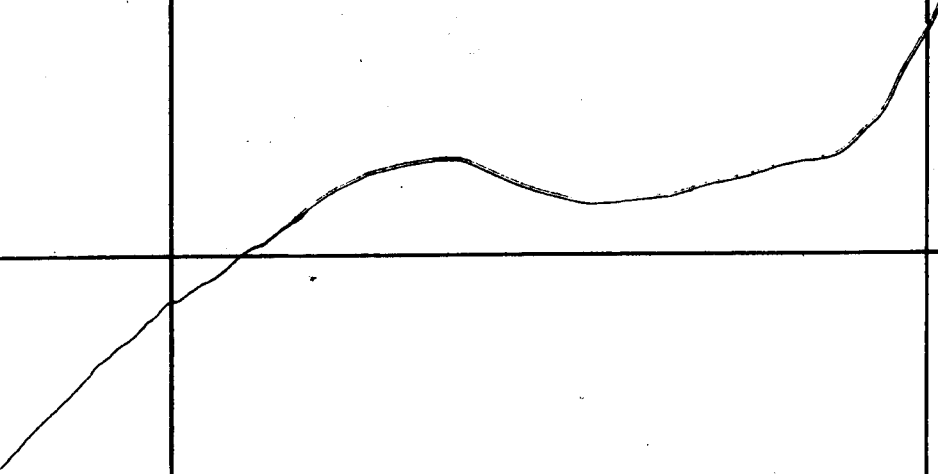

15


14

22

23

24

Location according
to Mr. Ball

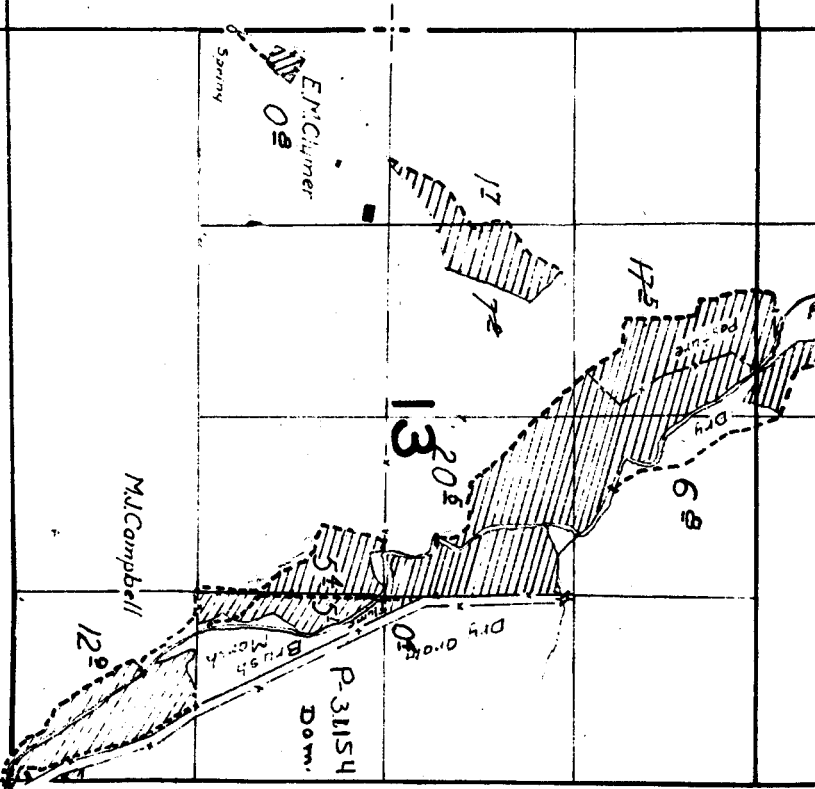


Note: Streams not in th.
irrigated lands sketched.

COTTONWOOD

16

17

18

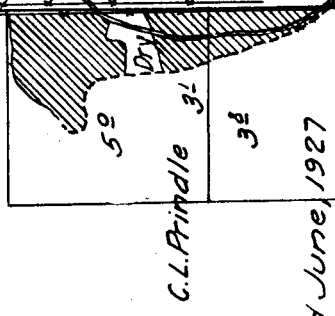

Surveyed June, 1927

CREK

21

20

19