

TOWNSHIP 8 S., RANGE 24 E.

	4	3	Surveyed.
1925	9	10	


50

15

22

16

21

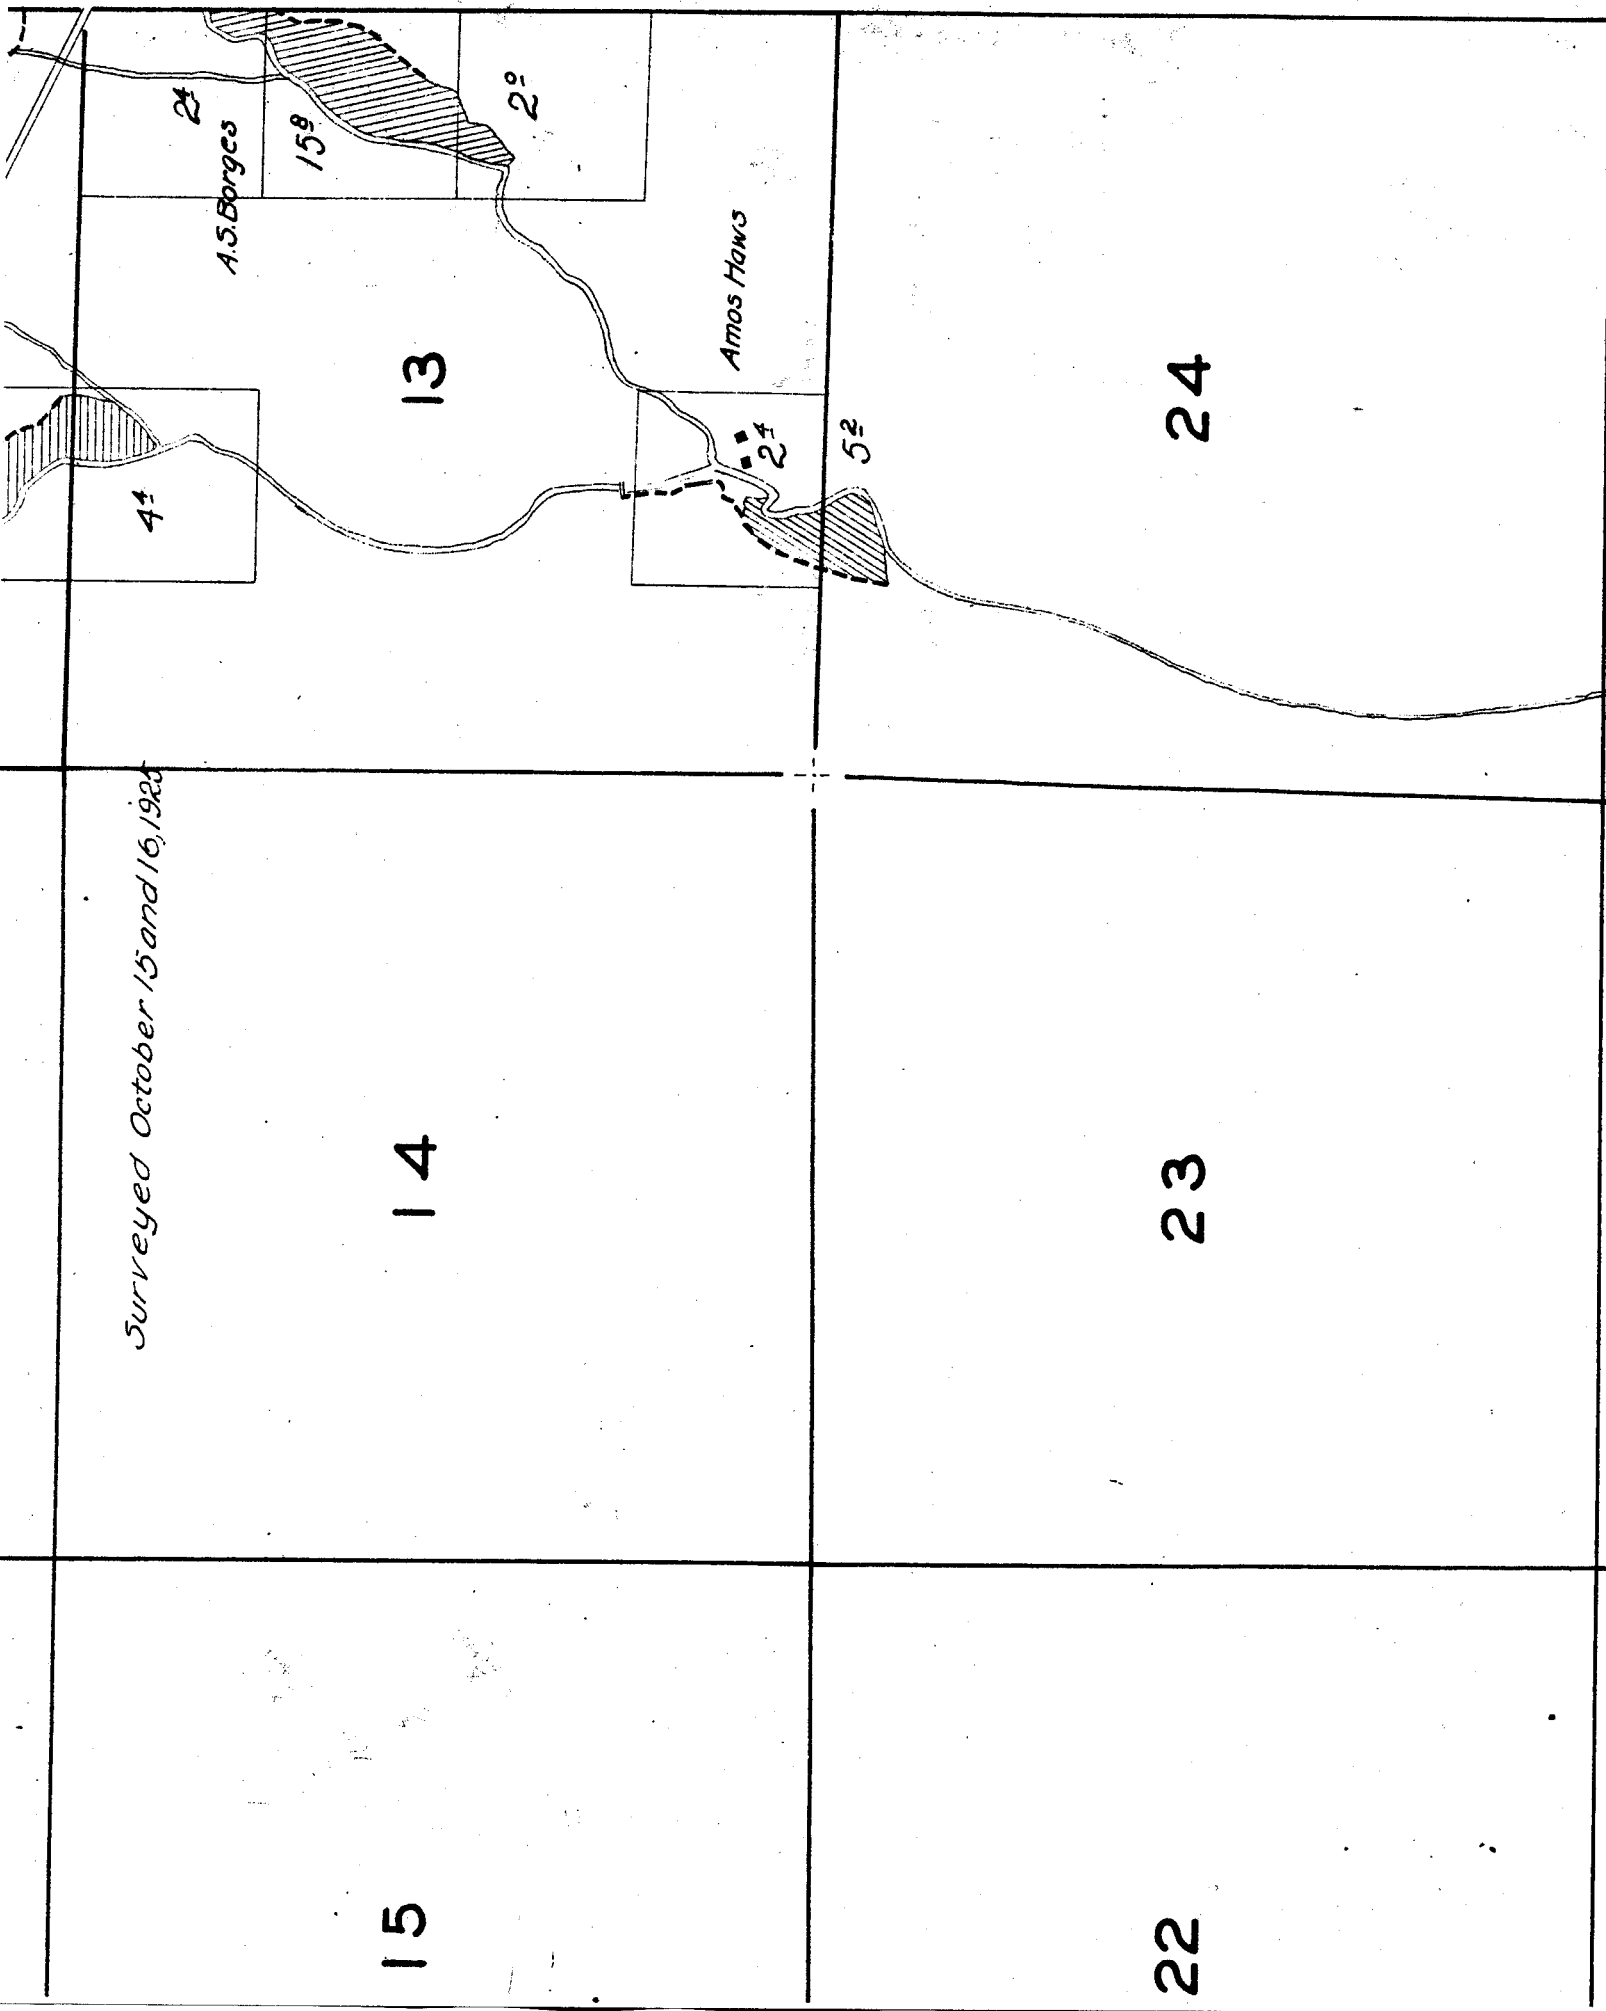


20

52

34

53

60
32

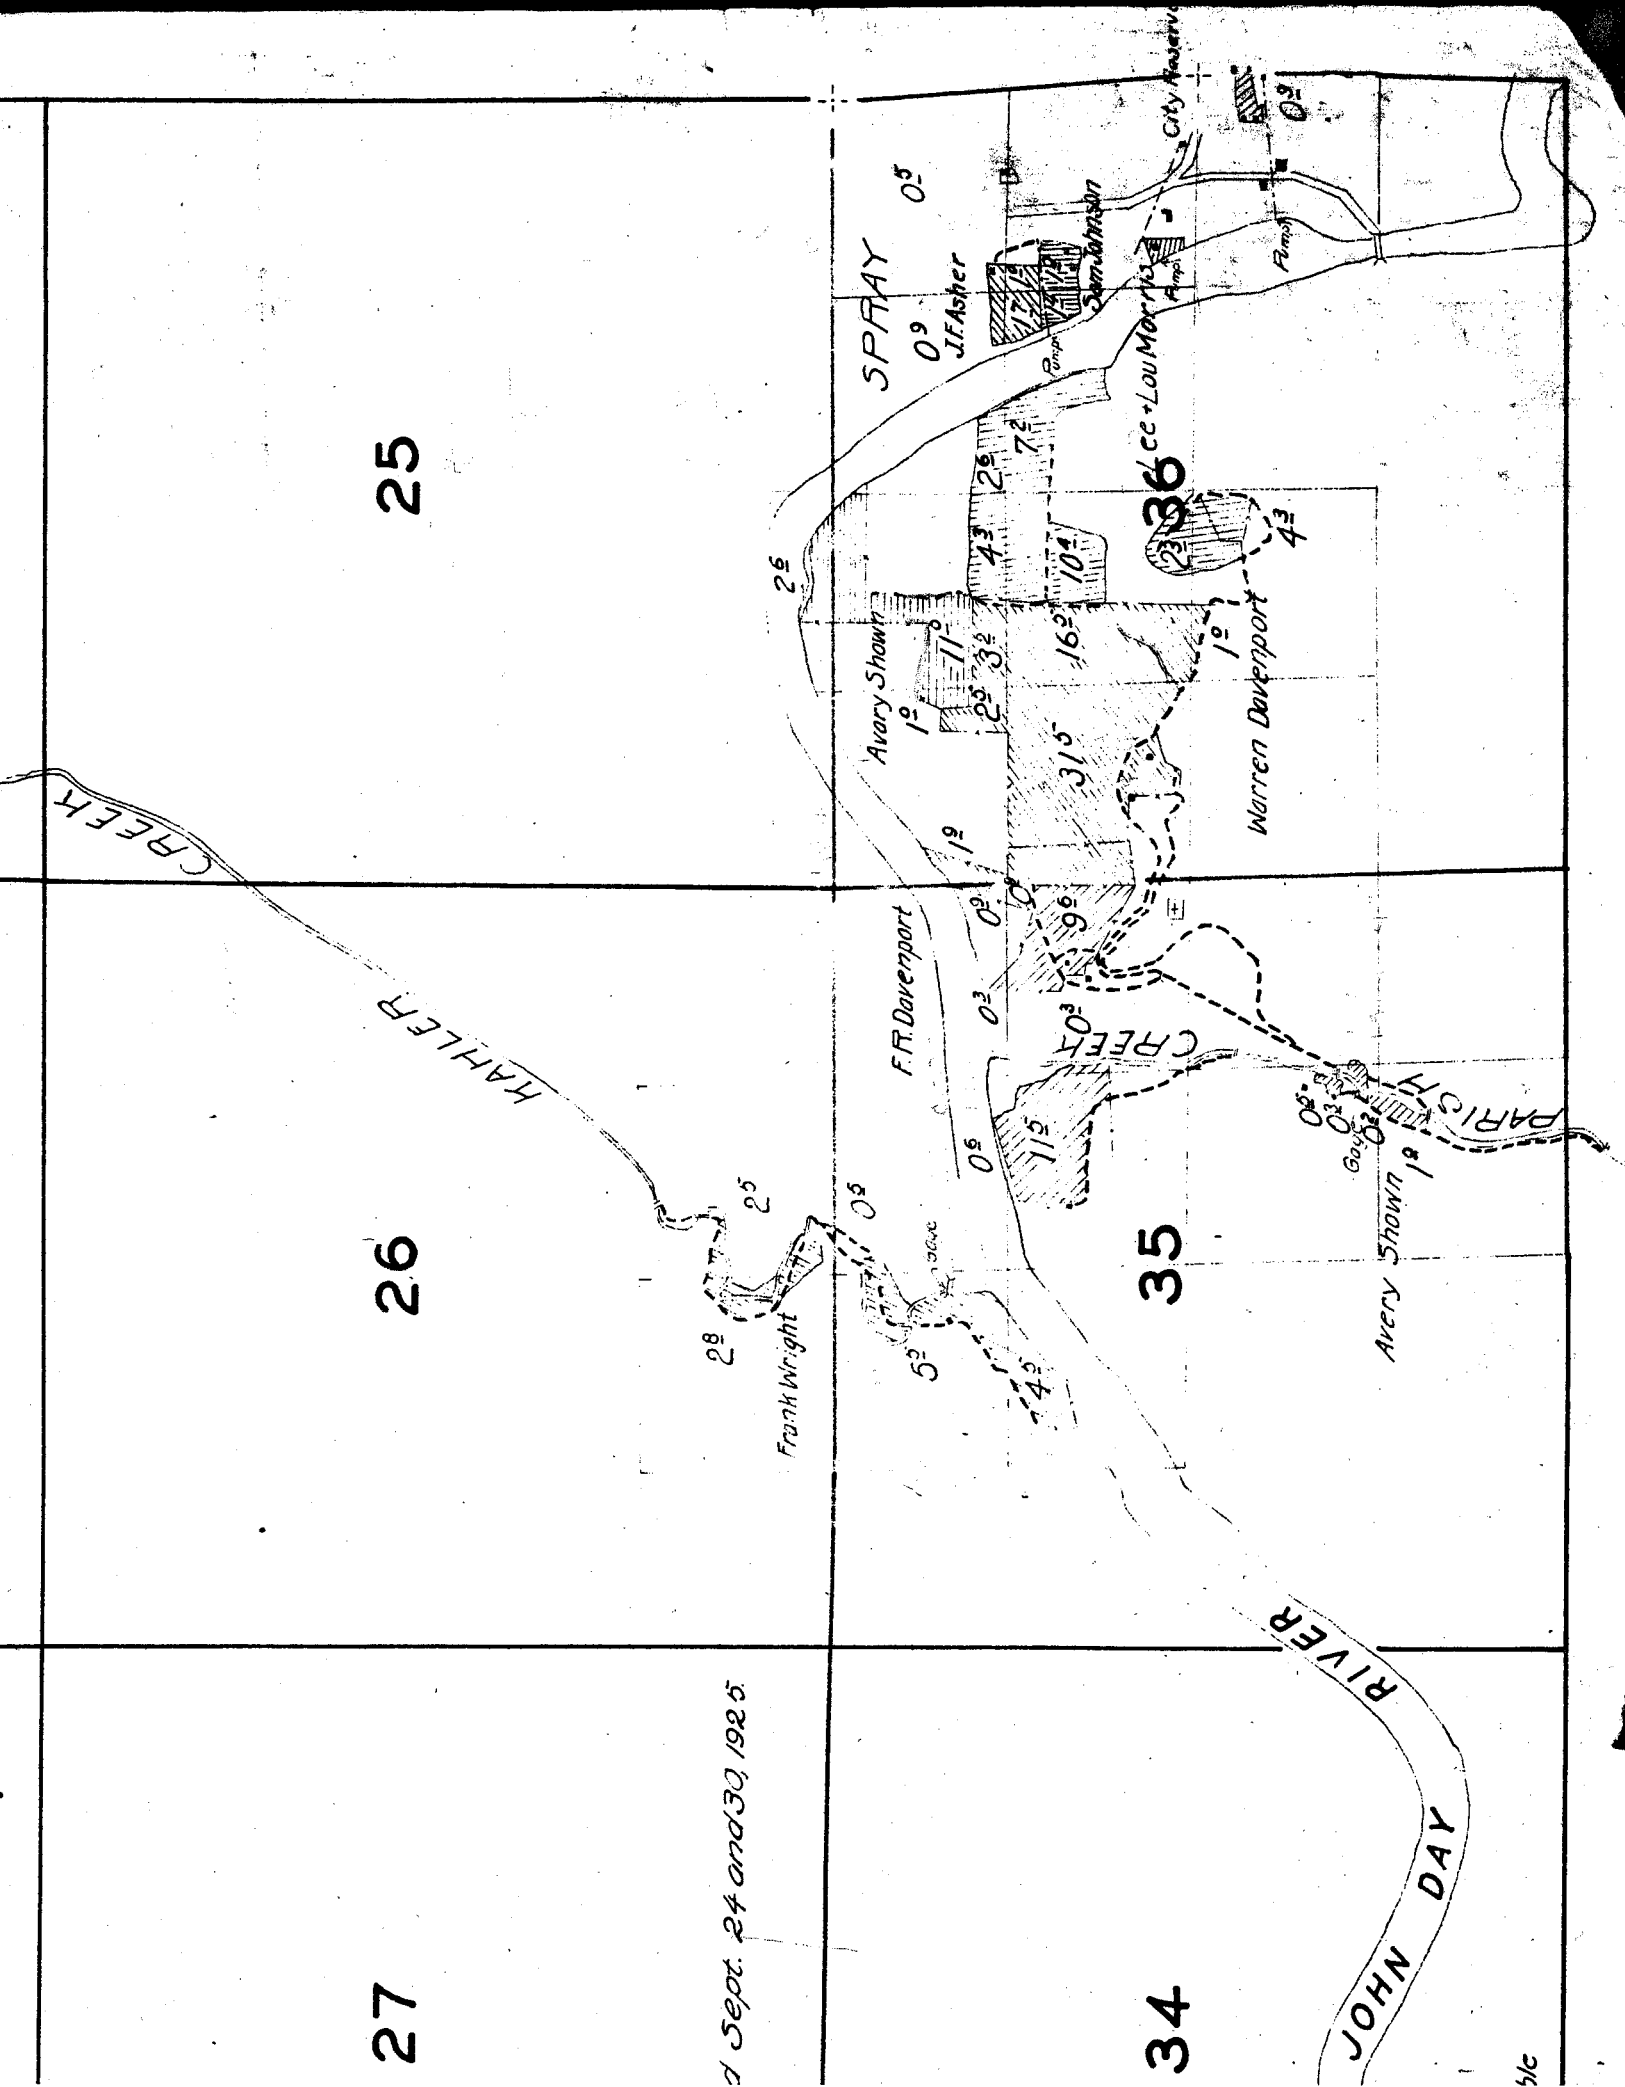

30

Note: Streams and Rivers except in the vicinity of irrigated land, sketched in approximate location.

29

28

31

MATHIS

Surveyed Oct 29, 1925

0-1

CANYON

Mrs Mary Adams

32

Spring

33

Baugh

18

17

16

19

20

21

Elmer McQuinn

Lot 4.


20'

3'

6

5

CREEK

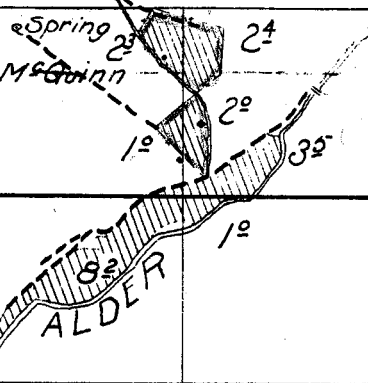

Mrs Elmer McQuinn

Lot 1.

Lot 2.

Lot 3.


Lot 4.

Surveyed October 16, 1925.

8

18

17

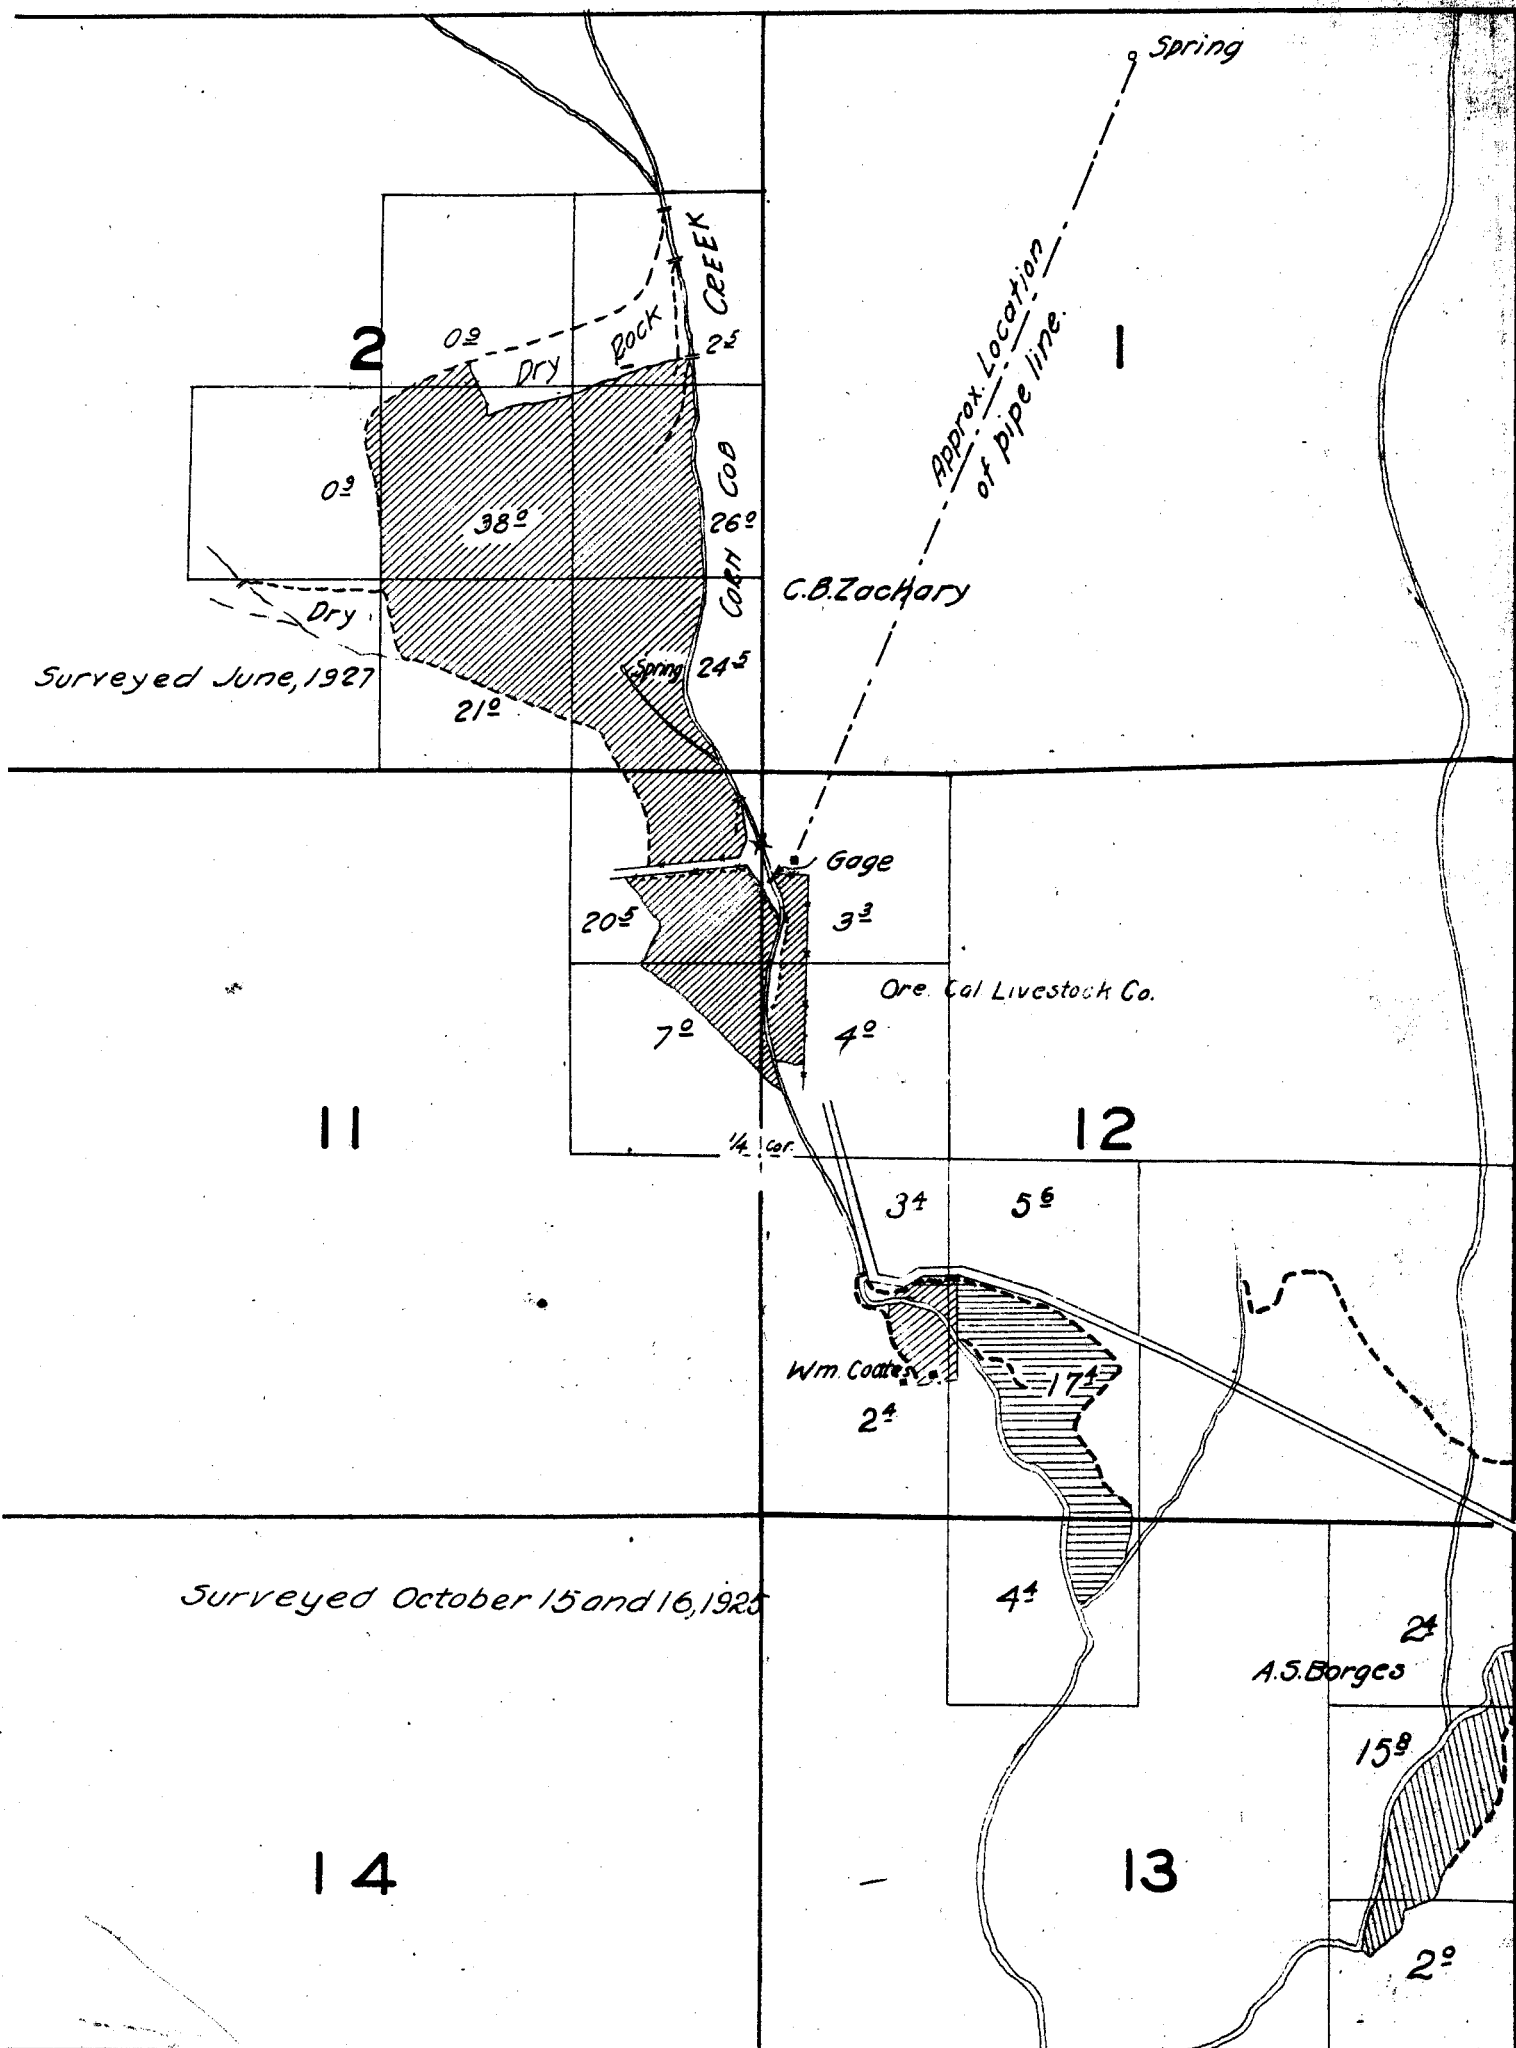

21

22

28

27

Surveyed Sept. 24 and 30, 1925

33

34

Baughn

0³

6²

pump

Snoble

JOHN DAY RIVER