

21

22

7°

4°

3°

Spring

L.H. Donavon

112
CREEK

12

17°

4°

Bob Wright

HAYSTACK

J.F. Asher

28

27

Spring

17°

Surveyed Sept. 19 to 23, 1926

Steiner

5°

C.W. Walls

1°

A.E. Cress

12

33

34

40°

Now C-35285

27°

02

12°

21°

3°

Pump

P.H. Jenkins

2

1

11

12

14

13

30

29

28

Spring

J.F. Asher

HAYSTACK

Bob Wray Sr.

17

18

Surveyed Se

31

Surveyed Sept. 29, 1925














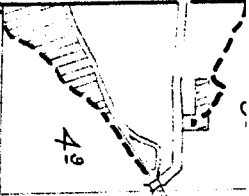

AS Borges

18

17


16

19

20

21

Note: Location of streams and roads, except in the vicinity of irrigated land, is sketched in approximate location.

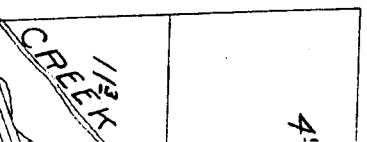

Surveyed Sept. 29, 1925.

Palm Cr.

27

26

25

34

35

36

15

14

13

22

23

24

IVER CREEK

02

62



17

RI Corner

05



6

5

7

13

Gage 8⁶

E. R. Moore

03

8

07


A. S. Borges

4⁹

18

17

TOWNSHIP 8 S., RANGE 25 E.

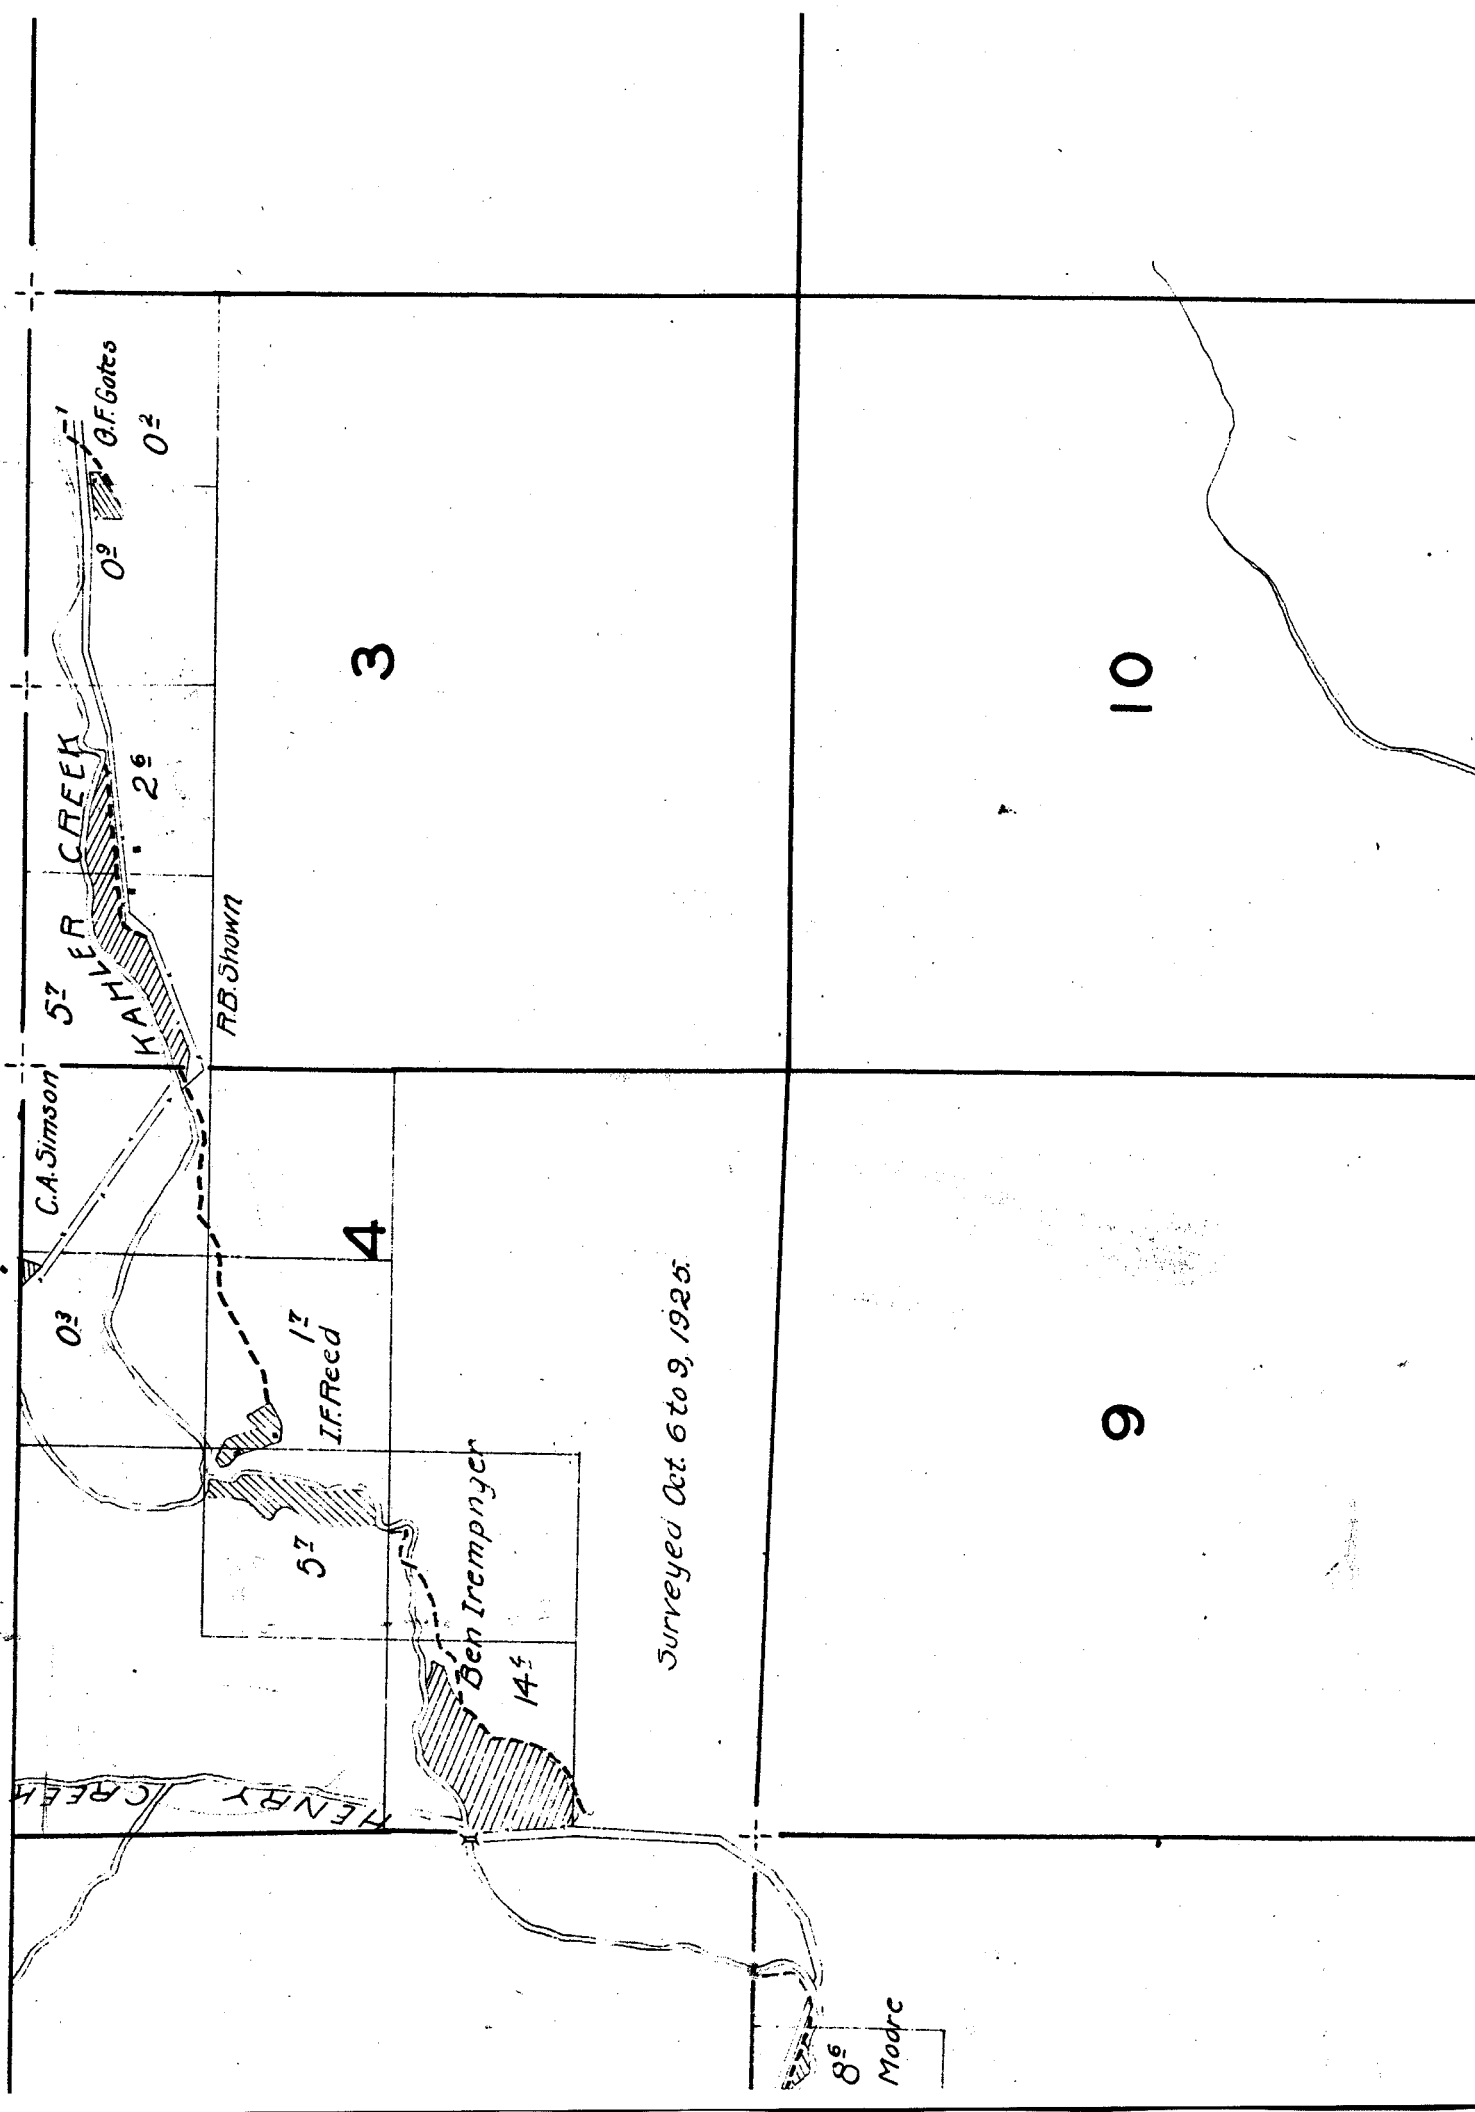

15

22

16

21

L.H. Donovan

4° 35' Spring

7°

1/2

1 1/2 K

as, except
nd, is
ation.