

A.S. Conlee

Lot 2

14

6

5

*Note: Section line bearings
and distances taken from
U.S. Township Plats.*

7

8

18

17

21

22


28

27

33

34

W
irr
loc

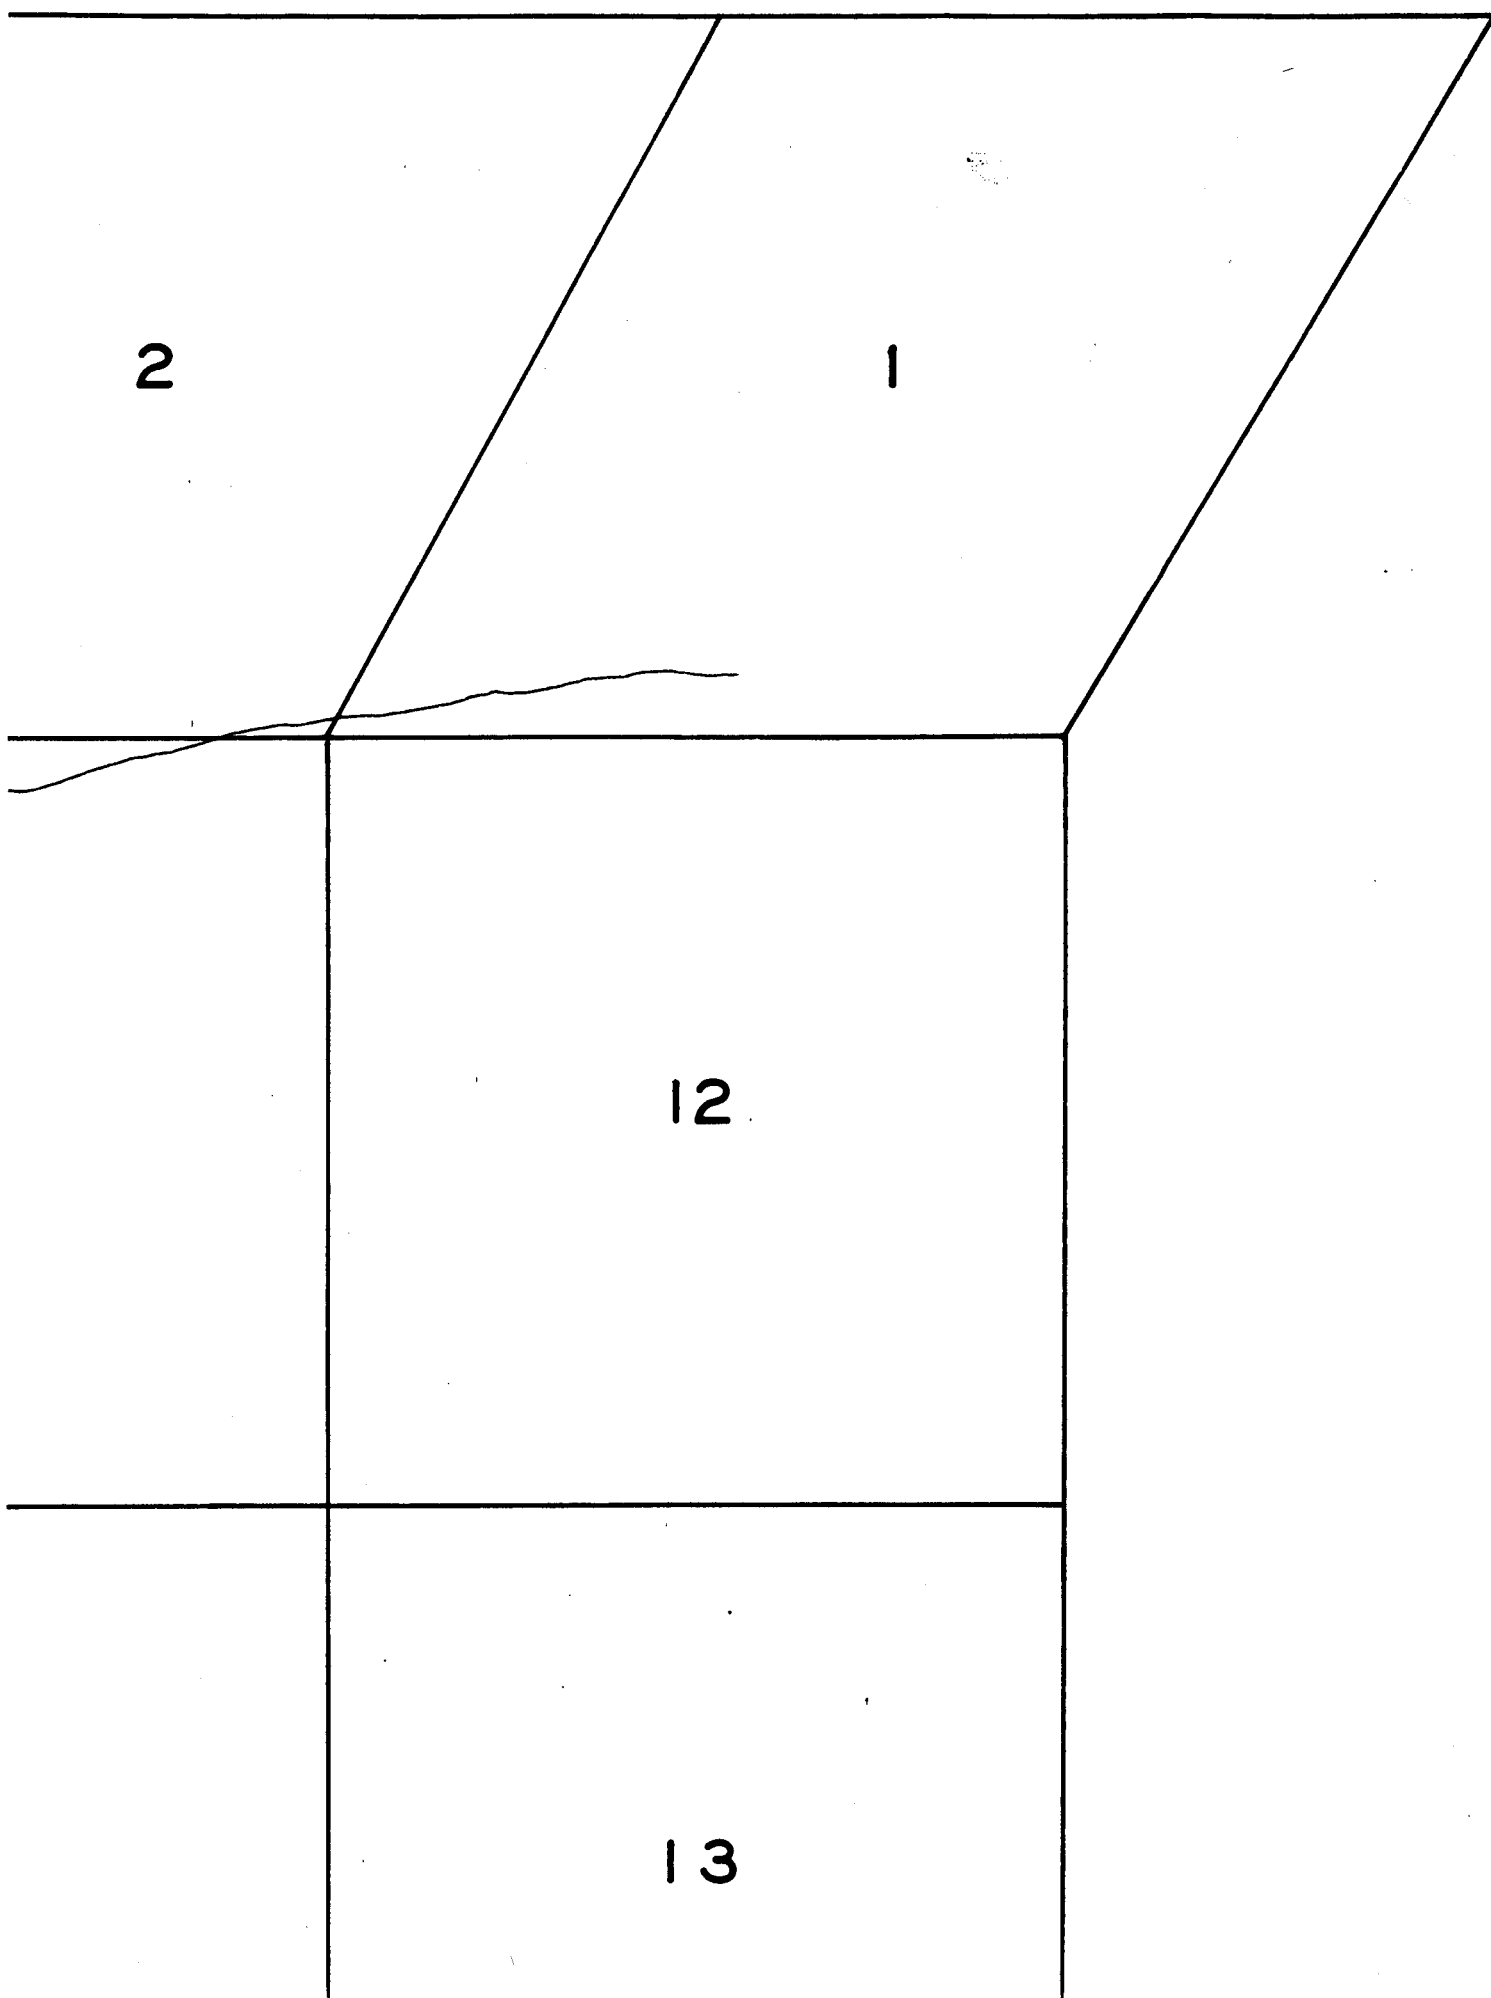

27

26

25

Note: Streams, except in the vicinity of irrigated lands, are sketched in approximate location.

34

35

36

ROWE

15

14

13

22

23

24

Surveyed Sept. 5, 1926


Tom Huntington

Spring
0 2
Spring

Chas. Palmer
Palmer Bros.

Lot 4

CREEK

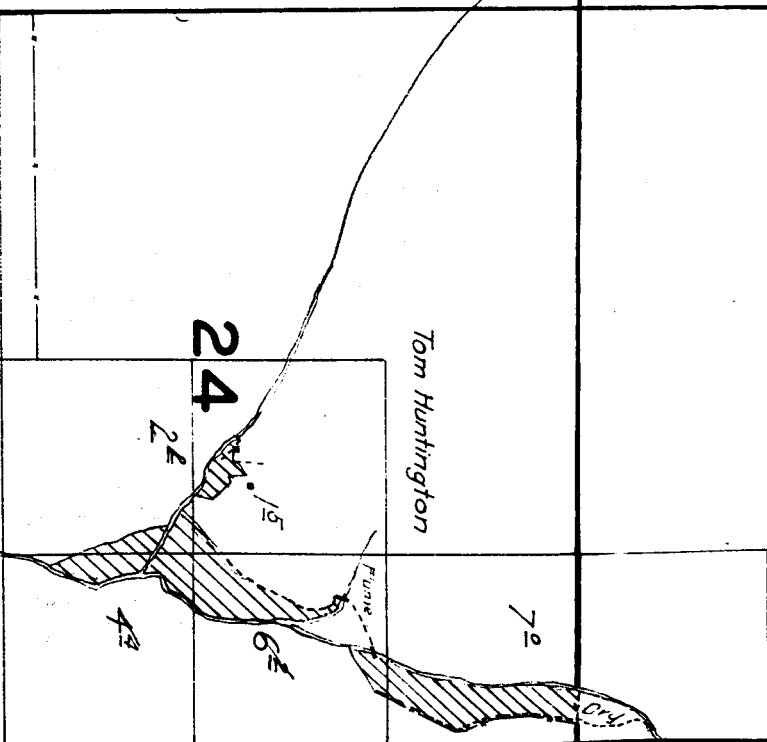

16

21

17

20

18

19

30

29

28

31

32

33

16

15

14

21

22

23

TOWNSHIP 8 S., RANGE. 21 E.

