

21

22

2^d
FW Ball

*Note: Location according
to Mr. Ball.*


School

28

27

33

34

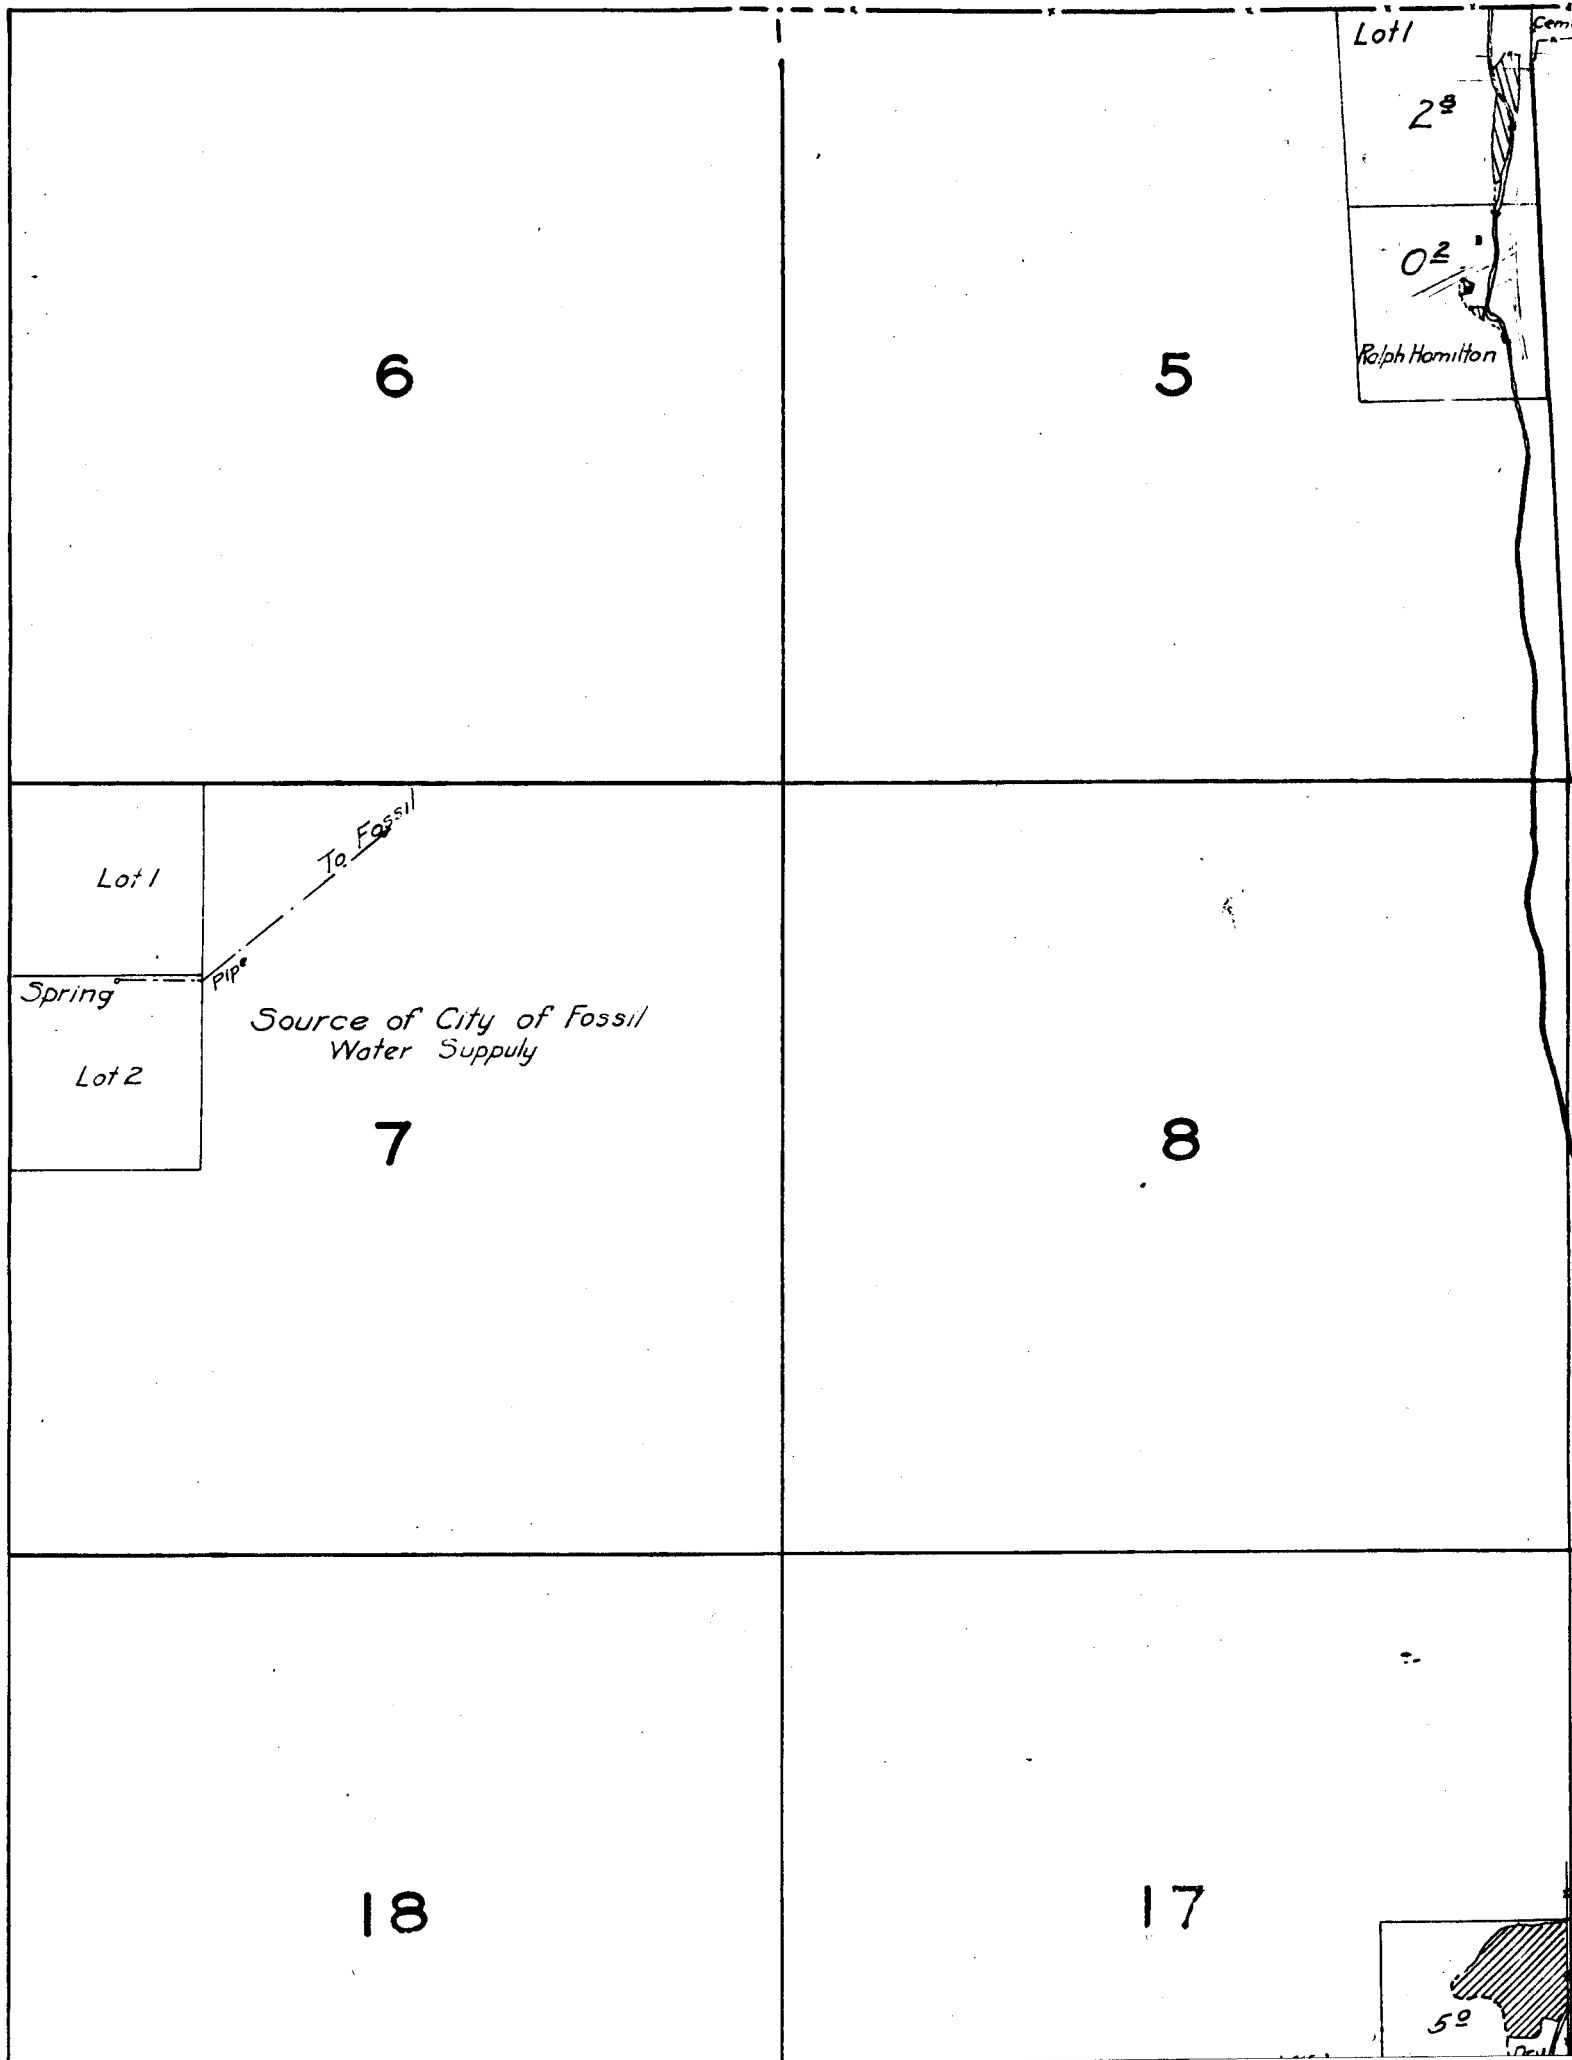


Note: Streams not in the vicinity of
irrigated lands sketched in approximate location.

7

16

15

COTTONWOOD

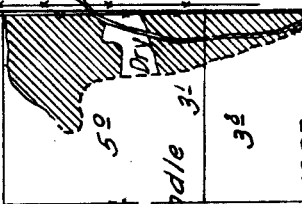

C.L. Prindle

31

Surveyed June, 1927

CREEK


0

21

22

Note: Location according
to Mr. Ball
School
FWBall
2°

Note: Streams not in the
irrigated lands sketched.

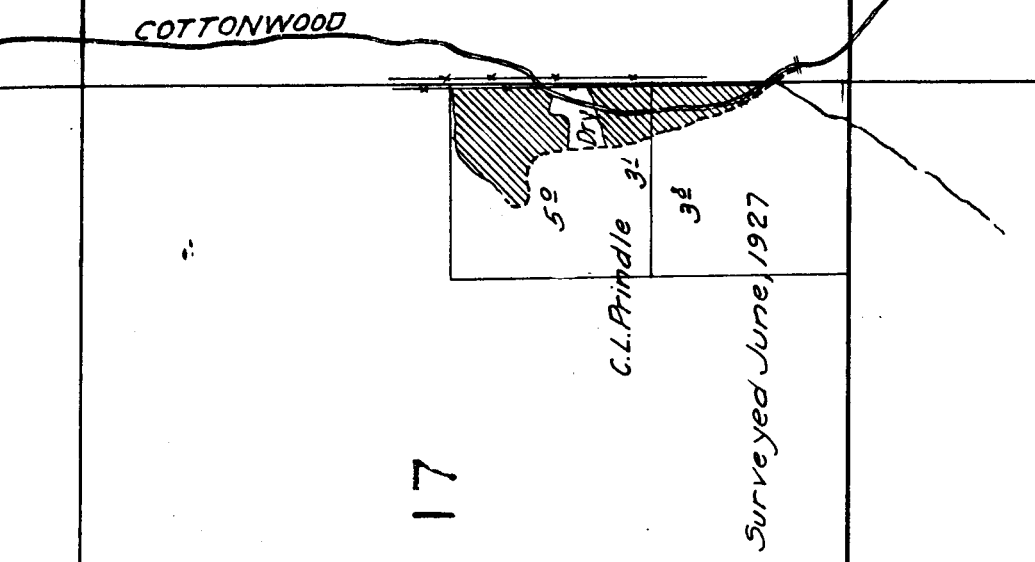

18

17

16

19

20

21

28


29


30

33

32

31

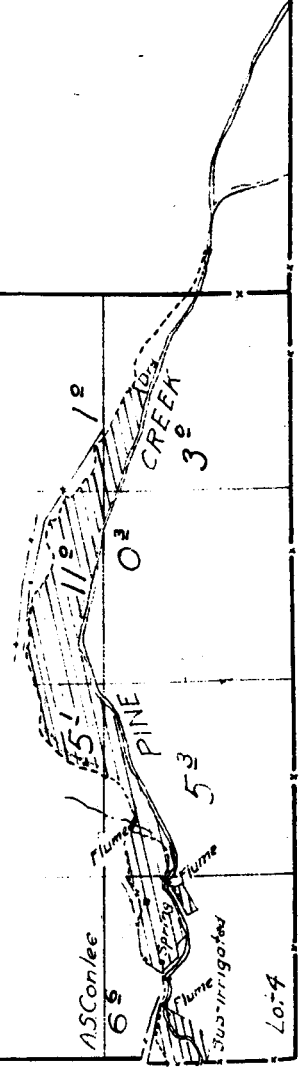

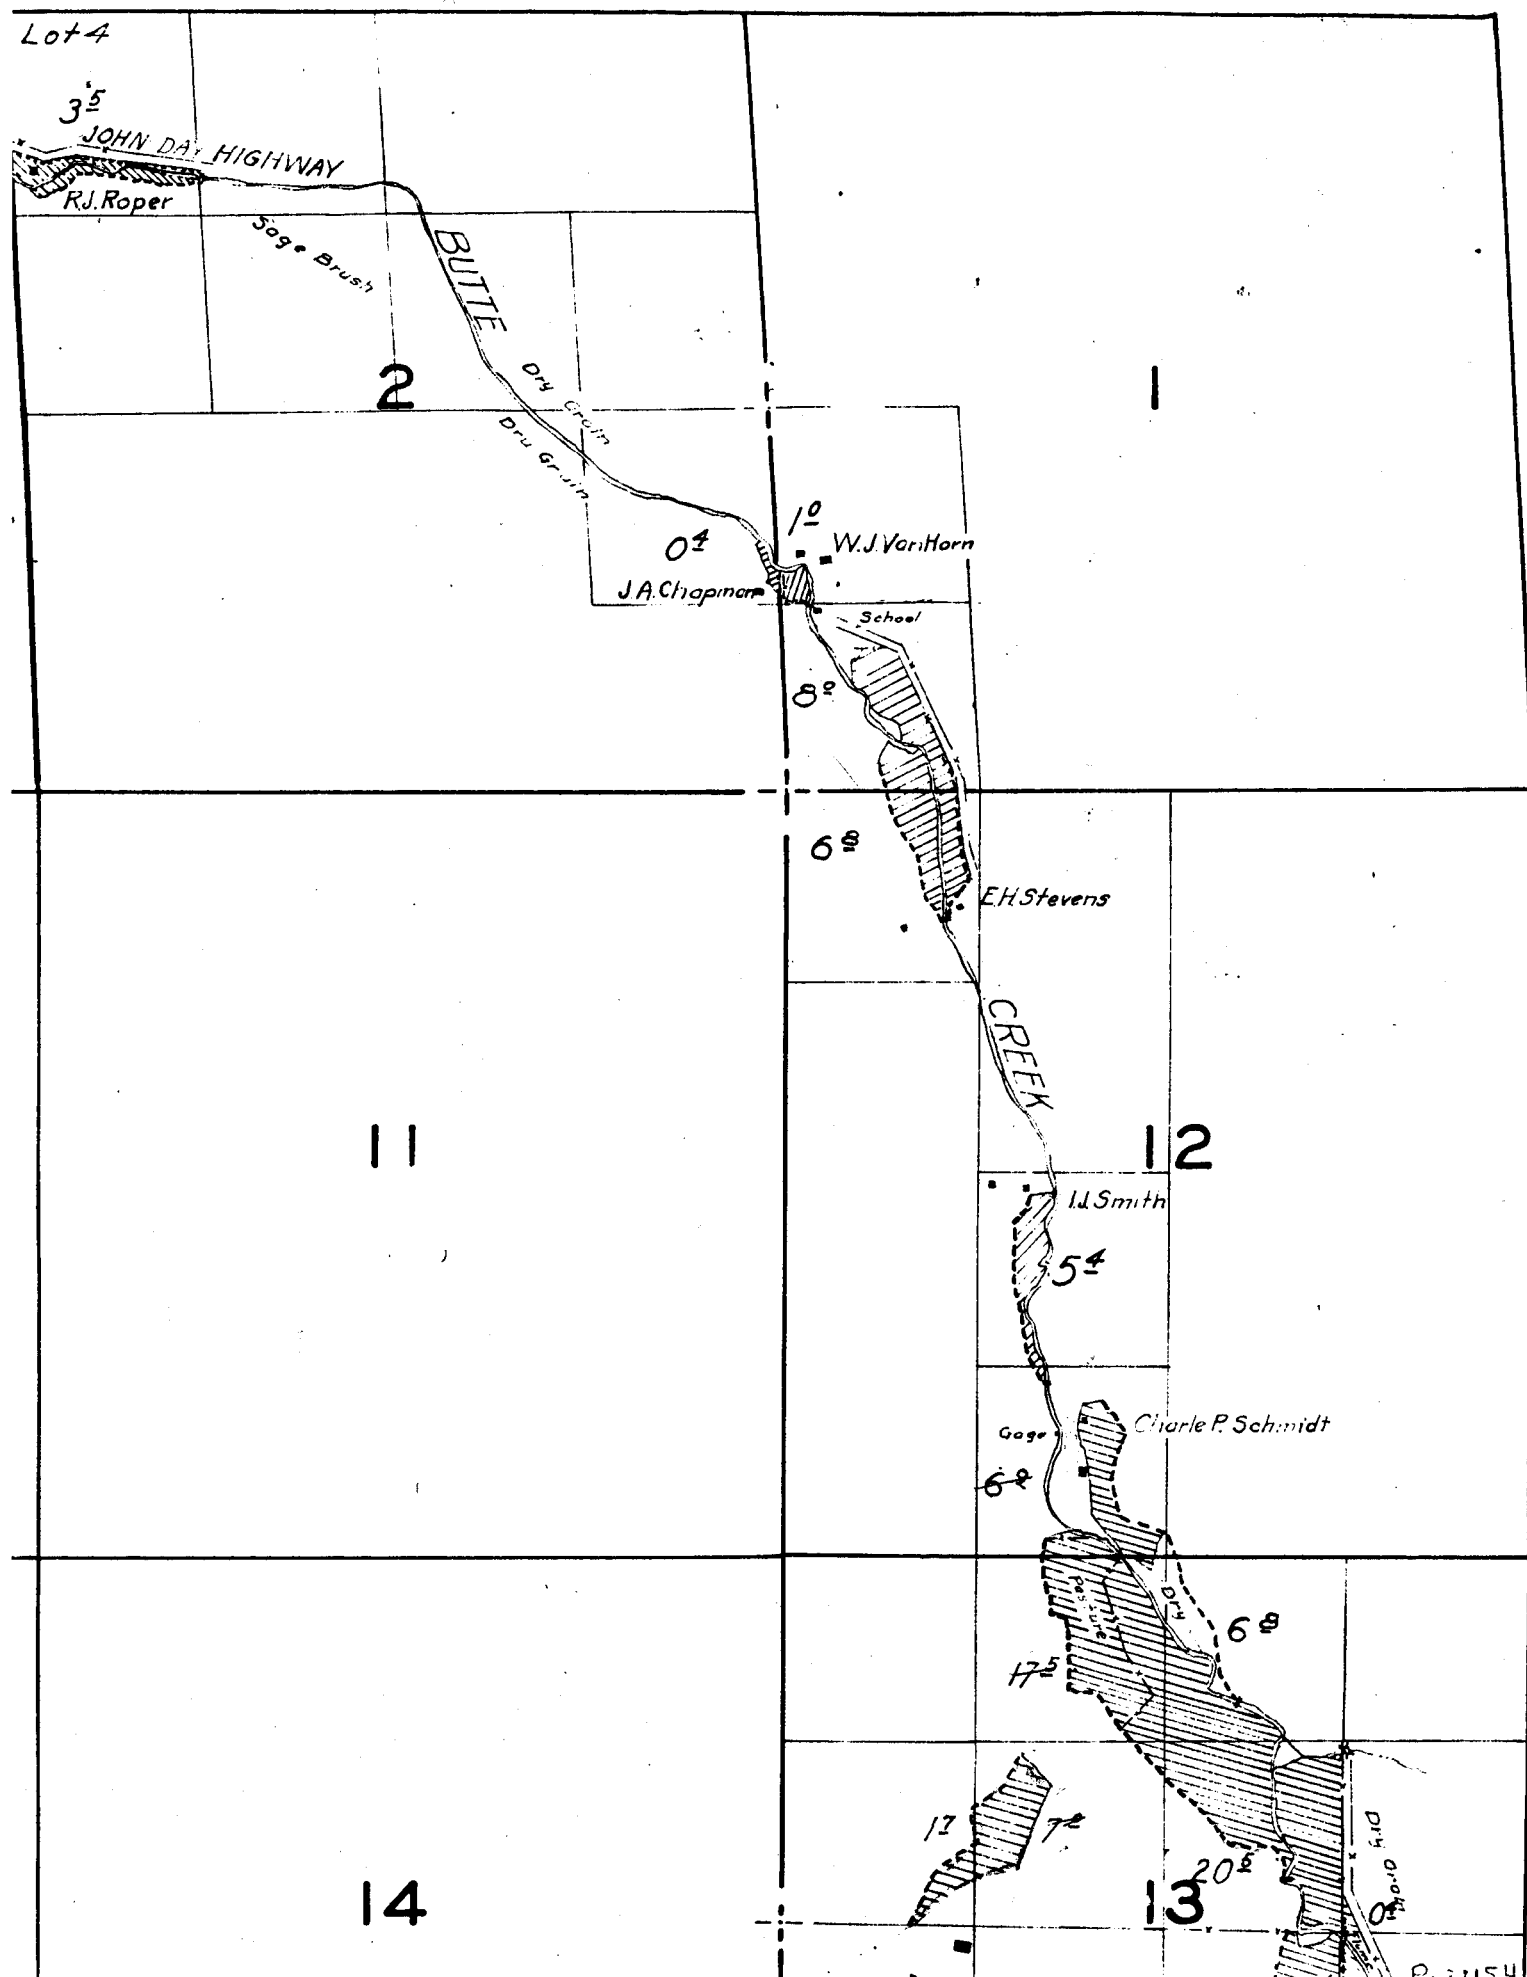

27


26

25

34

35

36

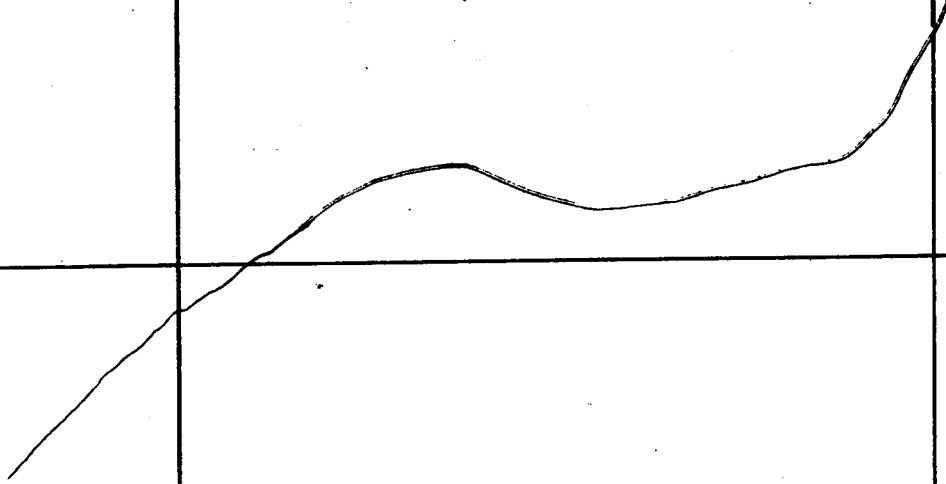

15

14

22

23

24

Location recording
Mt. Ball

