

TOWNSHIP 5 S., RANGE 20 E.

4

3

9

10

16

15

15


14

13

22

23

24

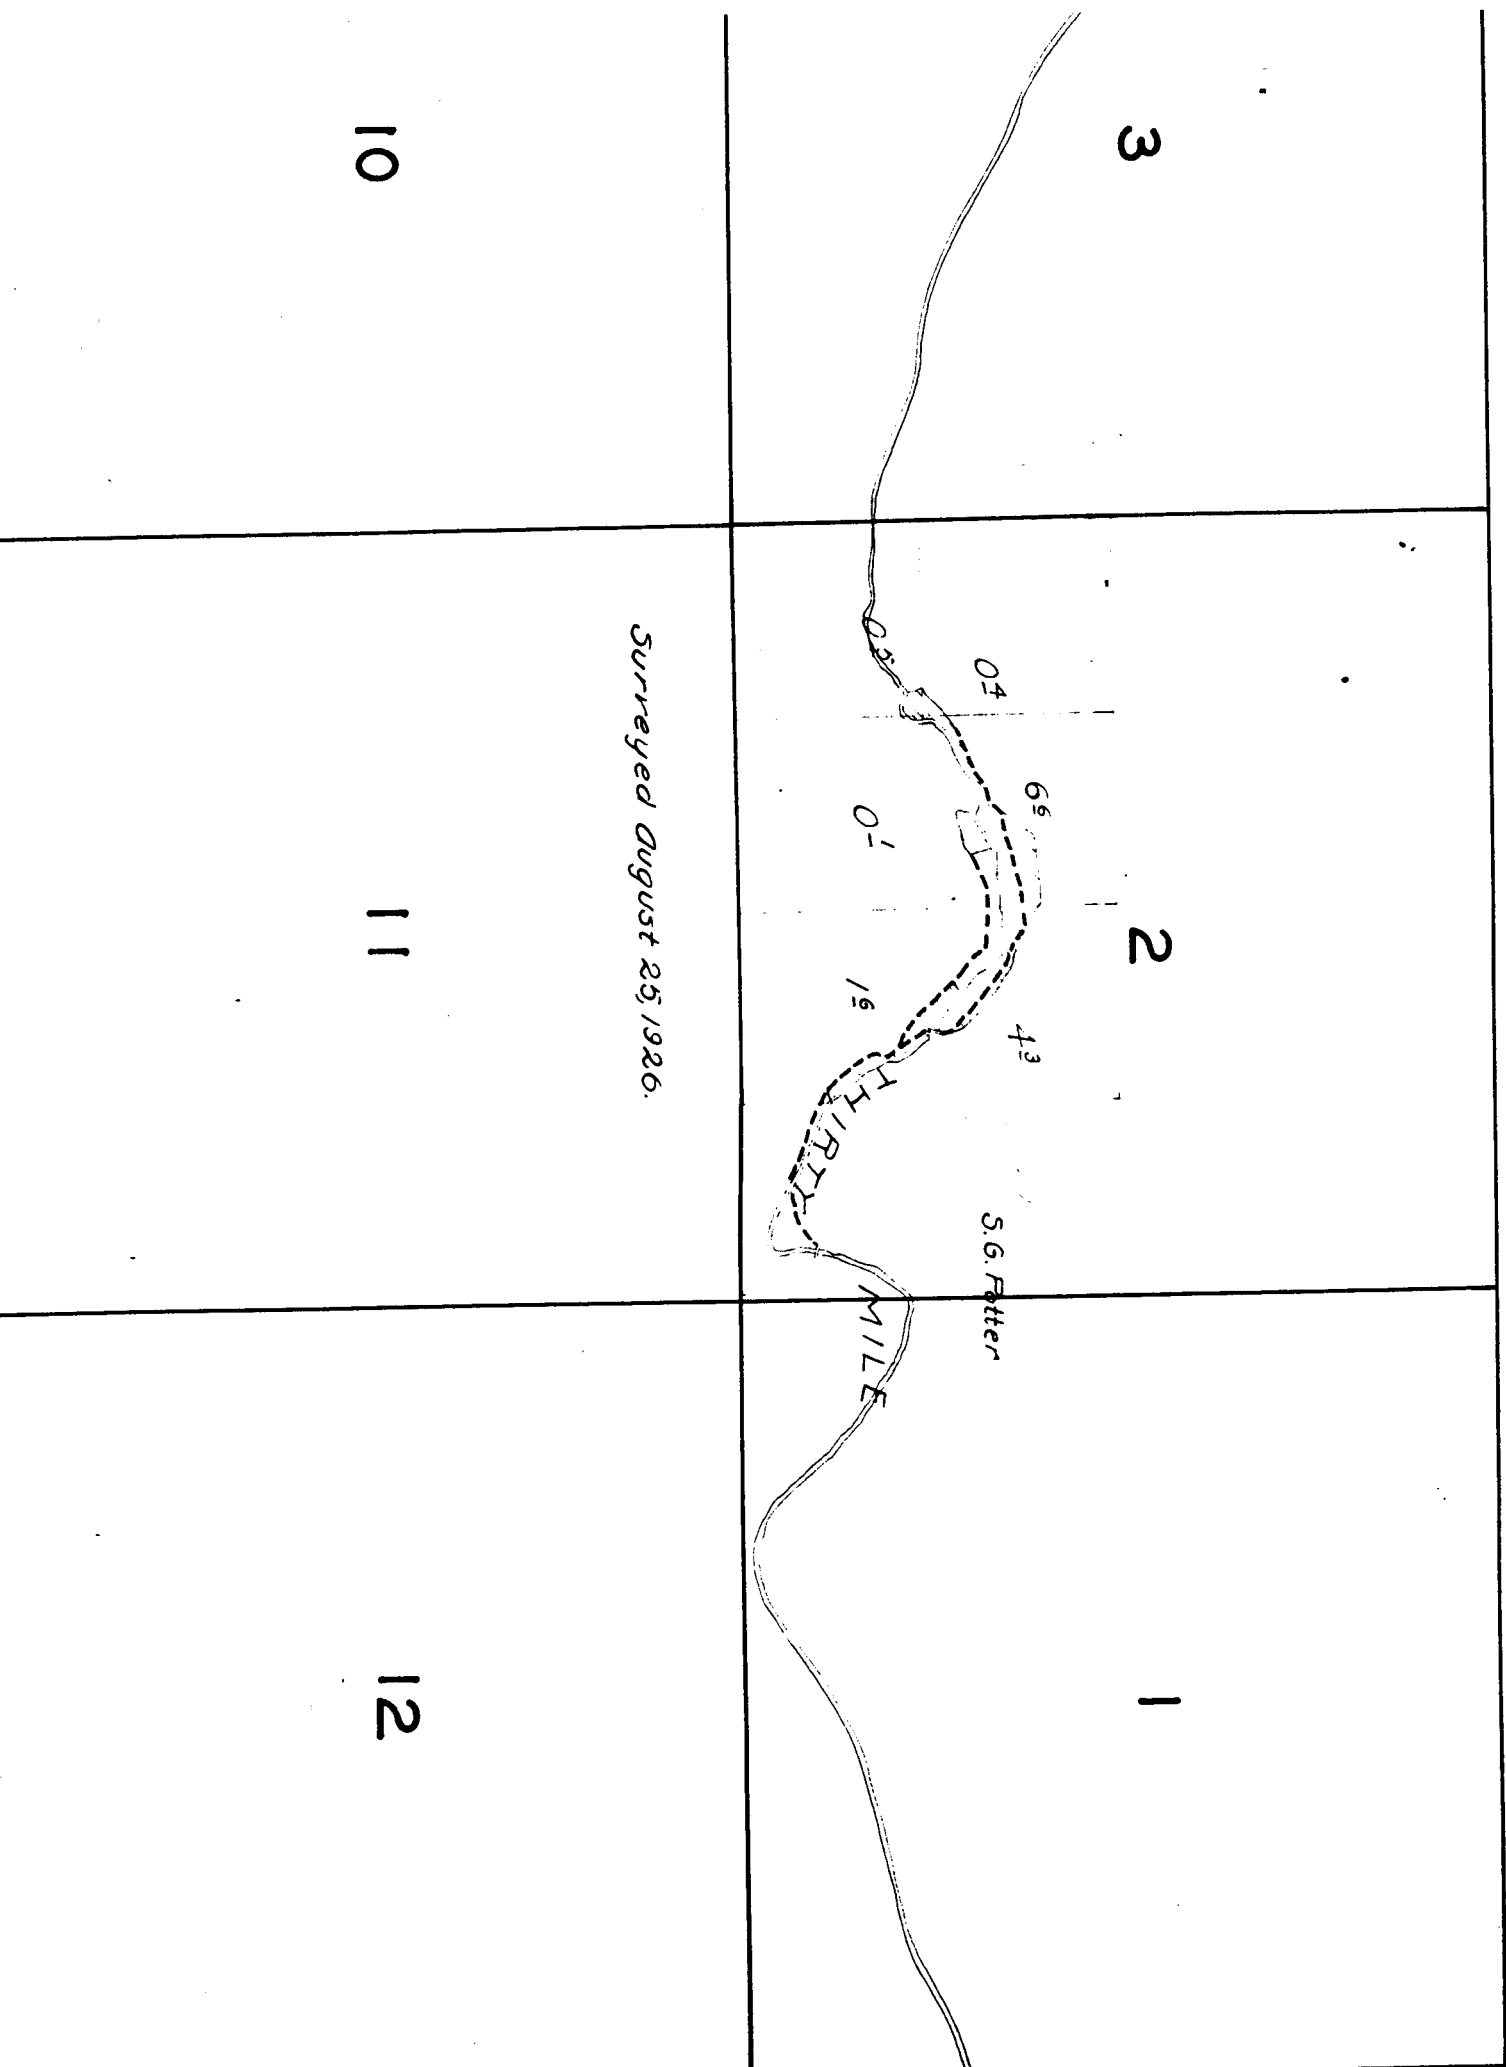

19

20

*Note: Streams, except in the vicinity of
irrigated land, are sketched in
approximate location.*

30

29

31

32

23

24

26

25

35

36

7

16

15

0

21

22

to the vicinity of
etched in
on.

27

34

28

33

18

17

16

19

20

21

*Note: Streams, except in the vicinity of
irrigated land are sketched in
approximate location.*

TOWNSHIP

6

5

4

7

8

9