

28

Surveyed May 2, 3, and 4

29

Note:  
Streams and roads, except in the vicinity of irrigated land, are sketched in approximate location.

33

31

08

C. Schott

12

20

12

C.E. Cripe

12

19

15

11

7

Sage & Rock

44

02

C.E. Cripe

02

32

72

34

Flume

E.L. Howland

04

School

36

04

ing

16


18

18

21

20

19

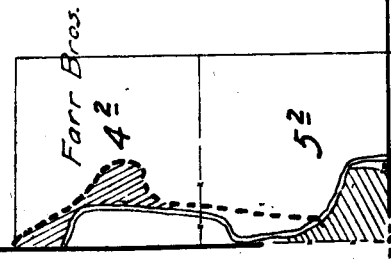

18

16

15

20

21

22

TOWNSHIP 1 S. RANGE 22 E.

5

4

3

8

9

10

	15	14	13
	22	23	24

21

22

28

27

*Surveyed May 2, 3, and 4, 1925.*

33

34

6

5

7

8

18

18

2

1

11

12

14

13



27

26

25

34

35

36

6

5

7

8

18

18