

17

16


15

Surveyed June 5 and 6, 1925.

20

21

22

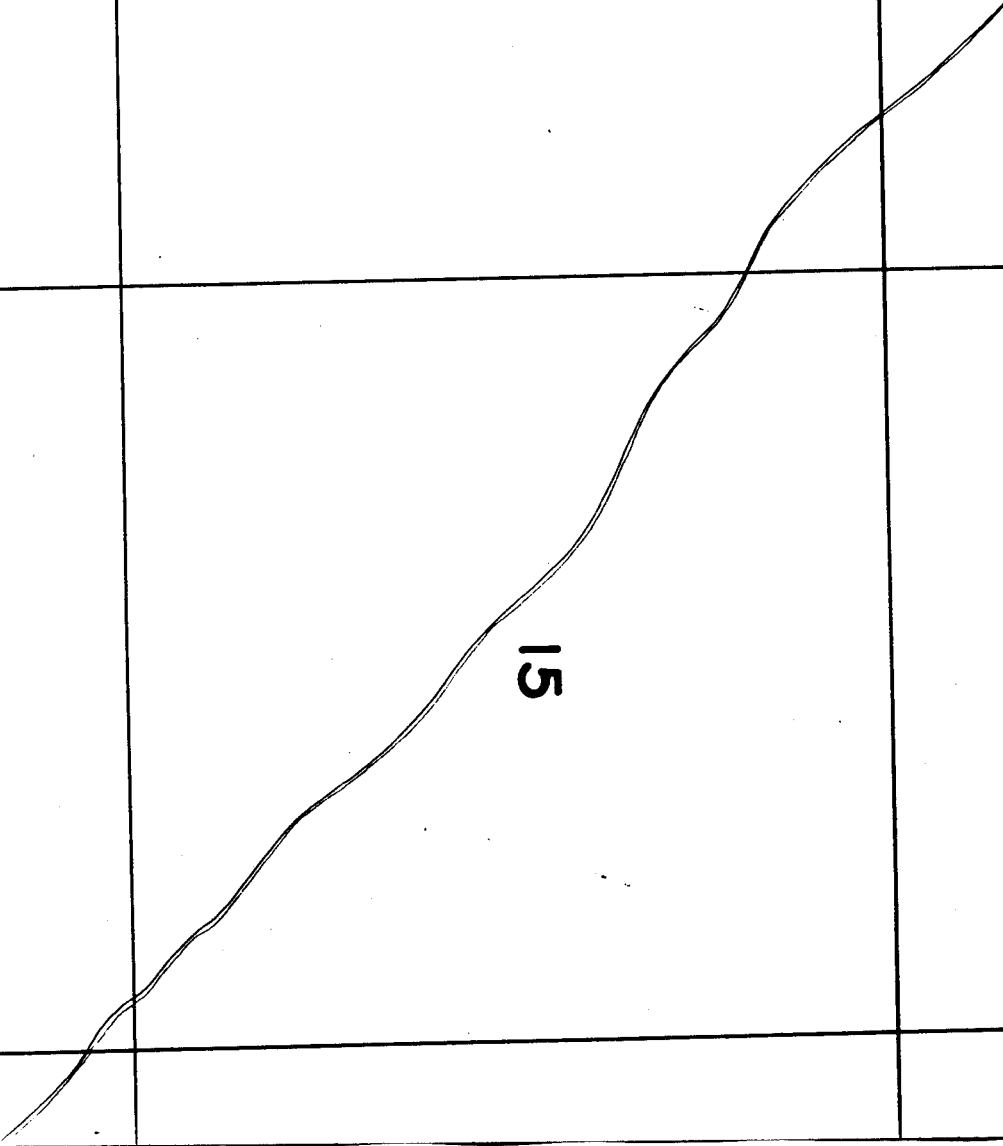

2

1

11

12

14

13

21

22


28

27

*Streams, except in the vicinity of
irrigated land are sketched in the
approximate location.*

33

34

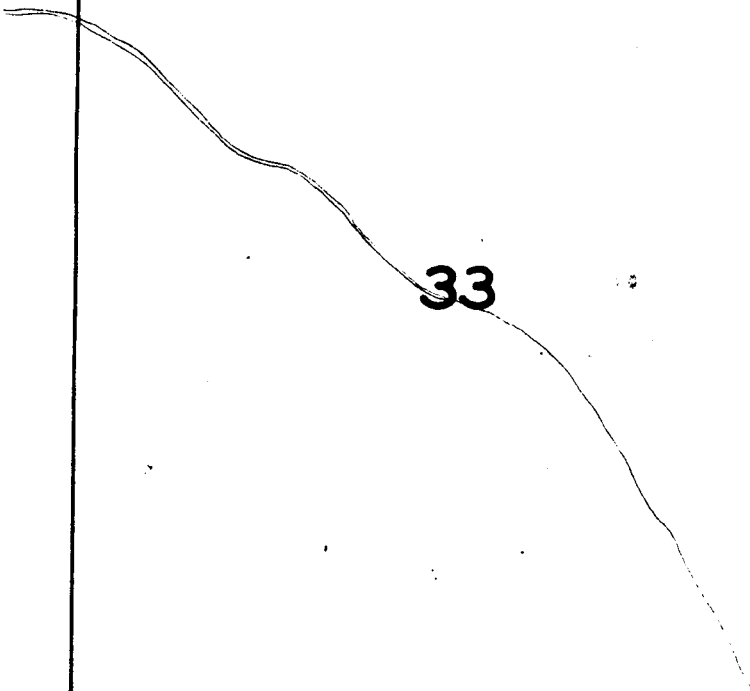

6

7

18

Lot 3.

Lot 2.

Lot 1.

0°

JOHNSON CREEK

Dale Stevens

5

15

6°

36°

1°

20°

Dam

J.B. and Roy Huddles

LONEROCK CREEK

8

Spring


Lot 4.

1°

Lot 1.
2°

Dam

17

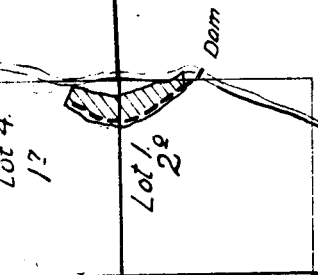

16

17


18

Surveyed June 5 and 6, 1

21

20

19

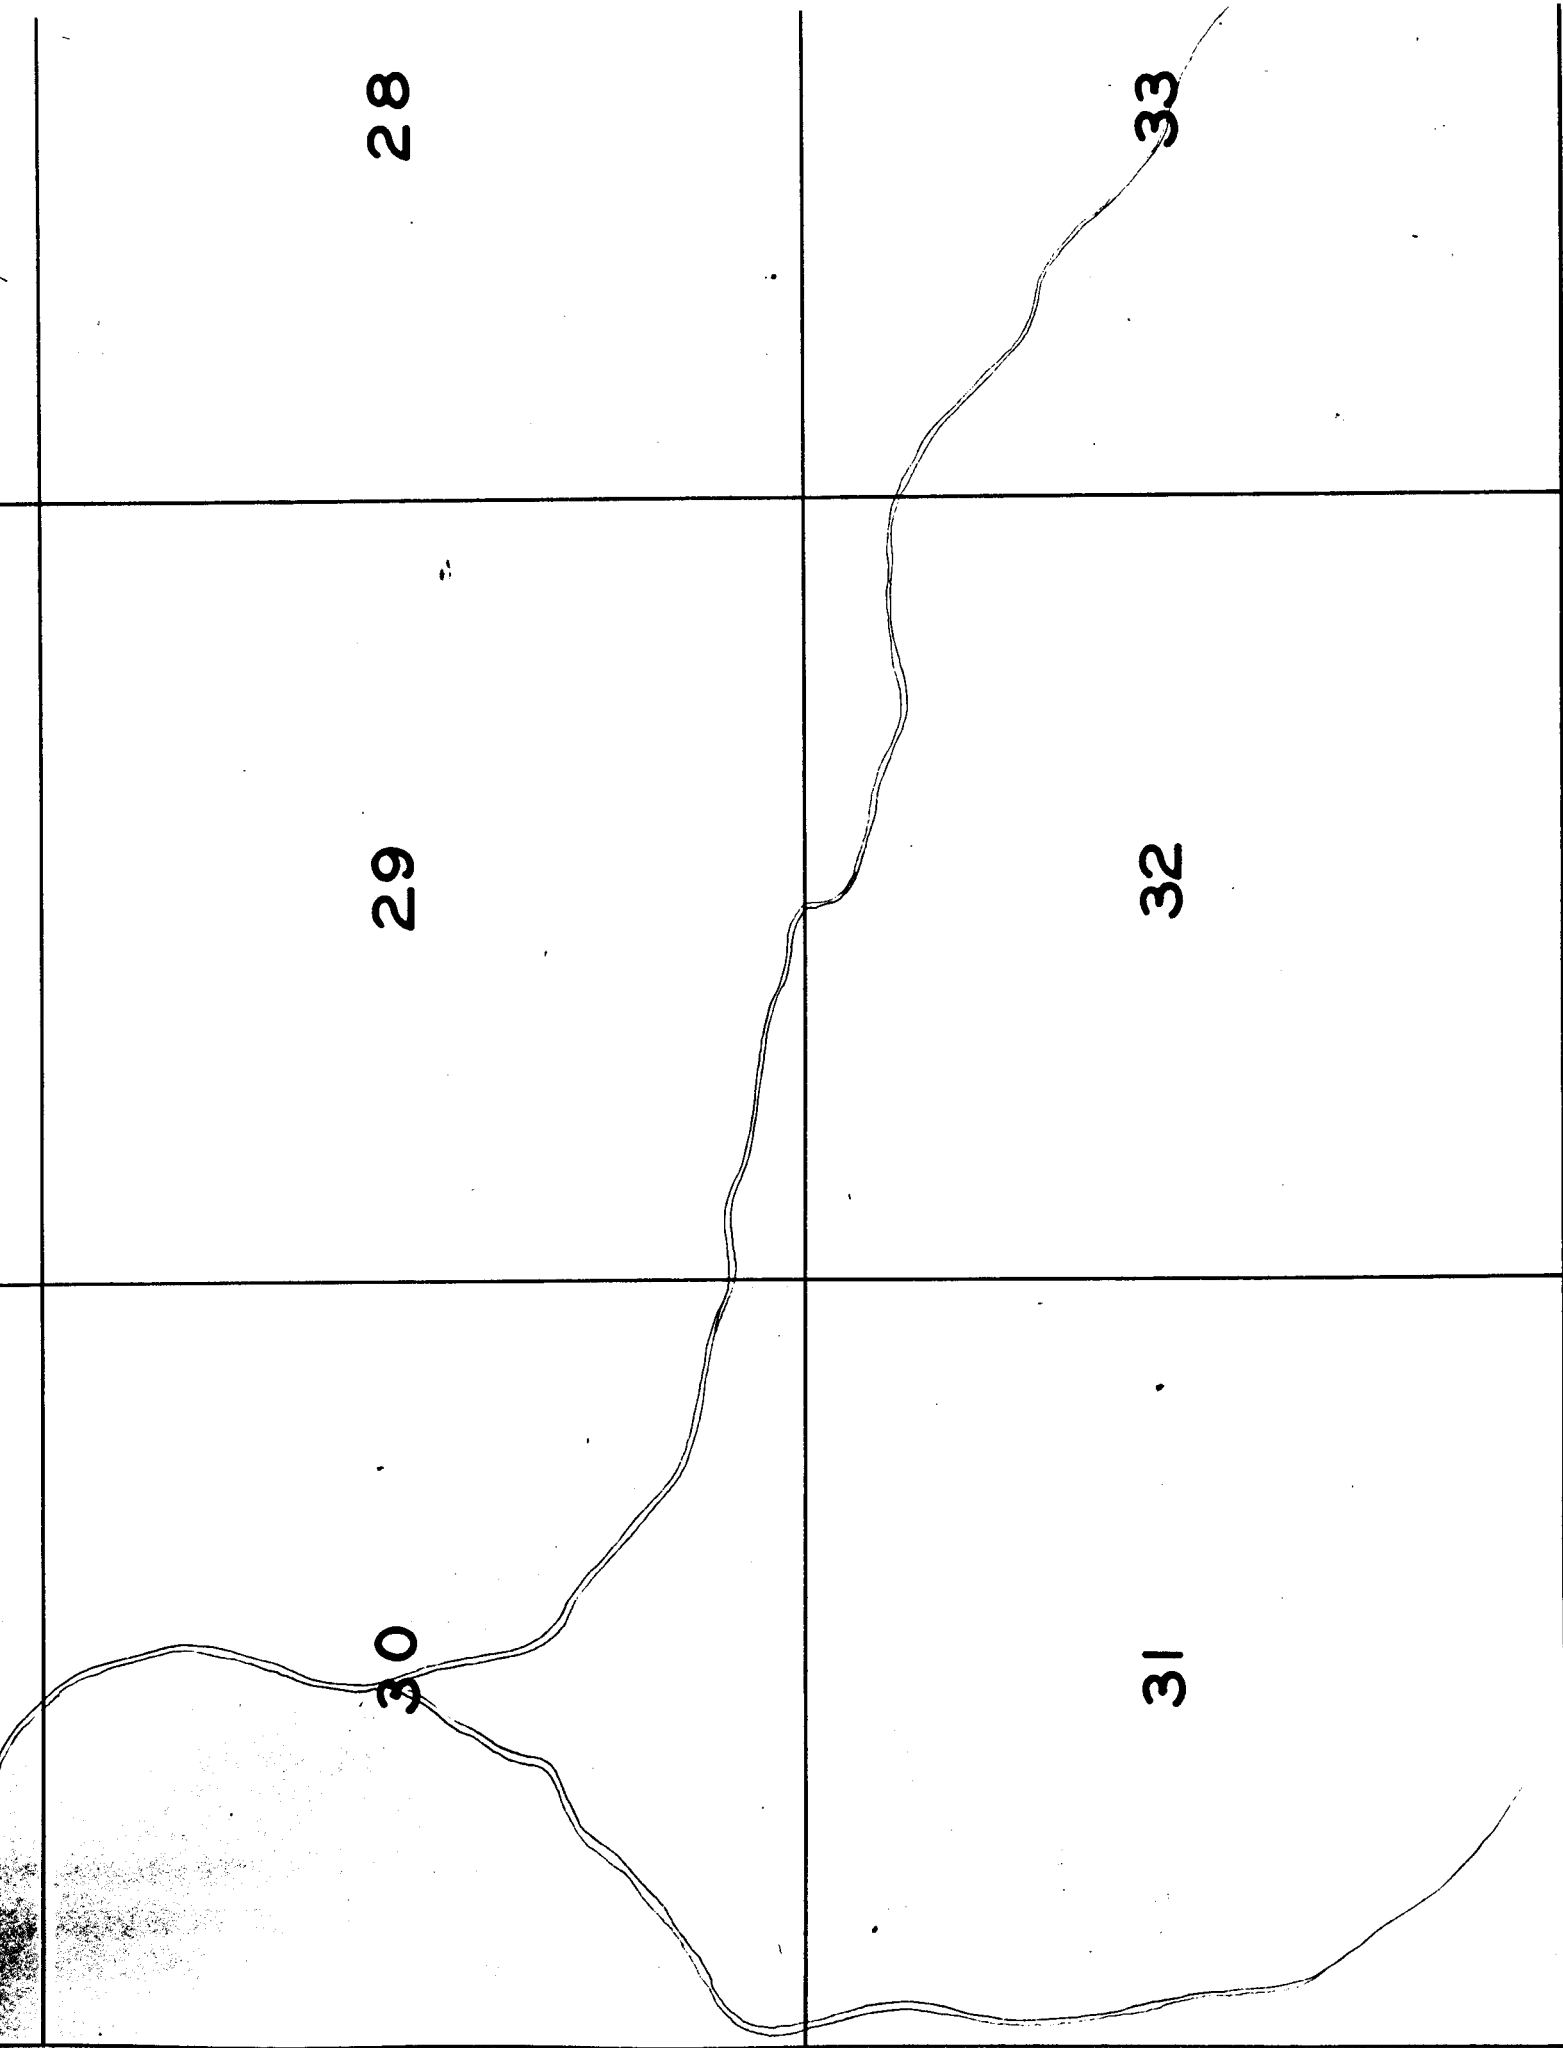

13


24

14

23

15

22

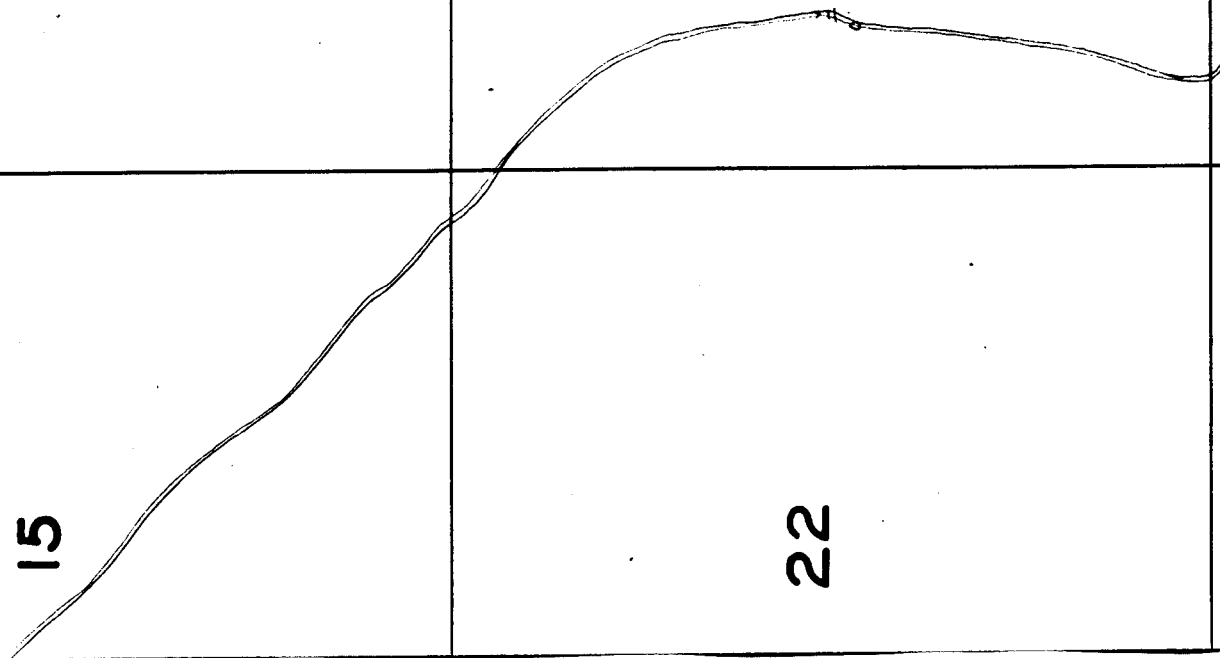

27

pt in the vicinity of
are sketched in the
location.

26

25

34

35

36