

28

29

30

Note: Streams and Rivers except in the vicinity of irrigated land, sketched in approximate location.

33

32

MATHIS

Surveyed Oct 29, 1925

0-1
Mrs Mary Adams
1925
CANYON

Spring

Baugh

16

21

17

20

18

19

27

26

25

1 Sept 24 and 30, 1925

34

35

36

JOHN DAY RIVER

HAHLER CREEK

PARISH AVENUE SHOWN

CREEK

F.F. Davenport

Avery Show



Warren Davenport

SPRAY

J. Fisher

Dem Johnson

cc + Lou Mar...
CITY RESERVE

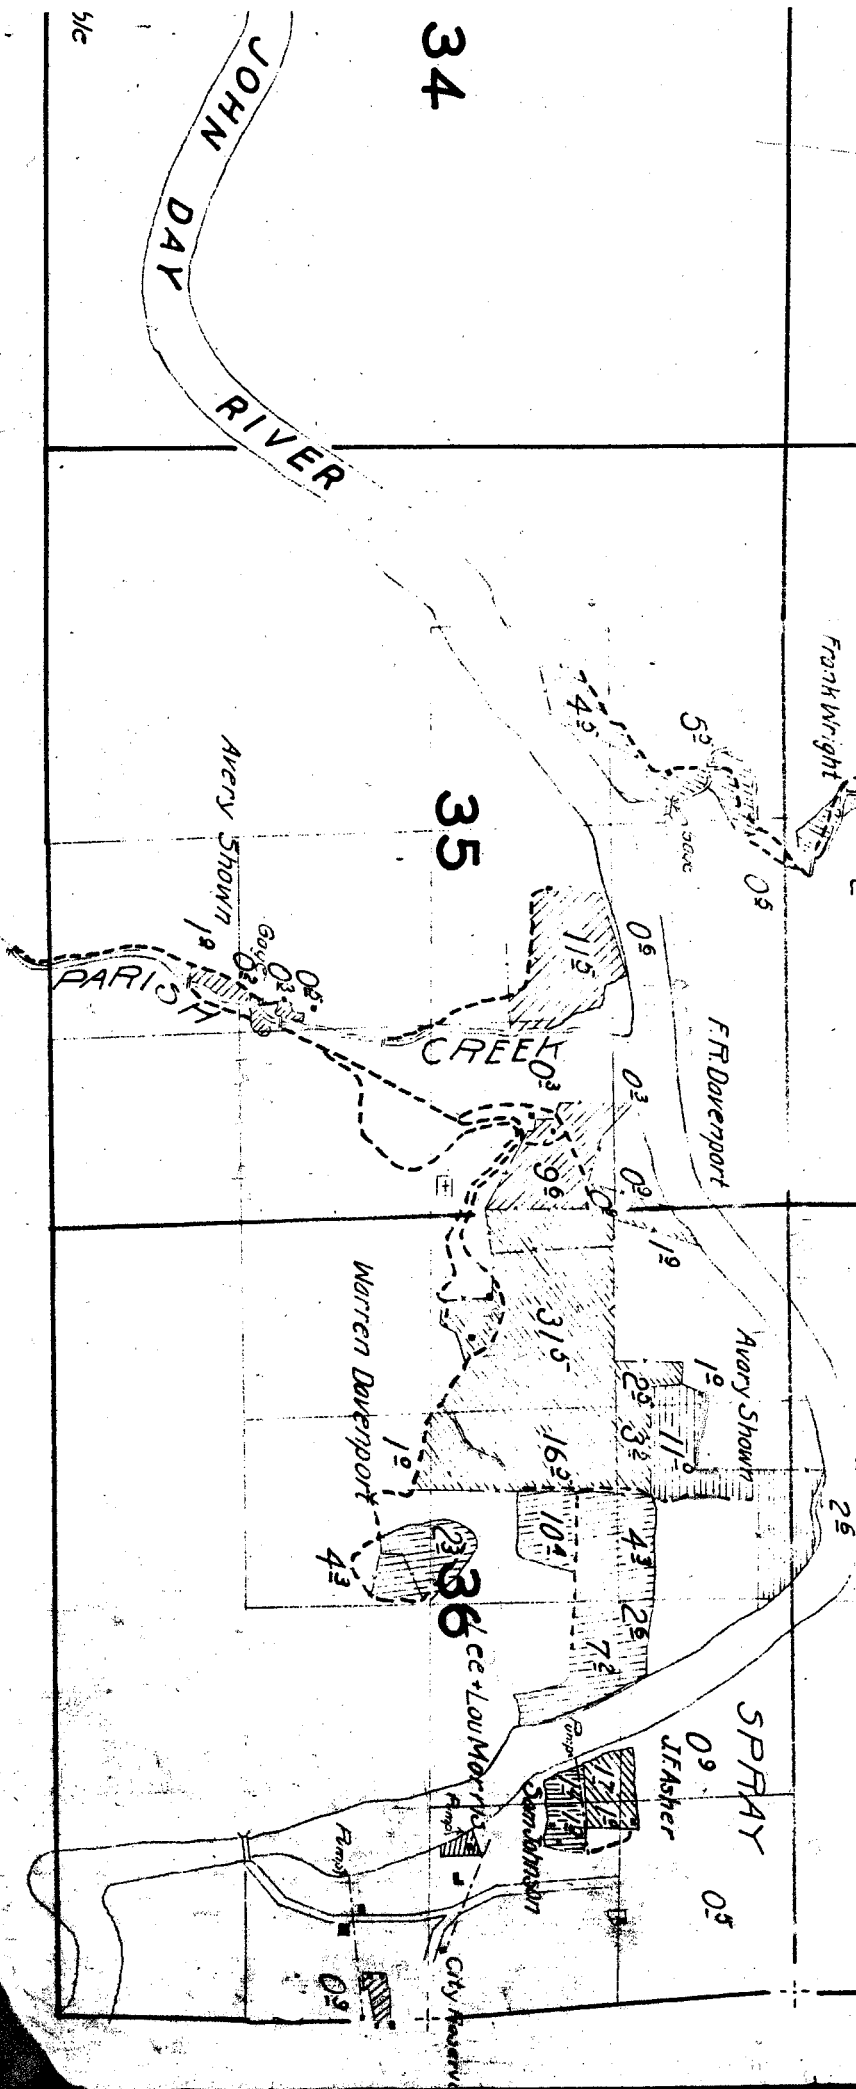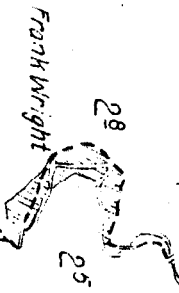

5/6


15

14


22

23

13

24

44

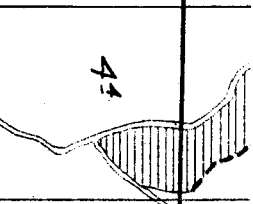


A.S. Borges

24

158


29

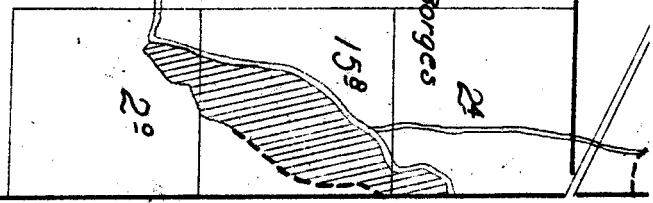

Amos Haws

24

52

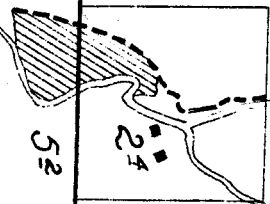

21

22

28

27

Surveyed Sept. 24 and 30, 1925.

33

34

Baughn


0³

6²

pump

Snoble

JOHN DAY RIVER

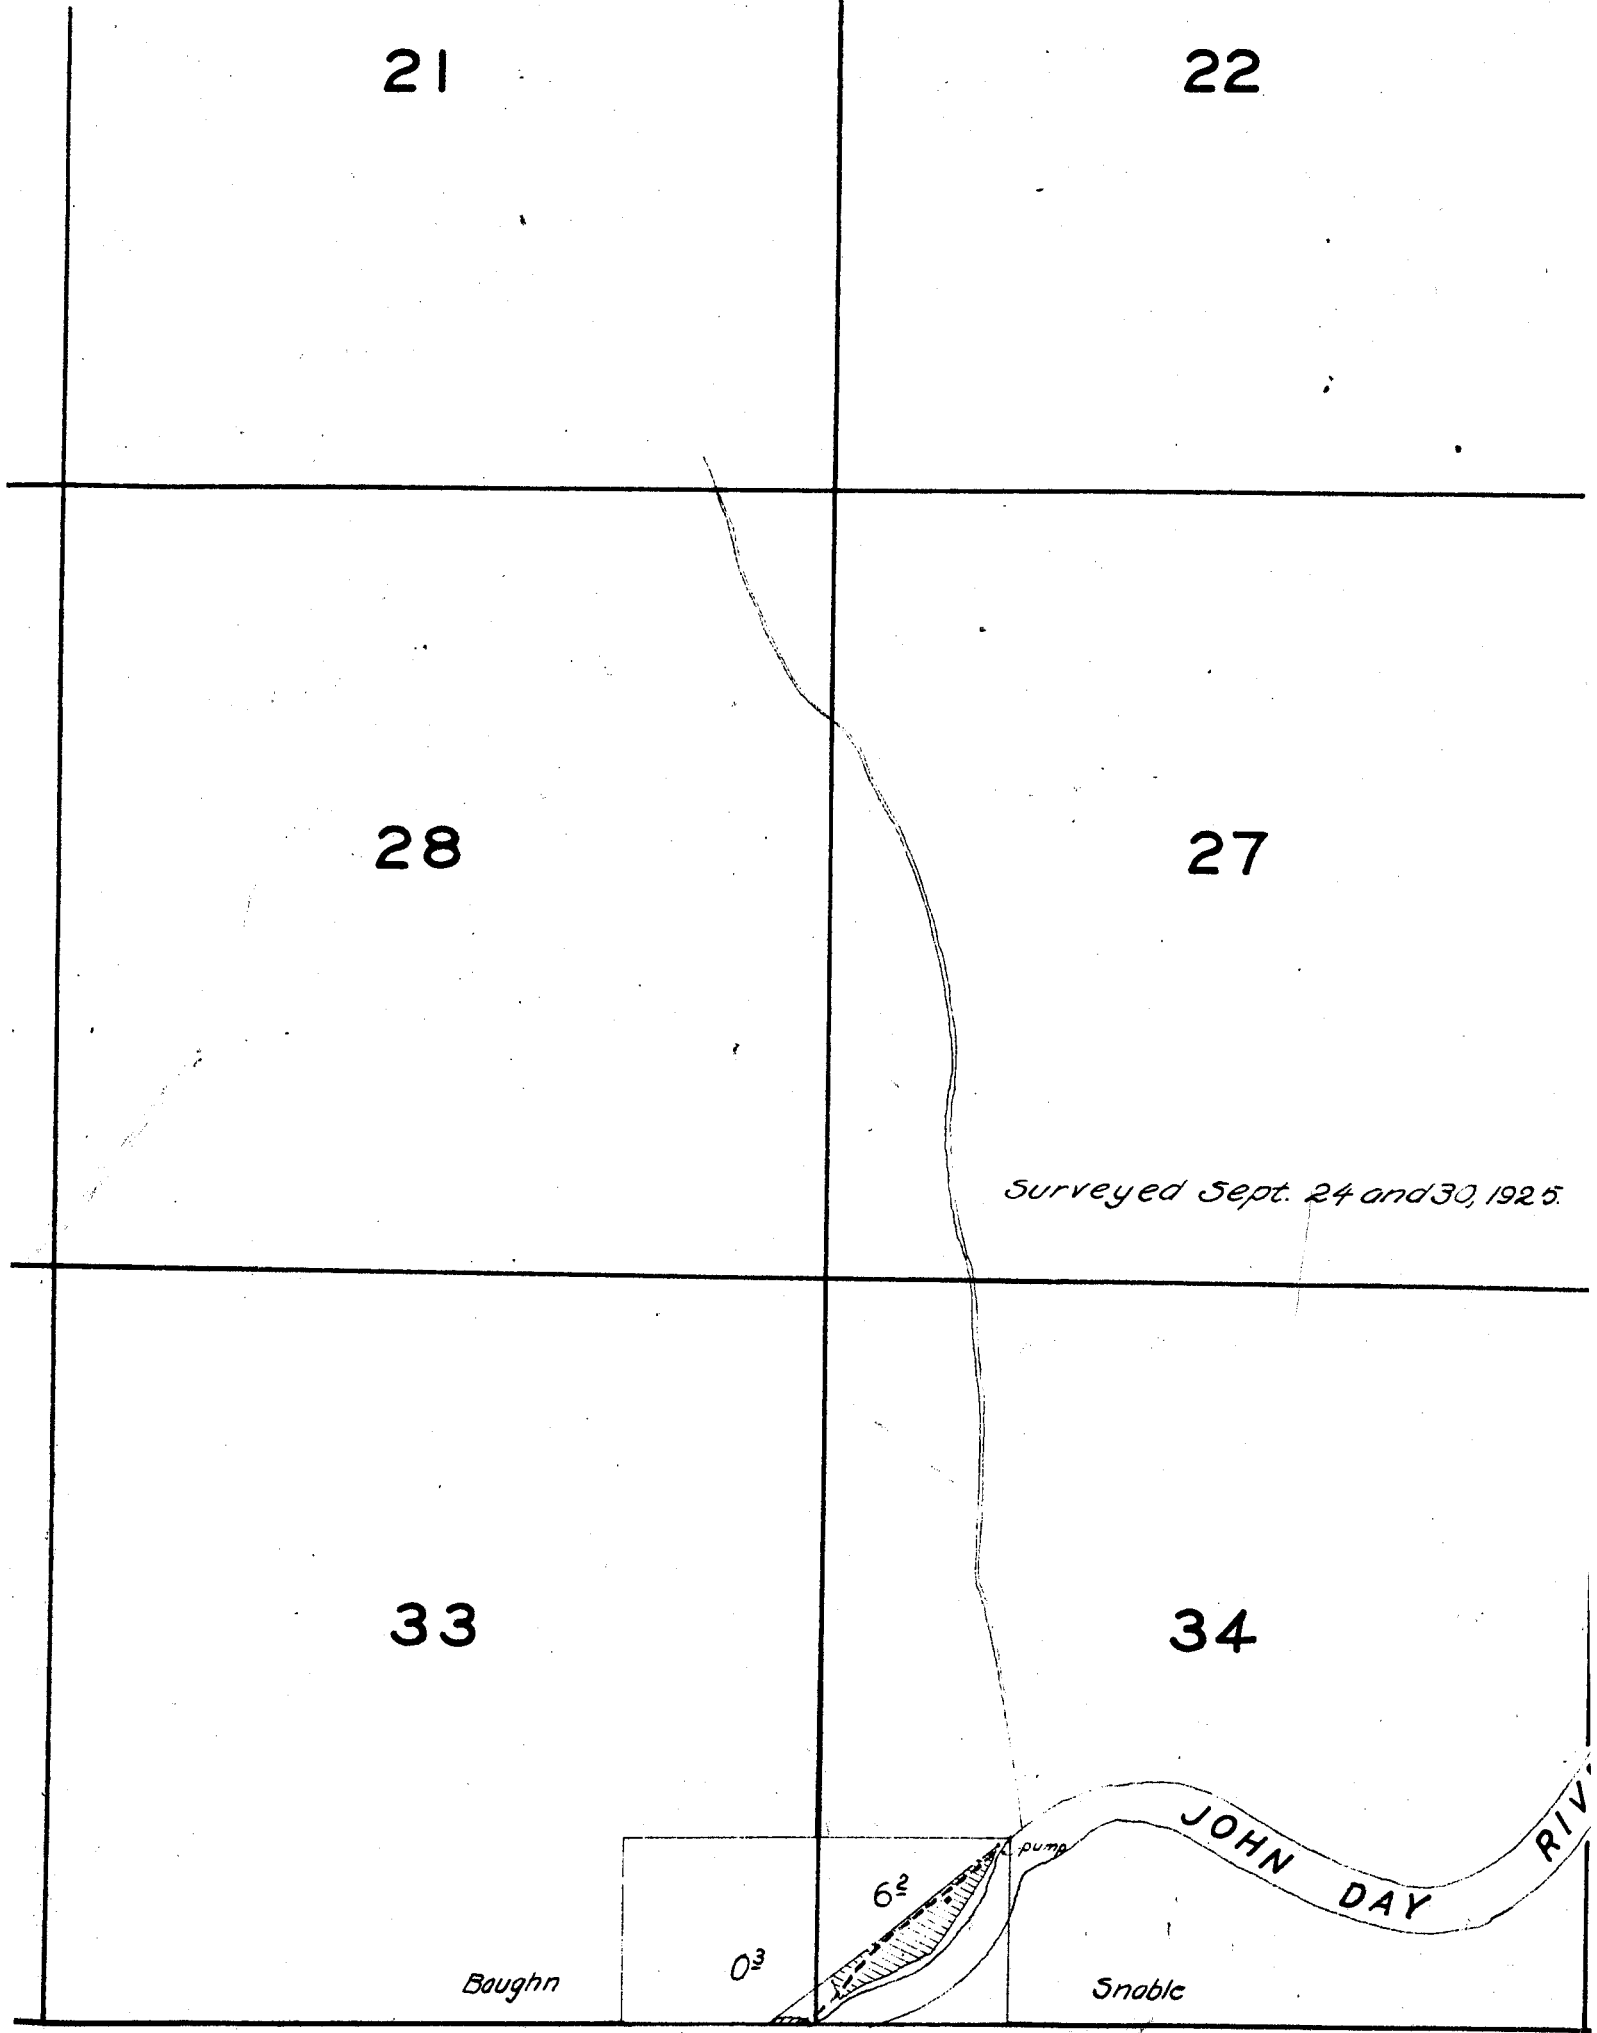

TOWNSHIP 8 S., RANGE 24 E.

	4	3	
			Surveyed.

			10
1925.			9


50

15

22

16

21

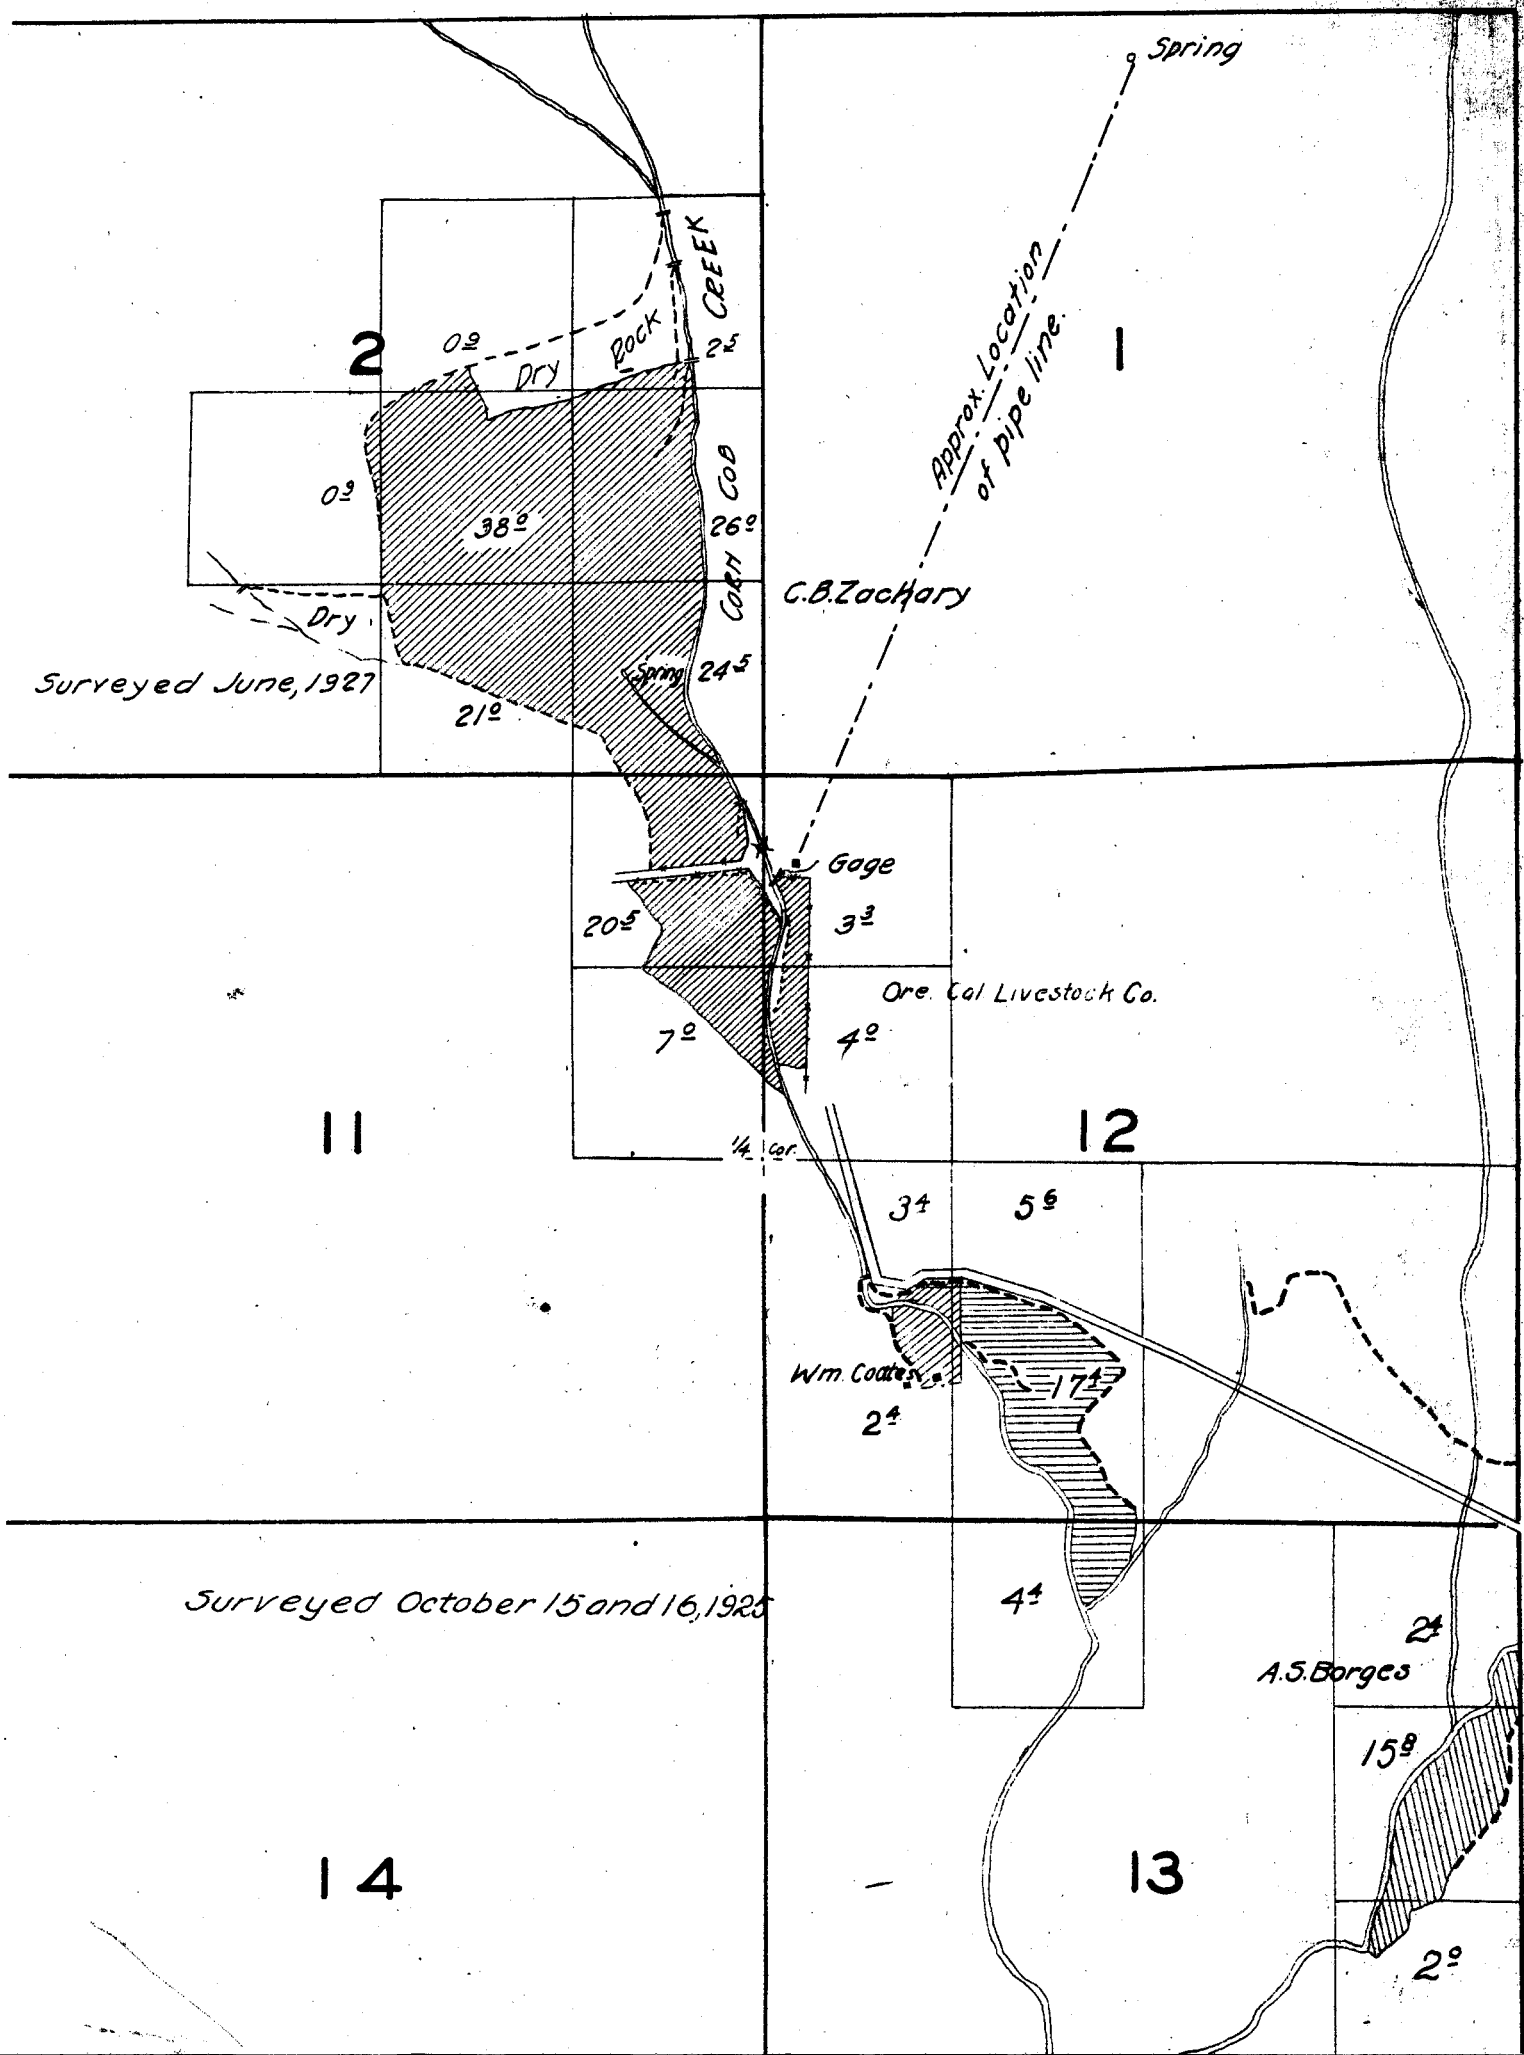

Elmer McQuinn


Lot 4.

20'

37'

6

5

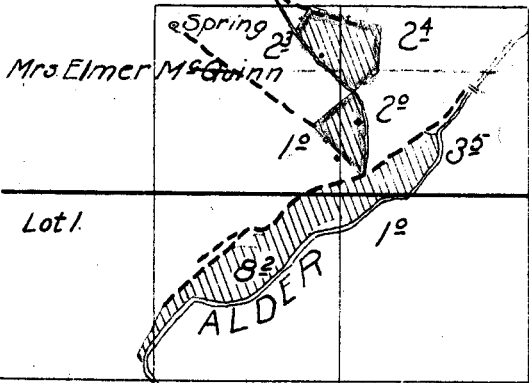

Lot 1.

Surveyed October 16, 1925.

Lot 2.

04'

7

8

Lot 3.

Lot 4.

18

17