


TOWNS

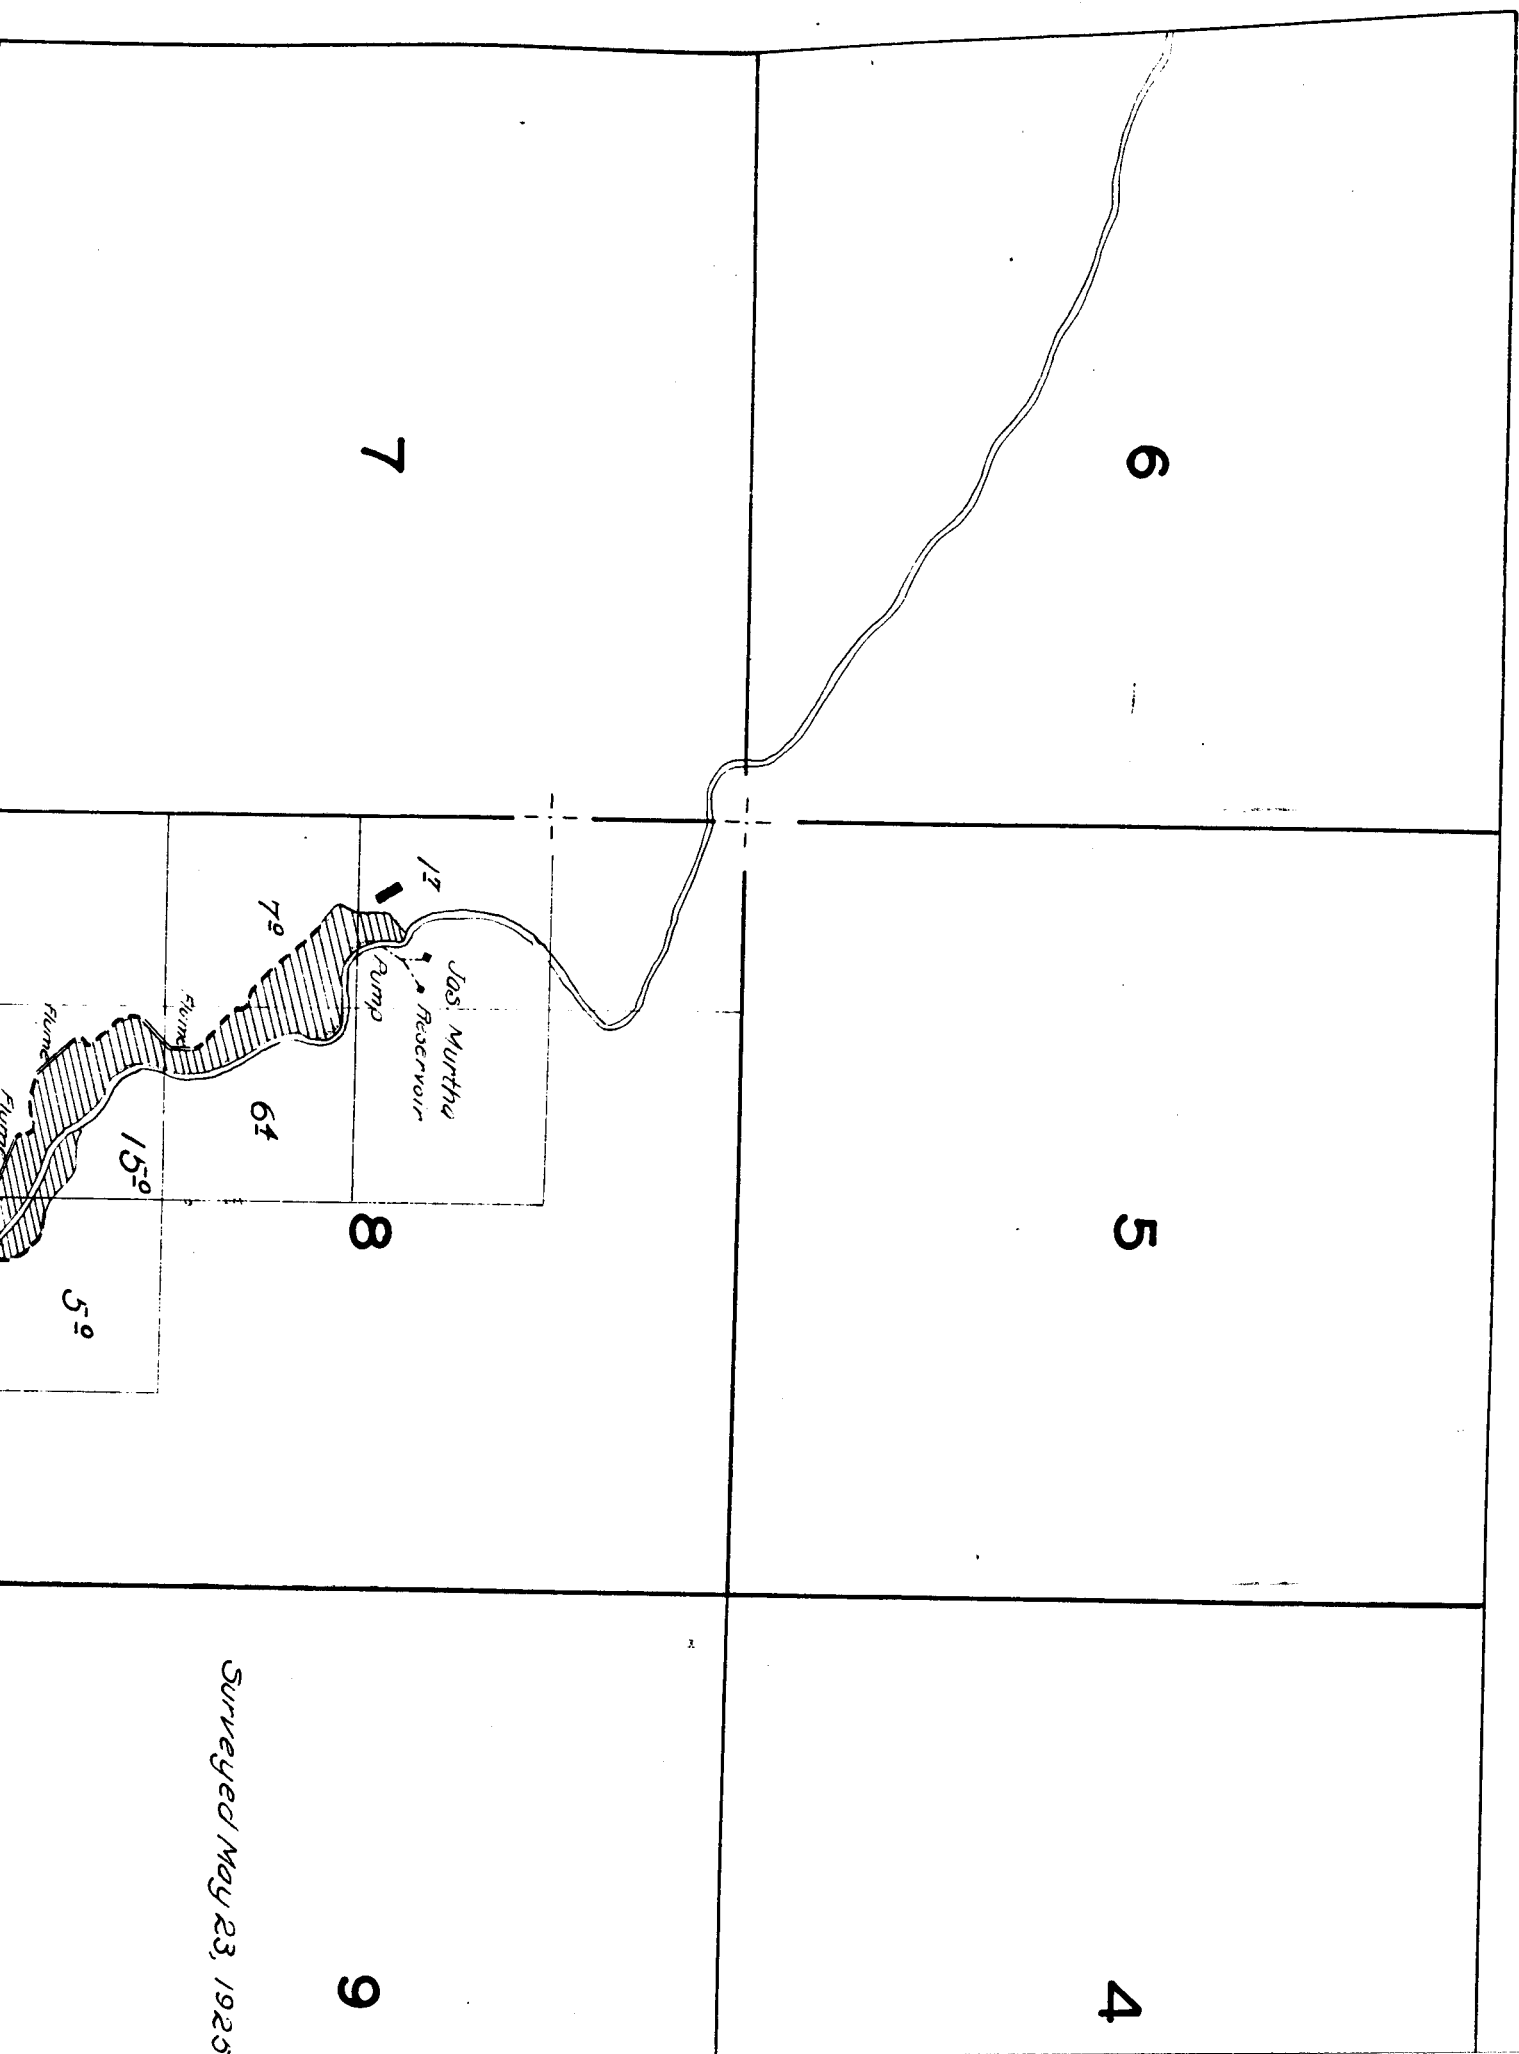

18

17



16

19

20

21

*Note:-
Information concerning corners
supplied by Murtha per township
plat in his possession.*

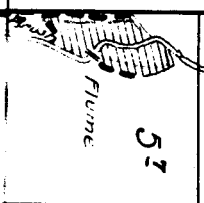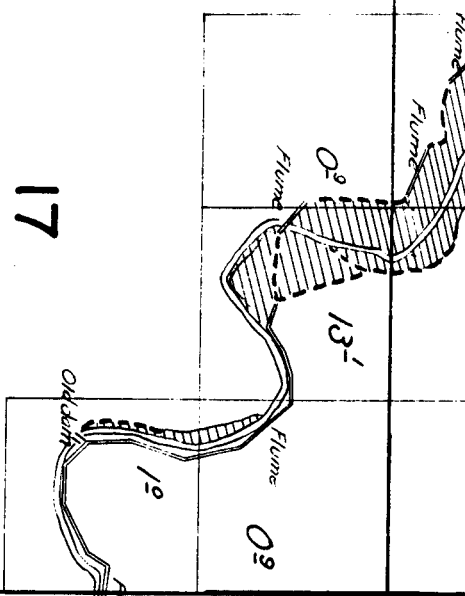

23

24

L.P. Davidson

Surveyed June 1927

26

25

4³

2²

4¹

0⁵

3²

1²

5⁵

4⁴

L.P. Davidson

Note: Location according to L.P. Davidson

Surveyed June, 1927

35

36

15


14

13

22

23

24

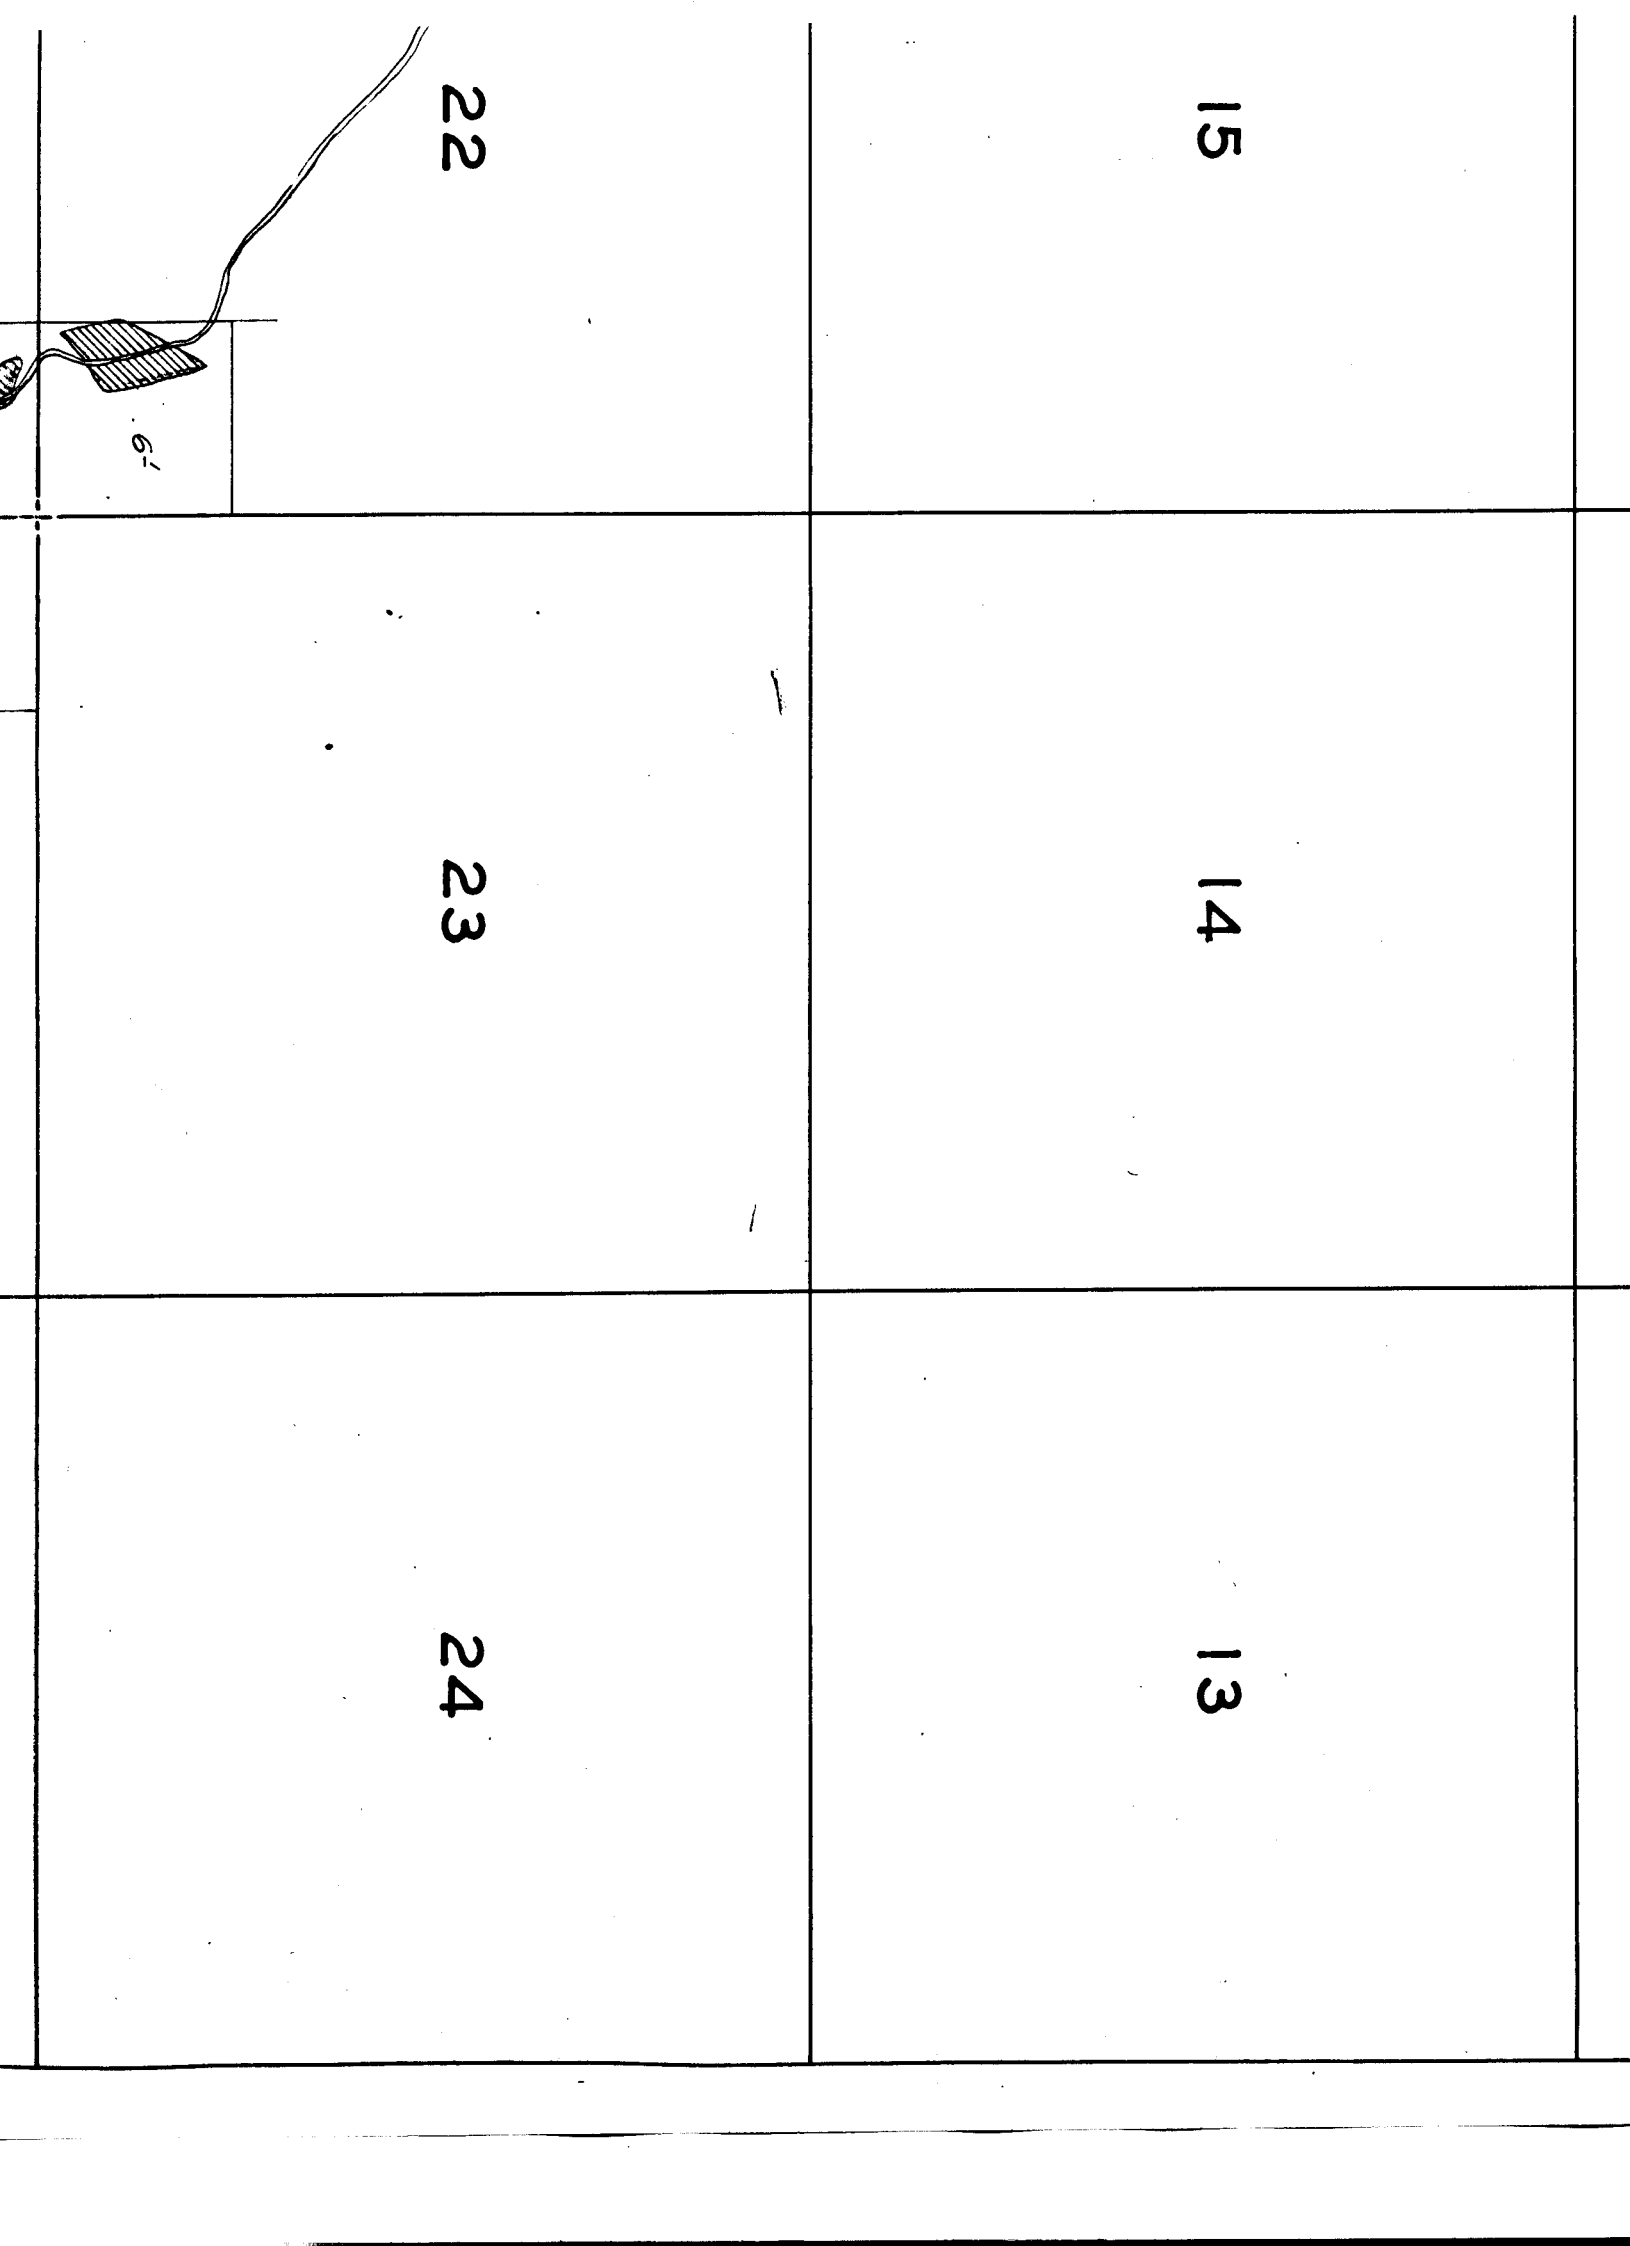

3	2	1
10	11	12

TOWNSHIP 4 S., RANGE 23 E.

4

3


9

10

Surveyed May 23, 1925

16

15

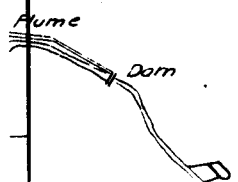

19

20

30

29


31

32

04

1/2

1/2

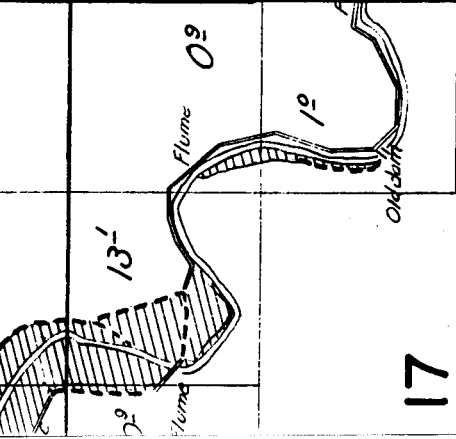

17

16

15

ROCK CREEK

Turning corners
the per township
ession.

20

21

22

