


TOWNSHIP 5 S., RANGE 19 E.

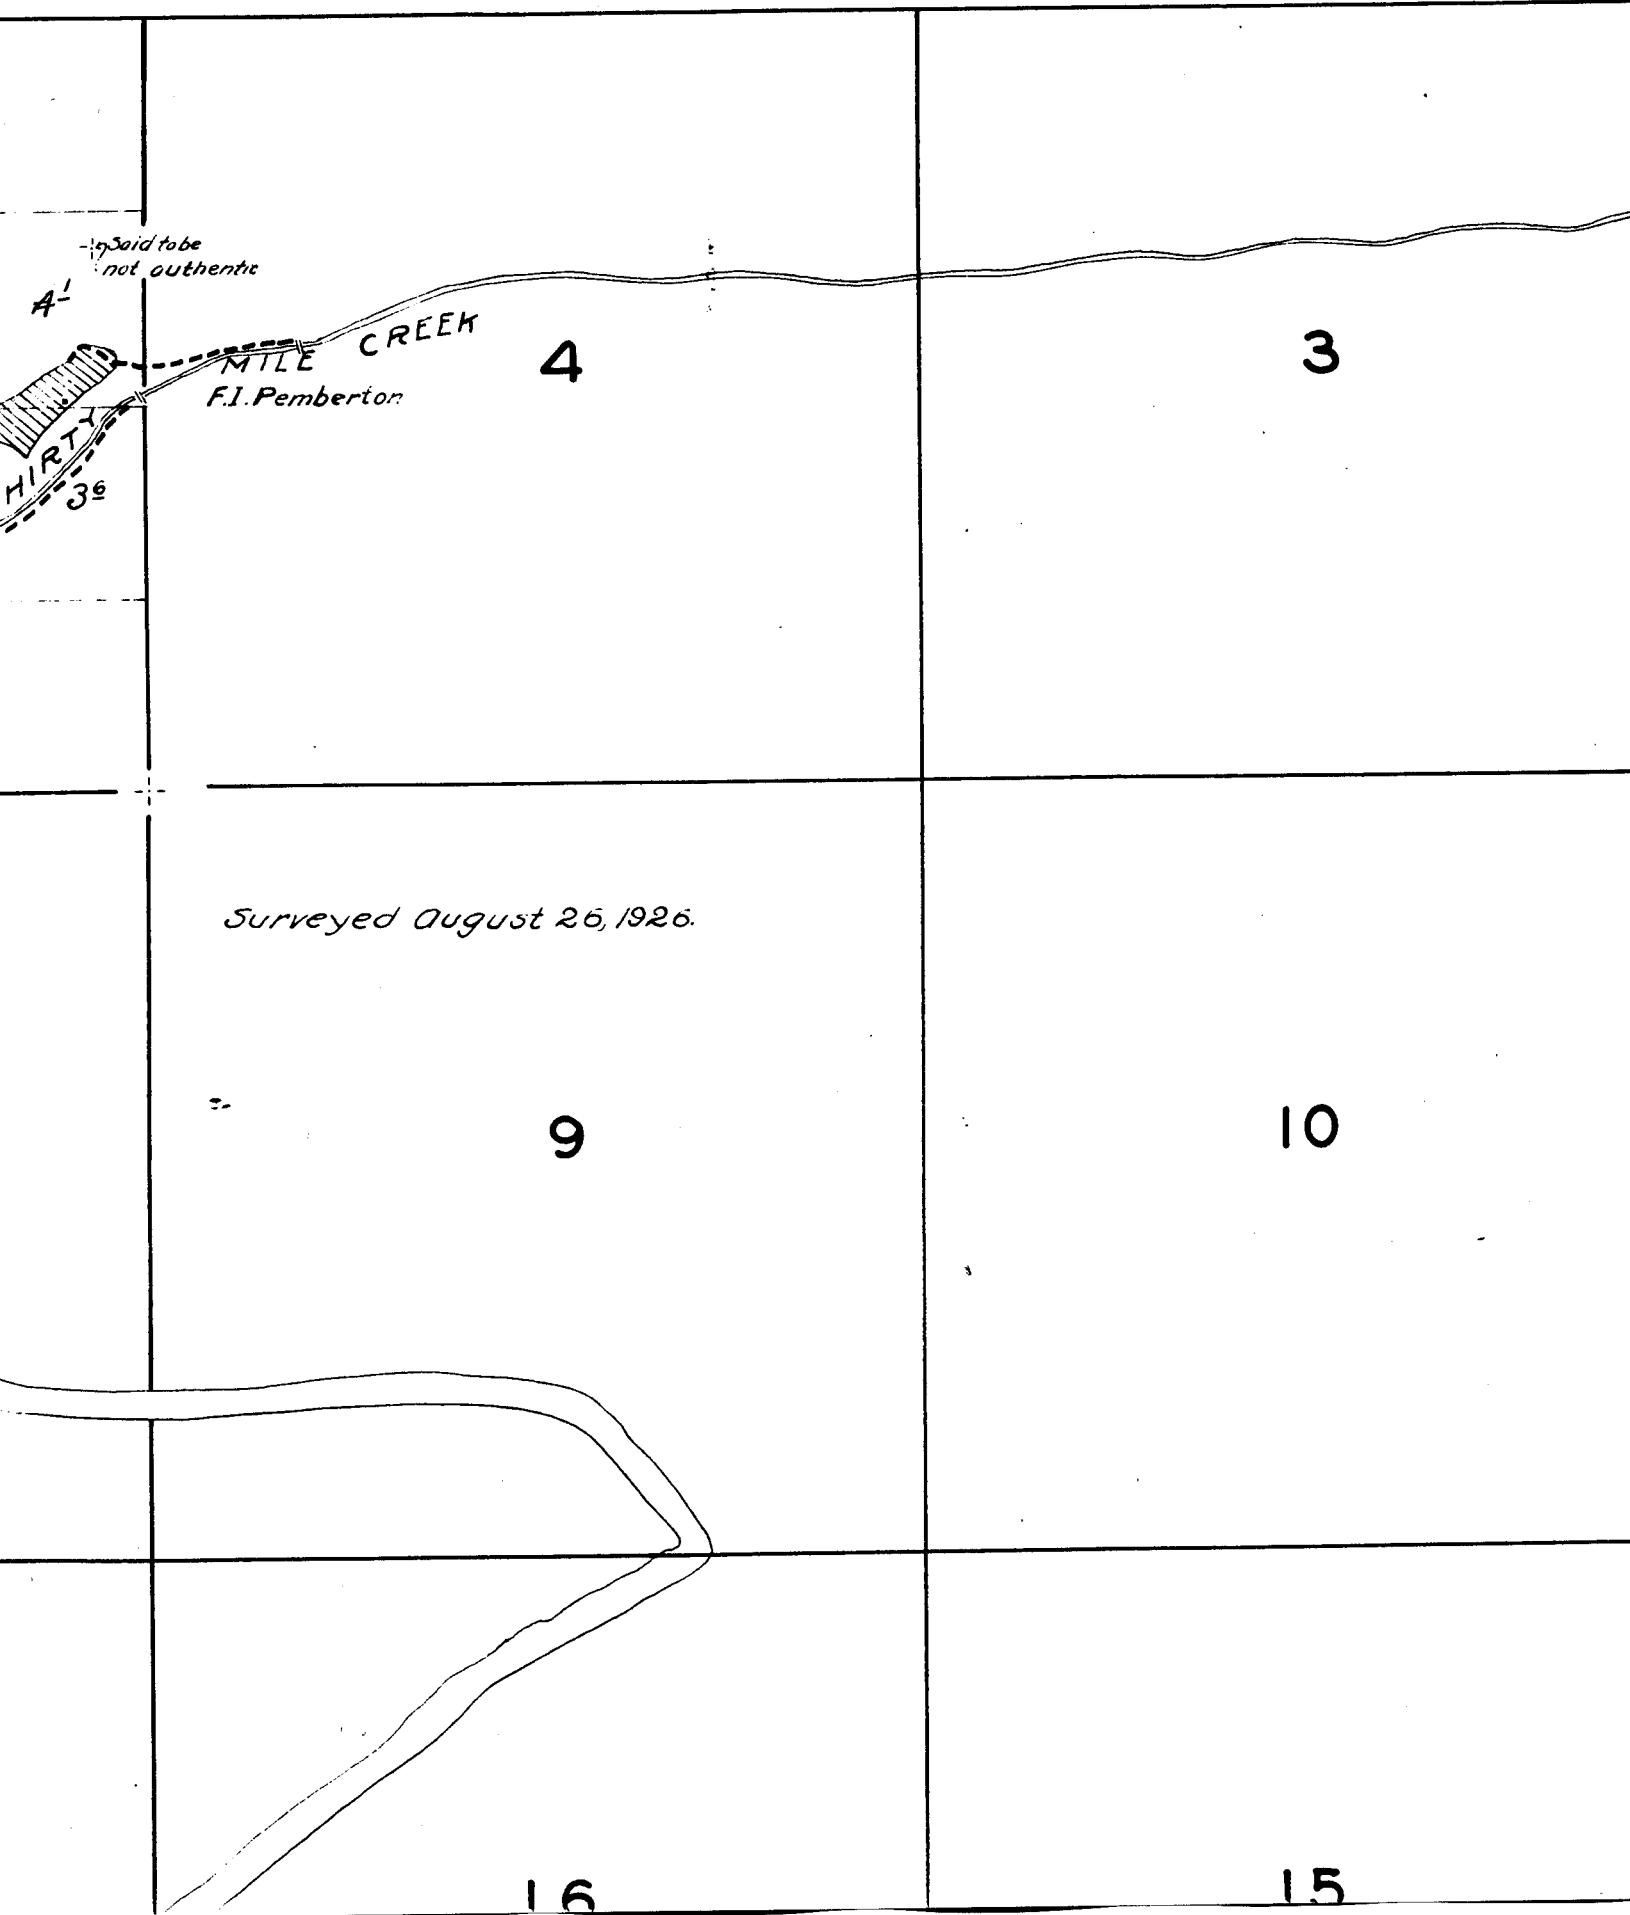

19

20


Note: Streams, except in the vicinity of irrigated land are sketched in the approximate location.

30

29

31

32

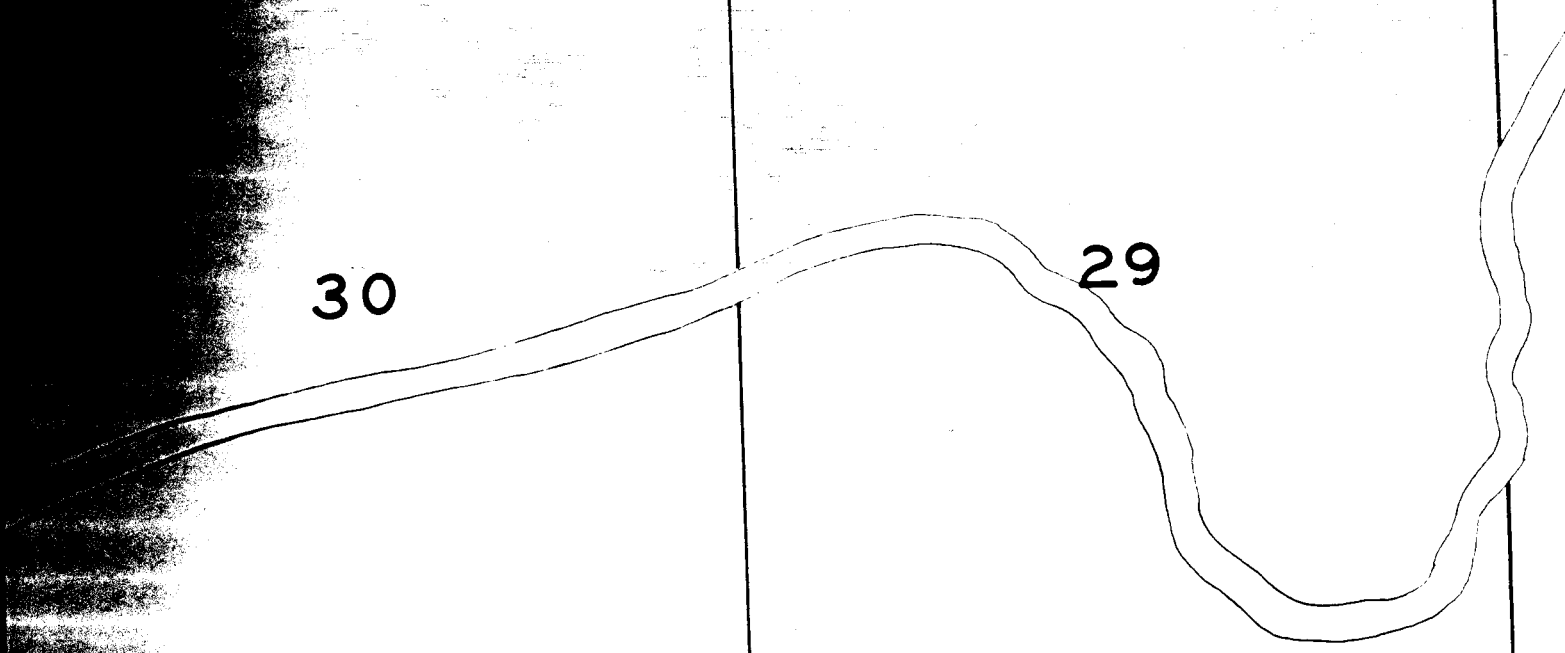

23

24

26

25

35

36

15

22

16

21


the vicinity of
hed in the

27

34

28

33

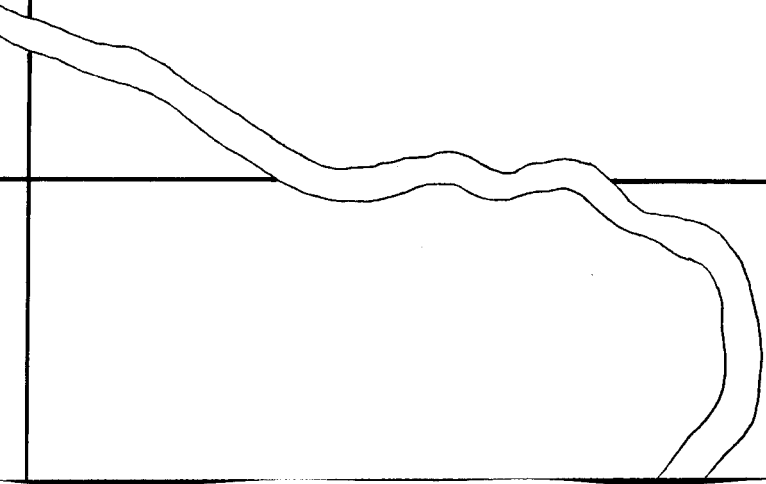

18

17


16

19


20

21

Note: Streams, except in the vicinity of irrigated land, are sketched in the approximate location.

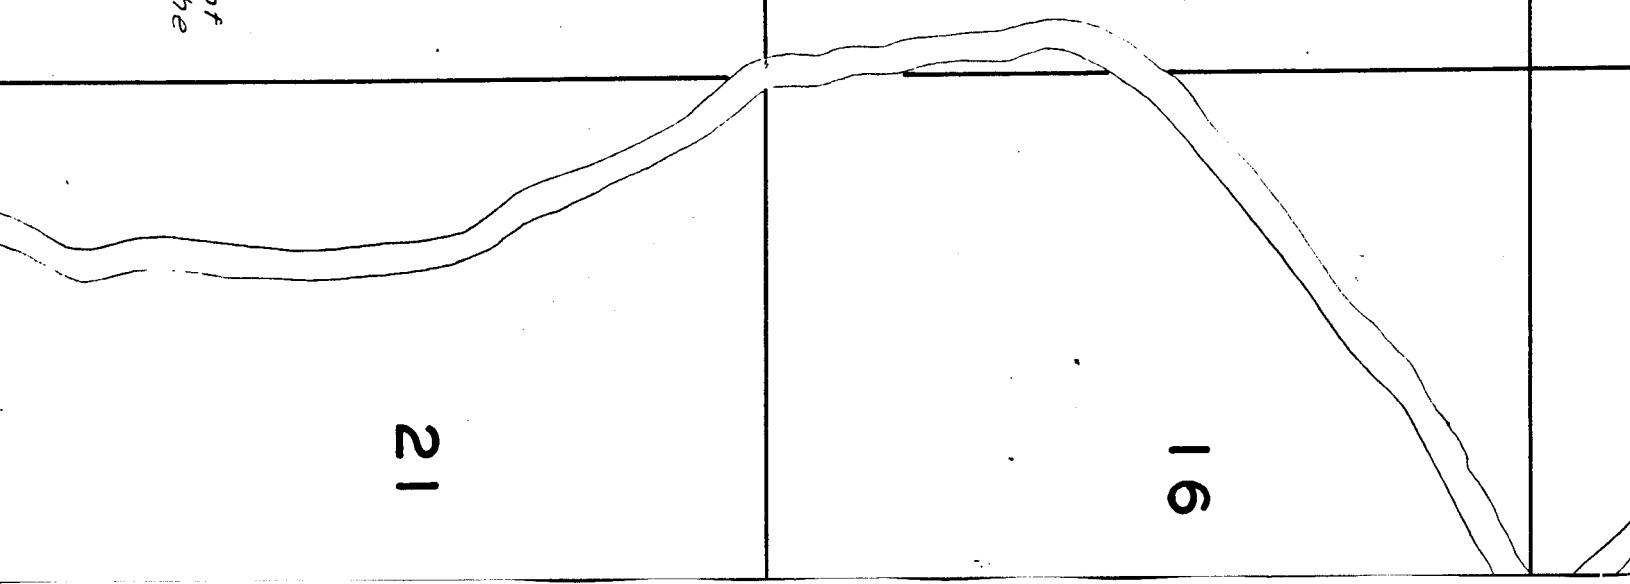

TOWNSHIP 1

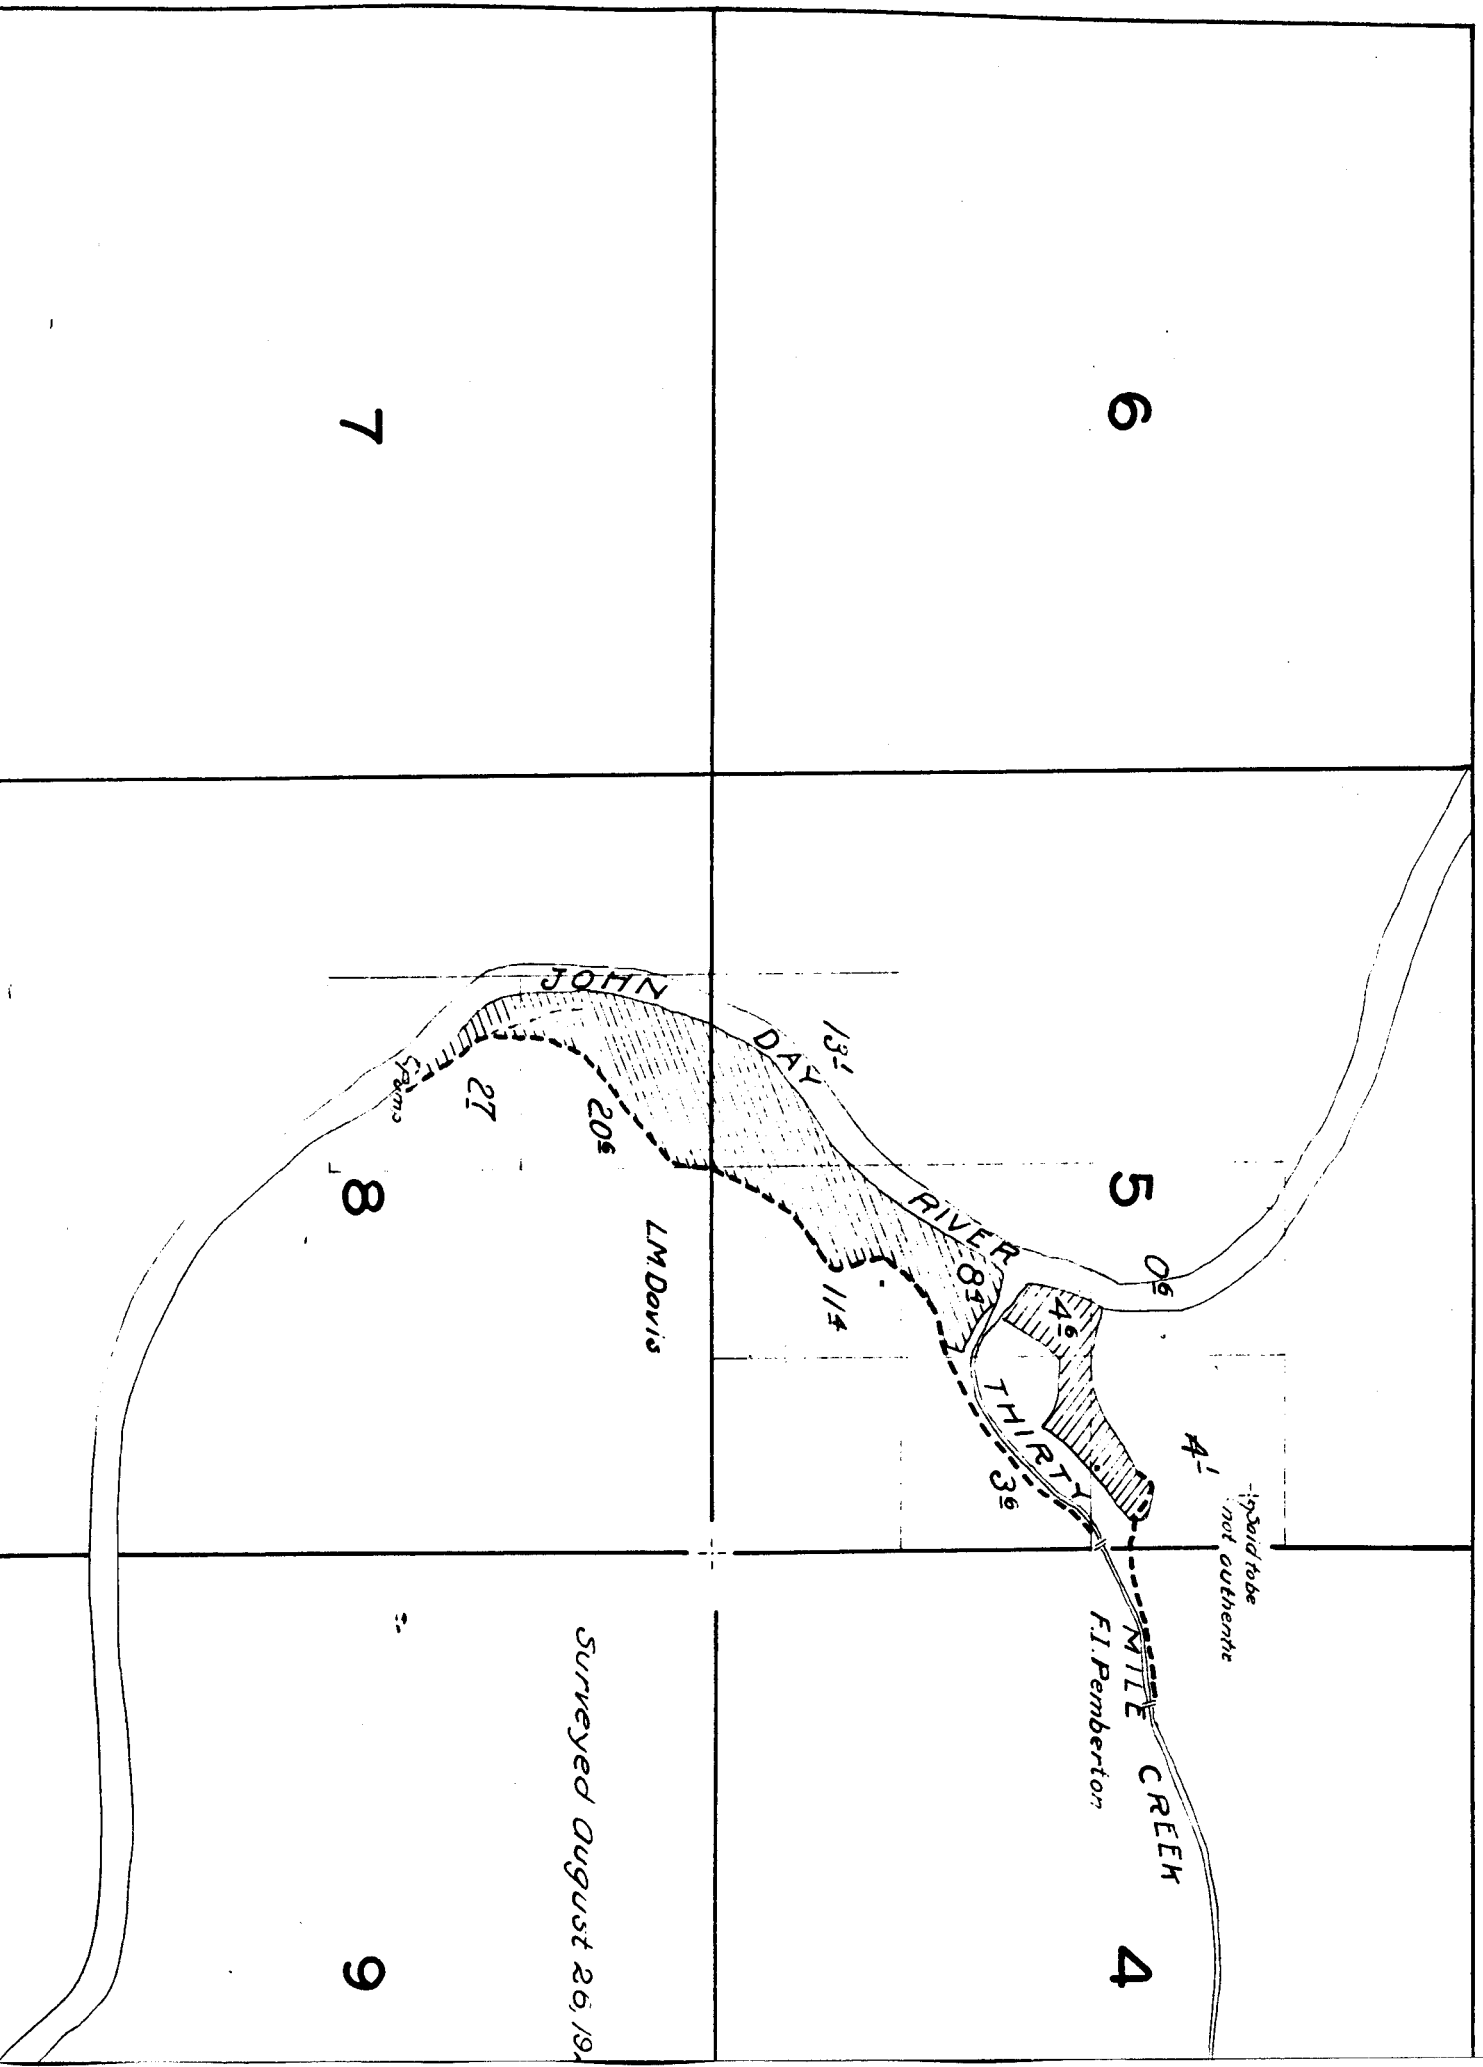

15

14

13

22

23

24

19E.

18-2-1

3	2	1
10	11	12