


Township 3. S. , R

	6			5			4			3
	7			8			9			10
	18			17			16			15
	19			20			21			22
	30			29			28			27

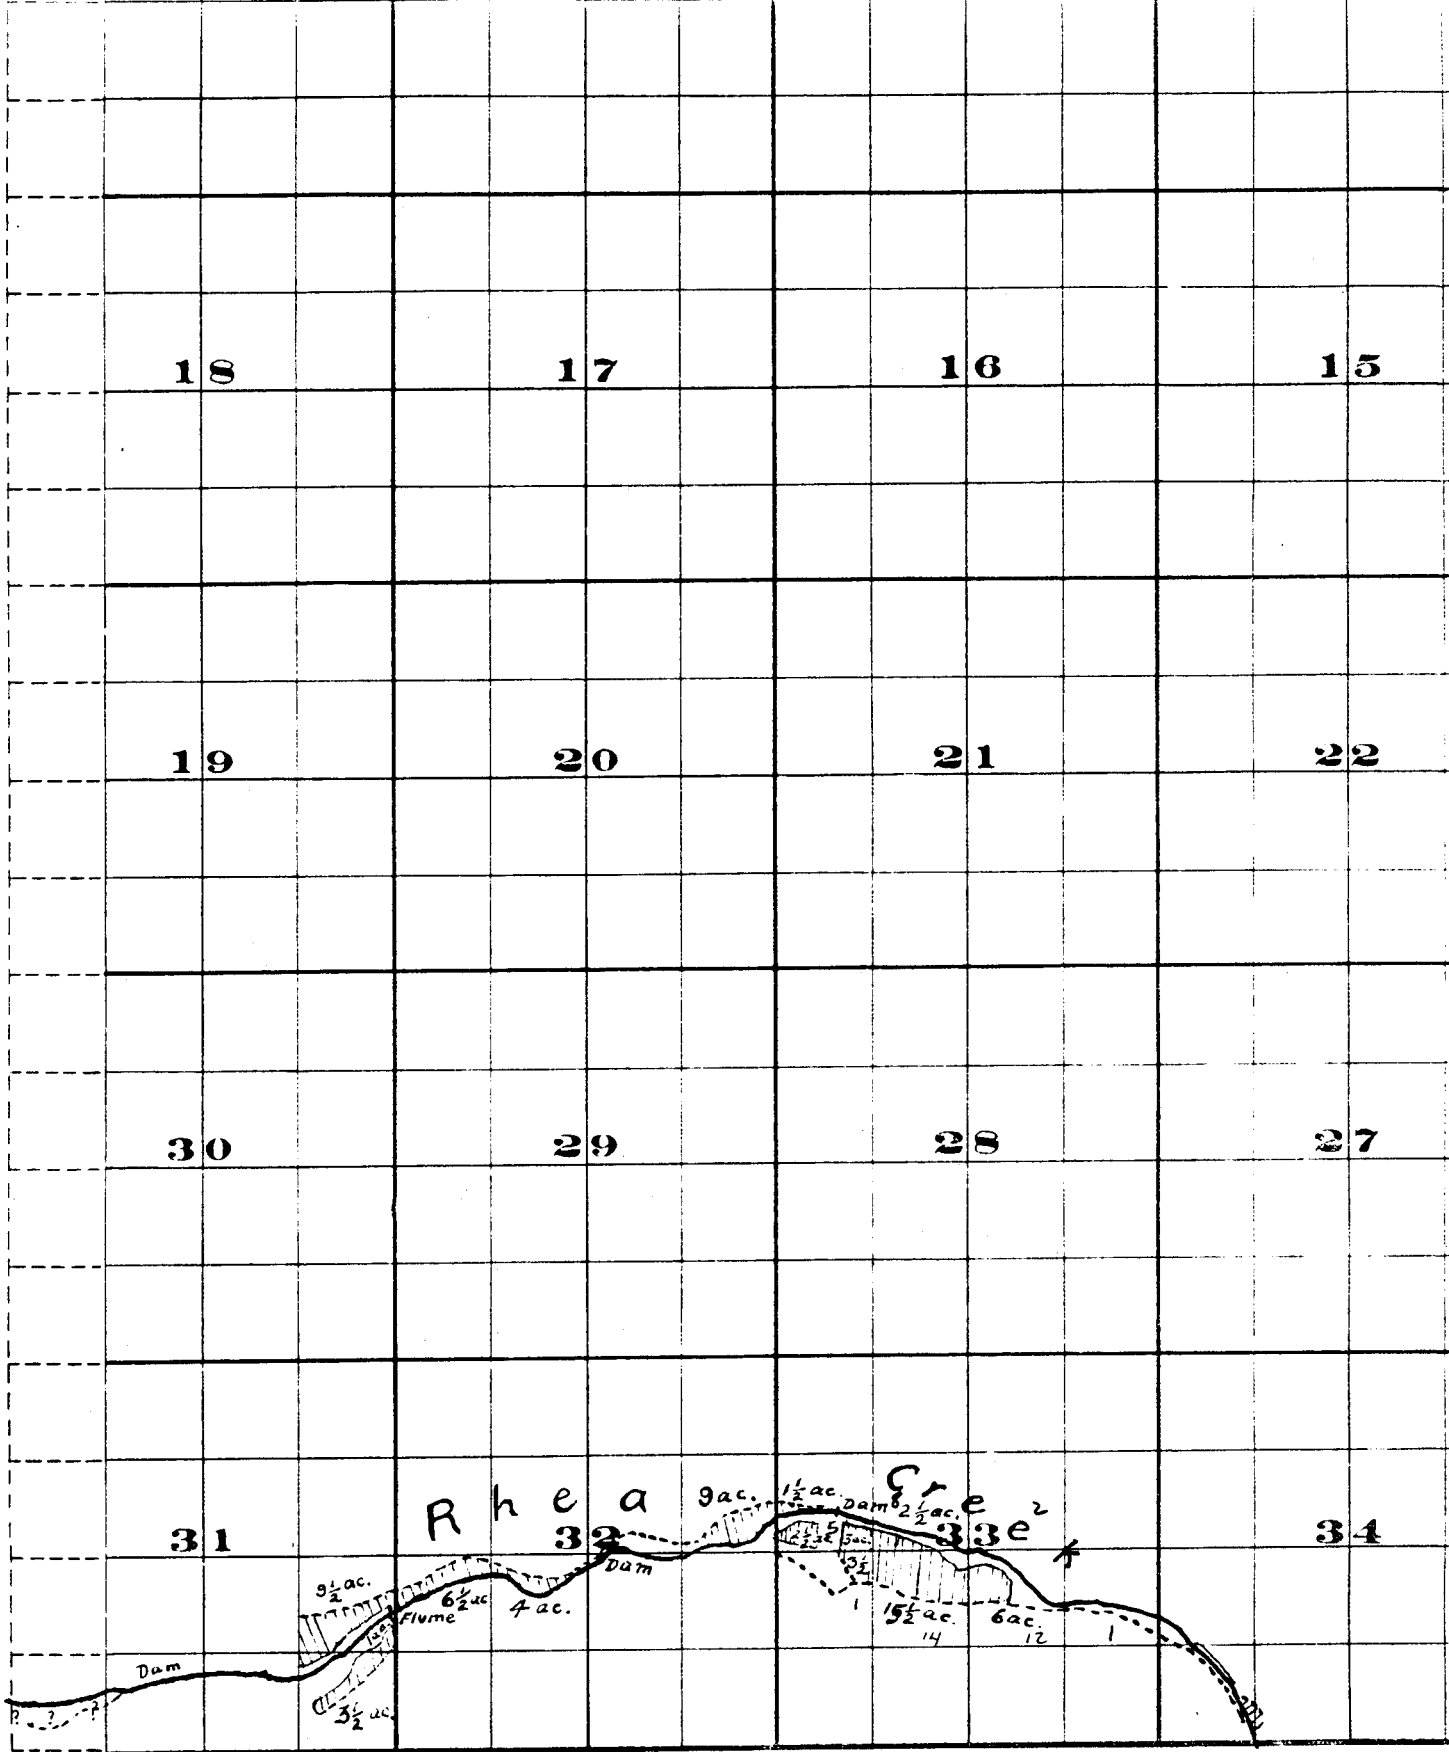

THE S. A. BRISTOL CO. PRINTERS & BOUNDERS, CHEYENNE, WYO.
 Surveyed by H. K. Donnelly July 1909
 John H. Lewis - State Engineer
 Examined - July 14, 1909.

15

14

13

22

23

24

27

26

25

34

35

36

FROM OFFICE OF THE STATE ENGINEER, SALEM, OREGON

Willow Creek Adjudication

3 S. 26 E.