

17

16

15

*Note: Streams, except in the vicinity of
irrigated land, sketched in approximate
location.*

20

21

22

29

28

27

32

33

34

15

14

13


22


23

24

JE 23 E.

76-2-2

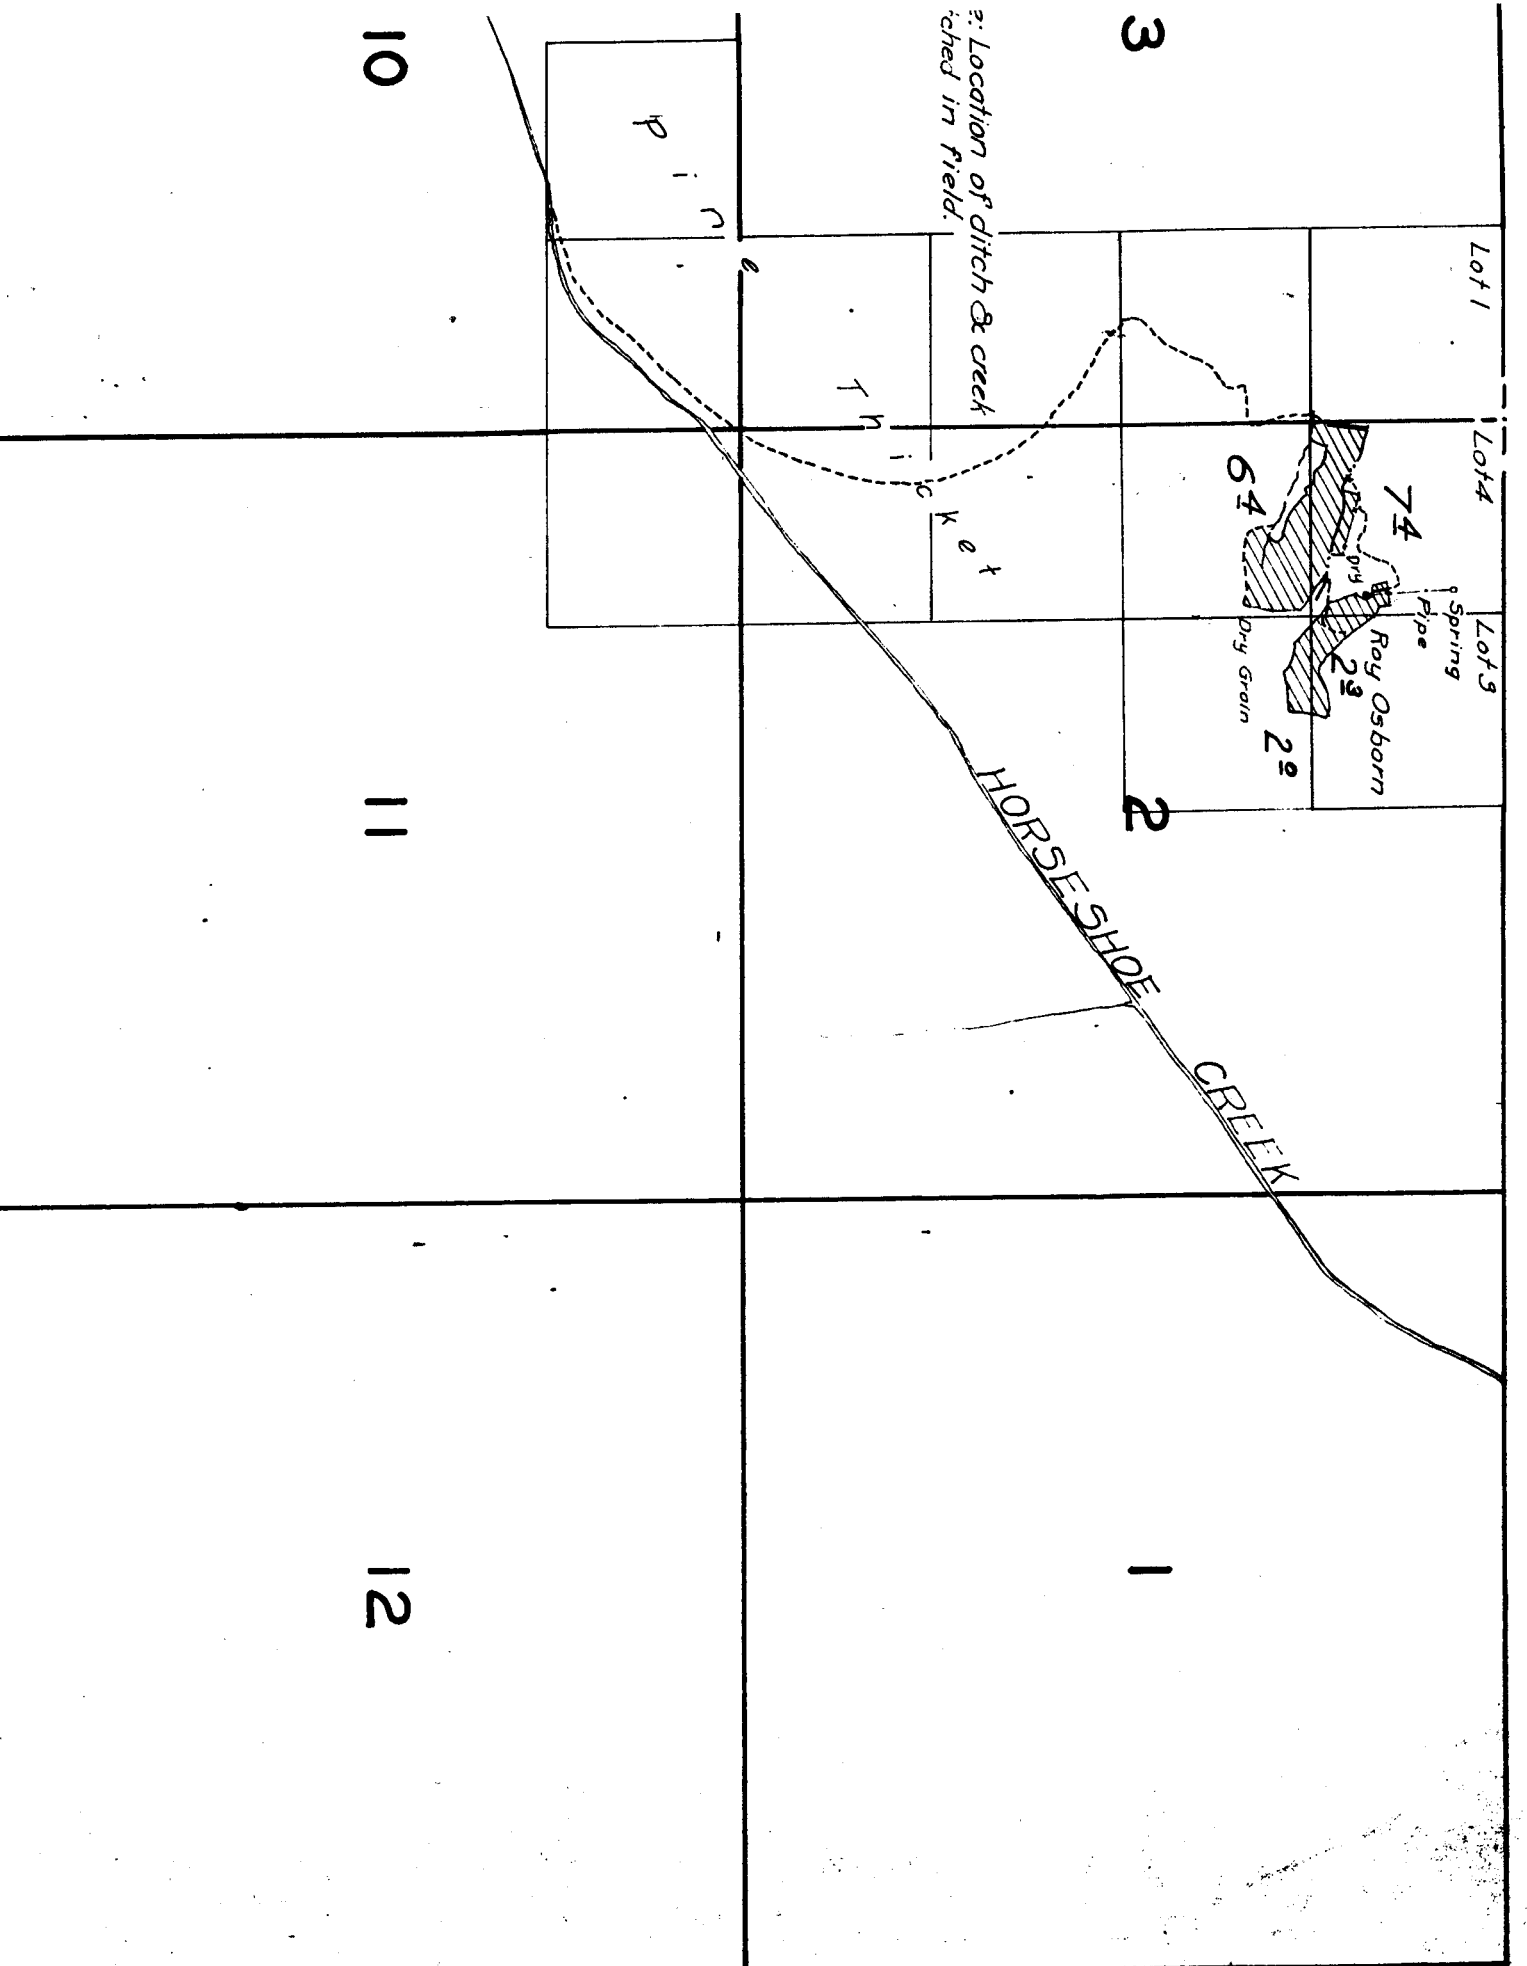

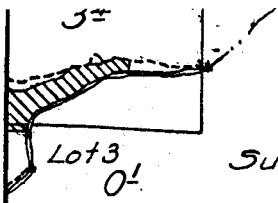


19

20

Surveyed Nov. 6, 1925.

30


29

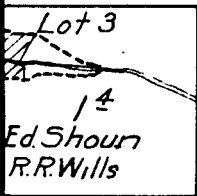

31

32

TOWNSHIP 10 S., RANGE 23 E.

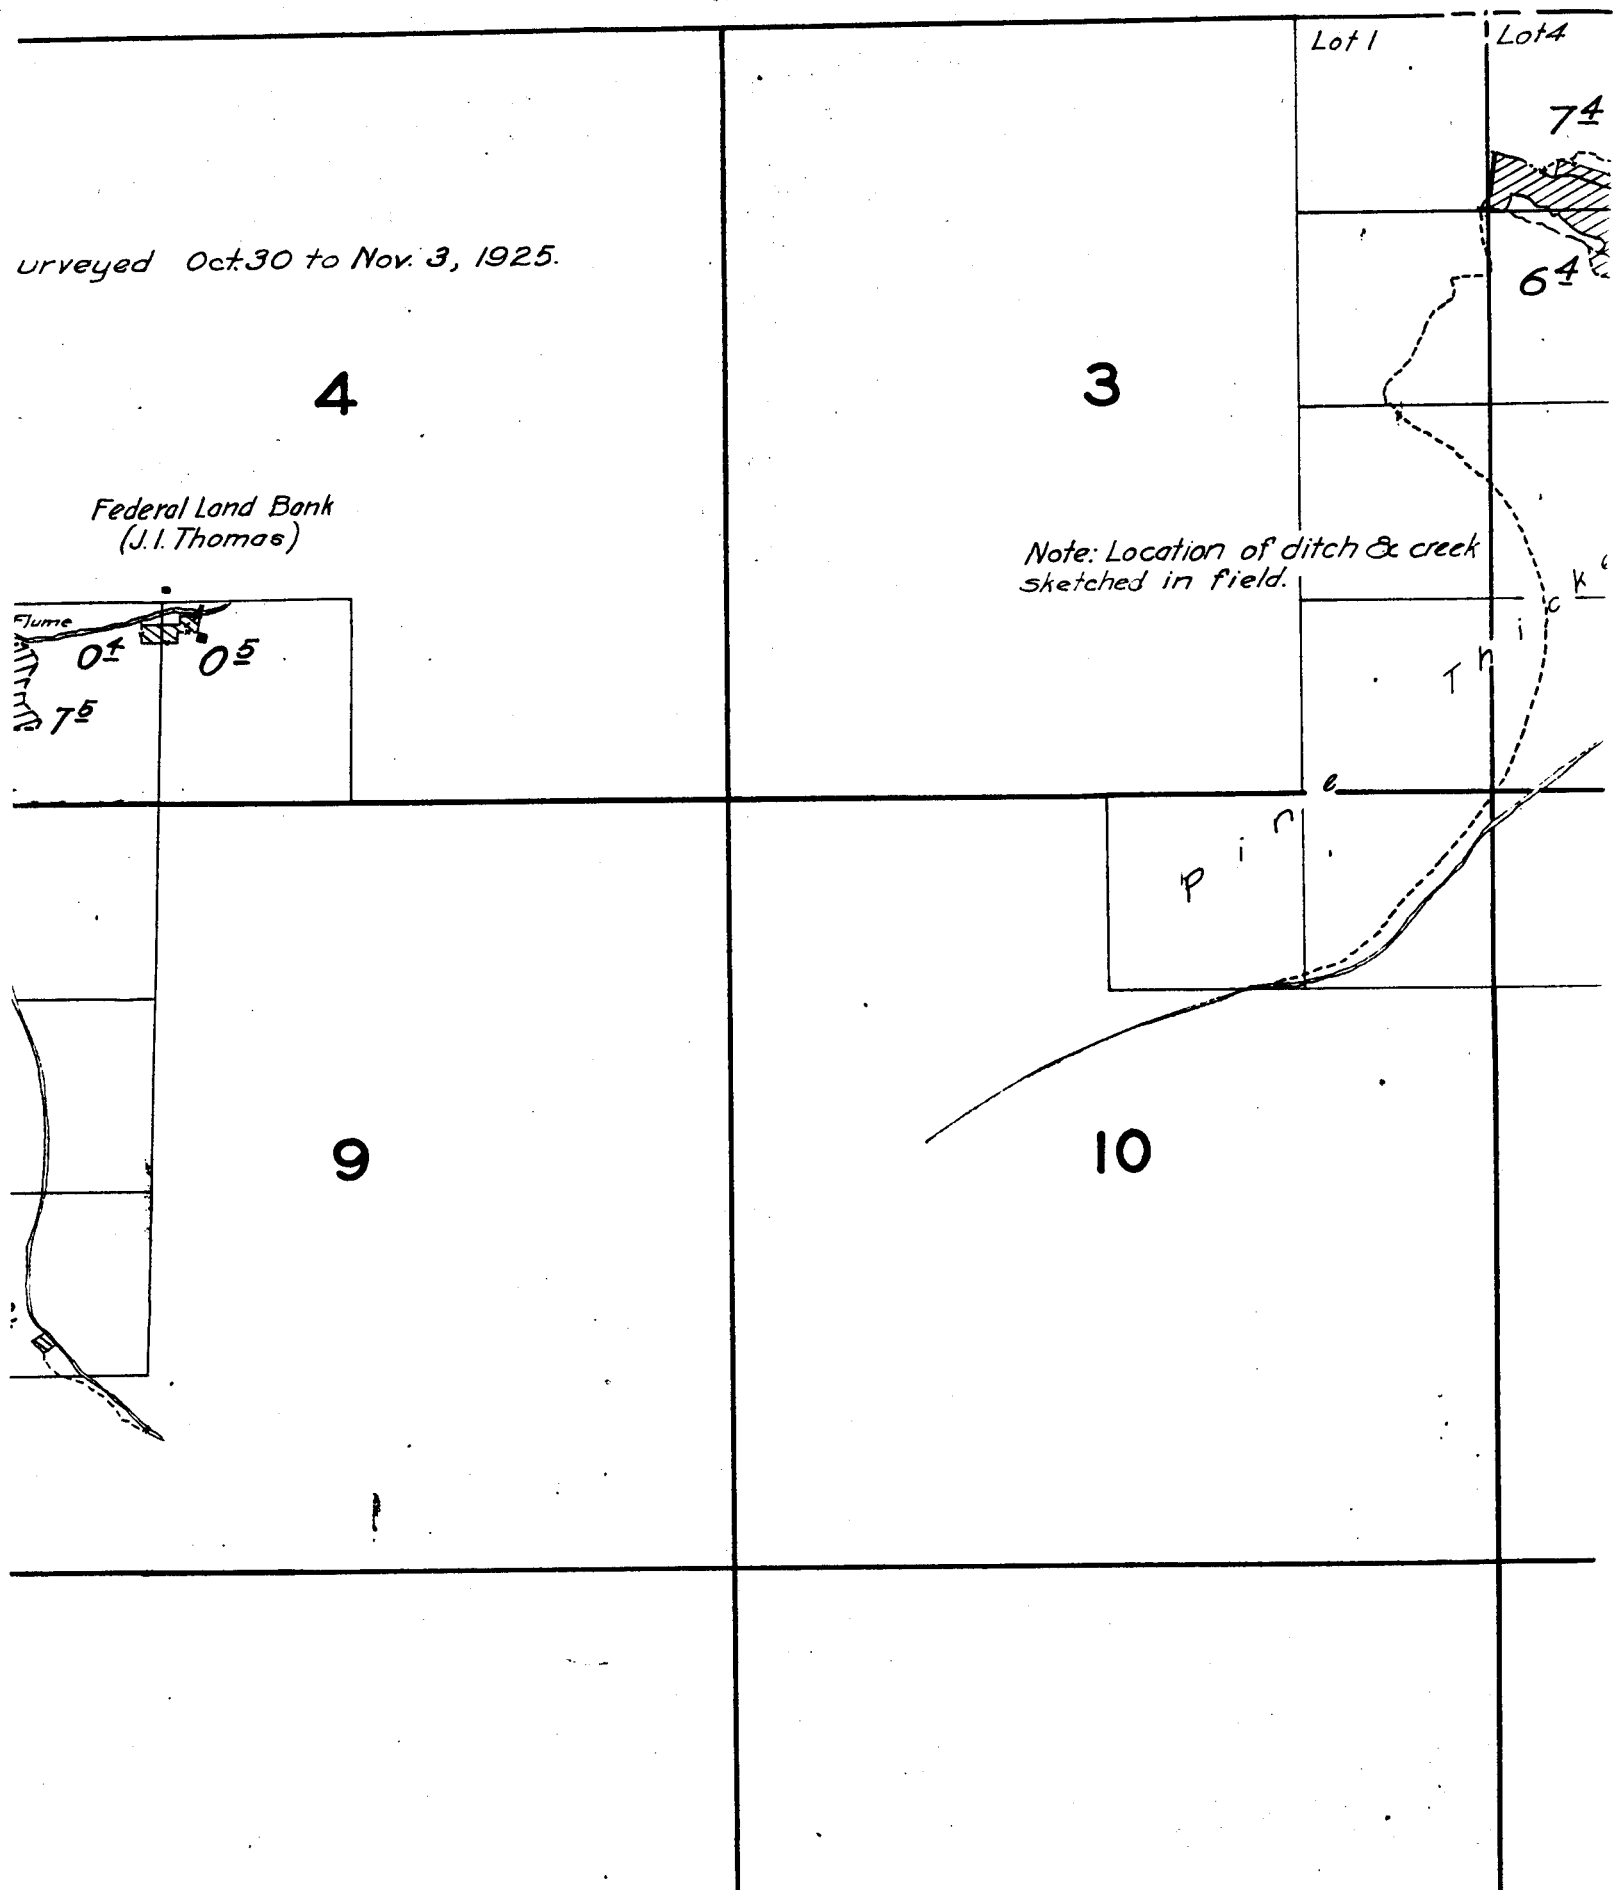

23

24

26

25

35

36


TOWNST

Surveyed Oct. 30 to 1

4

Federal Land Bank
(J.I. Thomas)

9

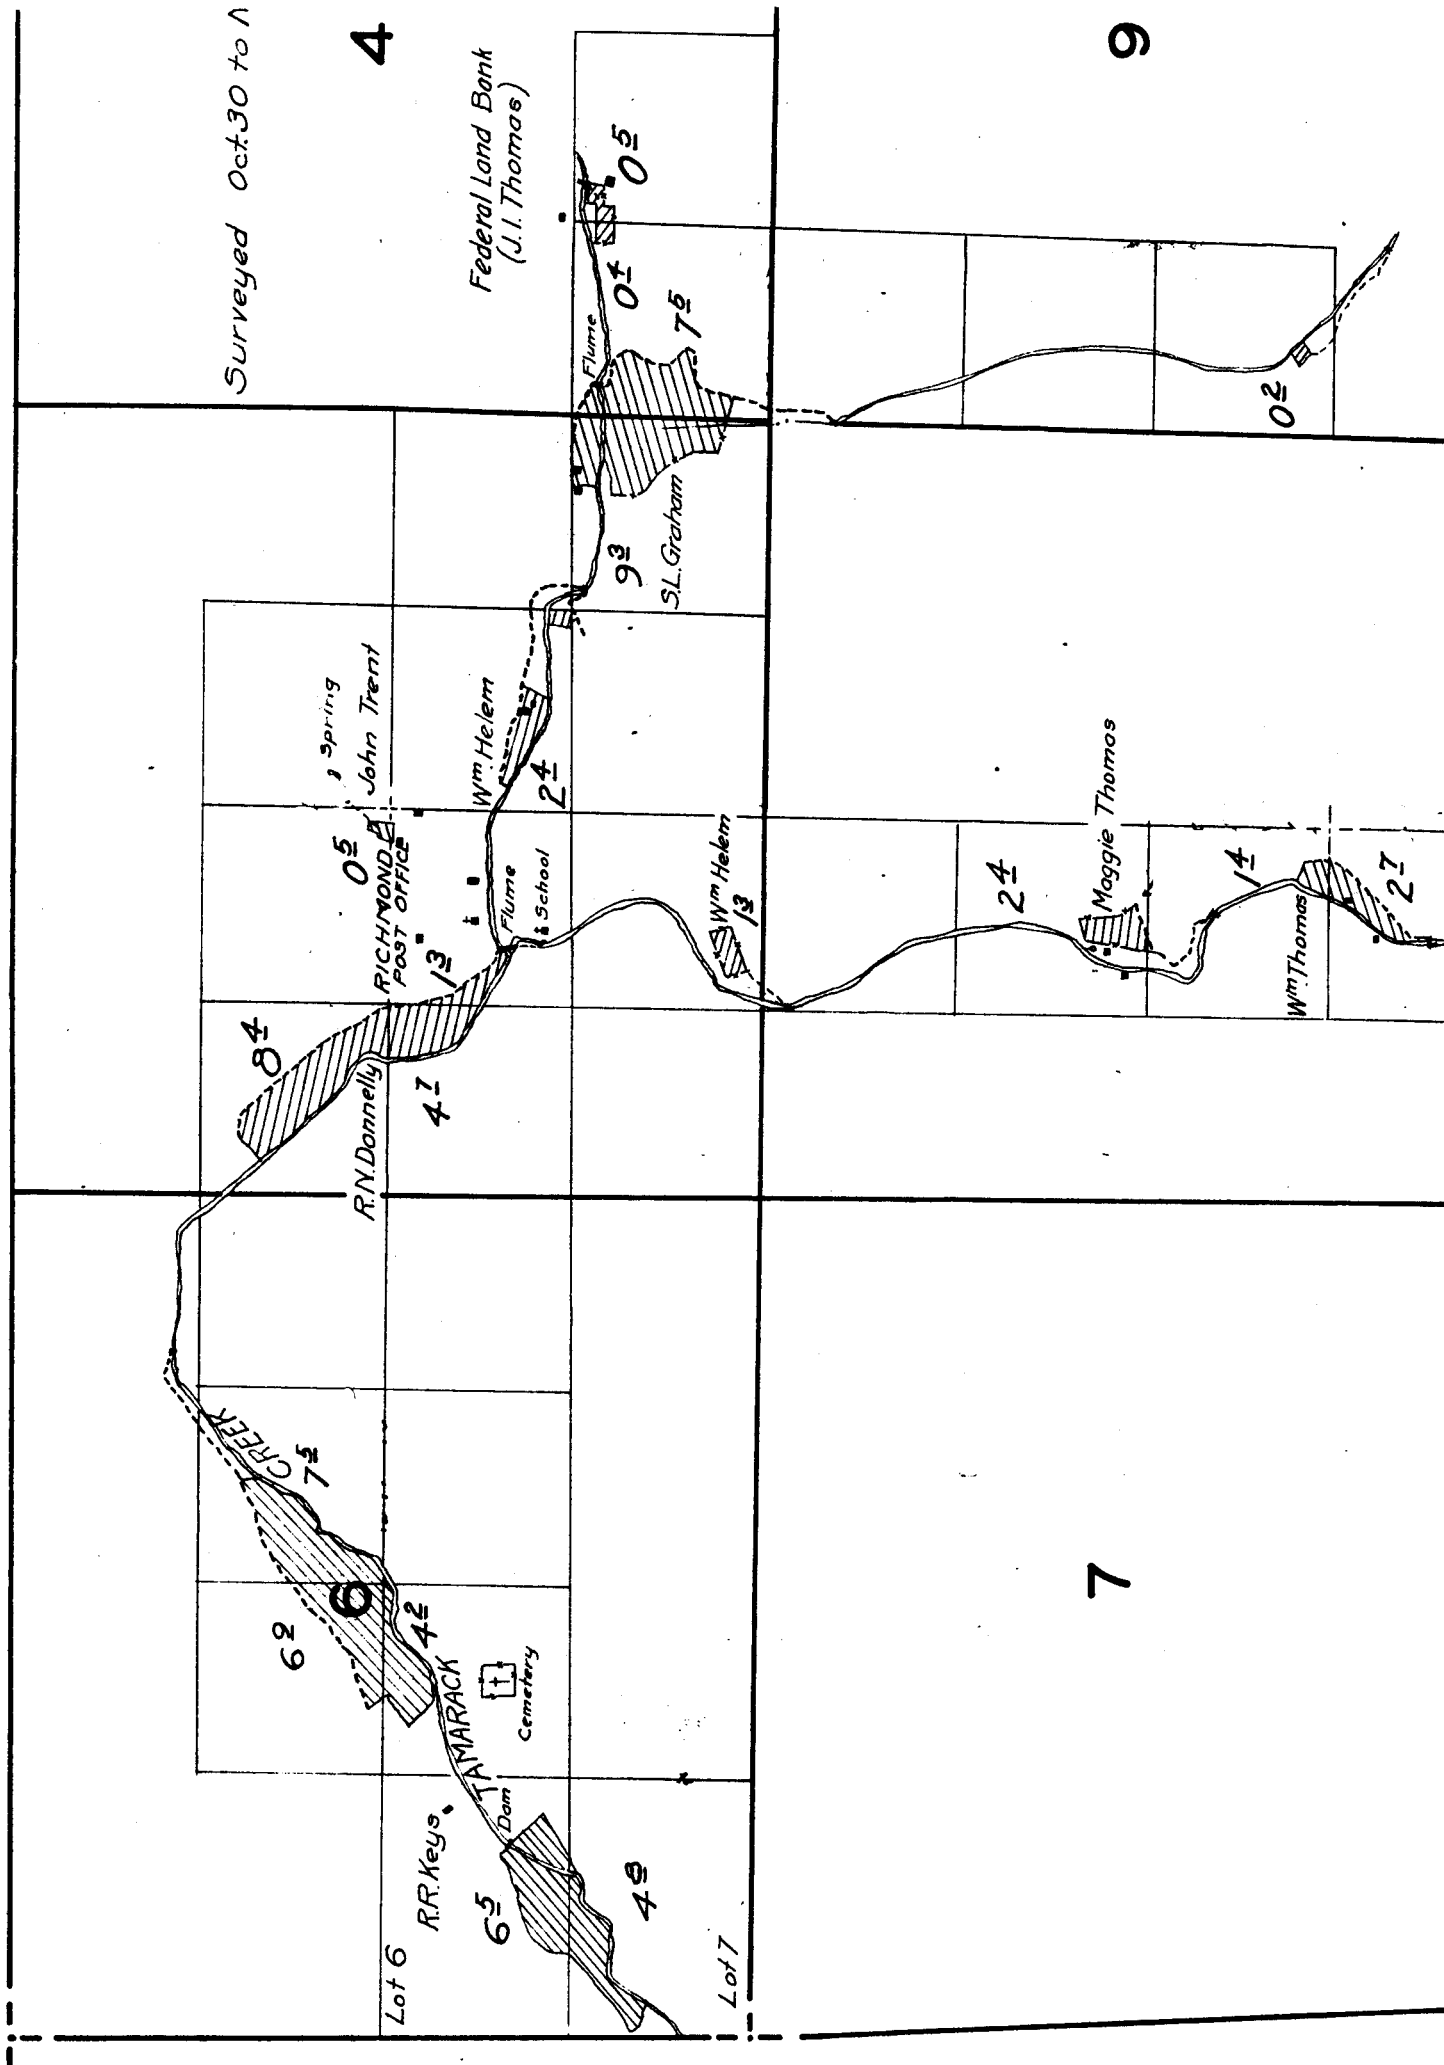

16

*Note: Streams, except,
irrigated land, sketched
location.*

21

17

20

18

19

04

Thomas Mabe

Lot 2

34

Lot 3

Surveyed Nov. 6, 1925.