

2

1

1^o

2^o

0³

Rock

J.E. Butler
Gage

urveyed Nov. 7 1925.

1

12

0²


L.H. Wright

14

13

CREEK

HORSESHOE

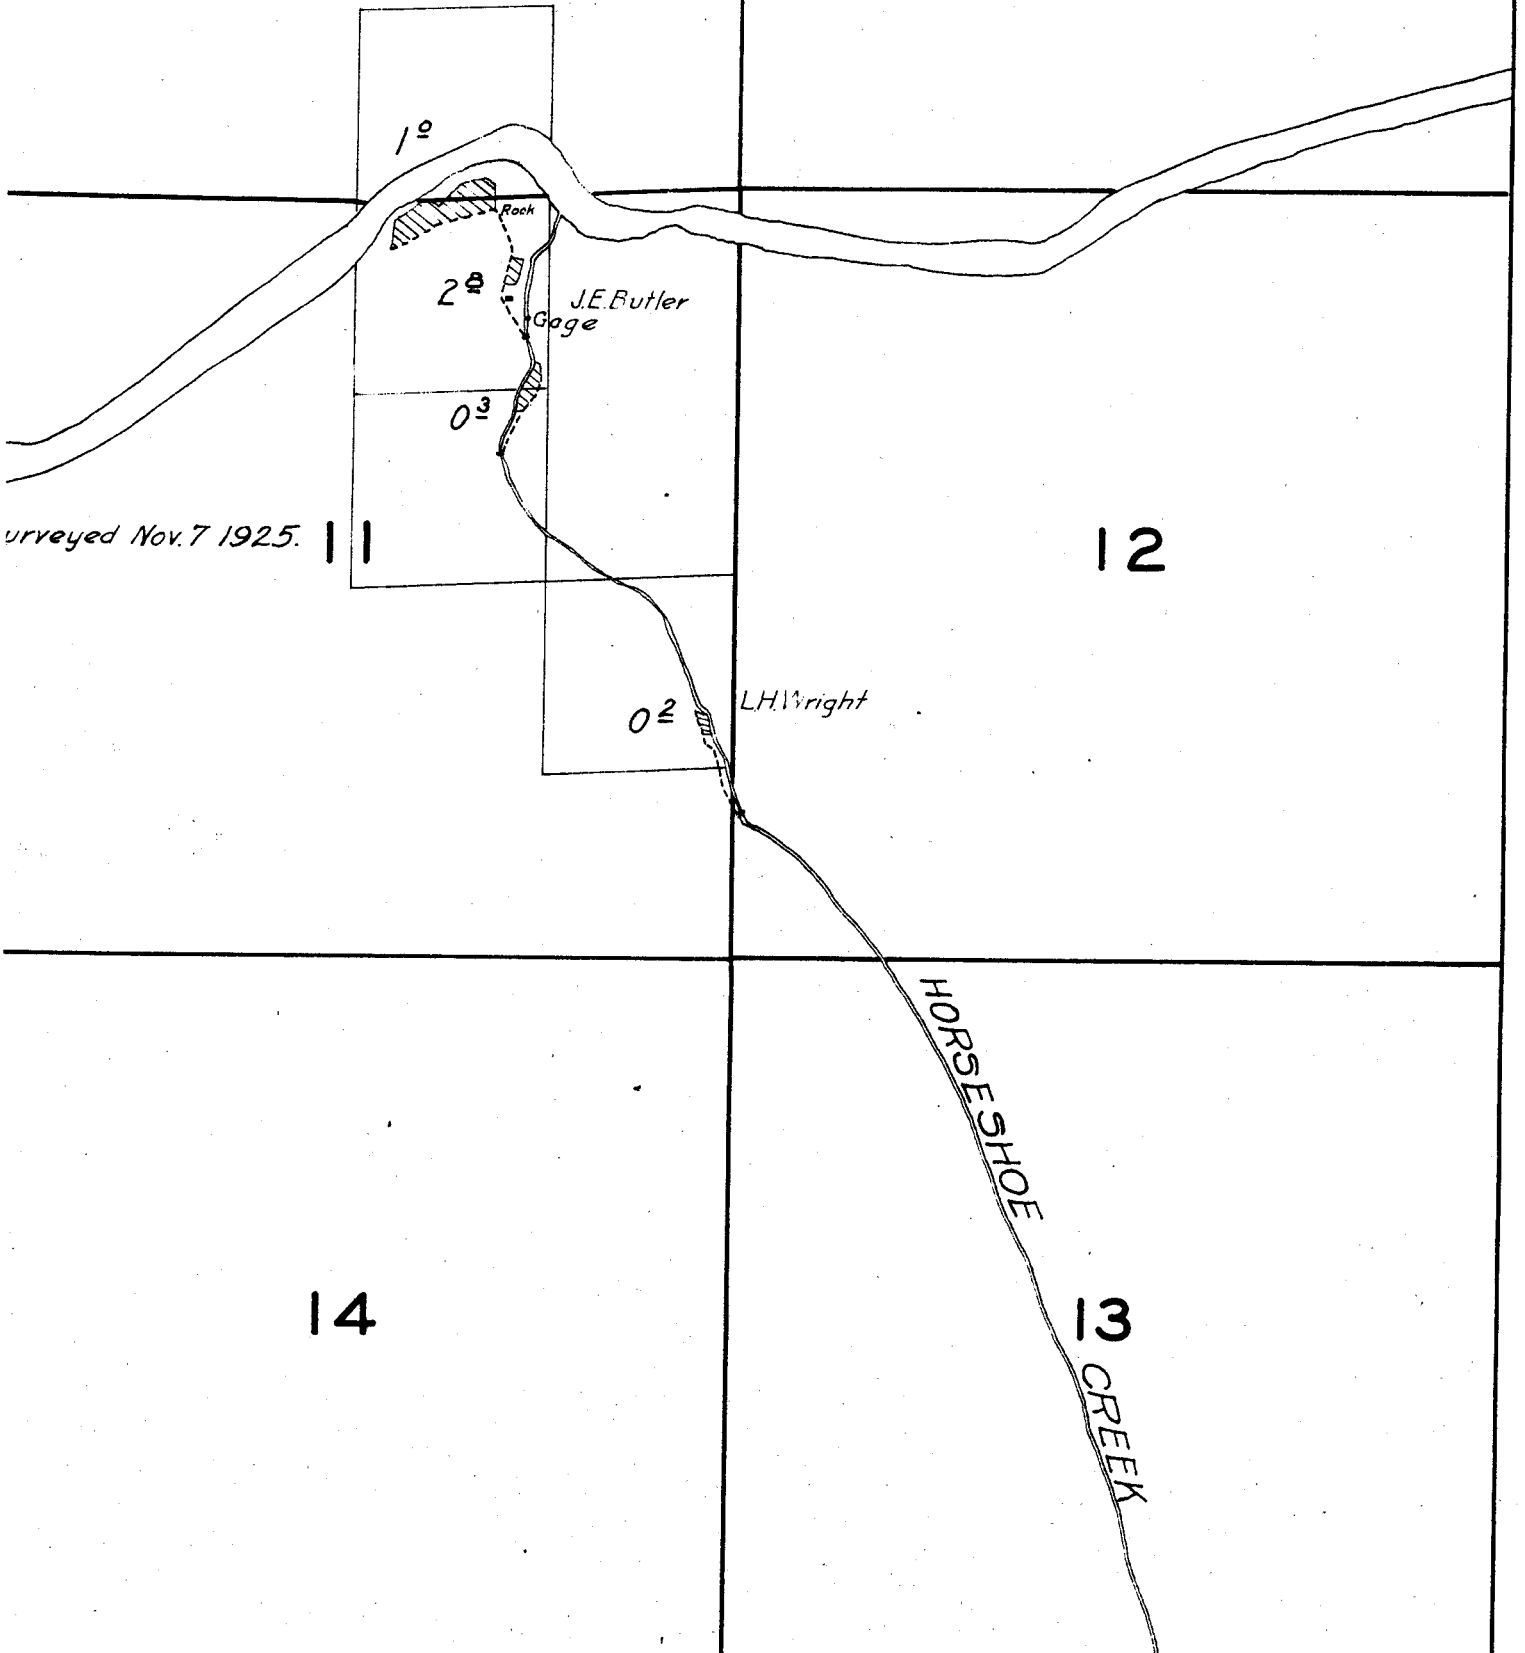

21

22

28

27

33

34

6

5

Surveyed Oct 26, 22, 23, 1925.

7

8

John Day
Hwy

Lot 1

Lot 2

SERVICE

Lot 3

M.J. Campbell

Ross Thomas

Lot 4

John Tilley

SERVICE CREEK
POST OFFICE

JOHN

5°

DAY

60° 5' CREEK

Lot 1

8°

5°

John Tilley

3°

6°

Keys Donnelly

18

4°

Lot 2

O'Pipe

4°

Lot 3

S.J. Howard

Lot 4

4°

3°

2°

1 1/2" Pipe

17

7

NOTE: Streams and river except in the vicinity of irrigated land, sketch in approximate location.

16


15


35

21

22

NOTE: Streams and vicinity of irrigated approximate location.

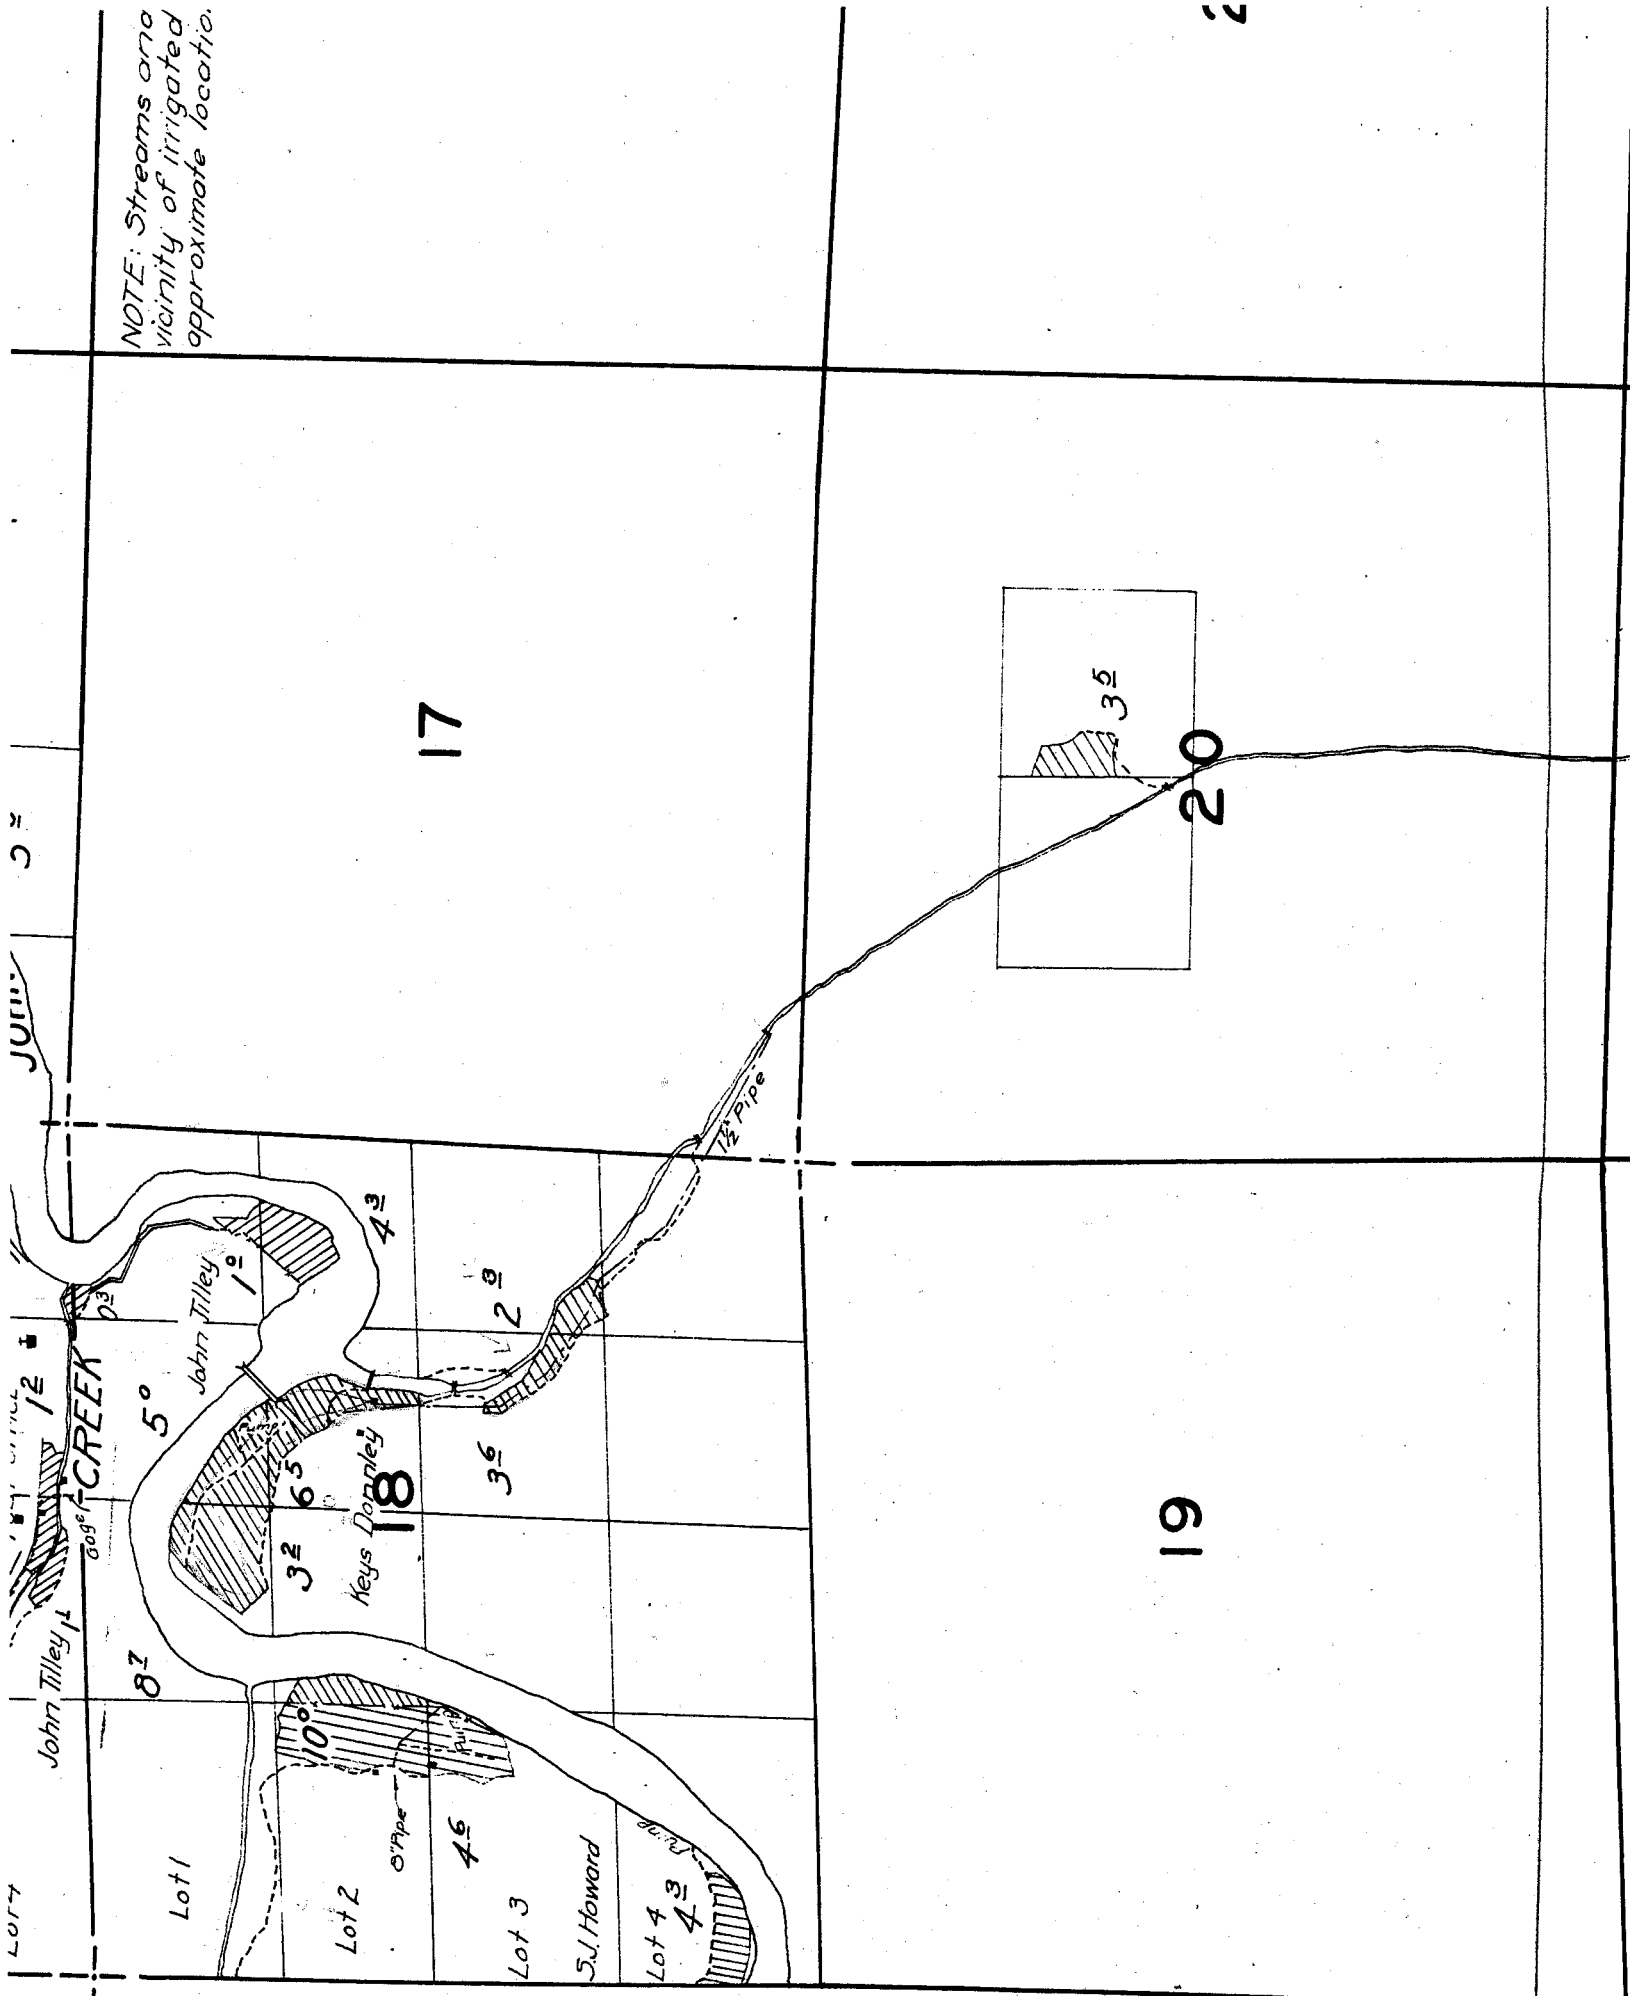

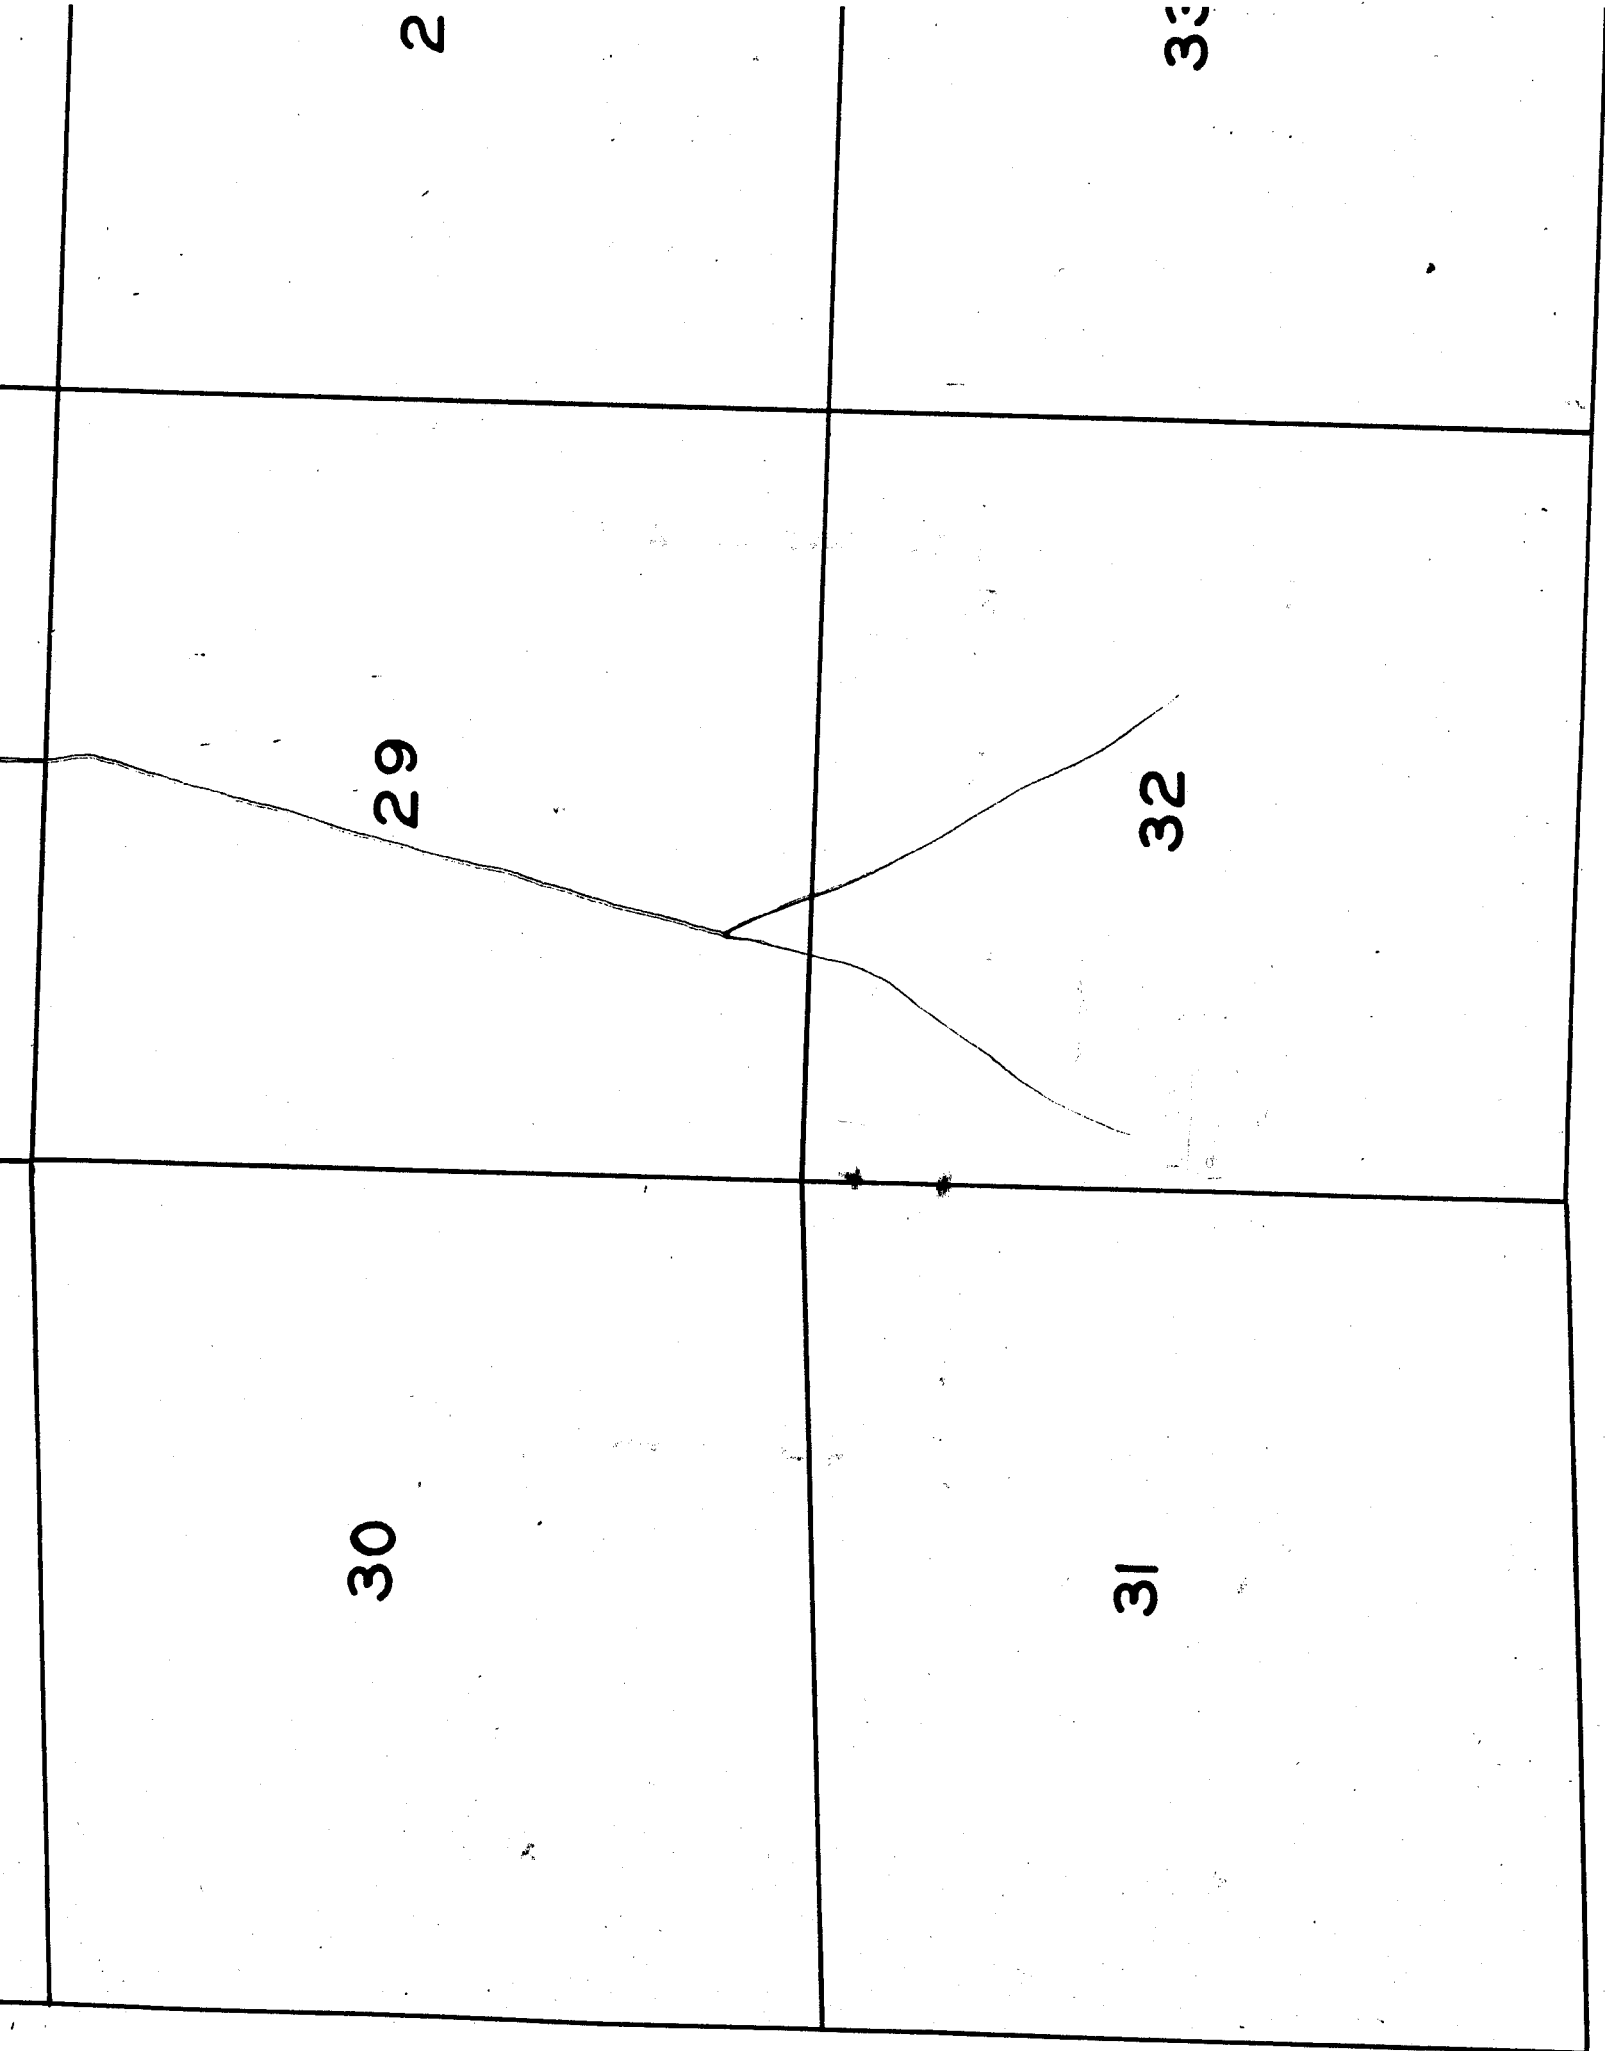

HORSESHOE
13 CREEK


14

15


24

23

22

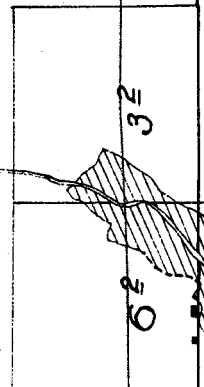

Surveyed — Oct 30, 1925.

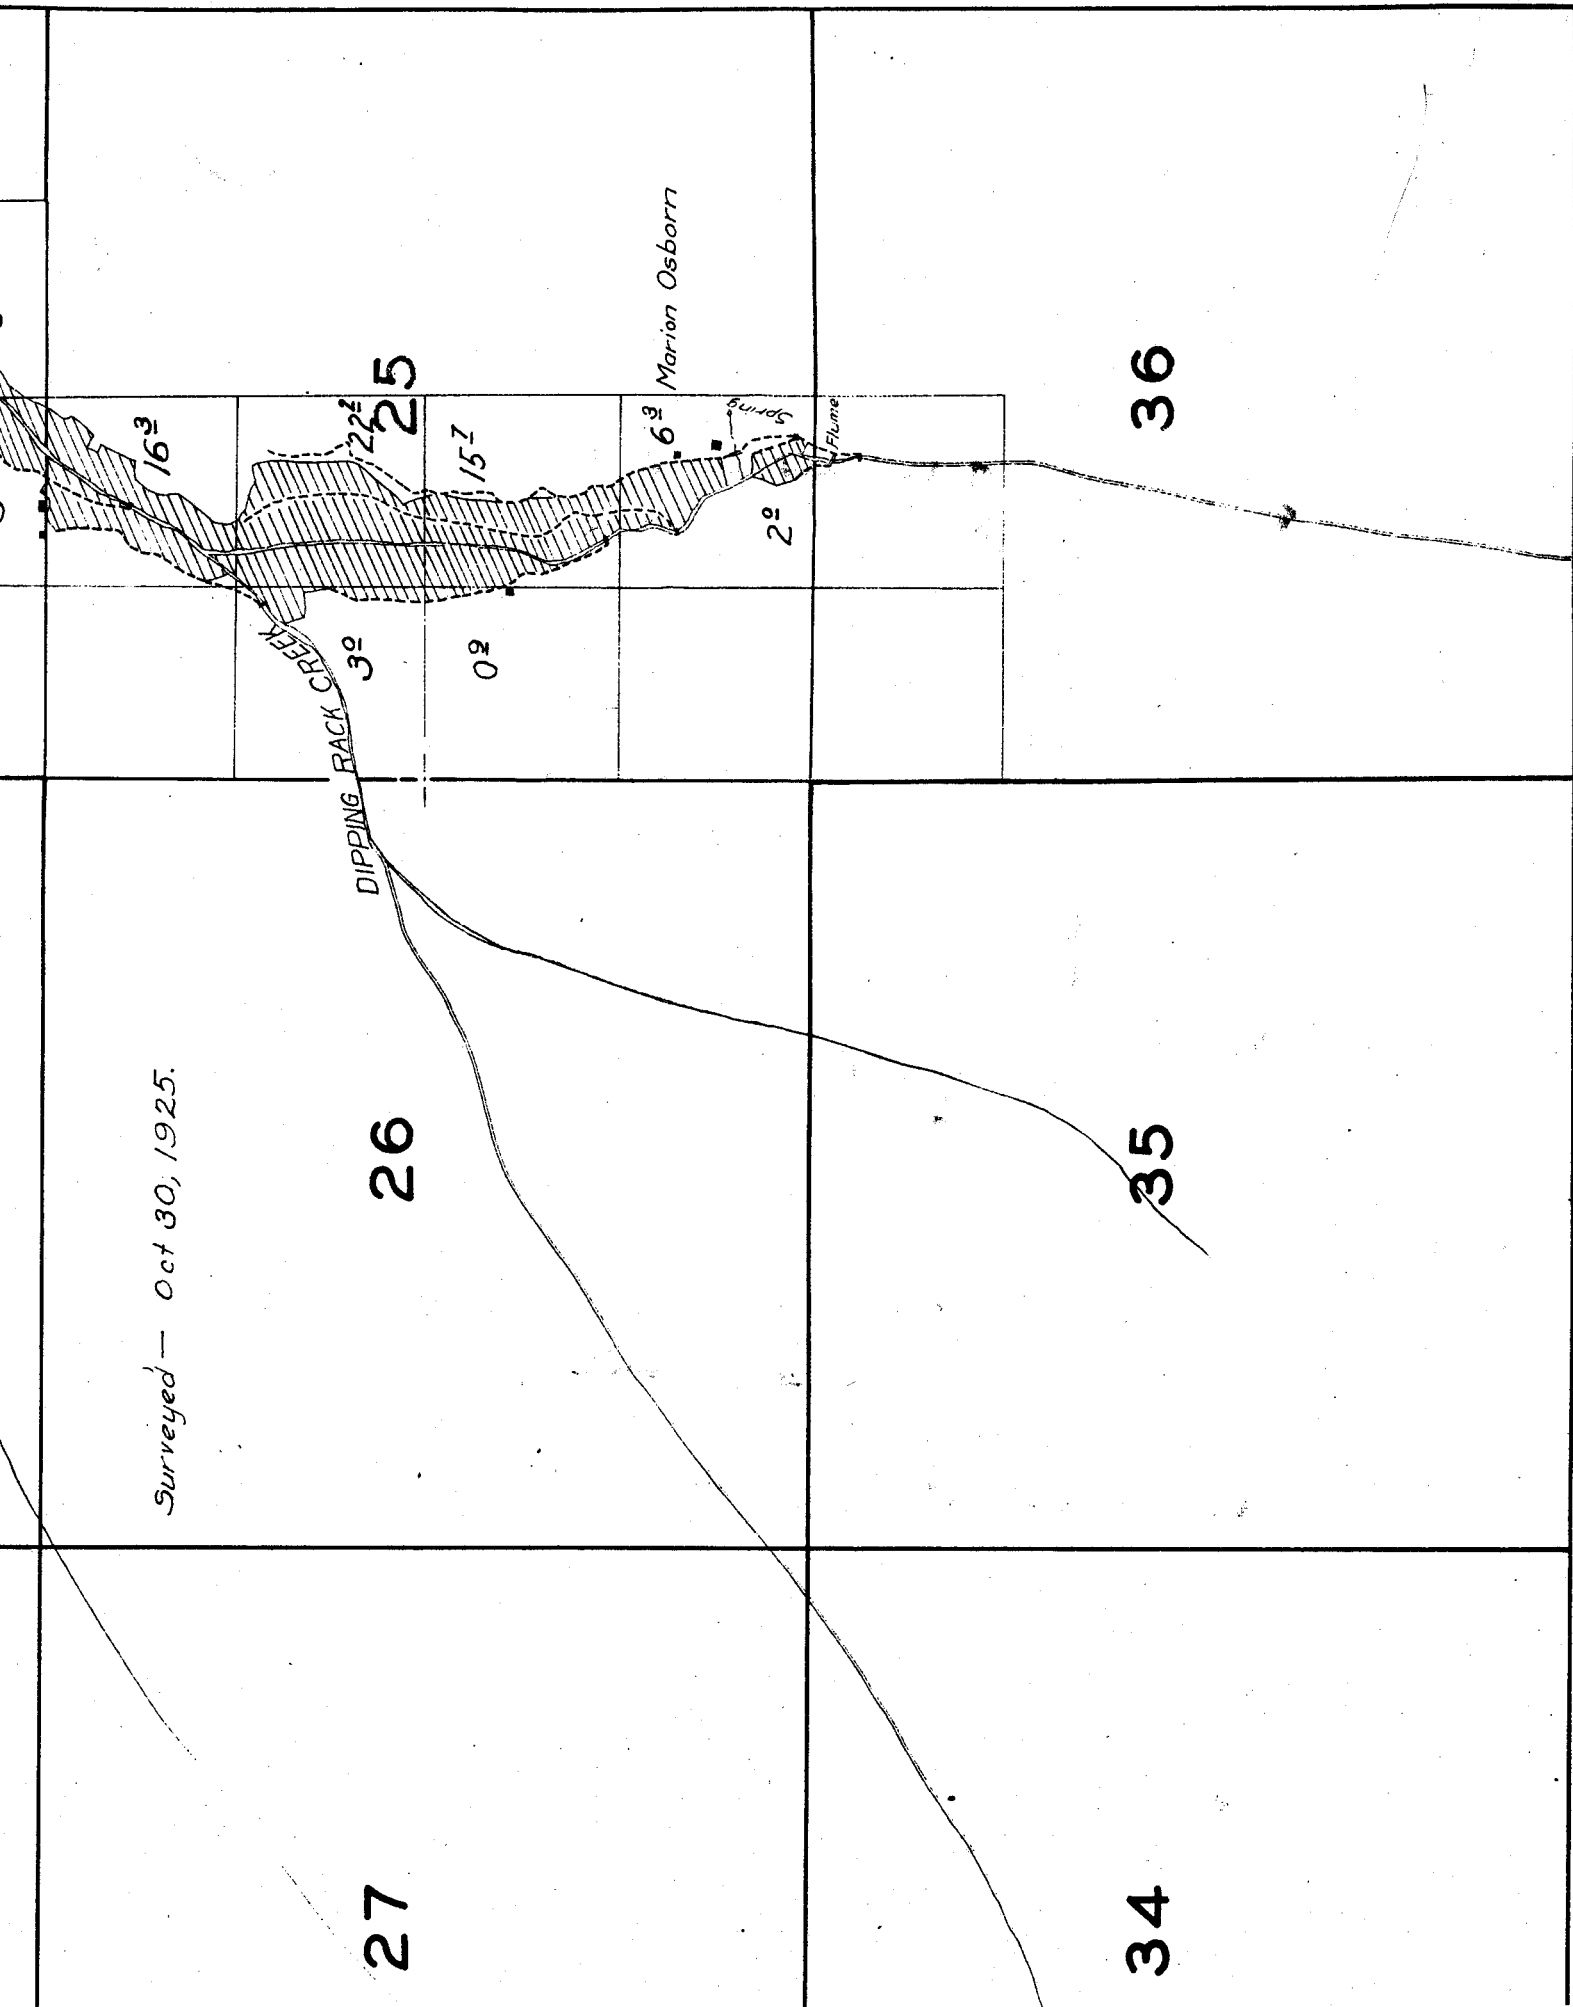

35

7

NOTE: Streams and river except in the vicinity of irrigated land, sketch in approximate location.

16

15

21

22

TOWNSHIP 9 S., RANGE 23 E.

