

NOTE: Streams and river except in the vicinity of irrigated land, sketch in approximate location.

7

16

15

35

21

22


6

5

Surveyed Oct. 26, 22, 23, 1925.

7

8

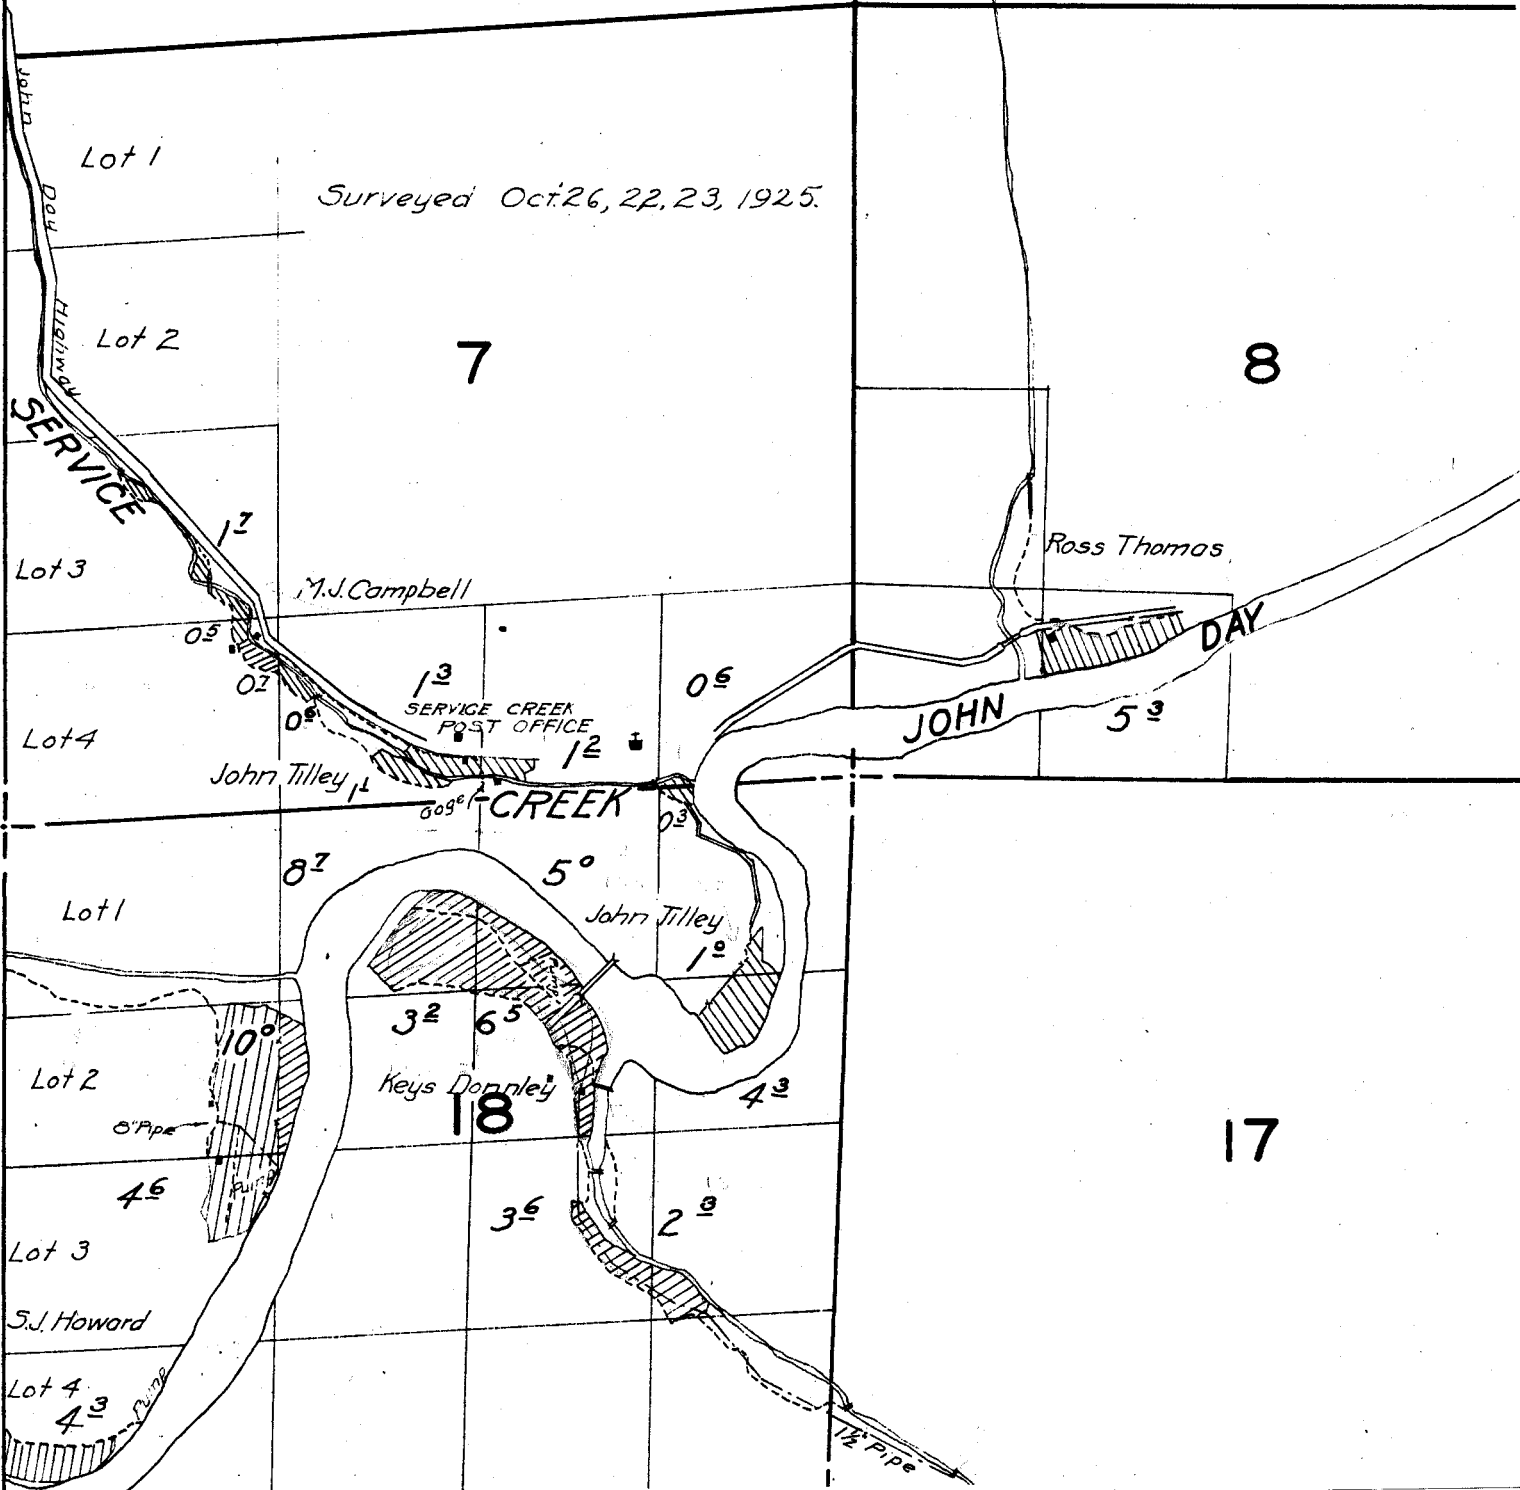

21

22

28


27

33

34

2

1

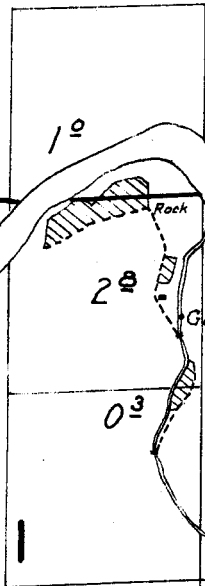

urveyed Nov. 7 1925.

11

12

02

L.H. Wright

14

13
CREEK

HORSESHOE

HORSESHOE CREEK

13

24

14

23


15

22

32

62

Surveyed - Oct 30, 1925.

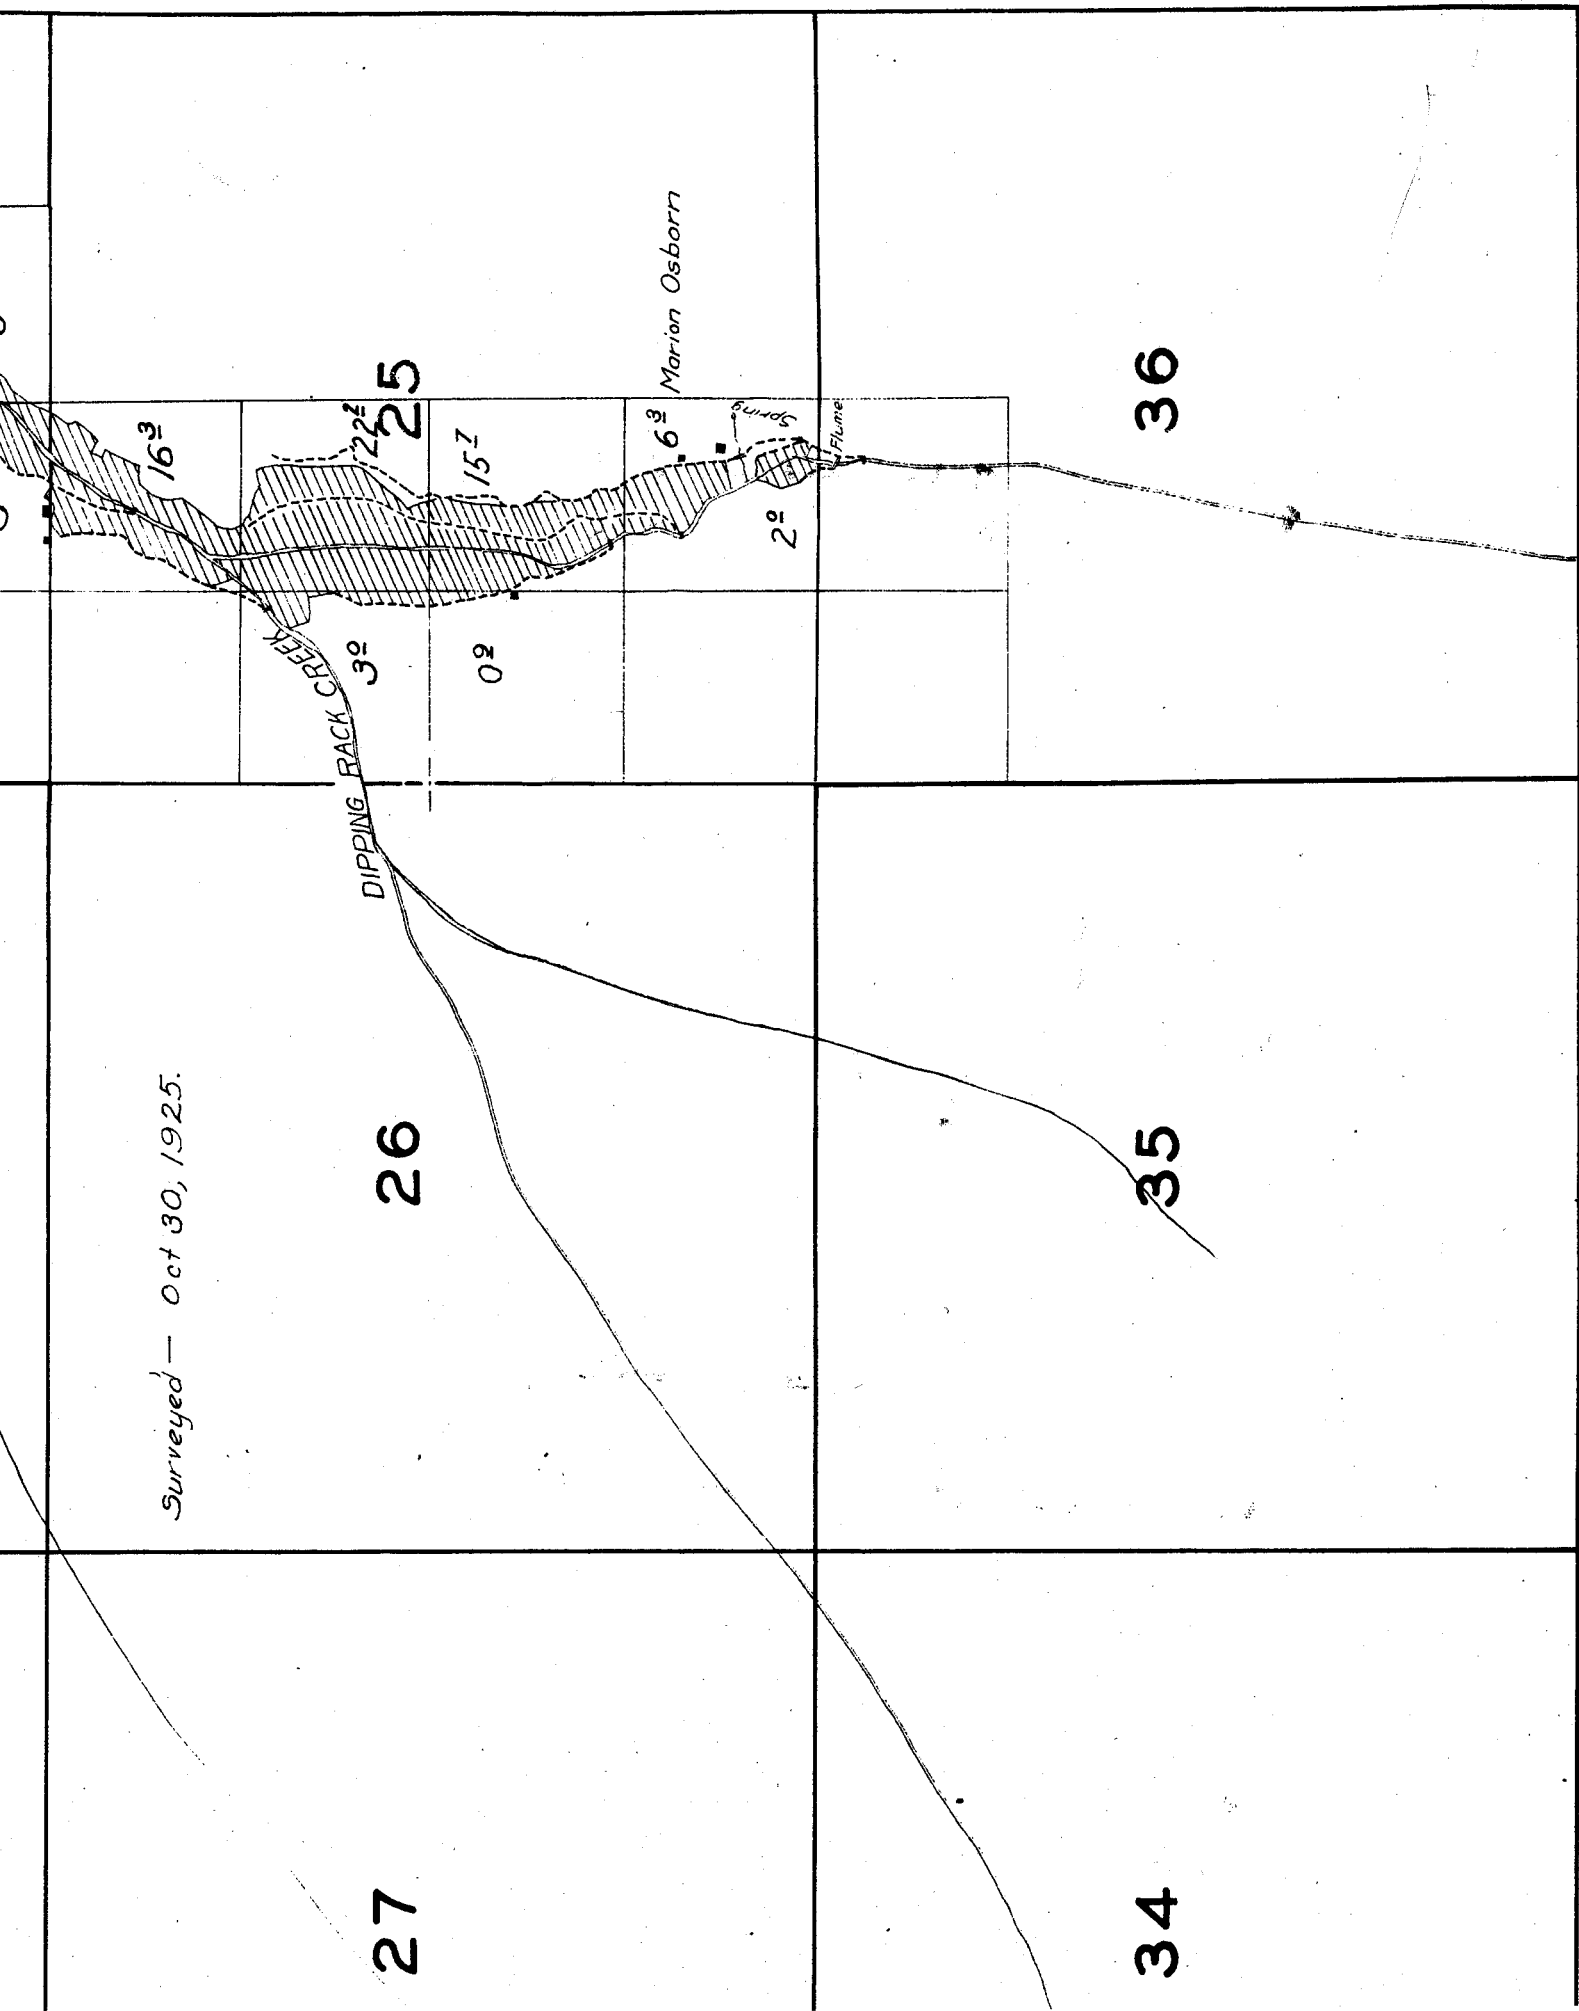

30


29

2

31

32

33

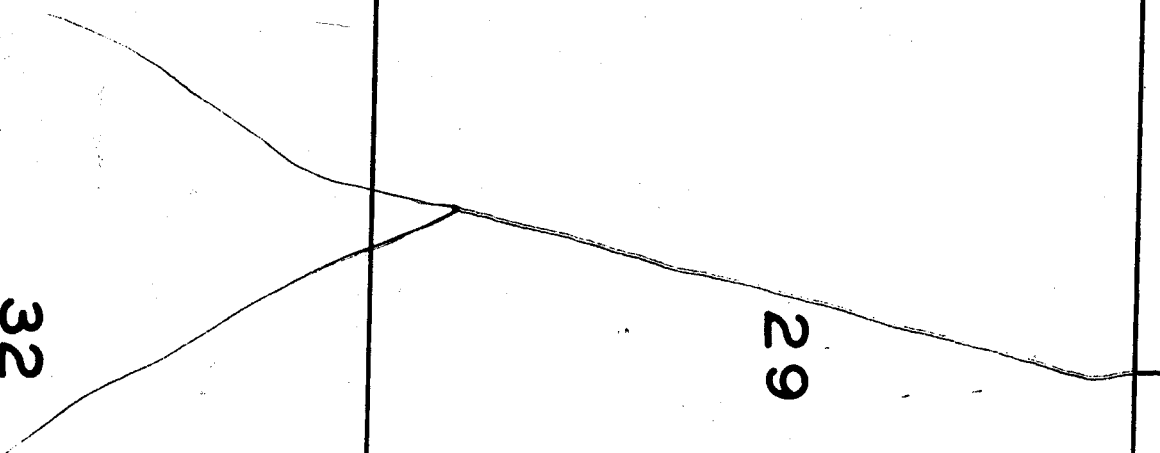

NOTE: Streams are in vicinity of irrigated approximate locatio.

