

17

16

15

*Note: Streams, except in the vicinity of
irrigated land, sketched in approximate
location.*

20

21

22

29

28

27

32

33

34

15


14


13

22

23

24

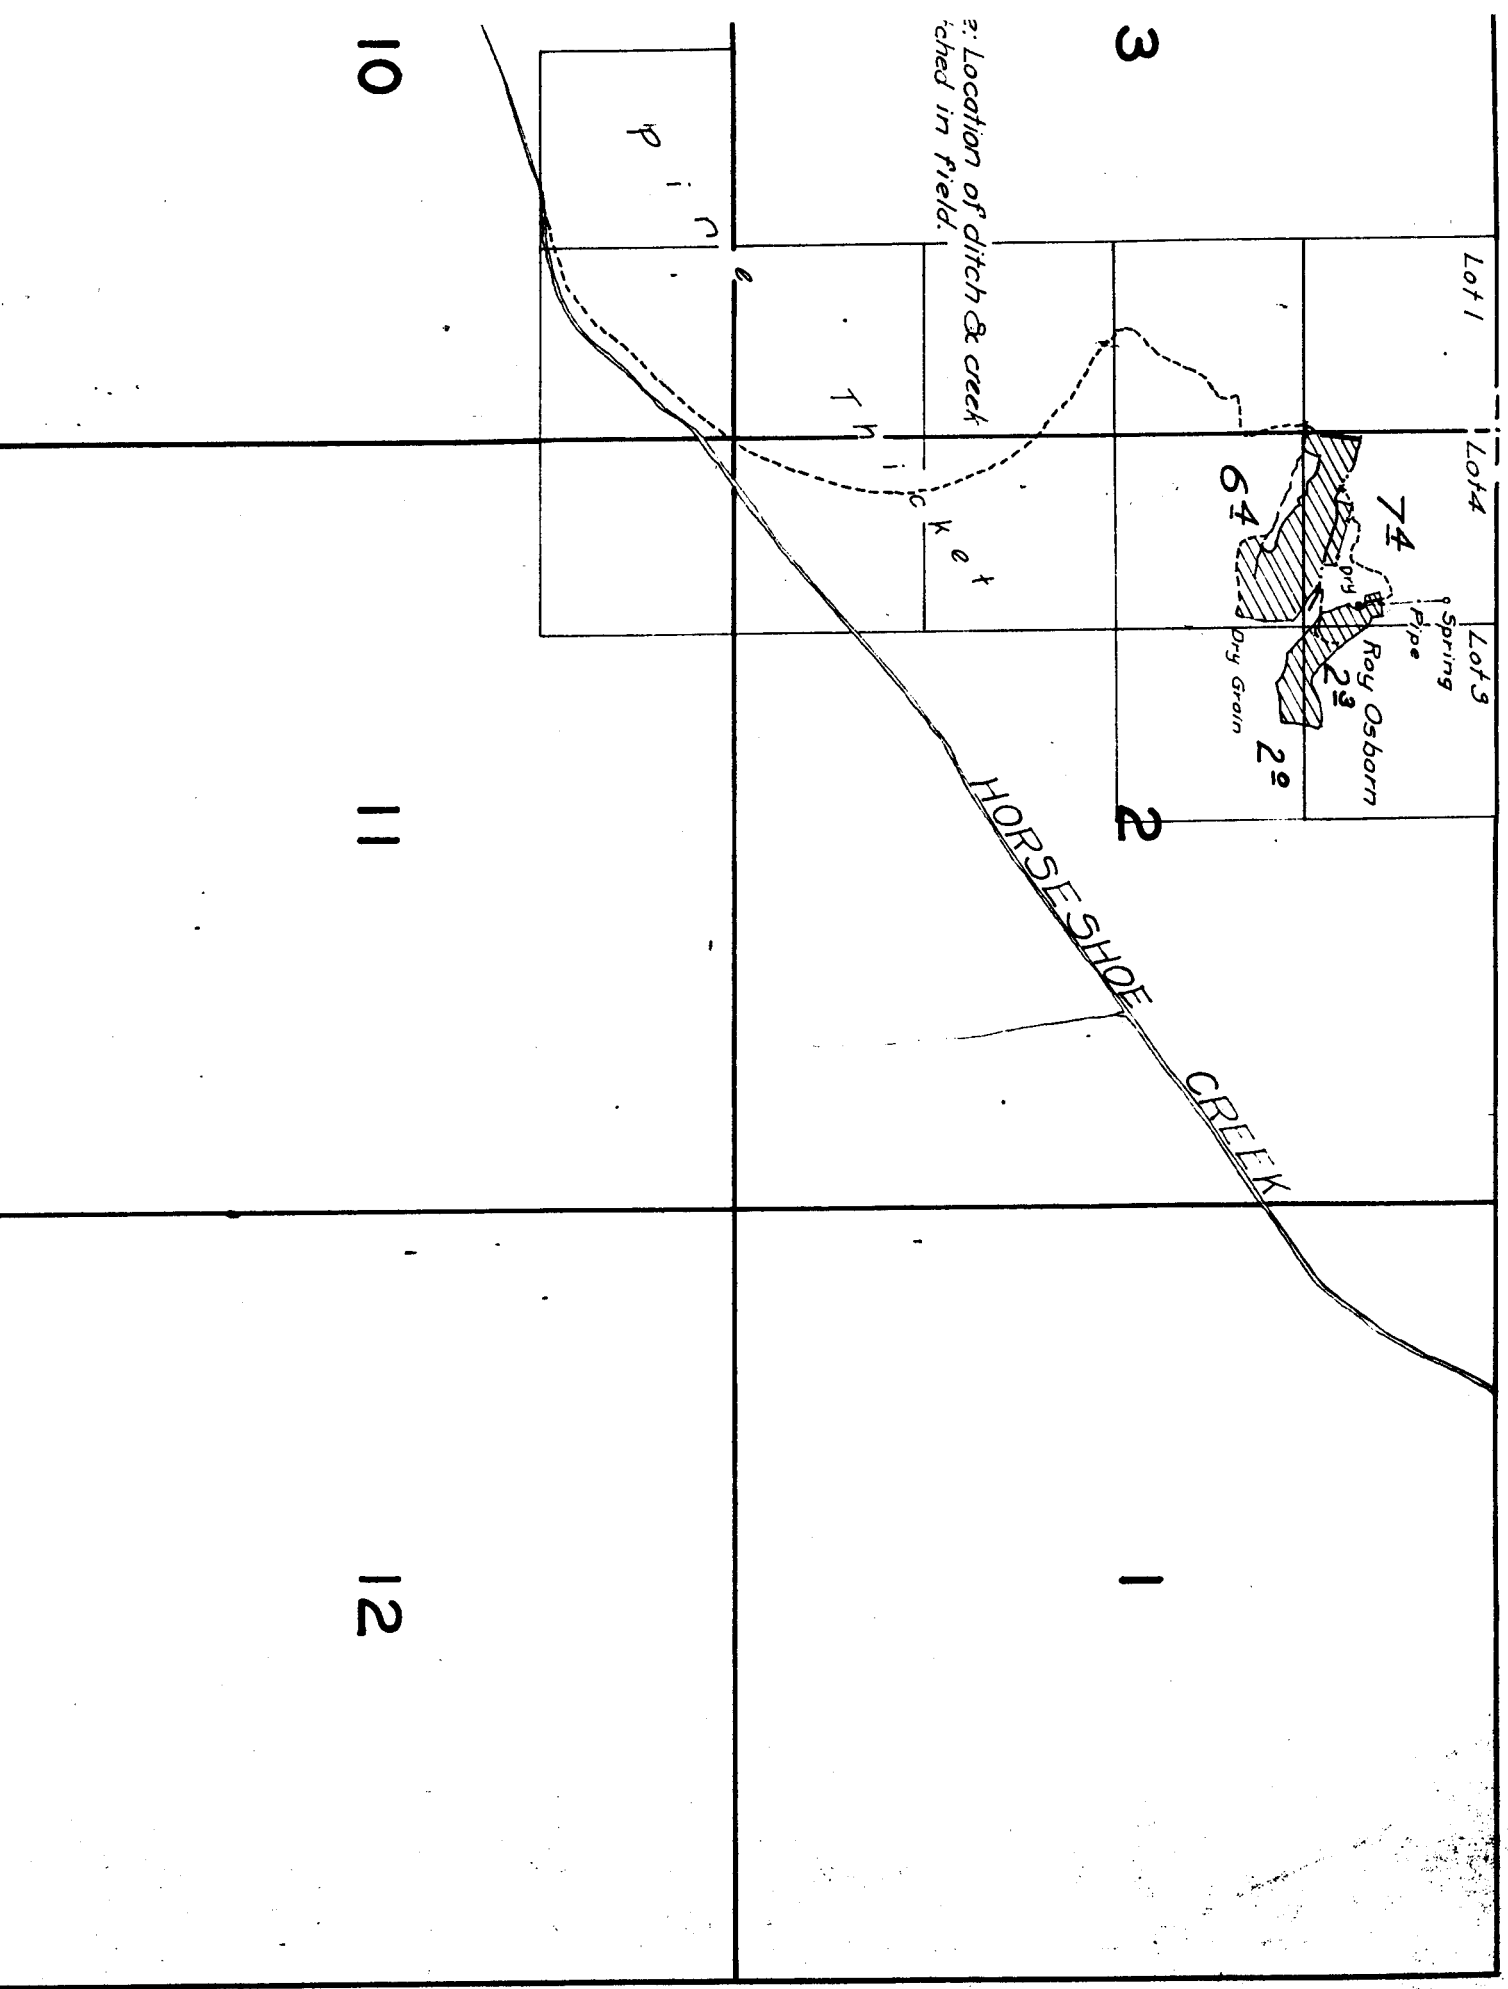

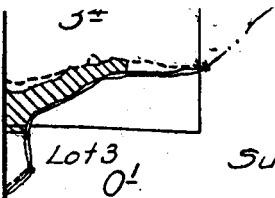


19

20

Surveyed Nov. 6, 1925.

30

29

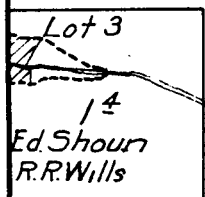

31

32

23

24

26

25

35


36

TOWNSHIP 10 S., RANGE 23 E.

urveyed Oct. 30 to Nov. 3, 1925.

4

Federal Land Bank
(J.I. Thomas)

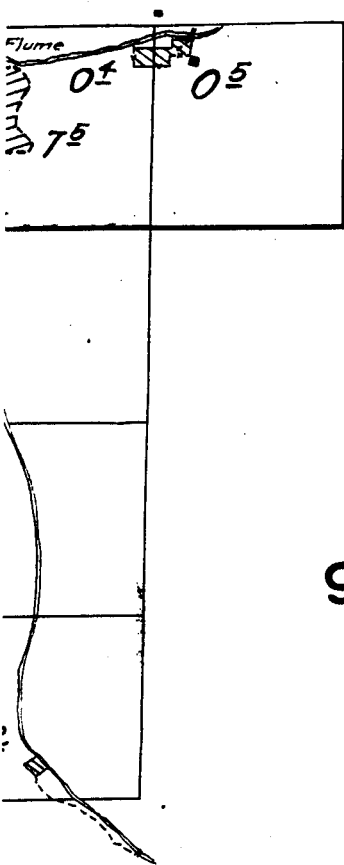

3

Note: Location of ditch & creek
sketched in field.

Lot 1

Lot 4

74

64

Thick

pin

9

10


TOWNSHIP

Surveyed Oct. 30 to 1


4

Federal Land Bank
(J.I. Thomas)

9

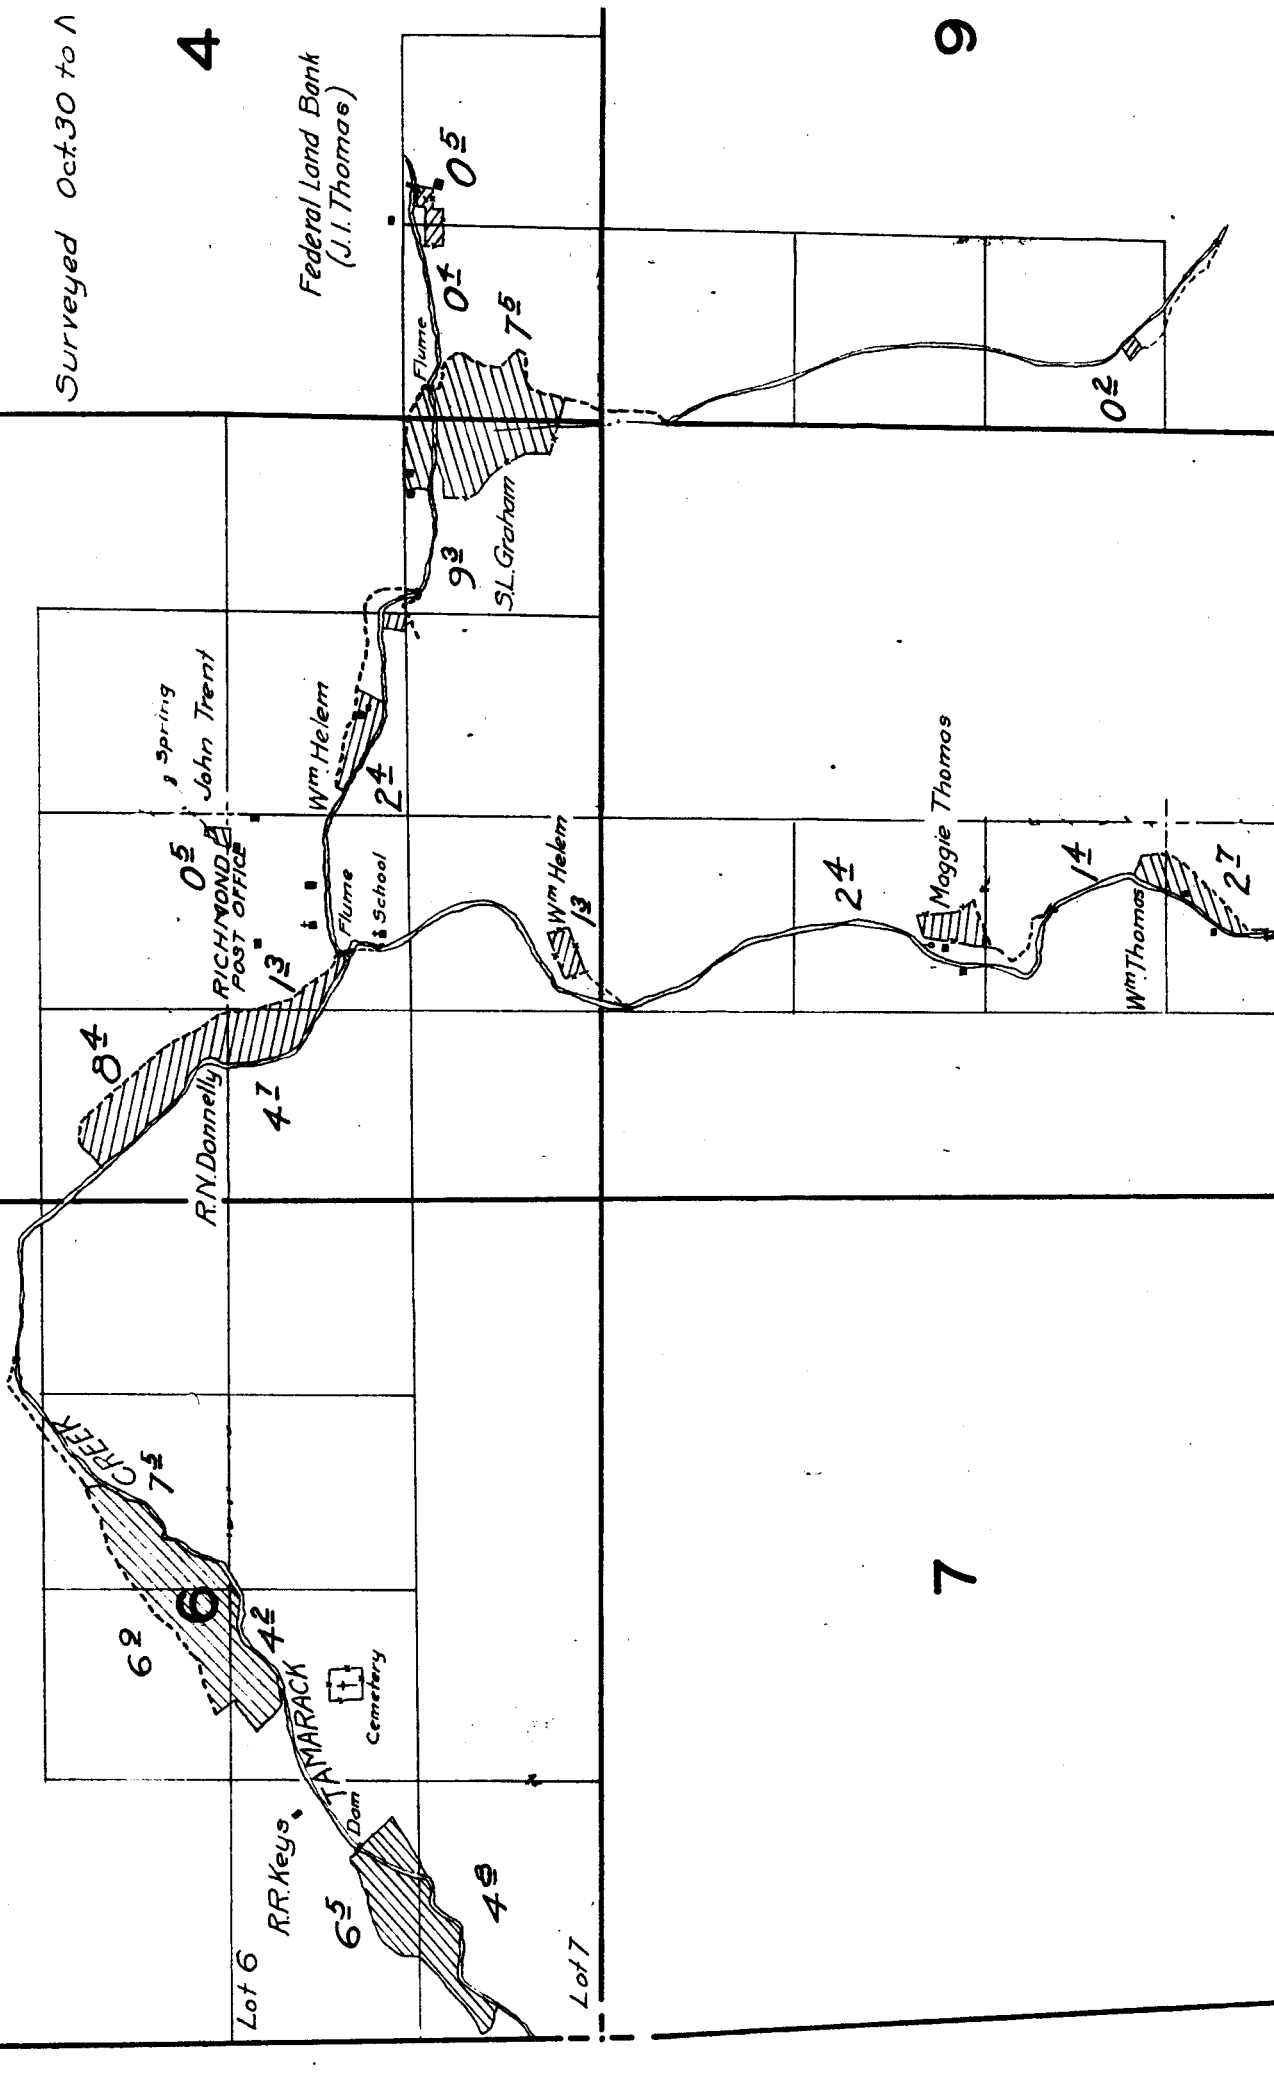

7

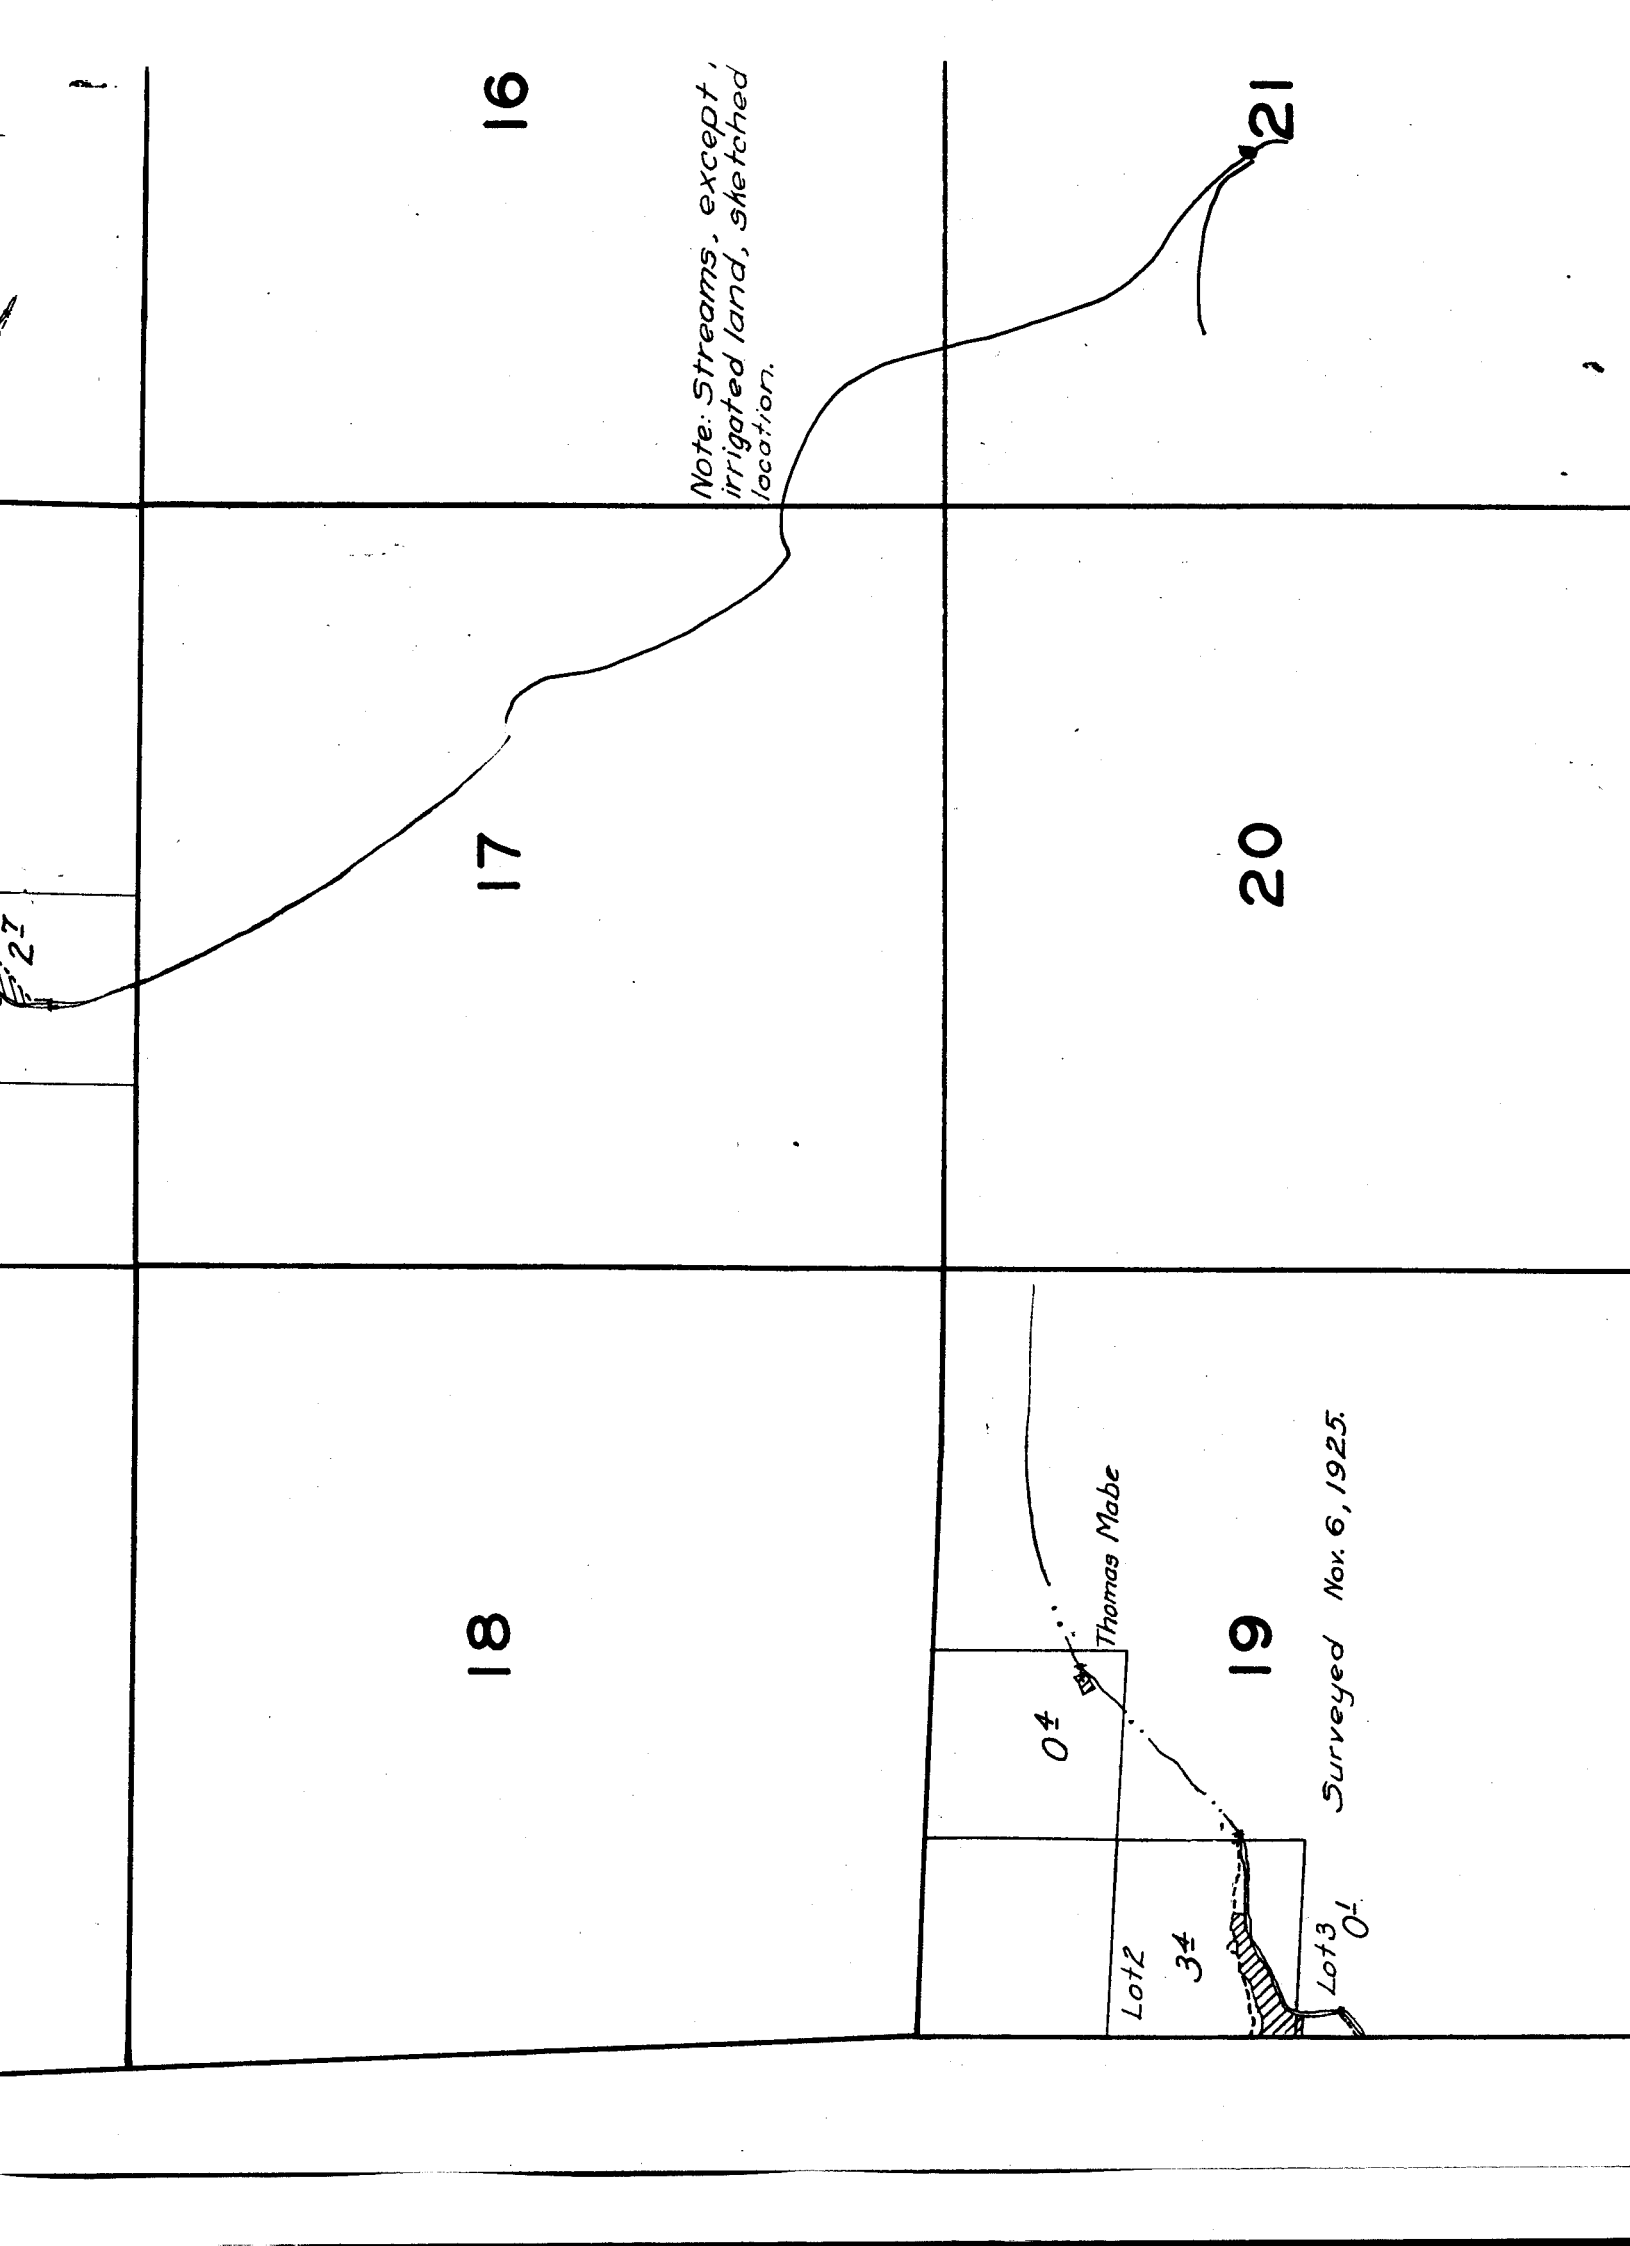

16

*Note: Streams, except,
irrigated land, sketched
location.*

21

17

20

18

19

Thomas Mabe

Surveyed Nov. 6, 1925.

04

Lot 2

34

Lot 3

01