

2

1

11

12

14

13

6

5

7

8

18

18

21

22

28

27

Surveyed May 2, 3, and 4, 1925.

33

34

15

14

13

22

23

24

27

26

25

34

35

36

18

16

15

20

21

22

TOWNSHIP 1 S., RANGE 22 E.

5

4

3

8

9

10

16


18

18


21

20

19

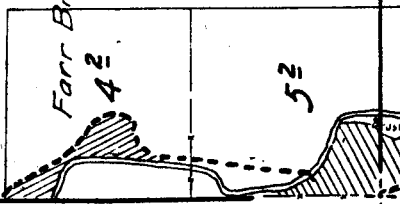

T. 15. R. 21 E. W. M.

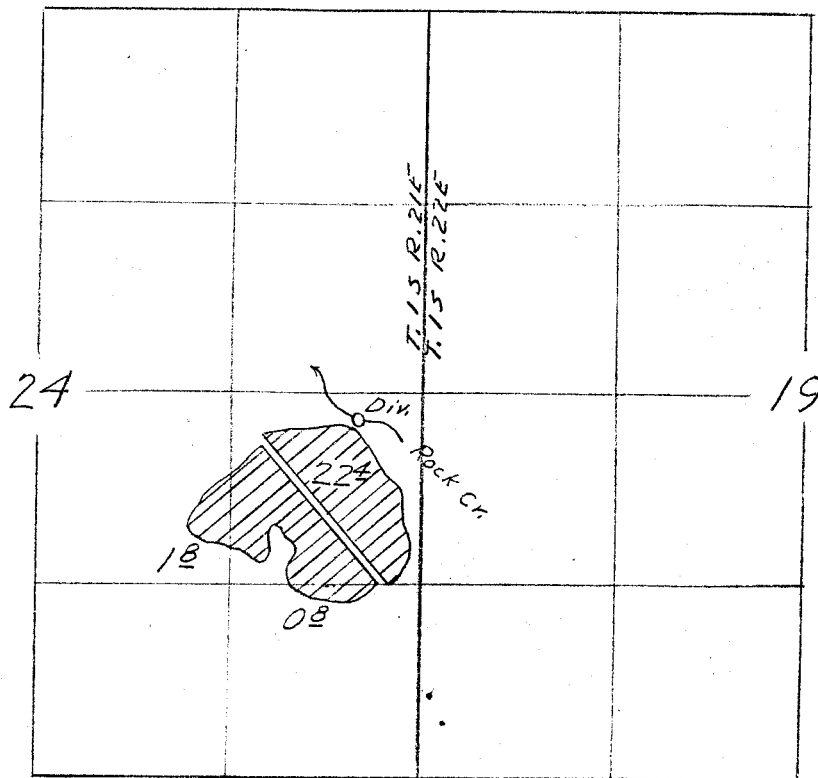

Final Proof Survey
Under

Transfer No. C-99
In Name Of

Orie L. Conboy

Surveyed April 6, 1955, by T. Jones

28

Surveyed May 2, 3, and 4

29

Note: Streams and roads, except in the vicinity of irrigated land, are sketched in approximate location.

33

