

2

1

11

12

14

13

16

15

21

22

4°

7°

3°


Spring

1/2  
DEEK


1/2

ds, except  
nd, is  
ation.

L.H. Donavan

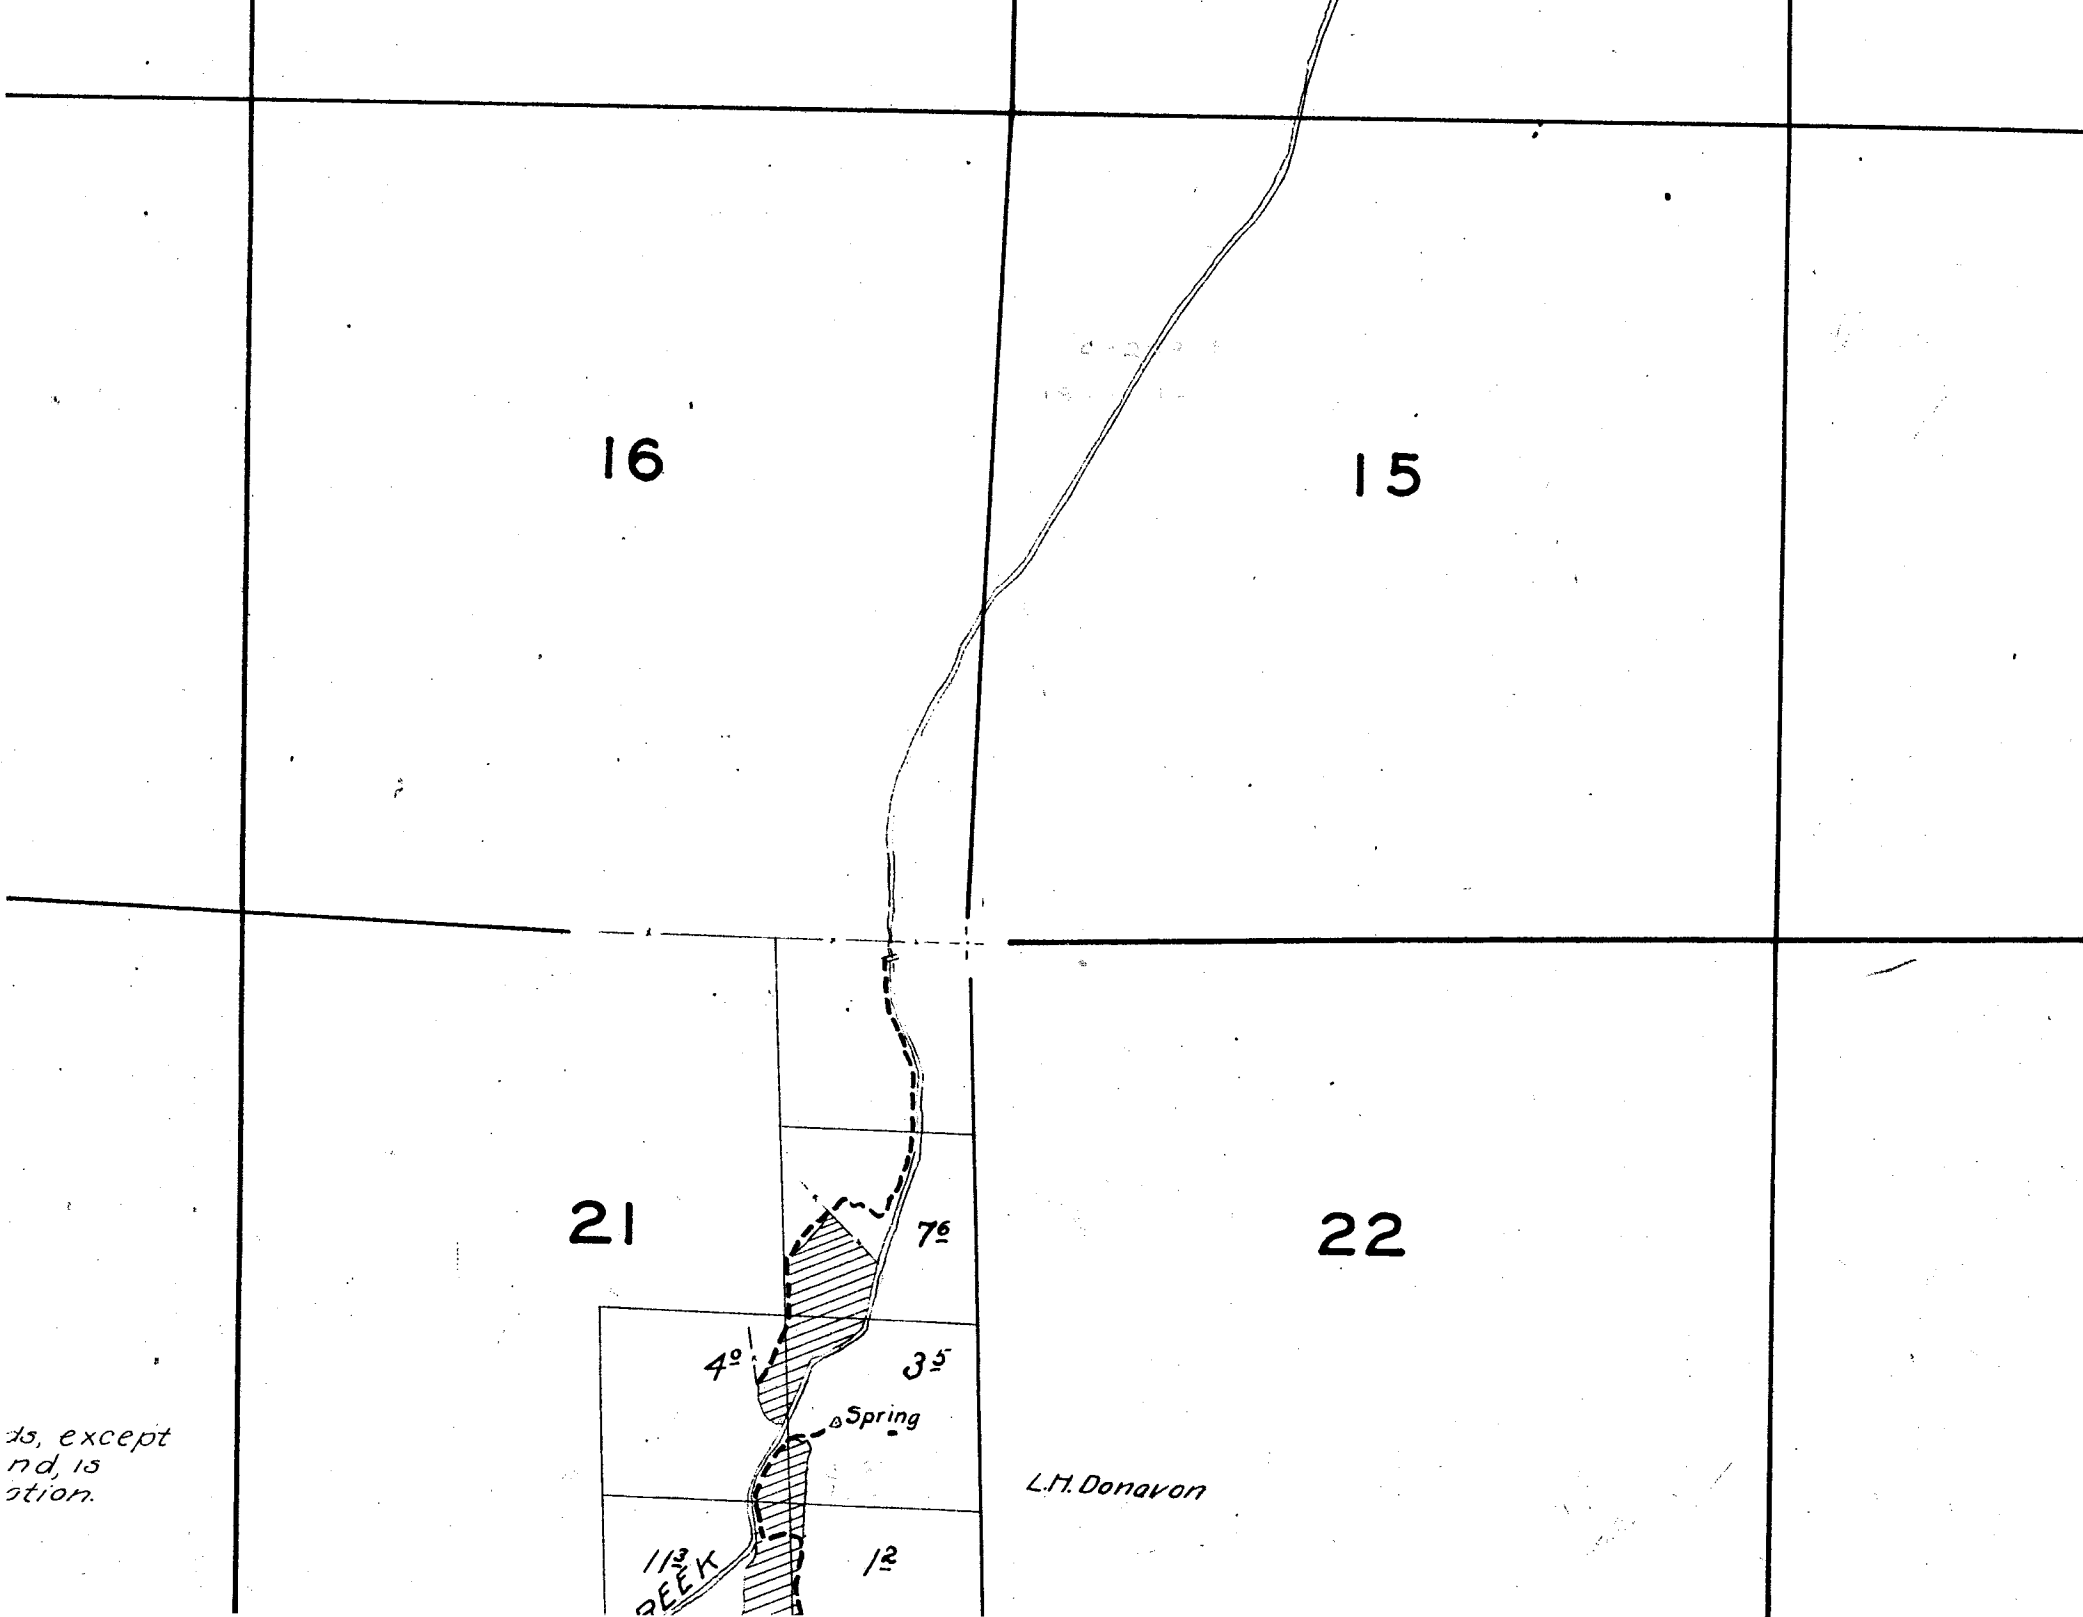

# TOWNSHIP 8 S., RANGE 25 E.

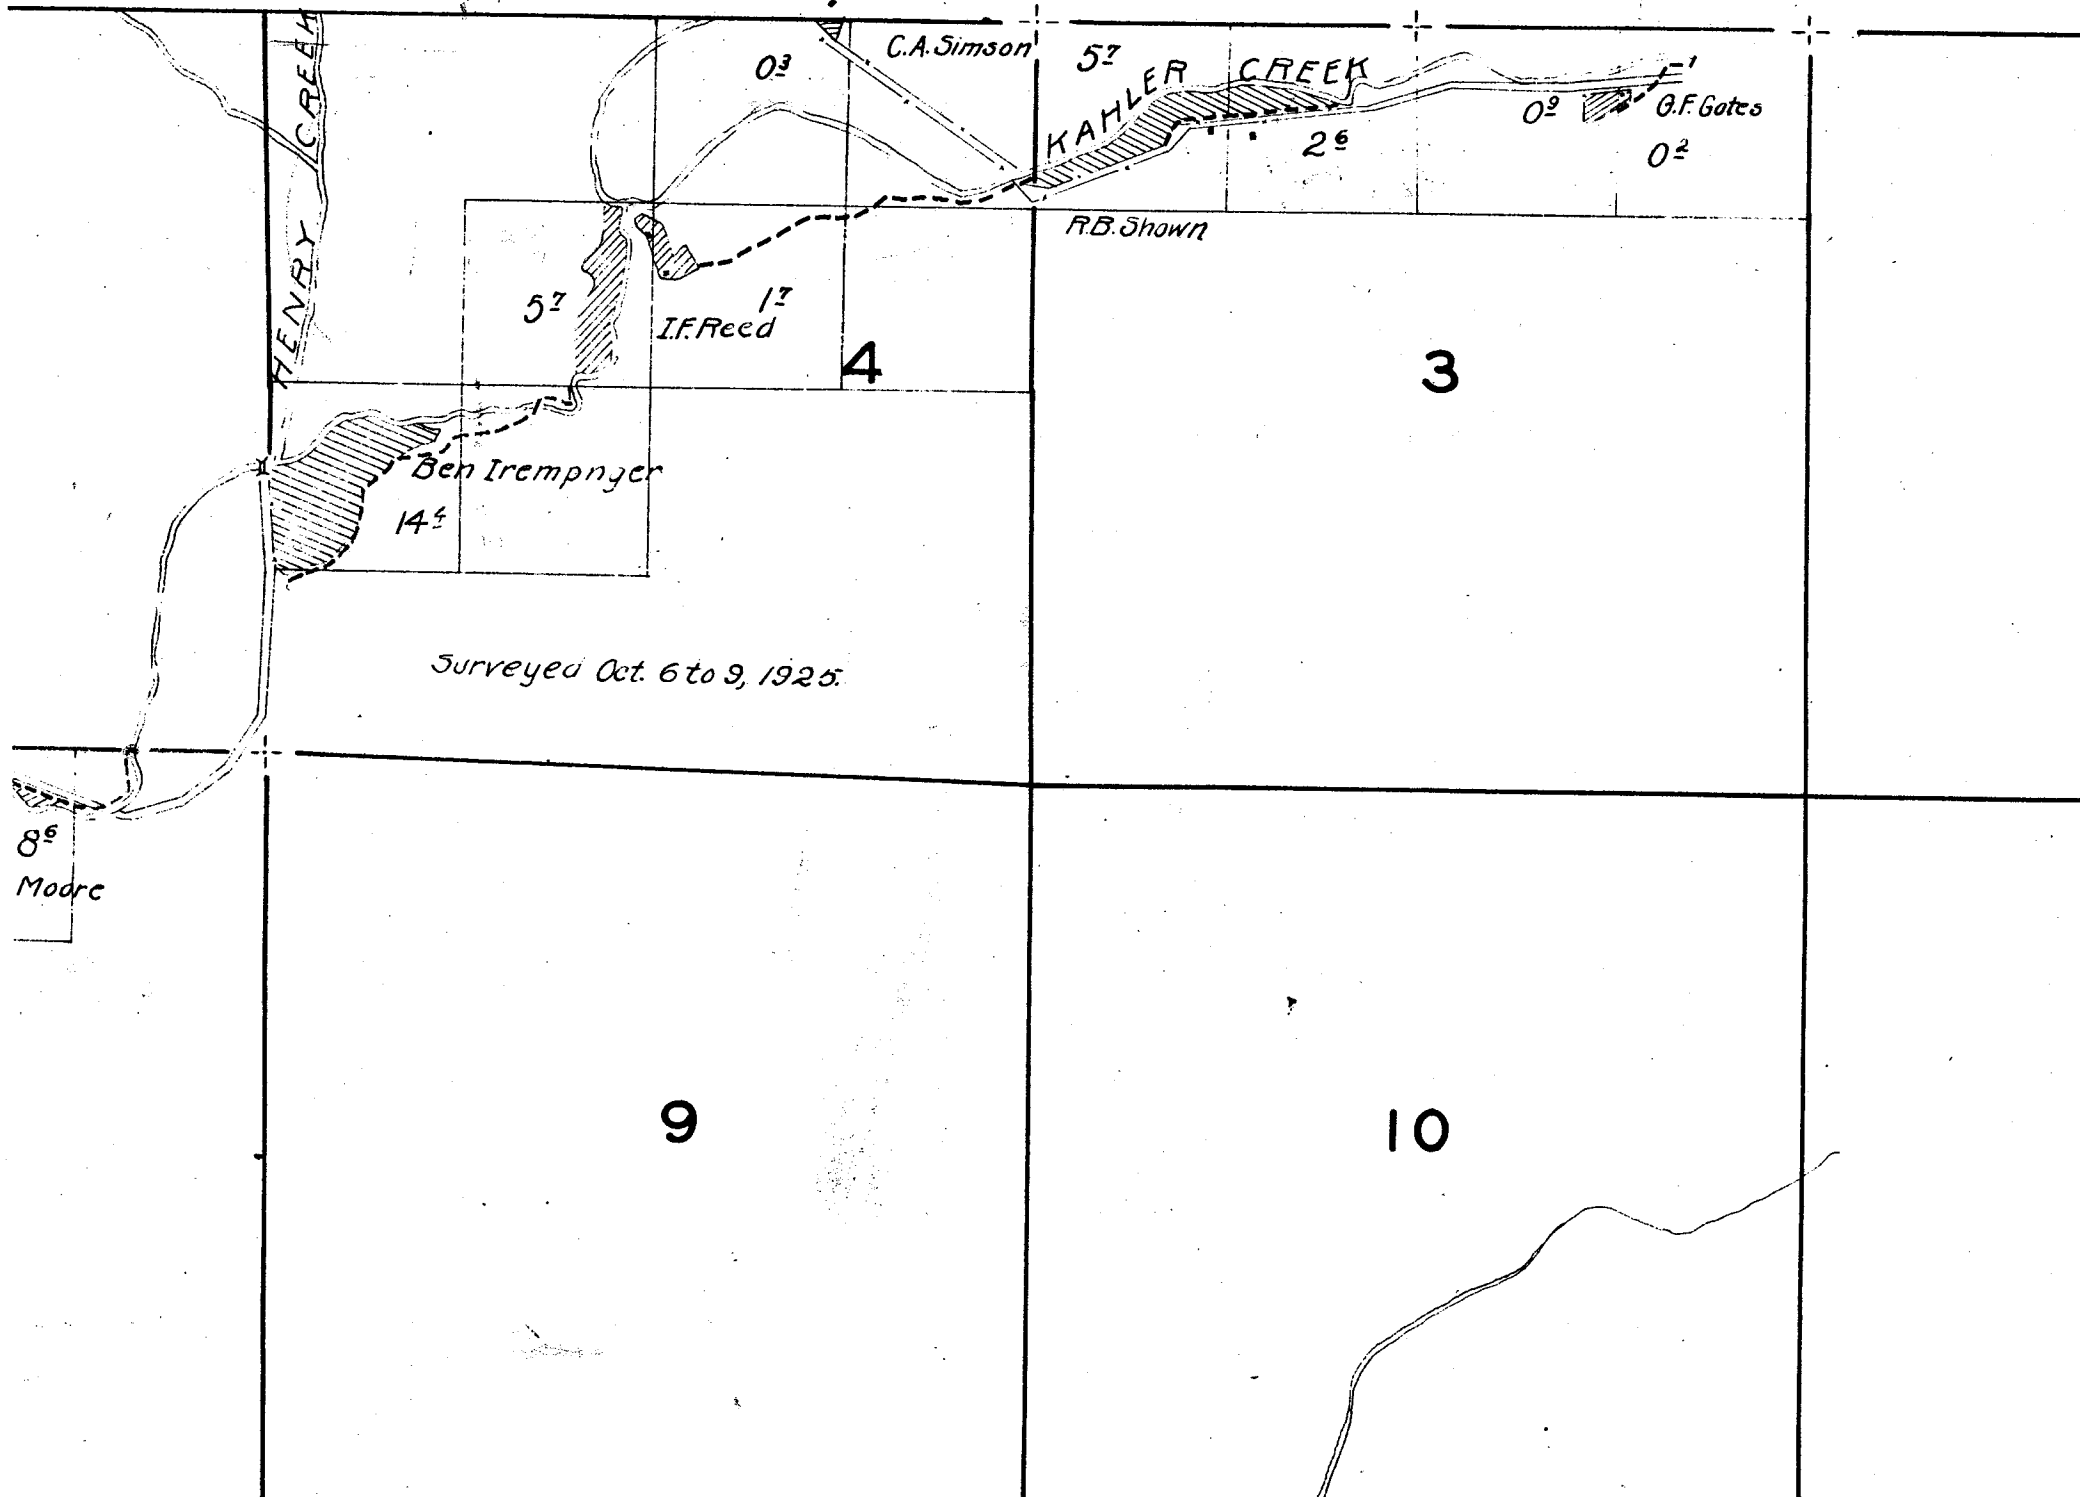

21

22

4°

7°

3°

Spring

113  
CREEK

12

L.H. Donavon

HAYSTACK

Bob Wright

175

4°

J.F. Asher

28

27

Spring

172

Surveyed Sept. 19 to 23, 1926

Steiner

5°

C.W. Walls

16

A.E. Cress

12

33

34

SOV 17 P. 111 + SOV 12 P. 506  
ADD. P. 40'S

40° NOW C-35285

27°

07

12°

21°

32°

Pump

Prt. Jenkins

Vr

27

26

25

Palm Cr

Surveyed Sept 29, 1925

34

35

36

15

14

13

22

23

24

INVESTIGATE  
CREEK


69

02

RI Corner

17

05

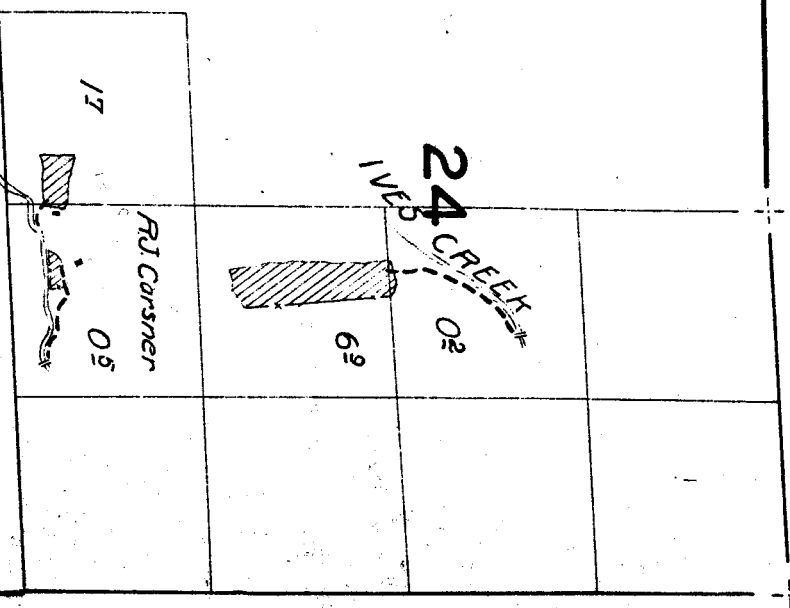

30

29

28

31

32

33

Surveyed Sept. 29, 1925

Surveyed Se

First National Bank

Condon

1905

Carl Wagner

L. Steiner


C.W. Walls


L. Steiner

J.F. Asher

Bob W. H. 51

HAYSTACK

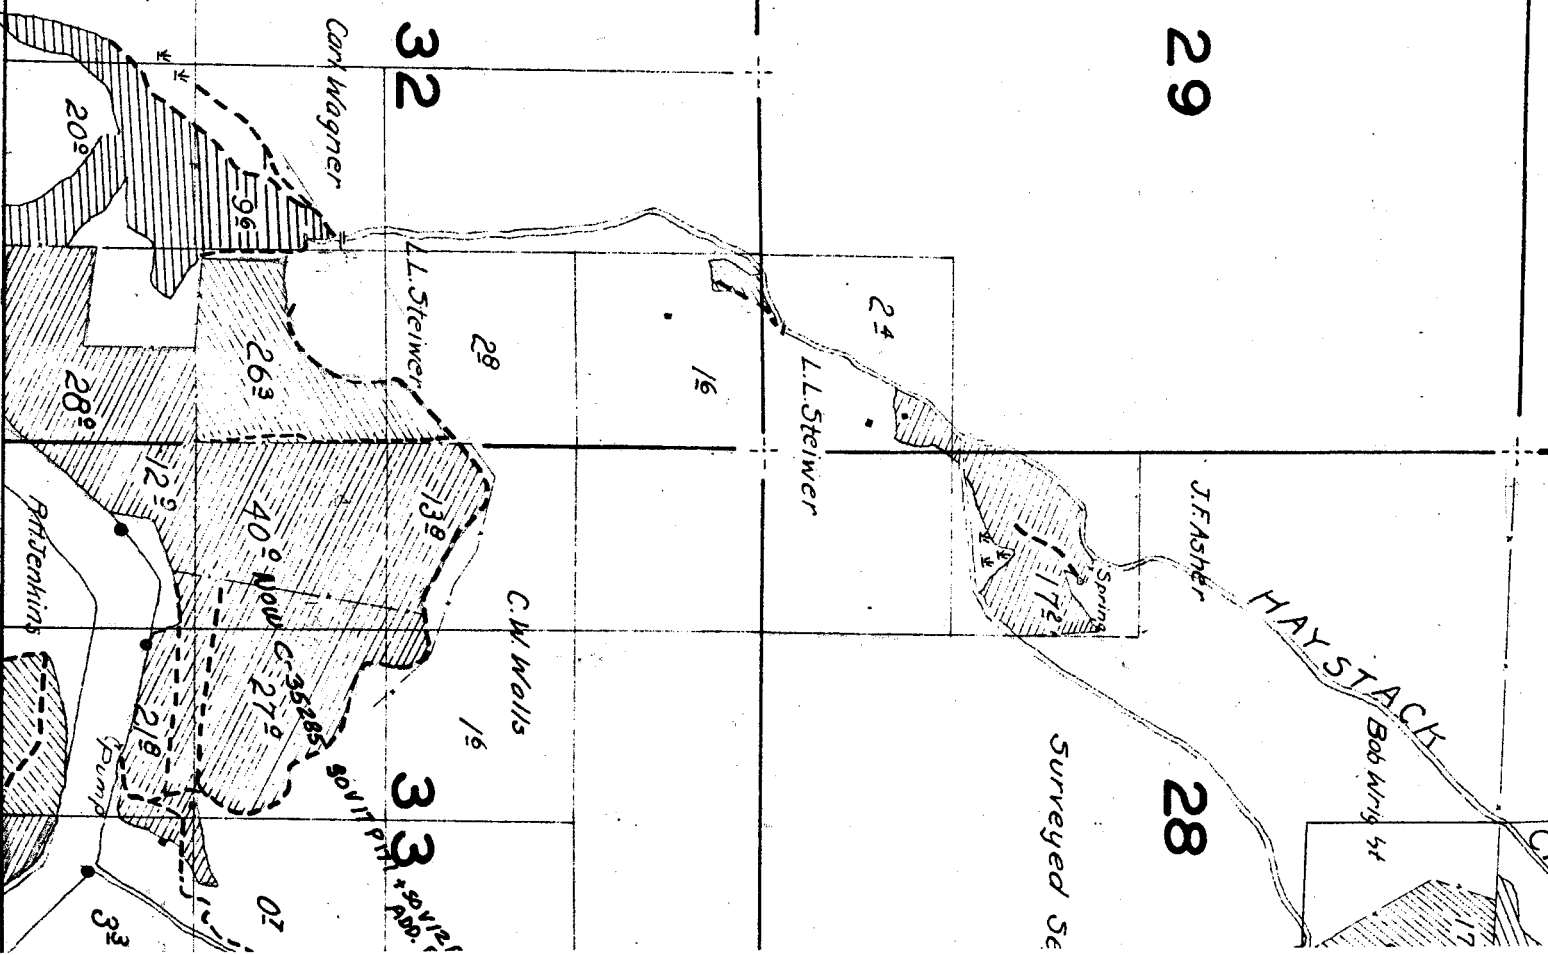

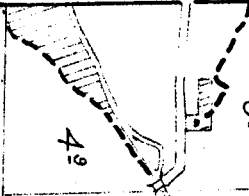

ASBorges

18

17


16

19

20

21

*Note: Location of streams and roads, except in the vicinity of irrigated land, is sketched in approximate location.*

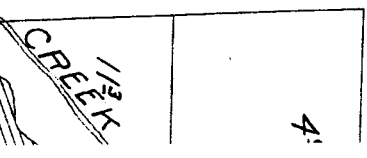



6

5

7

13

auge 8<sup>o</sup>

E.R. Moore

03

8

07

A.S. Borges

4<sup>o</sup>

18

17

