

6

5

7

8

13

03

Gage 8⁵
E. R. Moore

07

4⁹

A. S. Borges

18

17

30

29

28

Spring 172

HAYSTACK 17

Bob Wrig 5 ft

River

Surveyed Se

31

Surveyed Sept. 29, 1925

First National Bank
Condon
S.S. 03

32

Carl Wagner

L. Steiner

28

263


20°

28°

34

[illegible]

First Nation
Condom 05

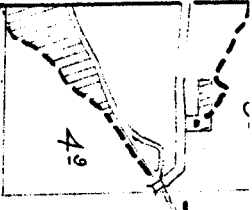

AS Borges

4⁹

18

17


16

19

20

21

*Note: Location of streams and roads, except
in the vicinity of irrigated land, is
sketched in approximate location.*

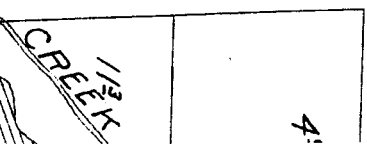

4¹

Surveyed Sept. 29, 1925.

Palm Cr.

27

26

25

34

35

36

15

14

13

22

23

24

IVEY CREEK

02

62



RU Corner

17

05



21

22

4°

35°

Spring

L.H. Donovan

113
CREEK

12

175

45°

Bob Wright

HAYSTACK

J.F. Asher

28

27

Spring

175

Surveyed Sept. 19 to 23, 1926

Steiner

5°

C.W. Walls

15

A.E. Cress

12

33

34

SOV 17 PTH + SOV 12 P506
ADD. Pads

40°

Now C-35285

27°

12°

219

07

33

Pump

P.H. Jenkins


16

15

21


22

is, except
nd, is
ation.

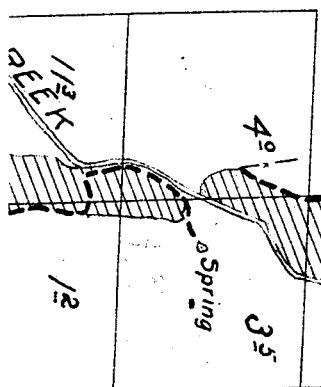

L.H. Donarion

TOWNSHIP 8 S., RANGE 25 E.

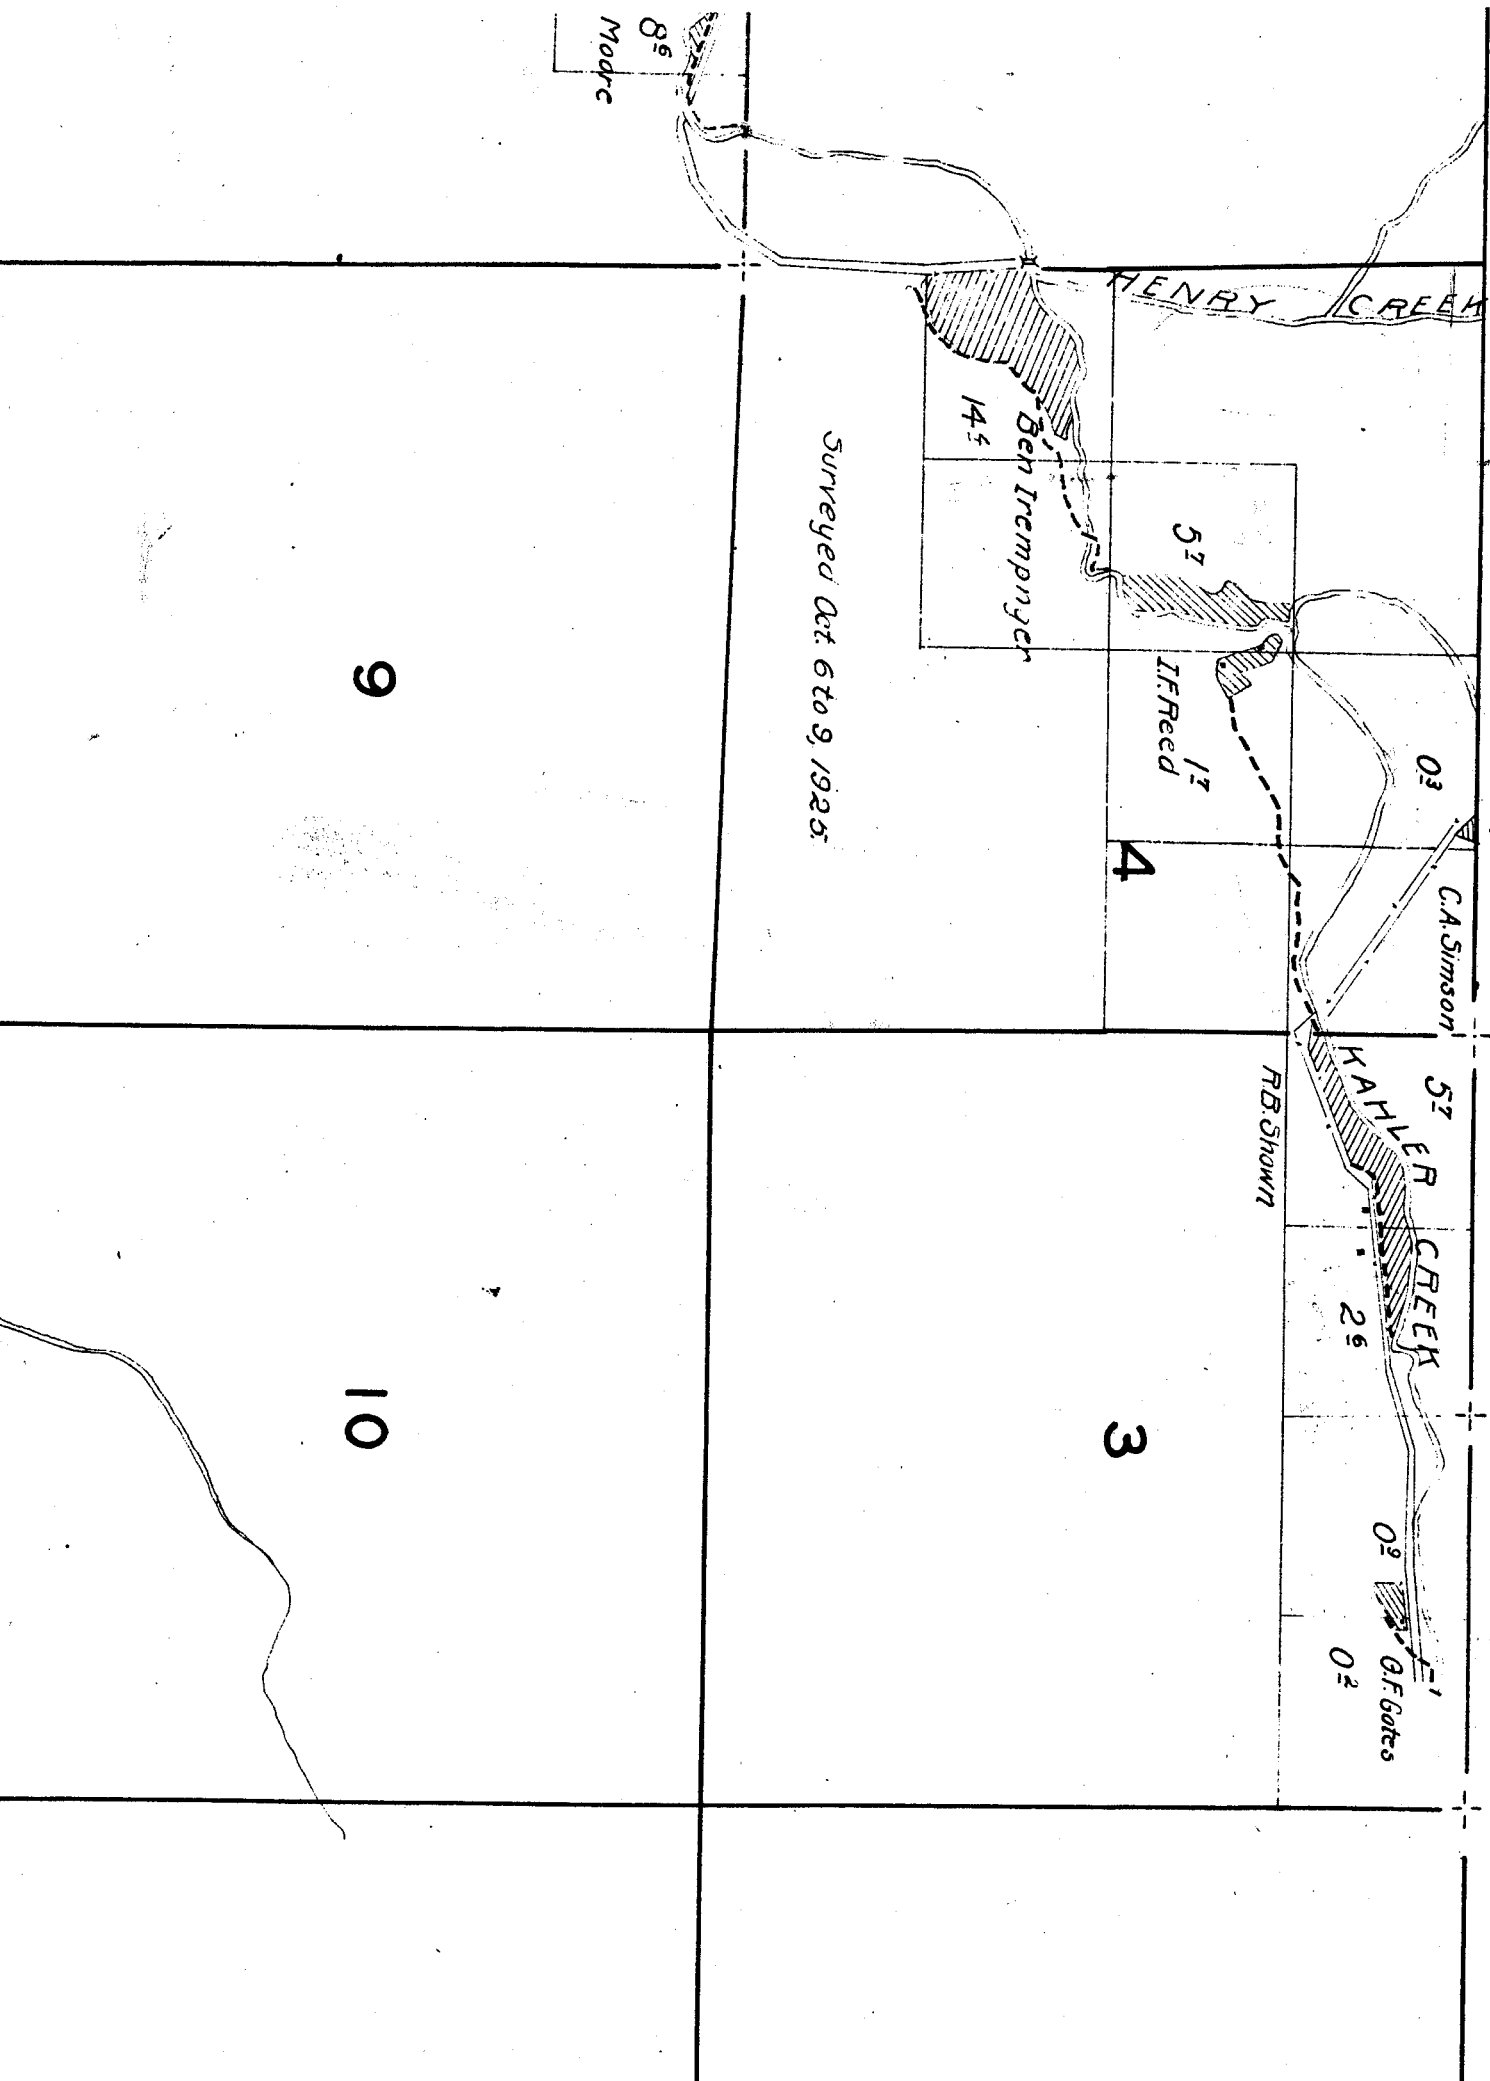

48-2-1

2

1

11

12

14

13