

19

20


30

29

31

32

JOHN
DAY
RIVER

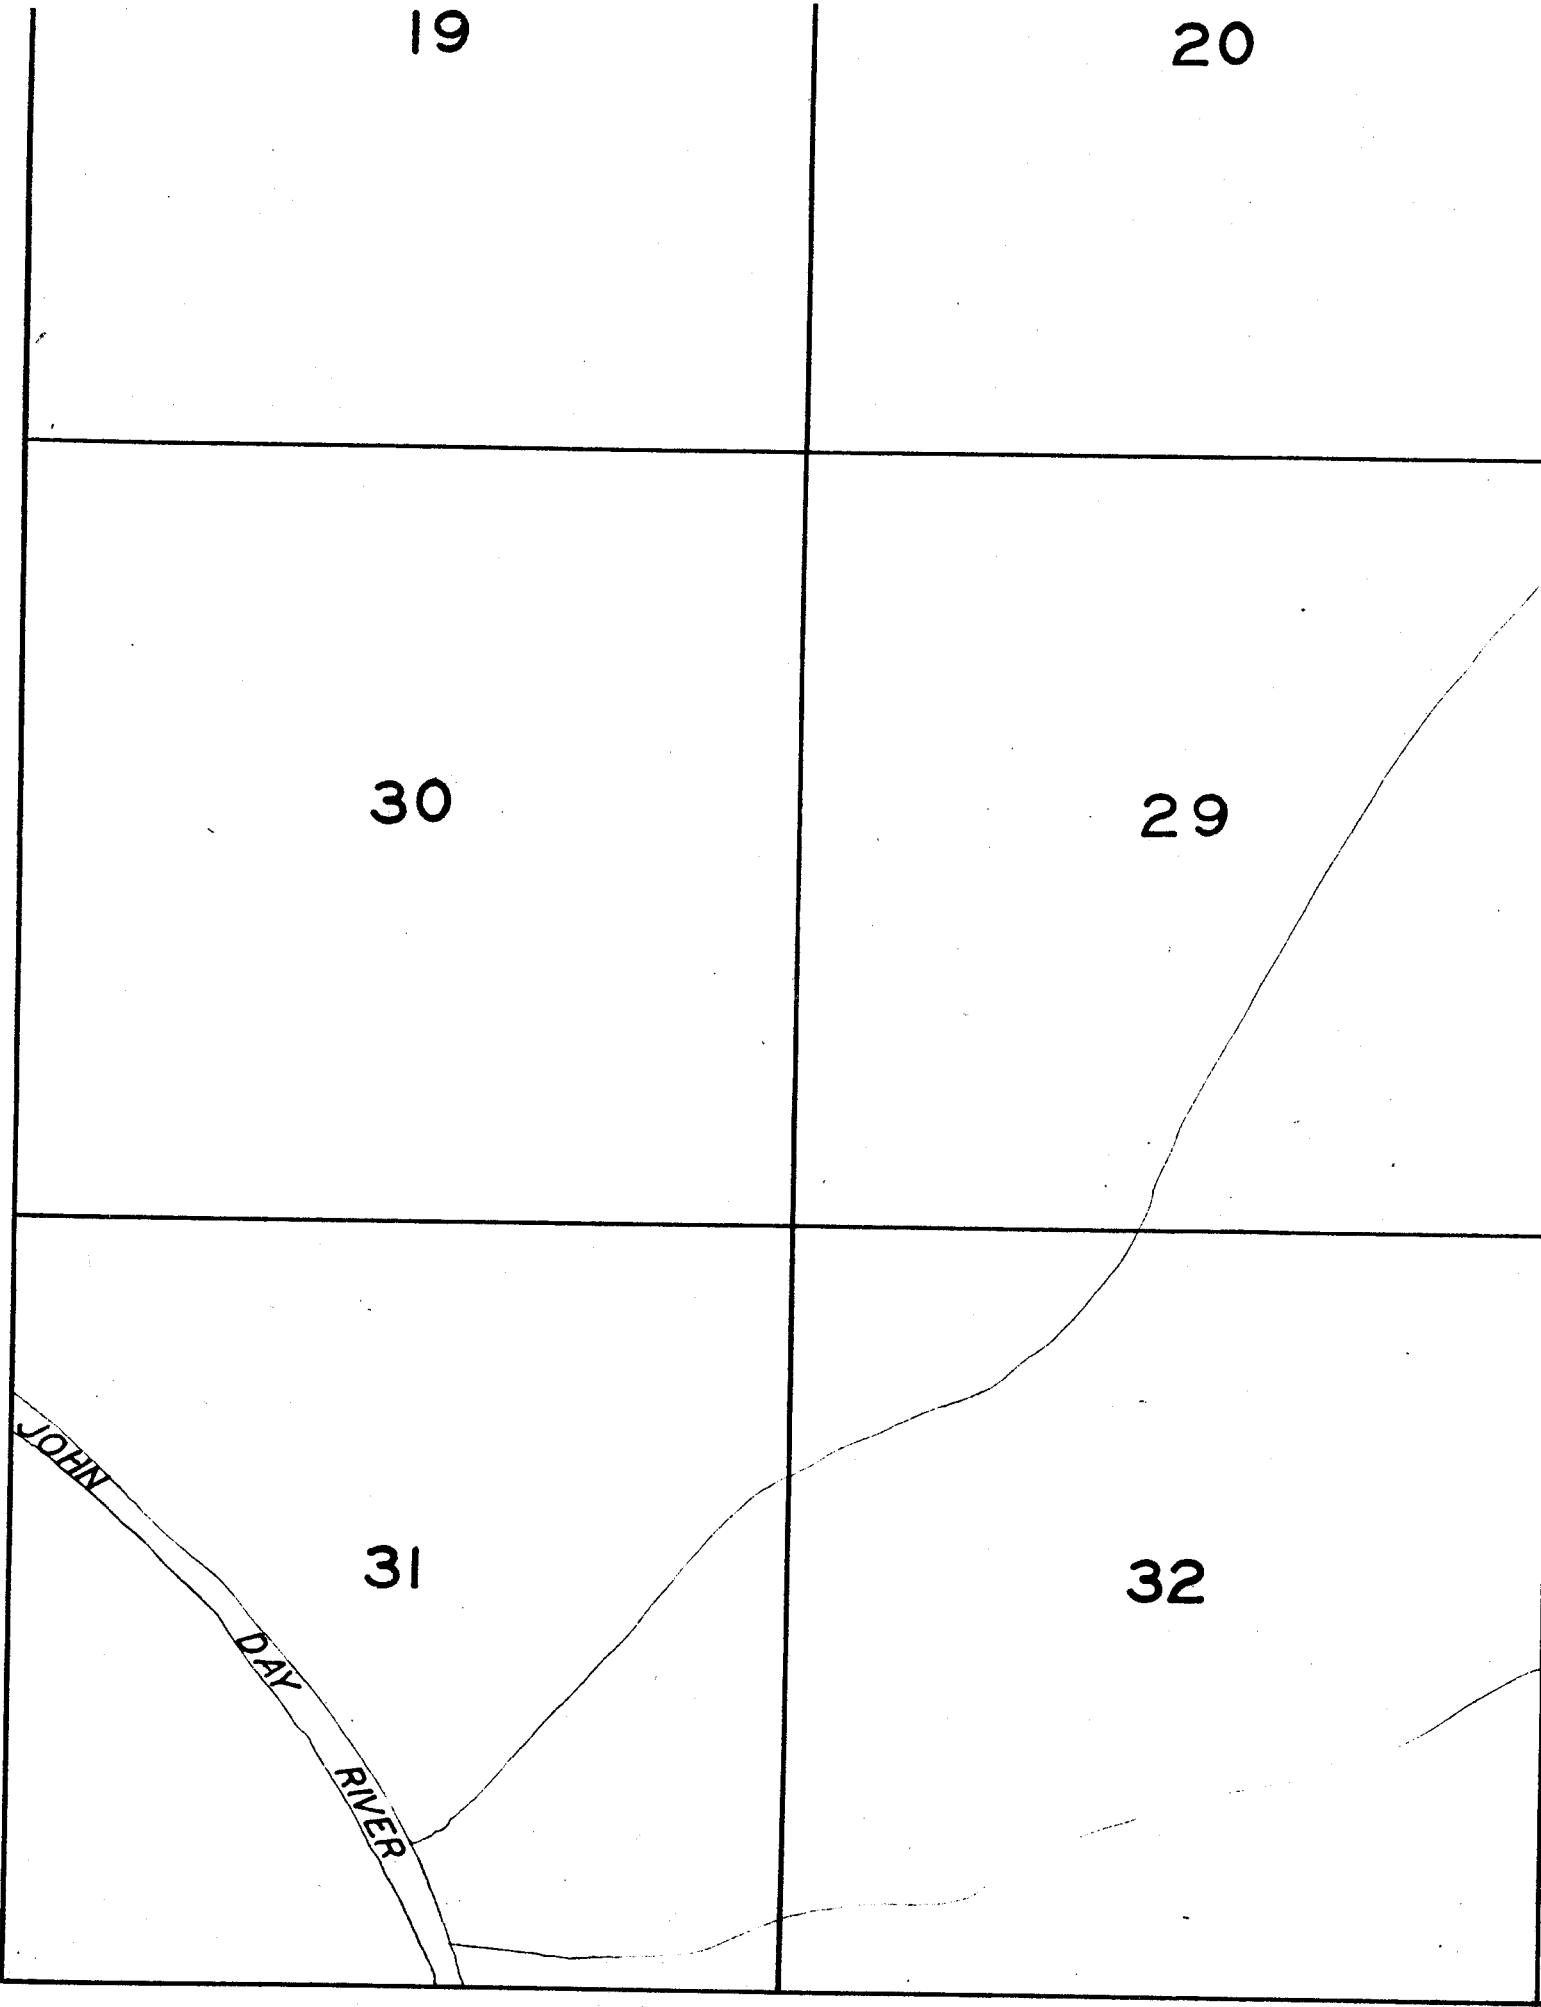

23

24


26

25

35

36

TOWNSHIP 8 S., RANGE 20 E.

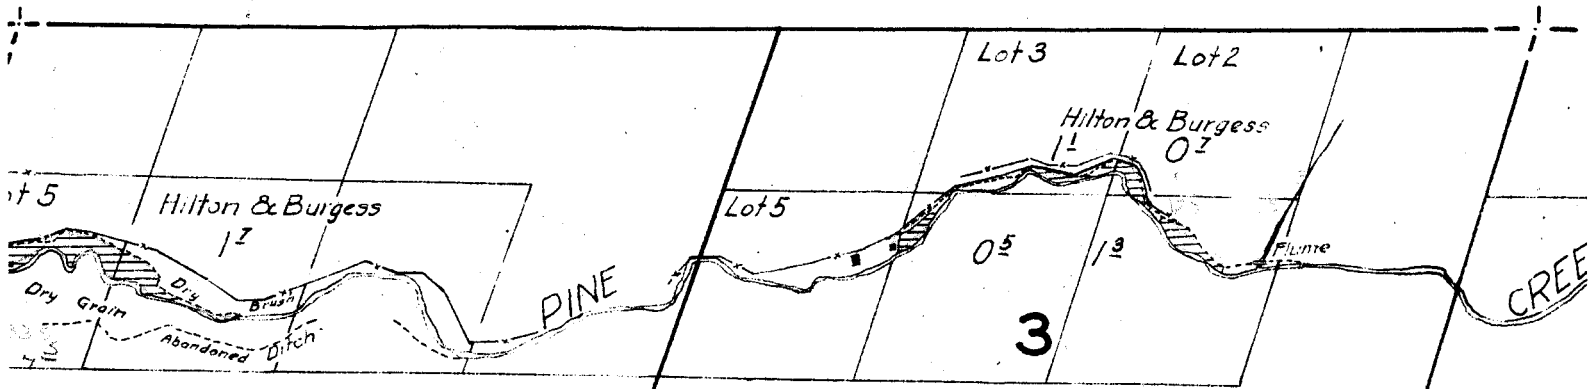

Aug. 12 to 14, 1926.

Note: Bearings of section lines
taken from U.S. Township Plats.

9


10

NOTE: Stream
the vicinity of
in approximate

16

15

TO

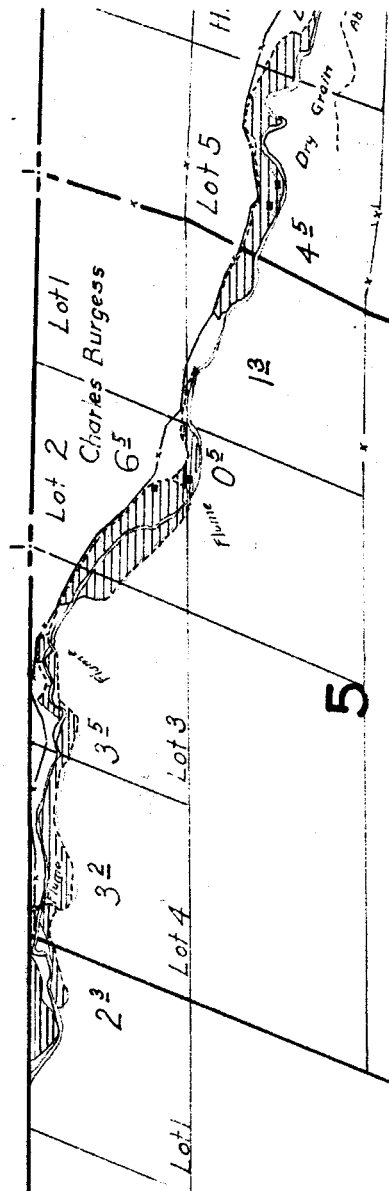

Surveyed Aug. 12:

6

5

7

8

9

16	17	18
21	20	19


NOTE: Streams and rivers, except in the vicinity of irrigated land sketched in approximate location.

14

13

23

24

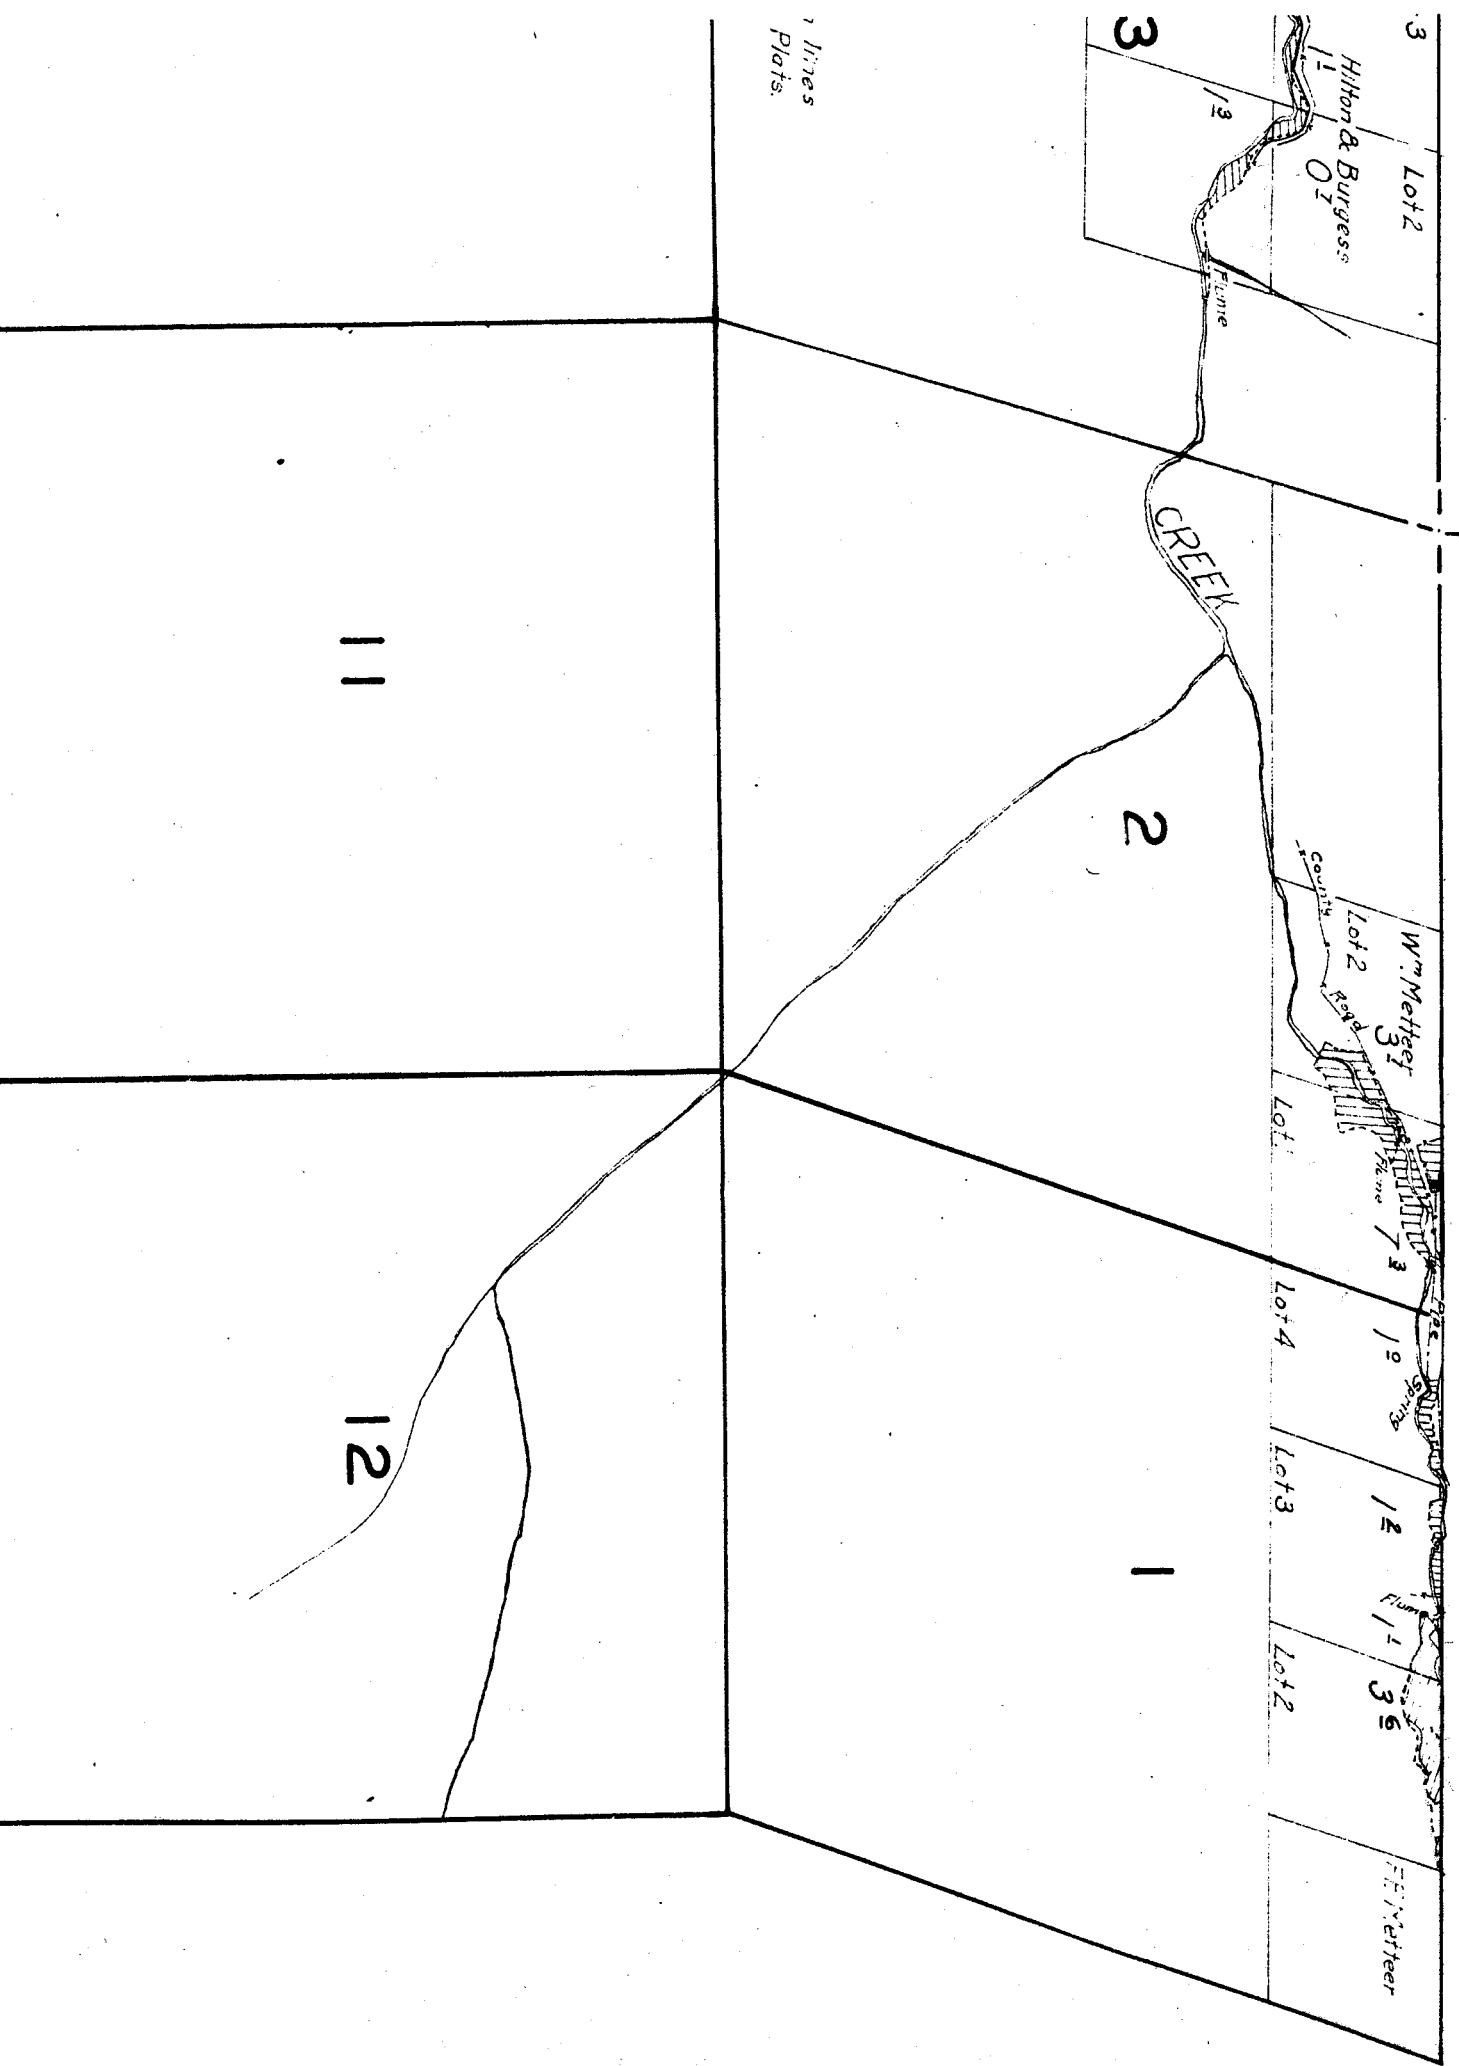

28

27

33

34

NOTE: S;
the victim,
in approx.

16

15

21

22

