


Elmer McQuinn

6

5

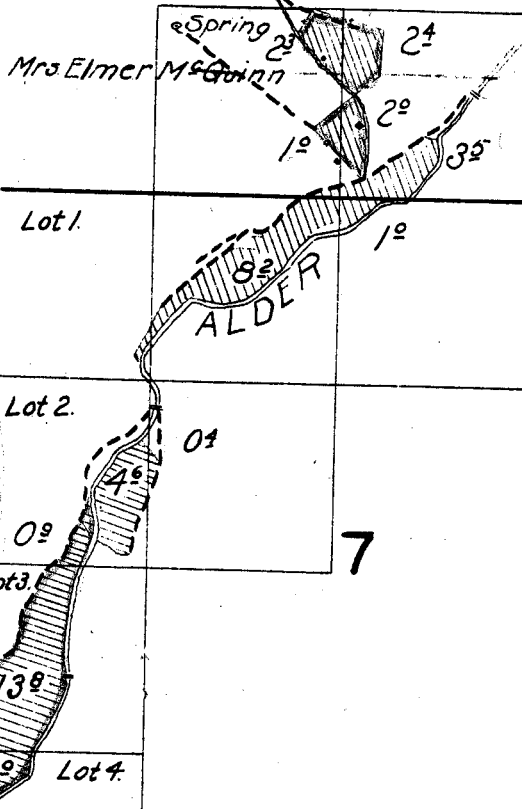


Surveyed October 16, 1925.

8

18

17

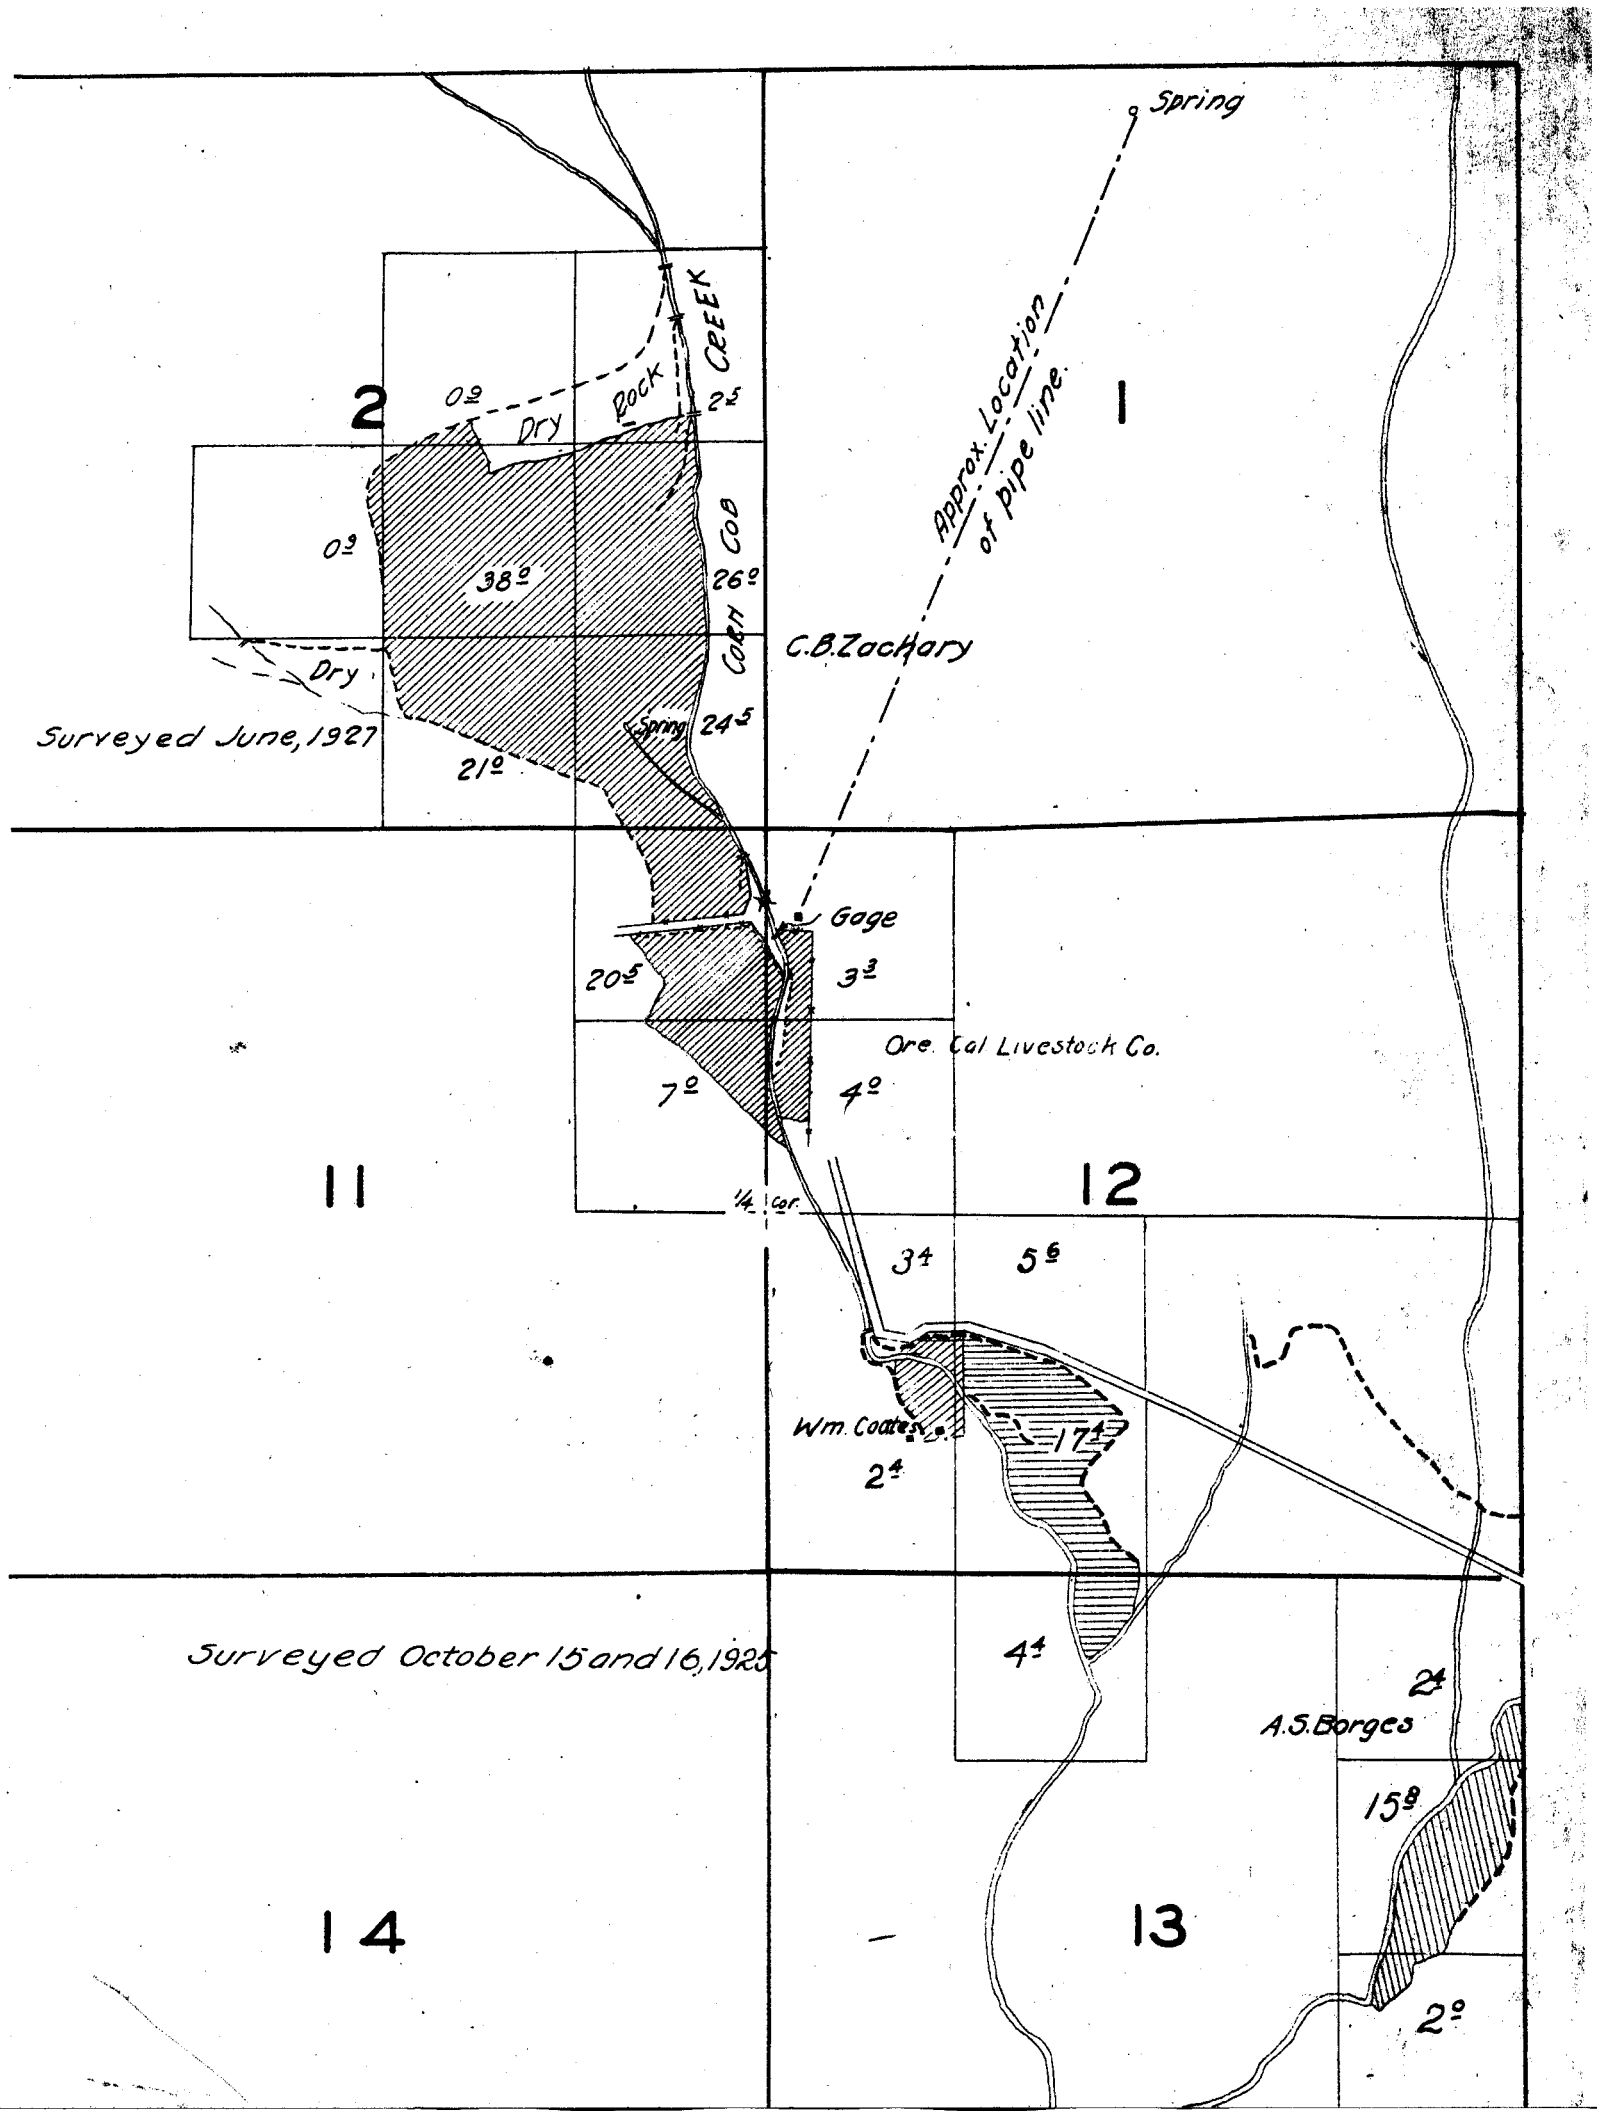

27

1 Sept 24 and 30, 1925

26

25

JOHN DAY RIVER

34

35

36

Frank Wright

HAHLER CREEK

F.F. Davenport

Avery Shown

SPRAY

JE Asher

Sumner

City

Watten Davenport

Avery Shown

PARISH

5/c

Surveyed October 15 and 16, 1928

15

14

22

23

13

24

44

A.S. Borges

24


158

2°

Amos Hawks

24

52

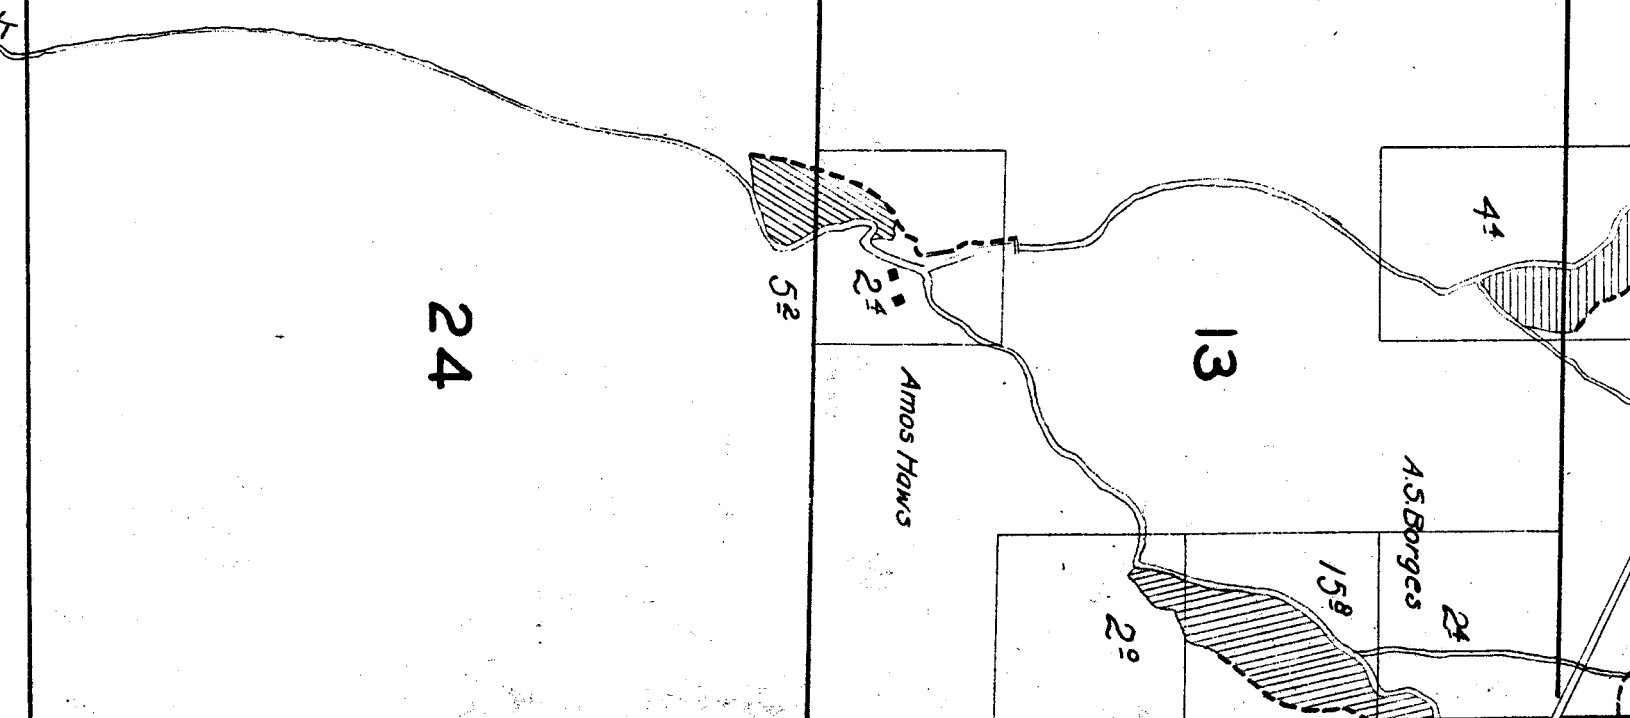

TOWNSHIP 8 S., RANGE 24 E.

	4	3	Surveyed.
1925.	9	10	


50

15

22

16

21

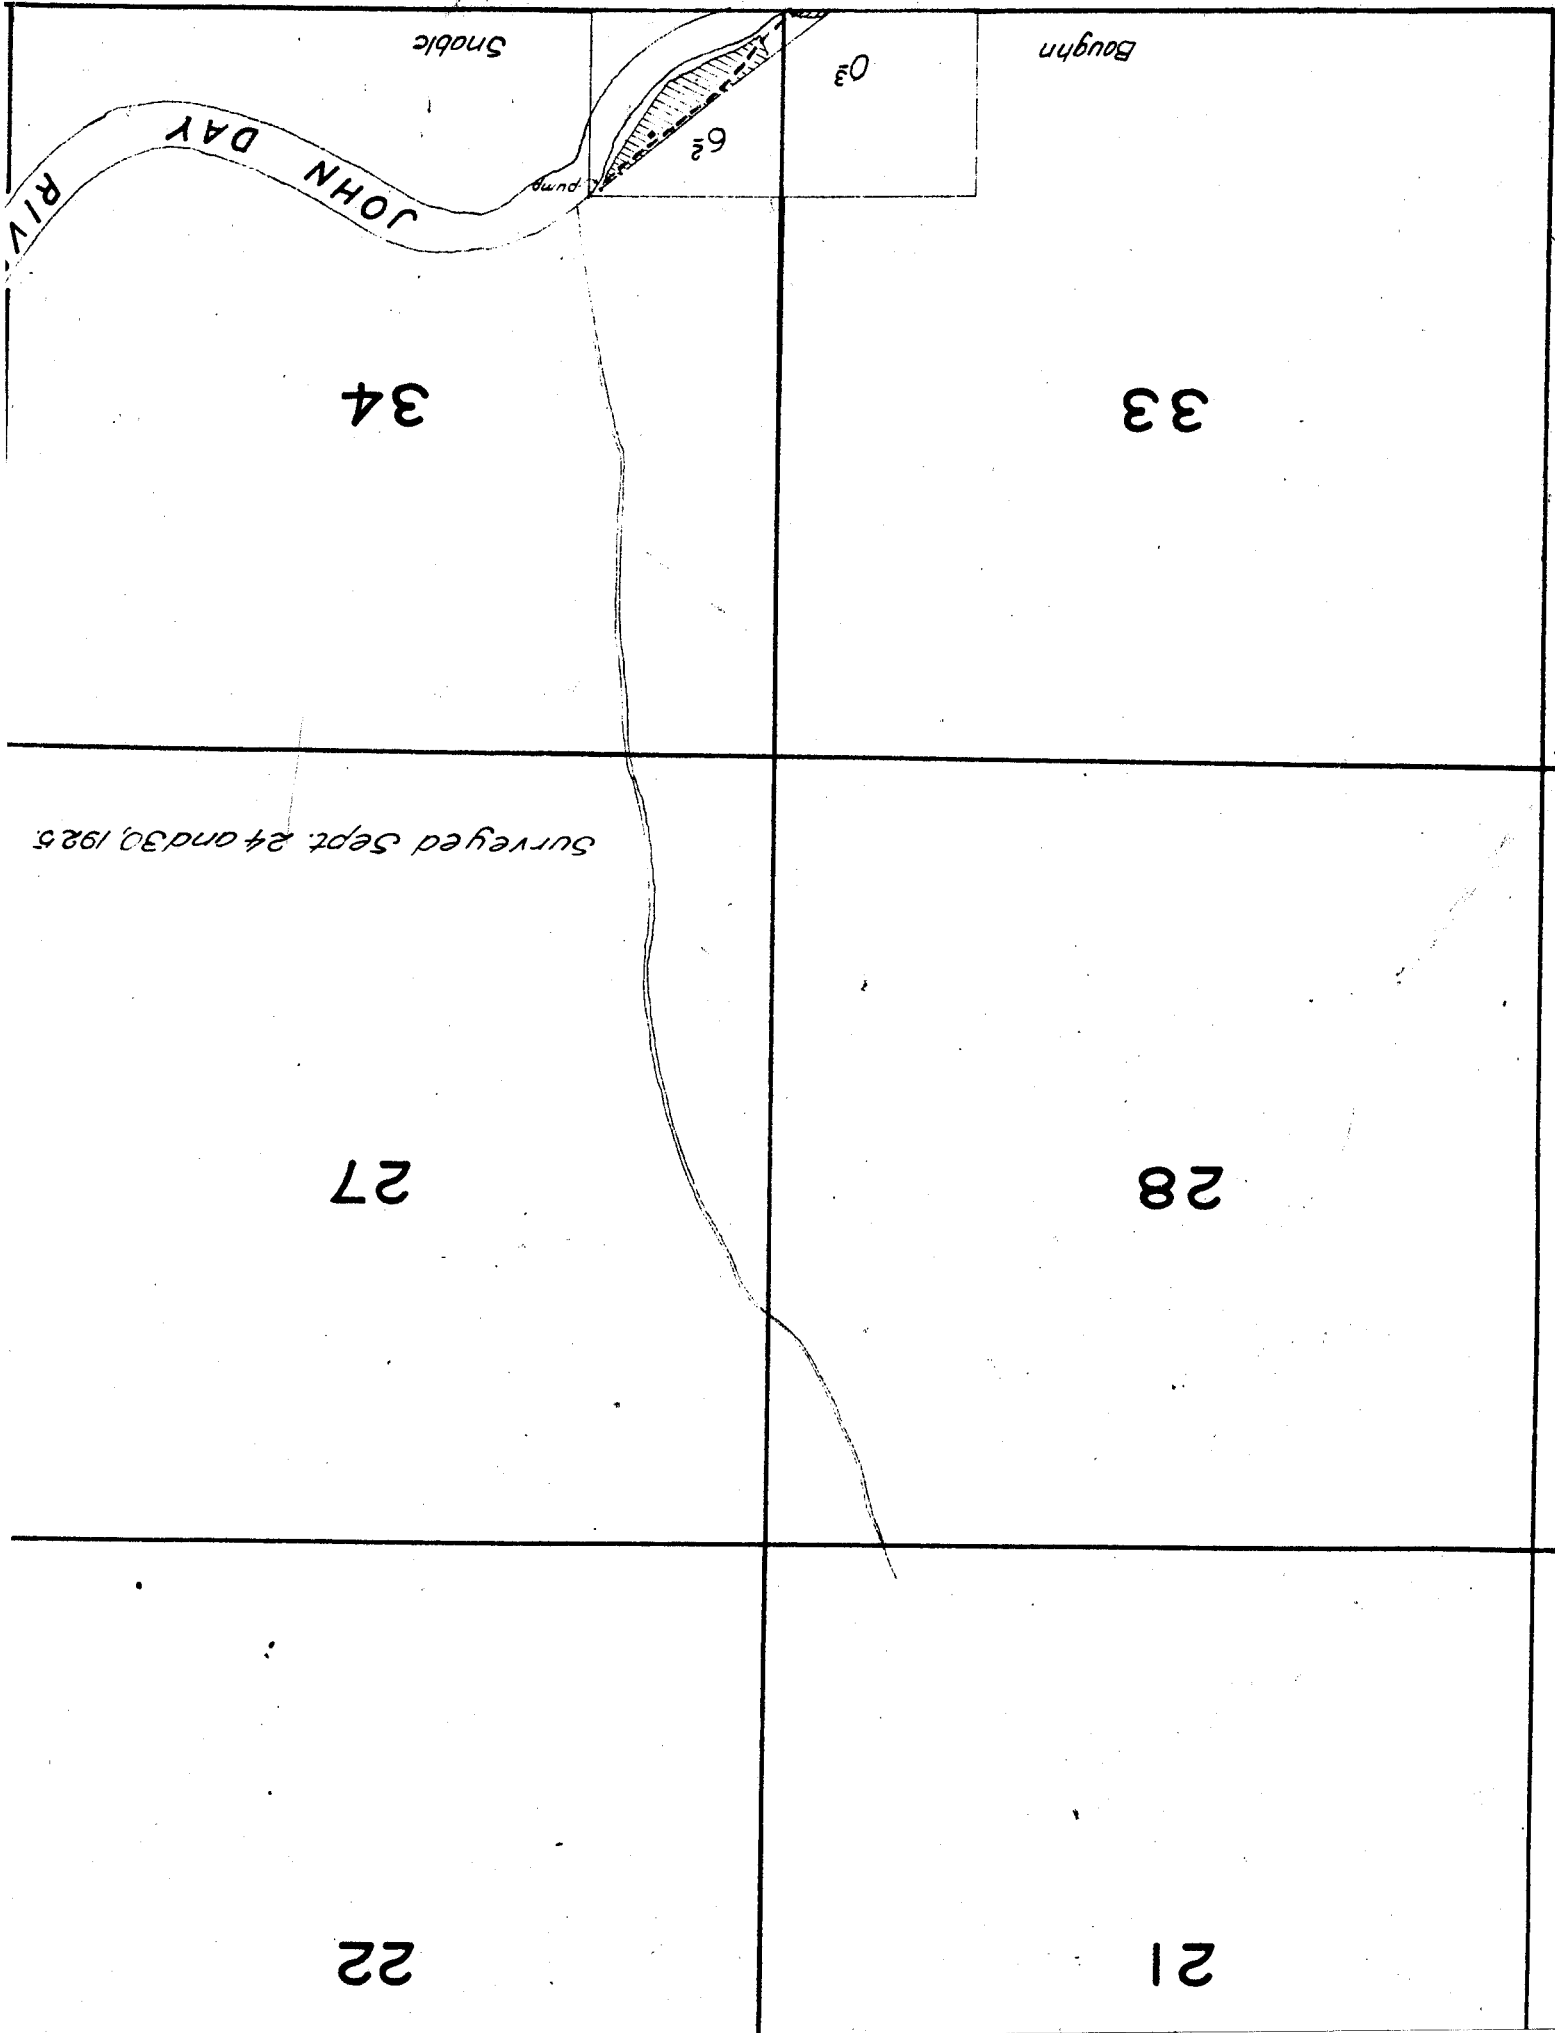

16

21

17

20

18

19

30

Note: Streams and Rivers except in the vicinity of irrigated land, sketched in approximate location.

29

28


MATHIS
31

Surveyed Oct 29, 1925

Mrs Mary Adams

10

0-

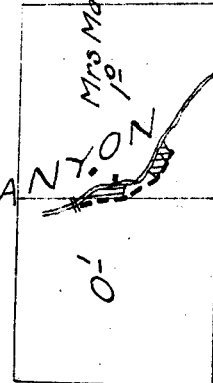

32

33

Spring

Baugh.