


21

22

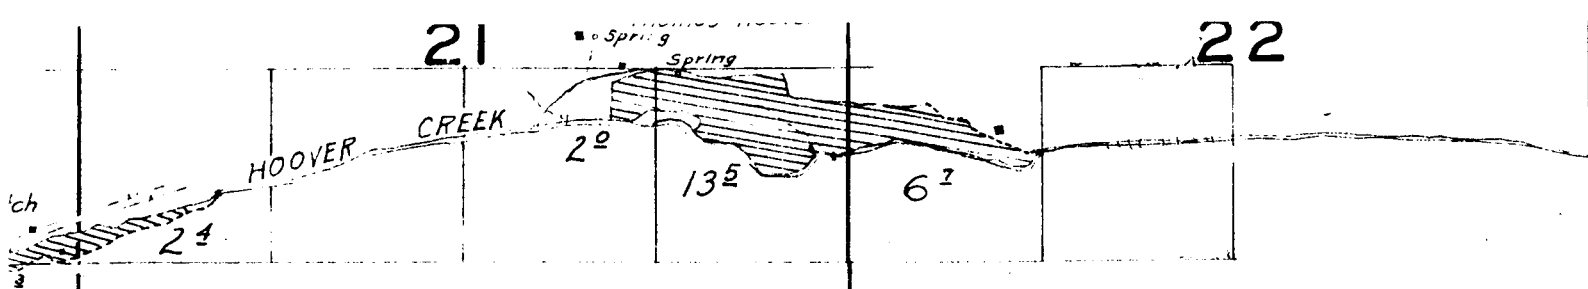

NOTE: Streams sketched in approximate location except in the vicinity of irrigated land.

28


27

Surveyed Nov. 12, 14, 20, & 21, 1925.

FOSSIL

33

34

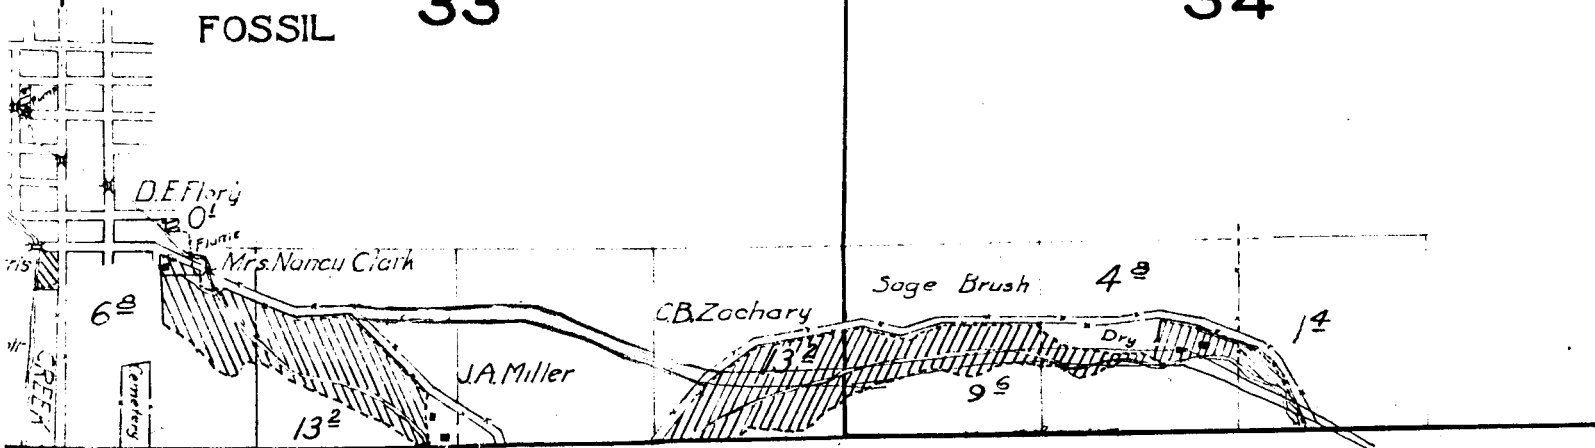

TOWNSHIP 6 S., RANGE 21 E.

3

10

4

9

15

16

22

21

Thomas Hoover
Spring

CREEK

HOOVER



2⁰

O.C. Veatch

1²

2⁴

Brush

Spring

Rocky

NOTE: Streams sketched in approximate location except in the vicinity of indicated land.

18

17

7

8

9

5

18


17

16

19

20

21

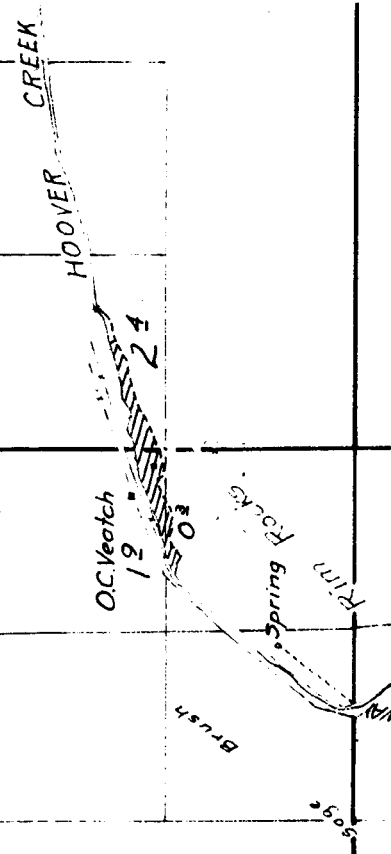



Surveyed Nov. 12, 14, 2



FOSIL

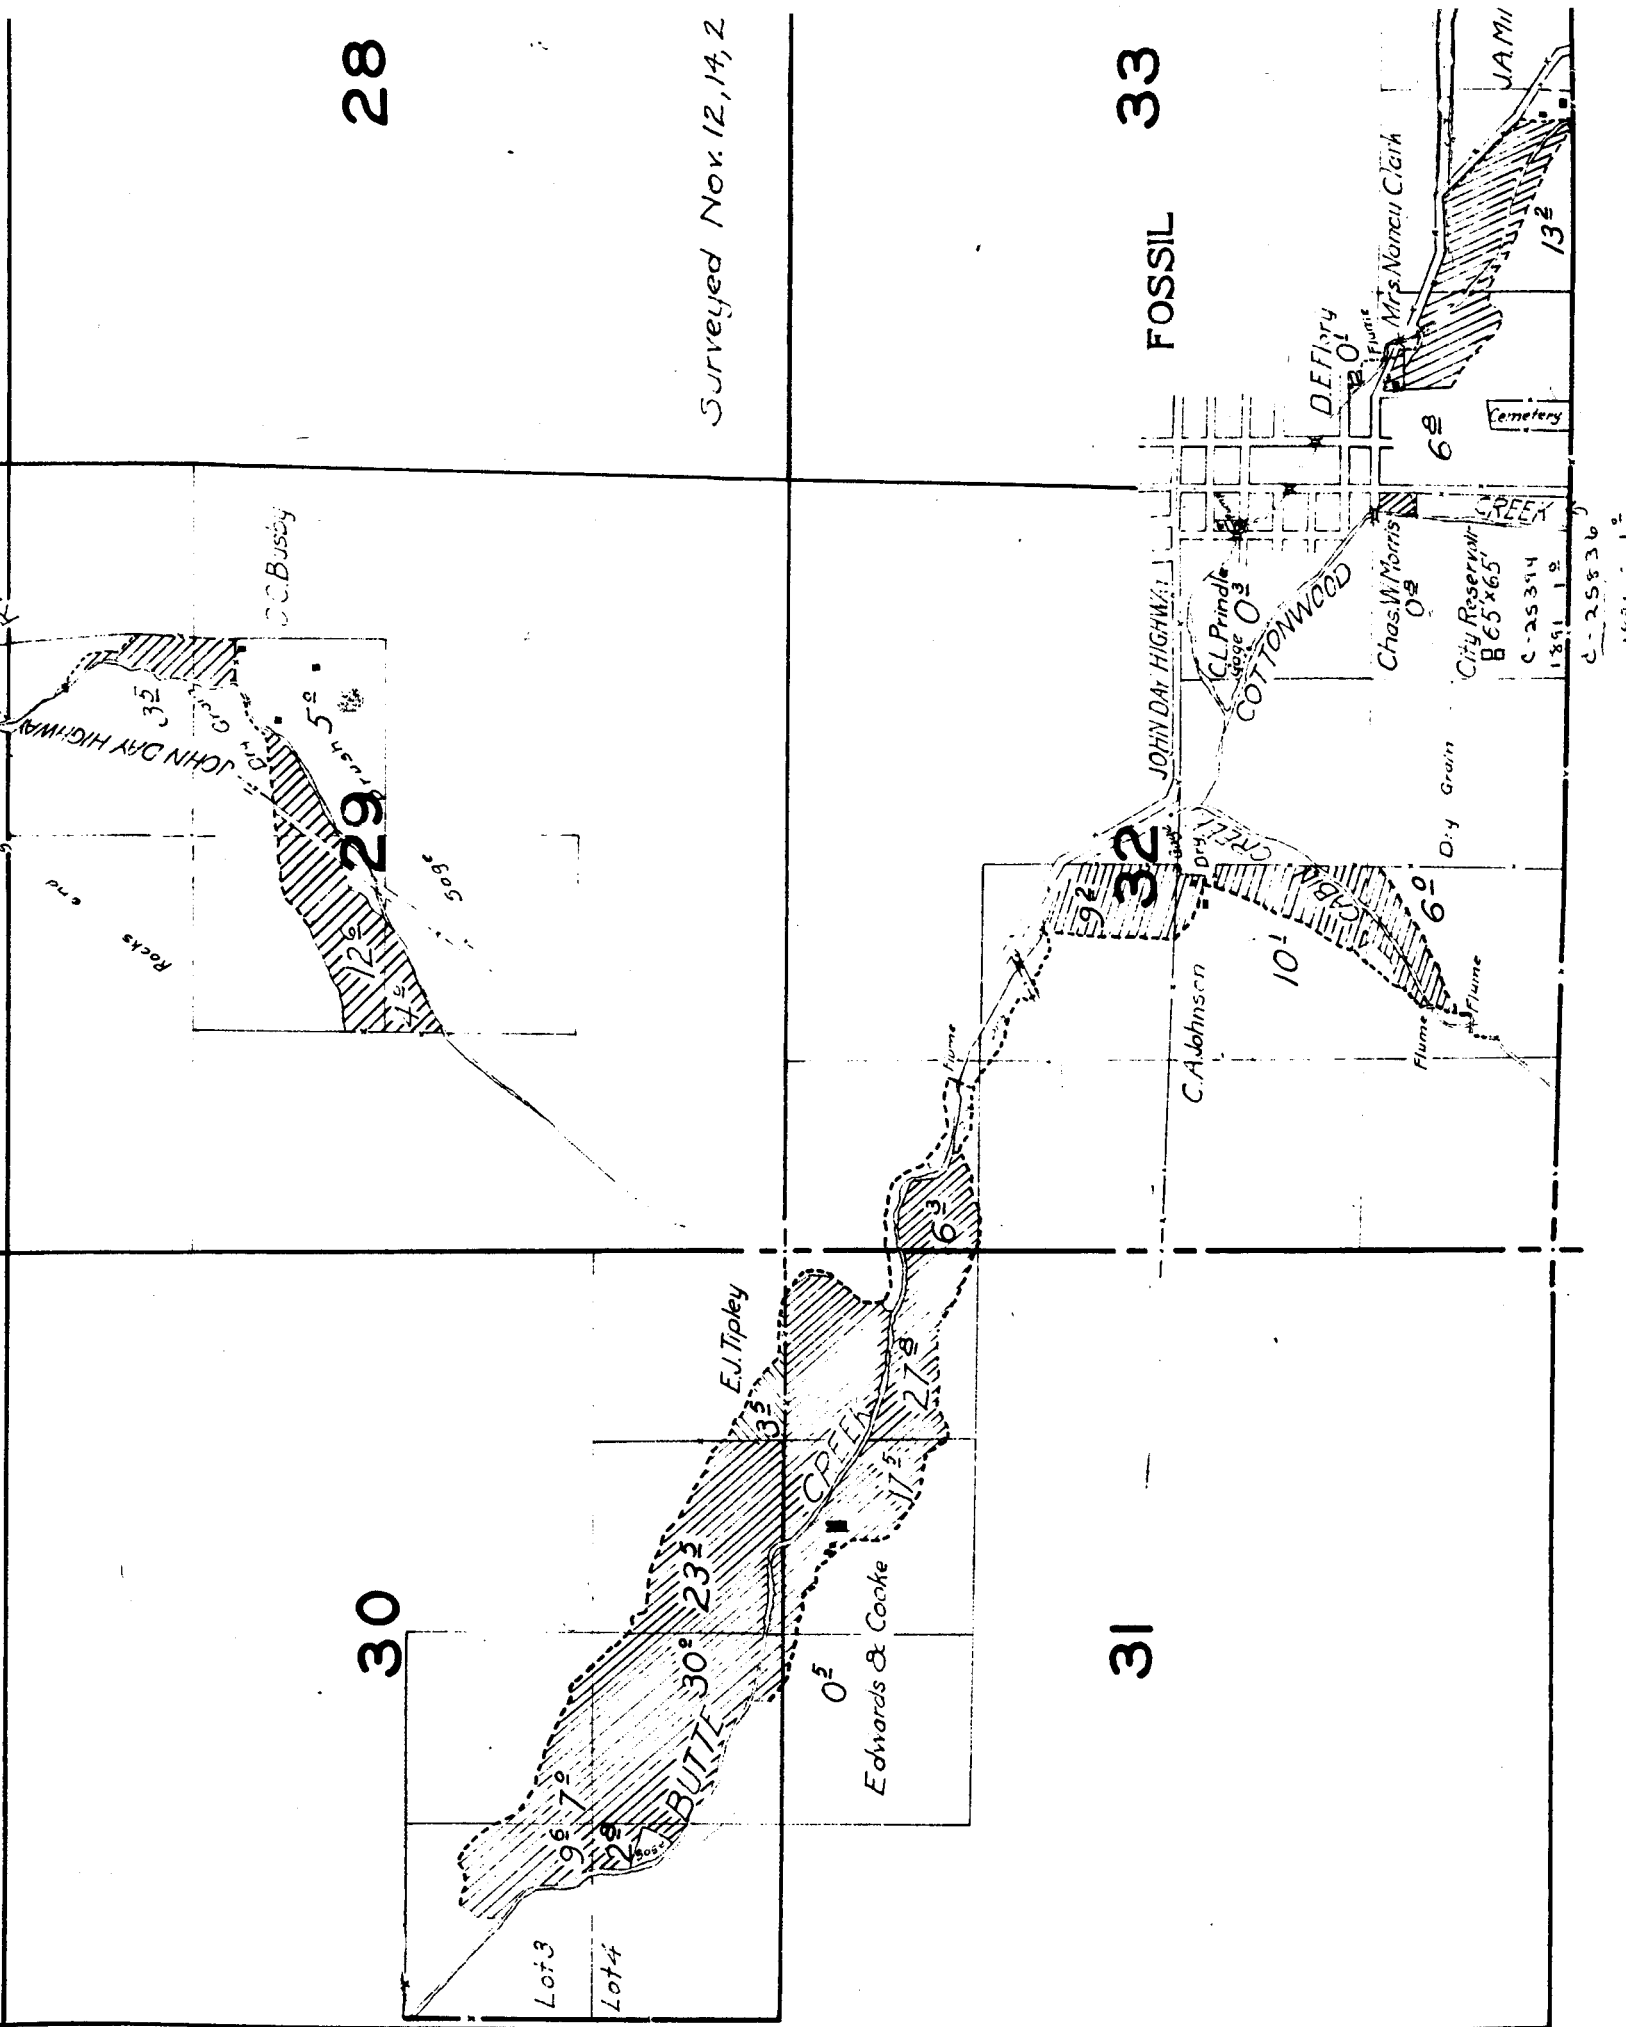

2	1
11	12
14	13

27


26

25

34

35

36

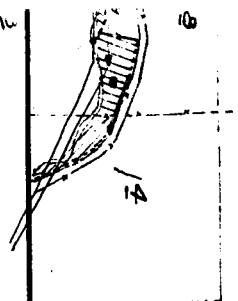

15

14

13

22

23

24

sketched in approximate
of in the vicinity of

