

18

17

16

*Note: Streams, except
irrigated land, sketched
location.*

04

Thomas Mabe

Lot 2

34

19

20

21


Lot 3
01

Surveyed Nov. 6, 1925.

TOWNSHIP

Surveyed Oct 30 to Nov 1

Federal Land Bank
(U.I. Thomas)

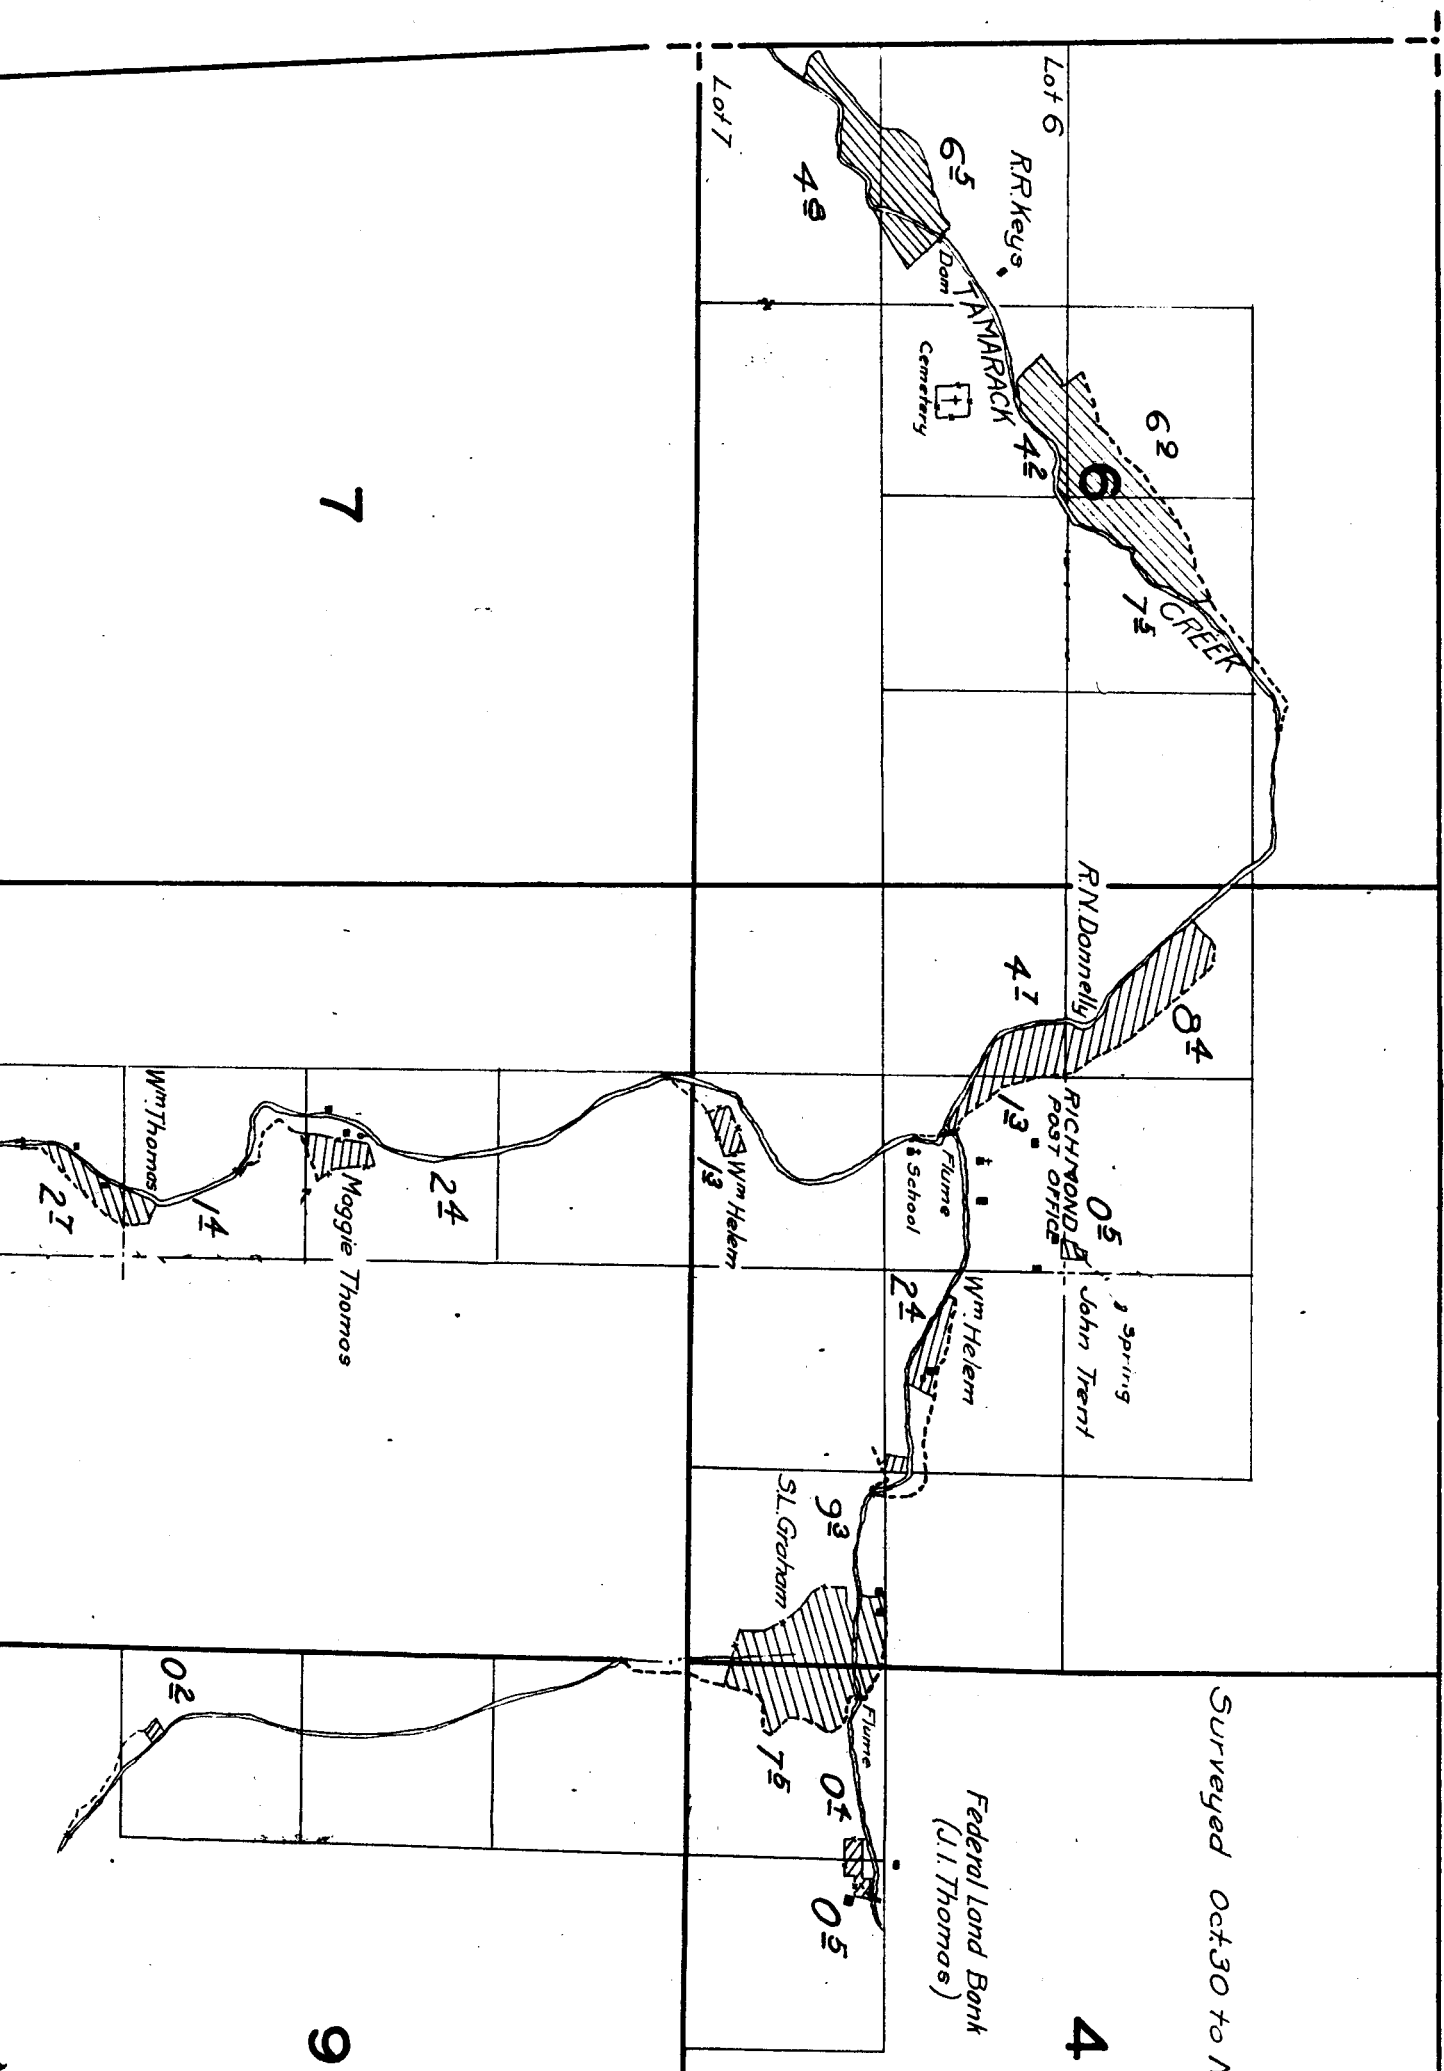

23

24

26

25

35


36

TOWNSHIP 10 S., RANGE 23 E.

urveyed Oct. 30 to Nov. 3, 1925.

4

Federal Land Bank
(J.I. Thomas)

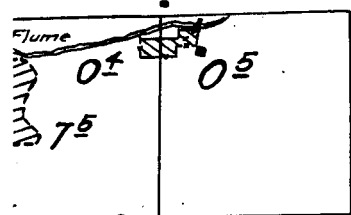

3

Note: Location of ditch & creek
sketched in field.

Lot 1

Lot 4

7±


6±

Thick

Pin

9

10

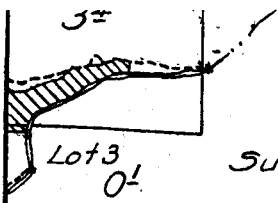

19


20

Lot 3
01

Surveyed Nov. 6, 1925.

30

29

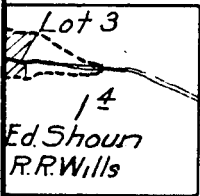

Lot 3
14
Ed. Shoun
R.R. Wills

31

32

15


14

13

22

23

24

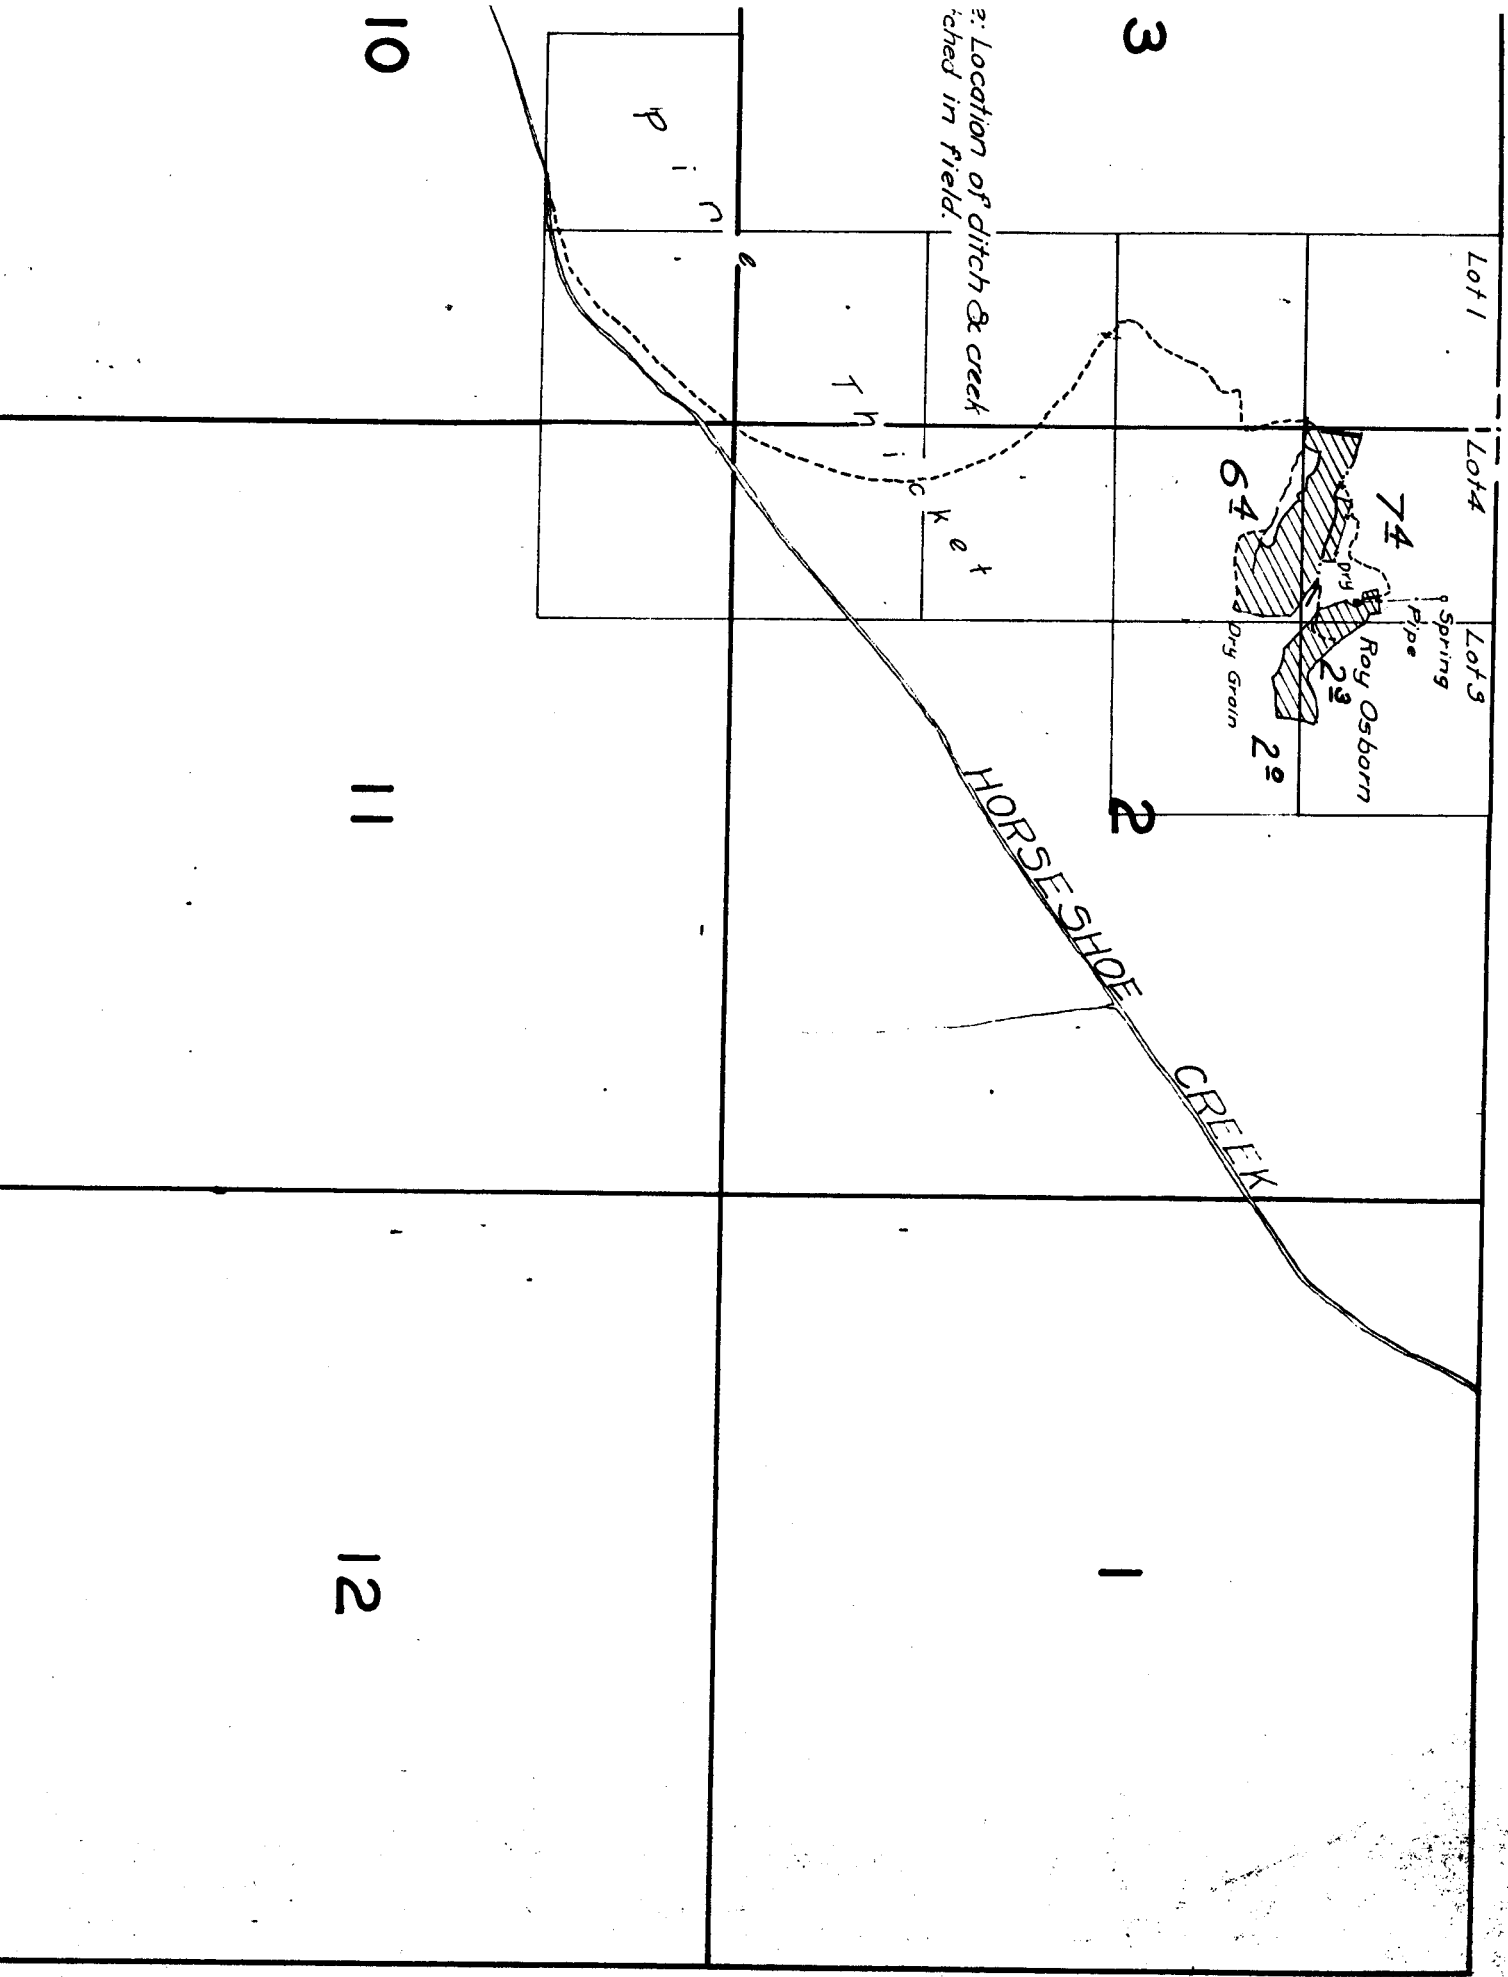

2: Location of ditch & creek

29

28

27

32

33

34

17

16

15

*Note: Streams, except in the vicinity of
irrigated land, sketched in approximate
location.*

20

21

22