

21

22

2^d
F.W. Ball

Note: Location according
to Mr. Ball.


School

28

27

33

34

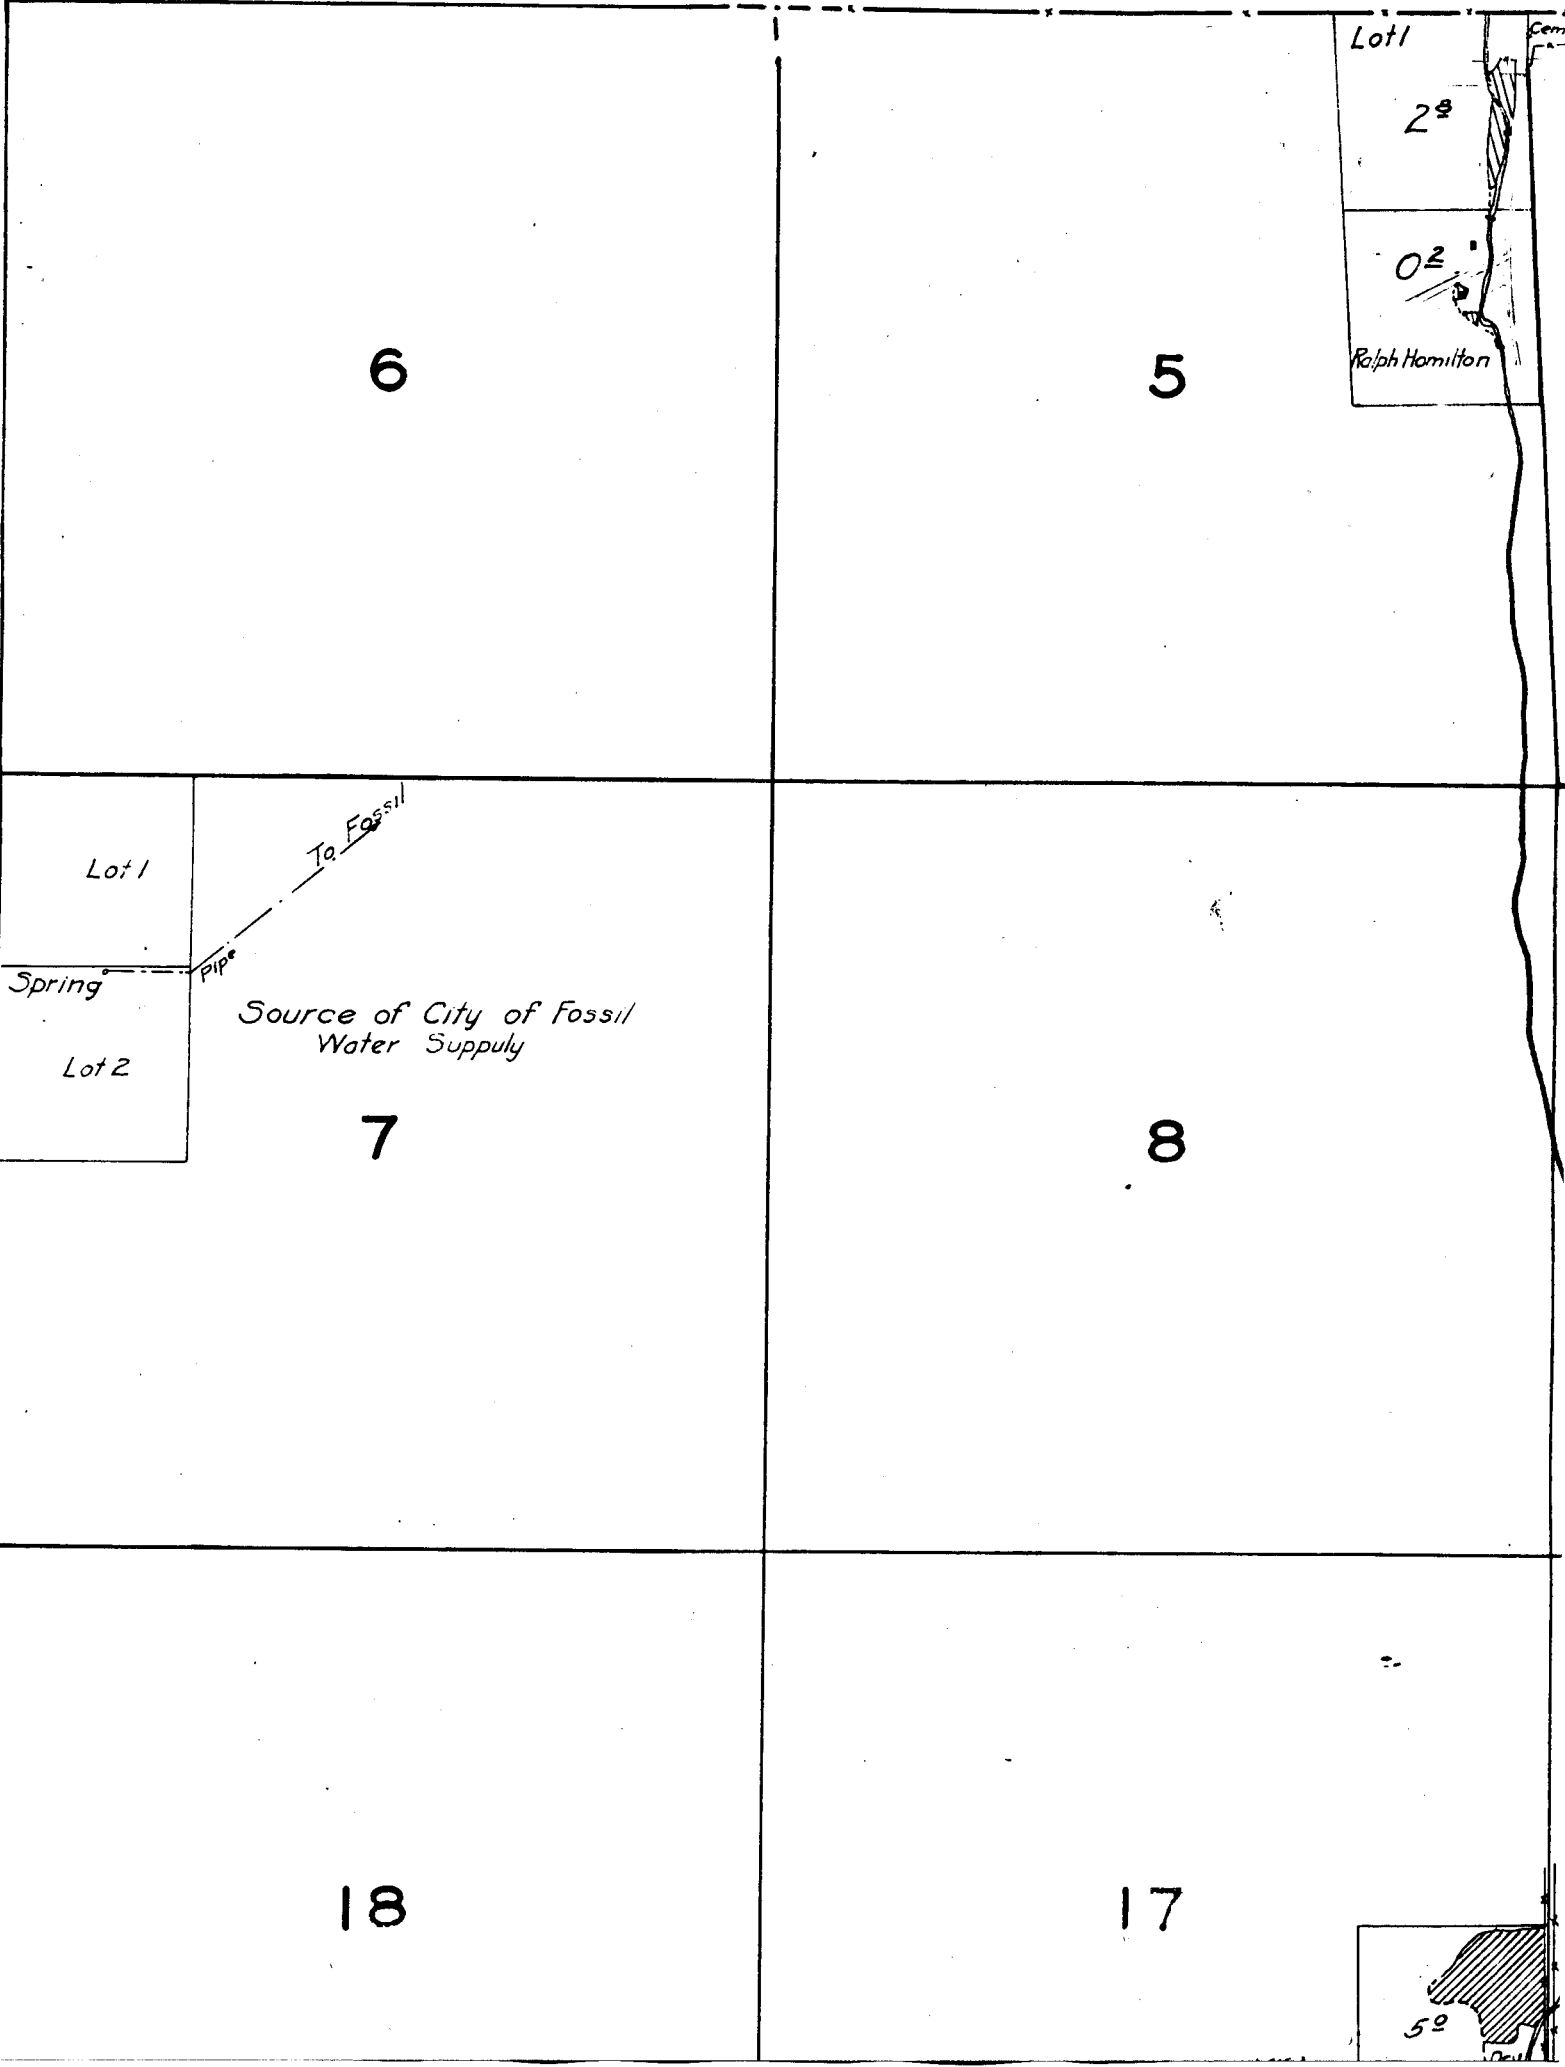

6

5

Lot 1
2^d
02
Ralph Hamilton
Cem.

Lot 1
Spring
Lot 2

To Fossil
Pipe
Source of City of Fossil
Water Supply


7

8

18

17

Lot 5

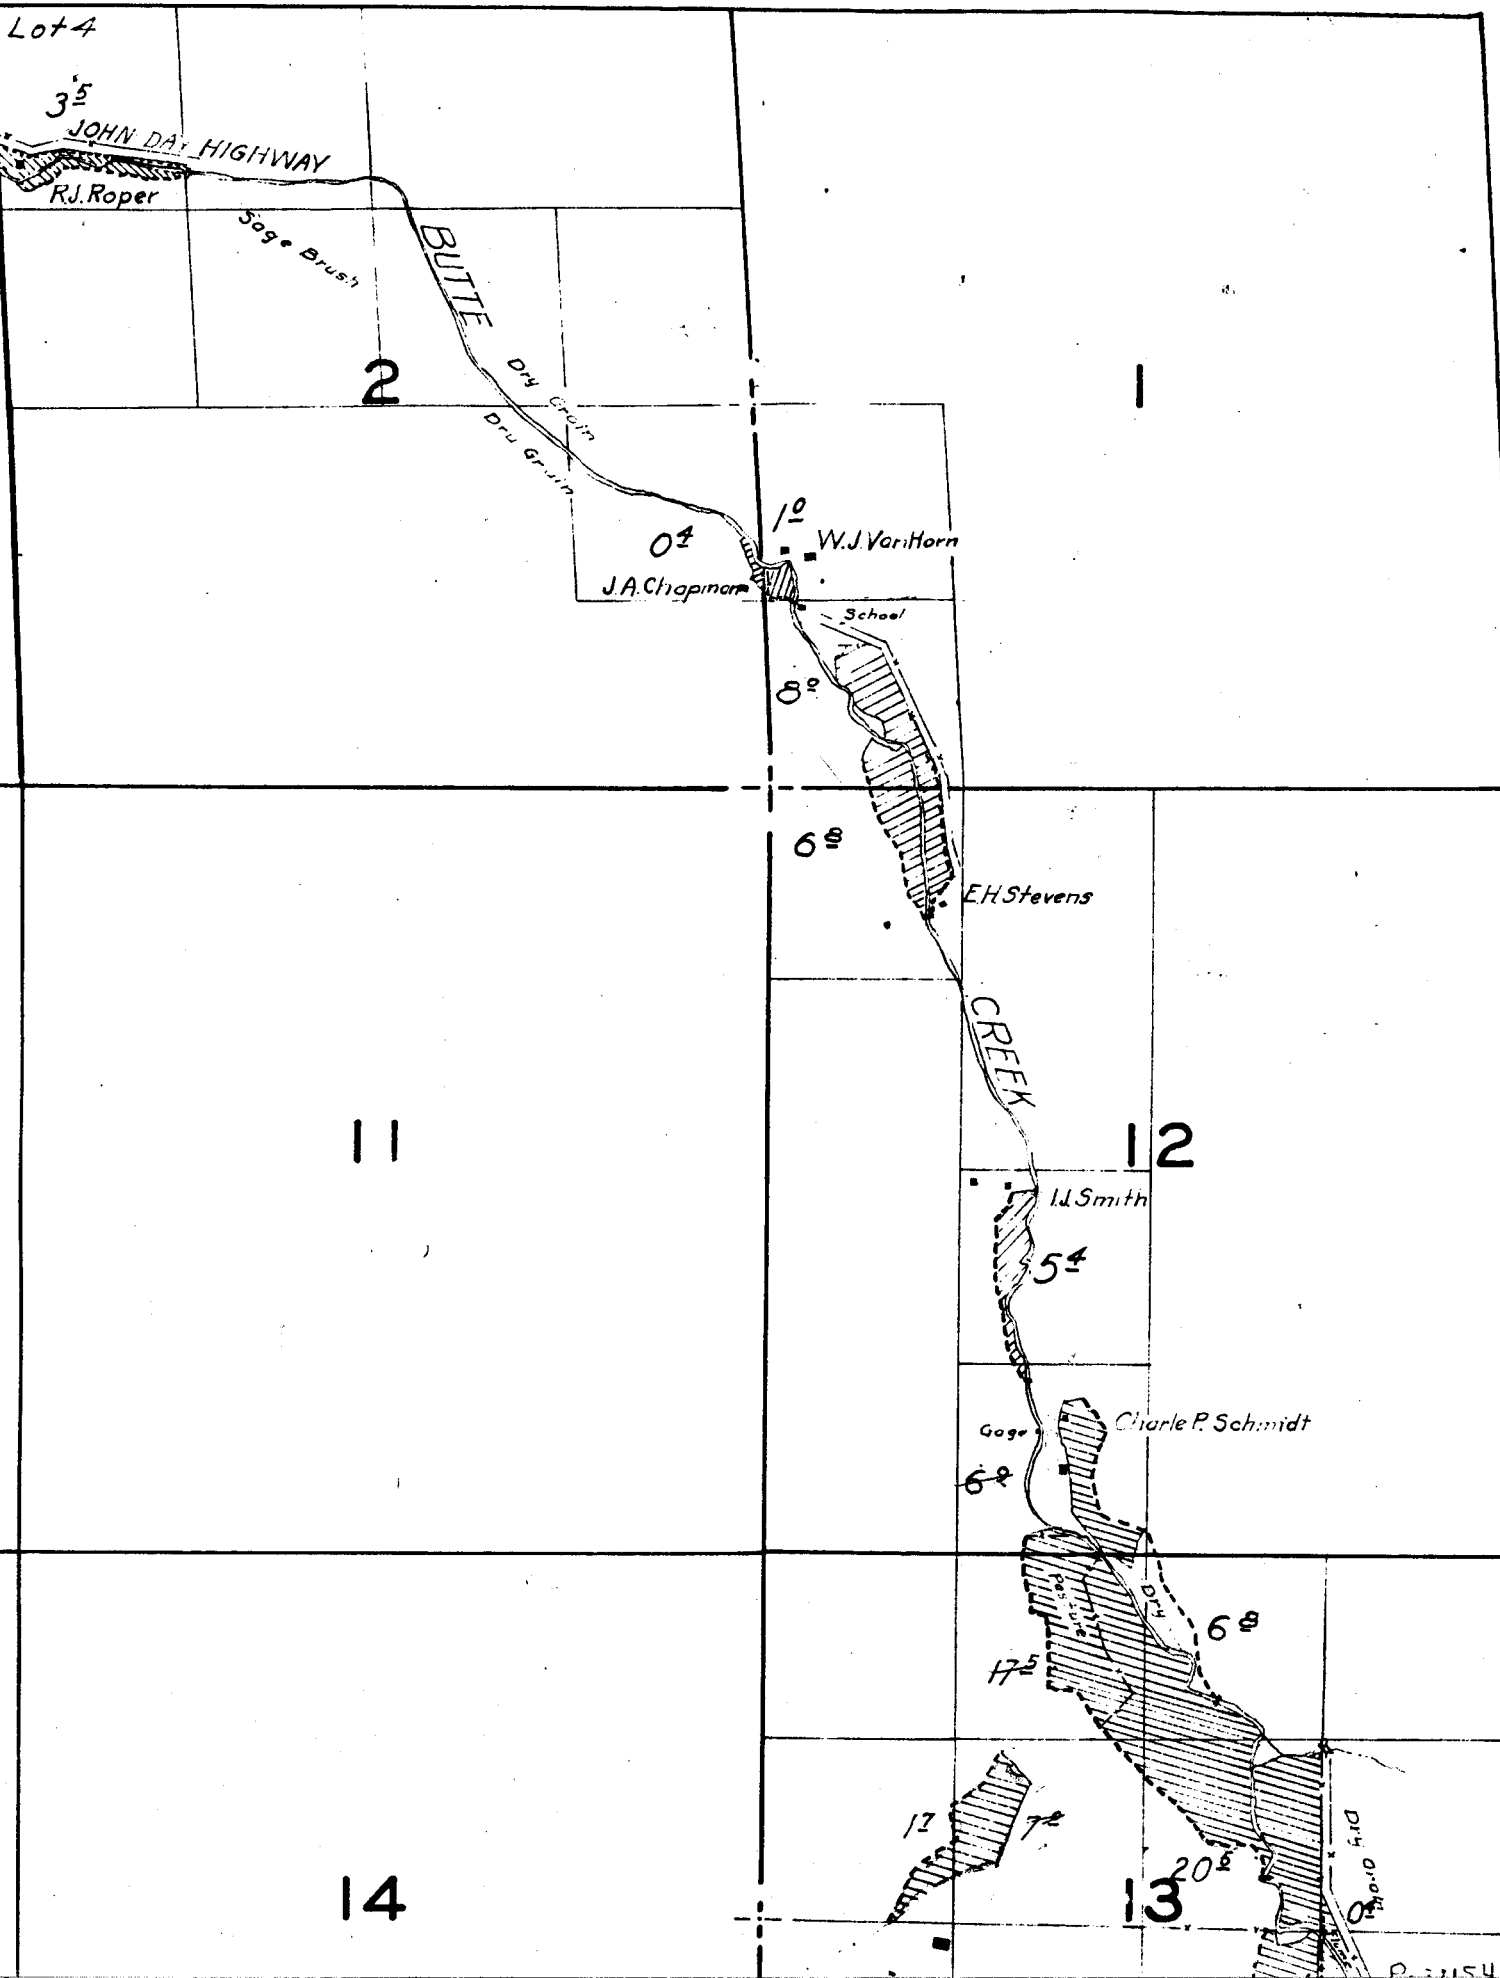


Note: Streams not in the irrigated lands sketched.

18

17

16

COTTONWOOD

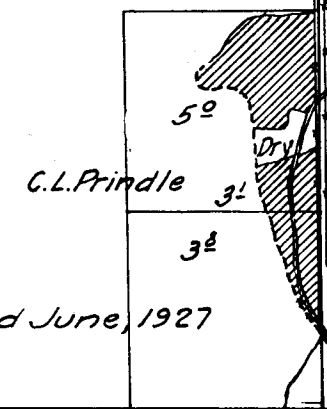

Surveyed June, 1927

19

20

21

CRE...

30


29

28

31

32

33

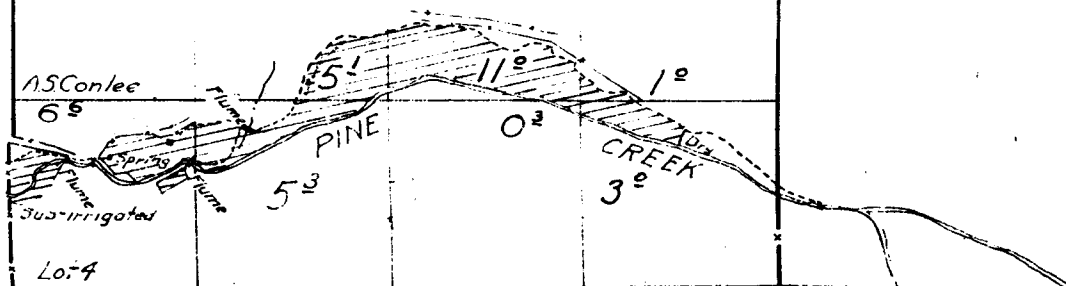

27

26

25

34


35

36

15

14

13

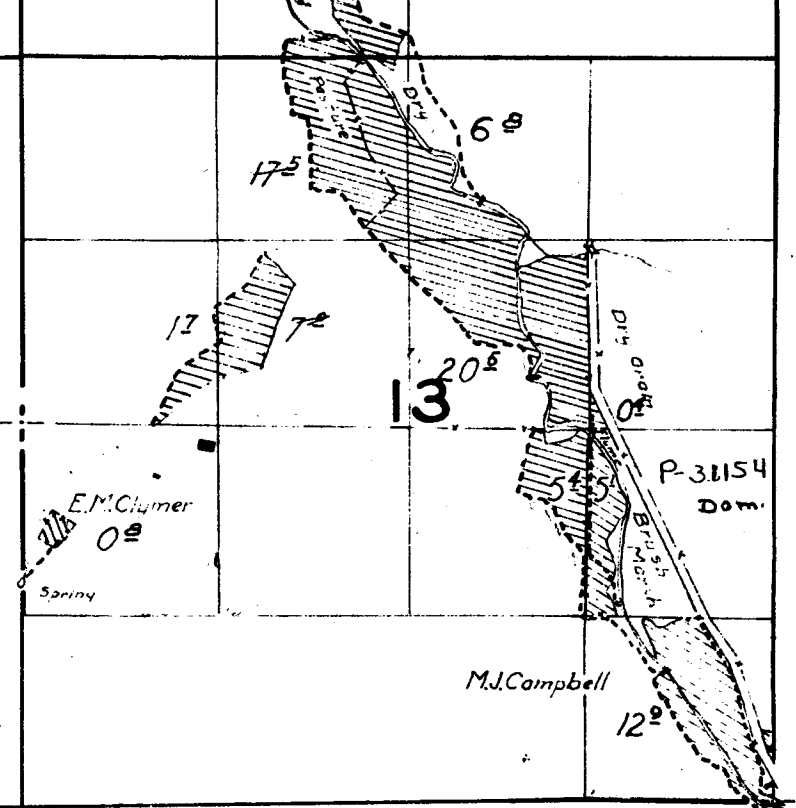

22

23

24

Location according
to Mr. Ball.

Note: Streams not in the vicinity of irrigated lands sketched in approximate location.

7

16

15

G.L. Prindle

5⁰

3¹

3²

Surveyed June, 1927

COTTONWOOD

CREEK



0

21

22

2⁰
F.W. Ball

Note: Location according to Mr. Ball.
School

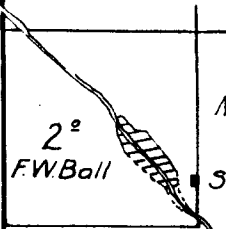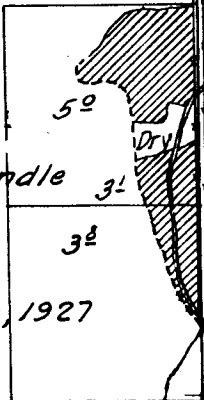

TOWNSHIP 7 S., RANGE 21 E.

